


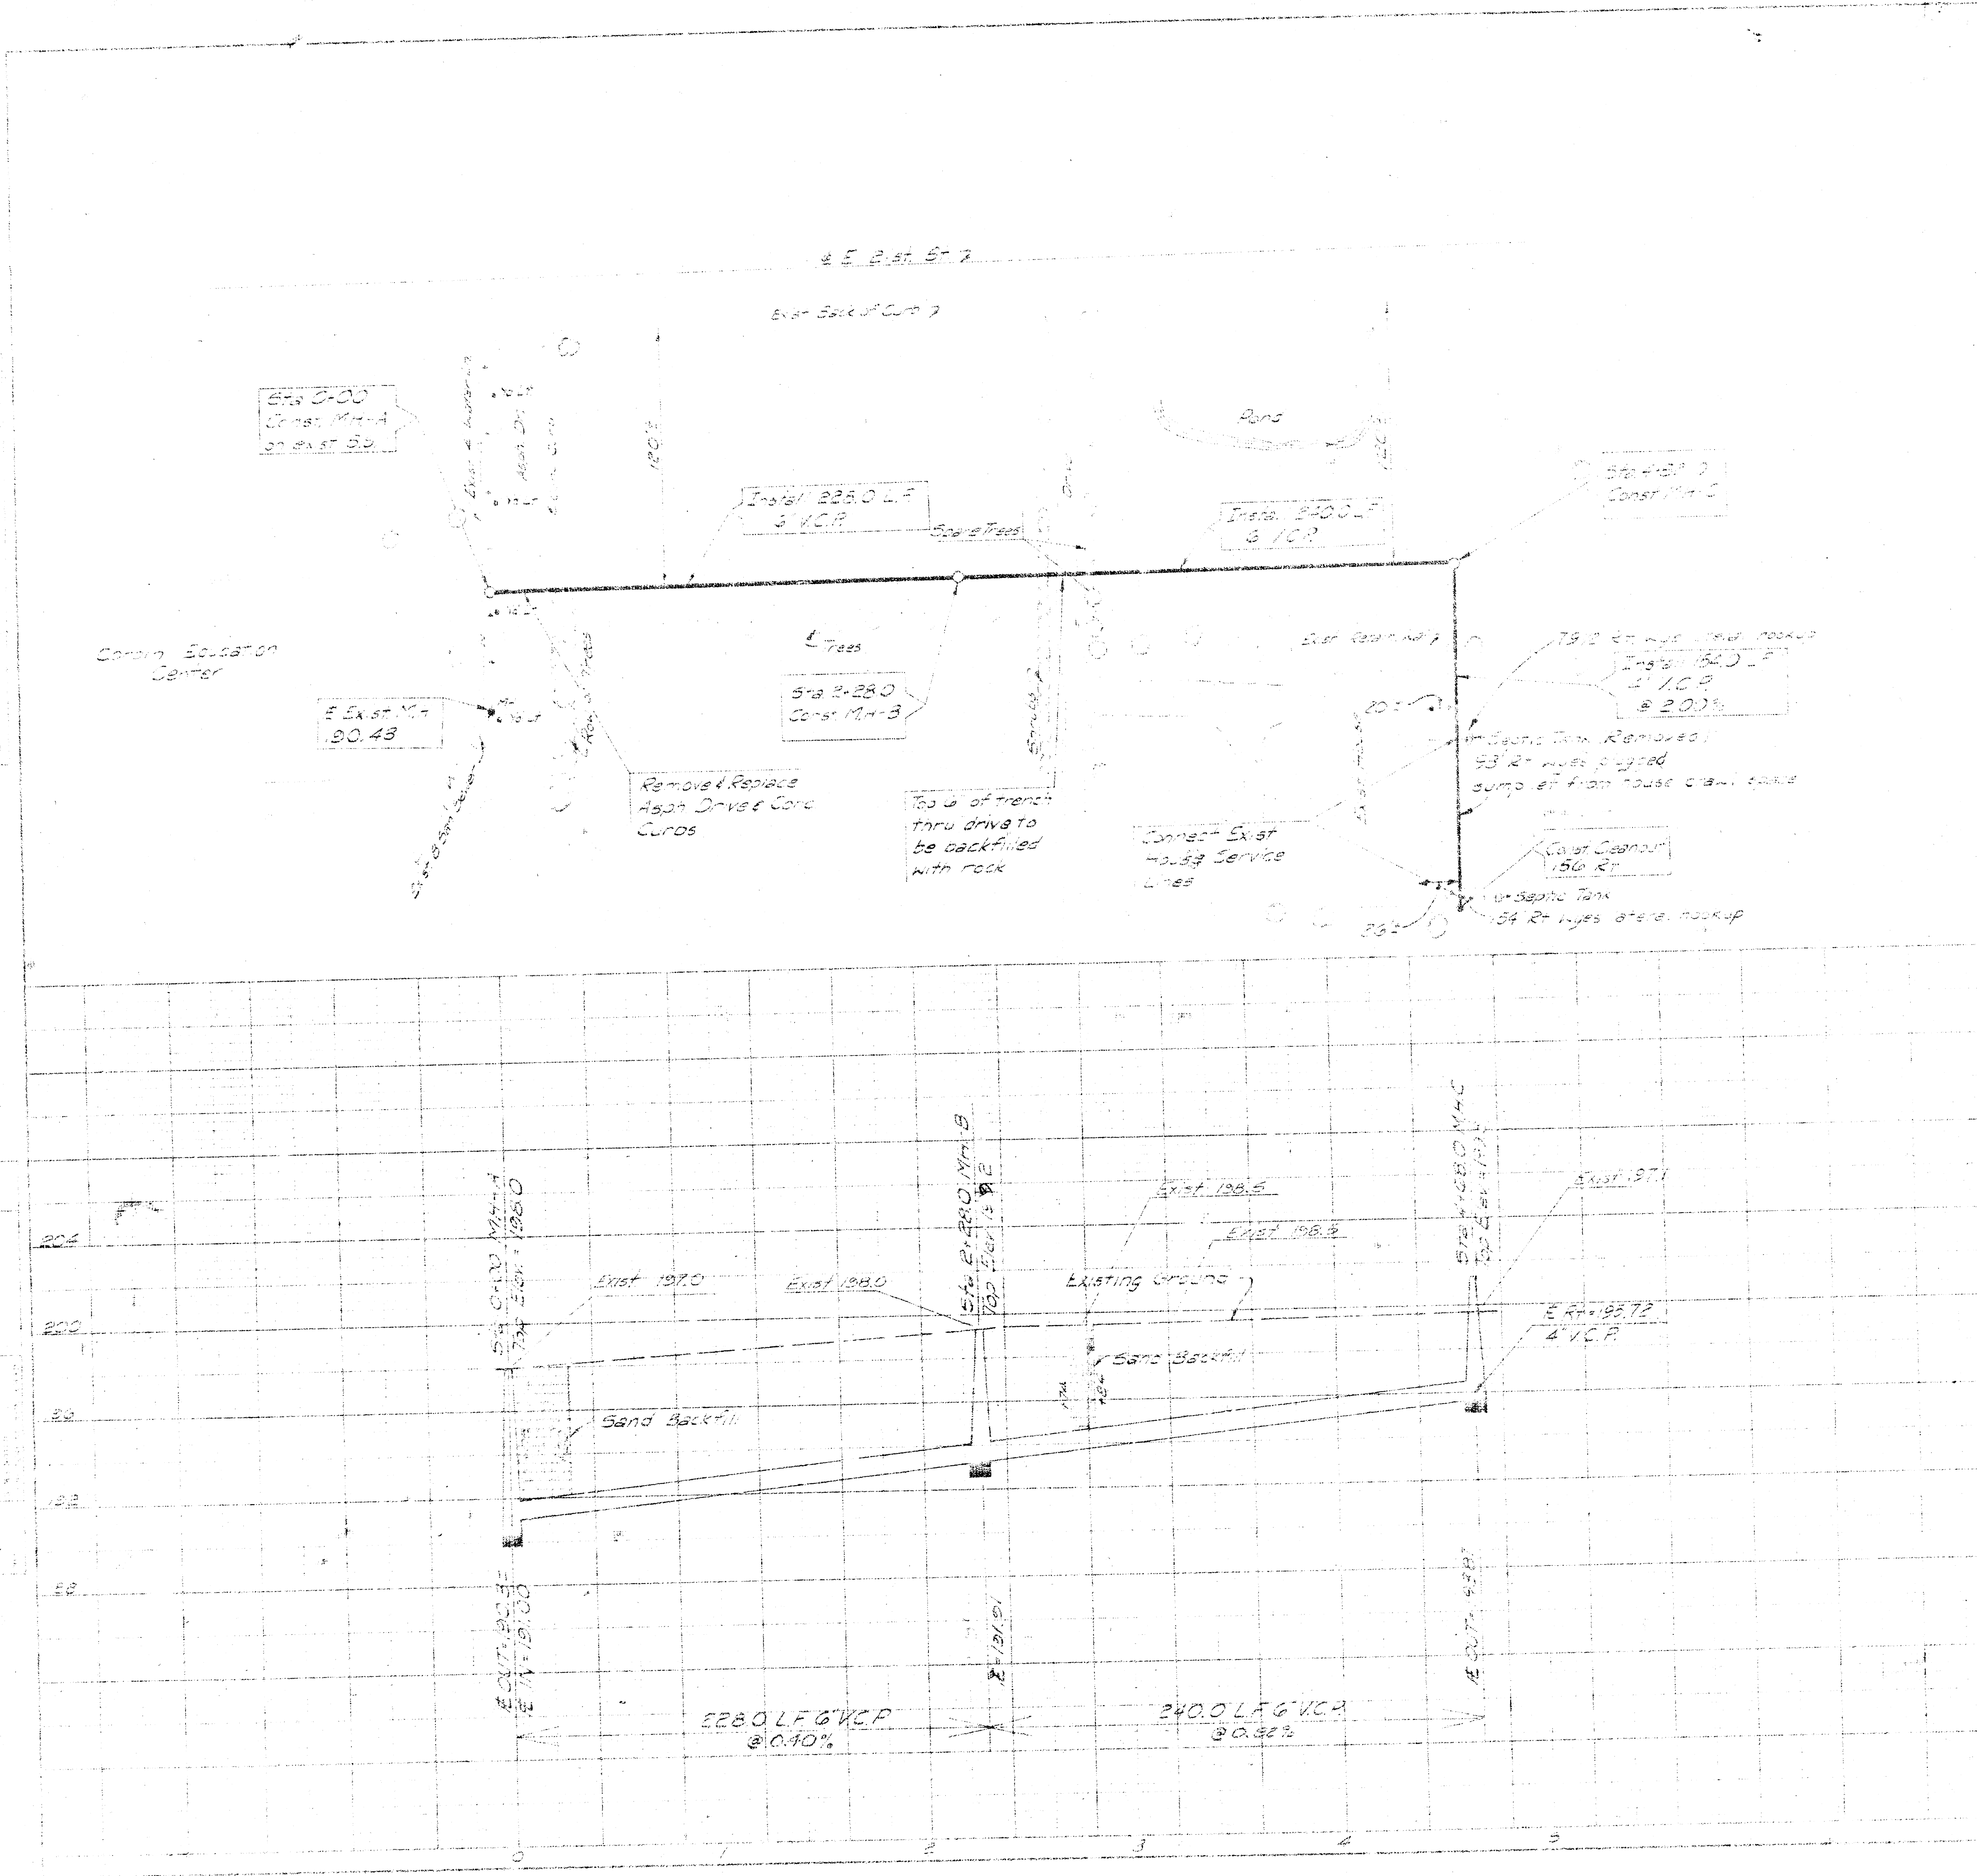

Scale:
1" = 40'
1" = 80'
1" = 120'

NOTES

1. Manholes to be City of Wichita Standard Manholes. This includes all 24" Manholes and 36" Manholes constructed in accordance with City of Wichita Sewer Regulations for these items.

"As Built" Booked on J-148

WICHITA STATE UNIVERSITY
LANDSHAWNE HOUSE
SEWER REPLACEMENT

6-22-79

BHKB 503040