



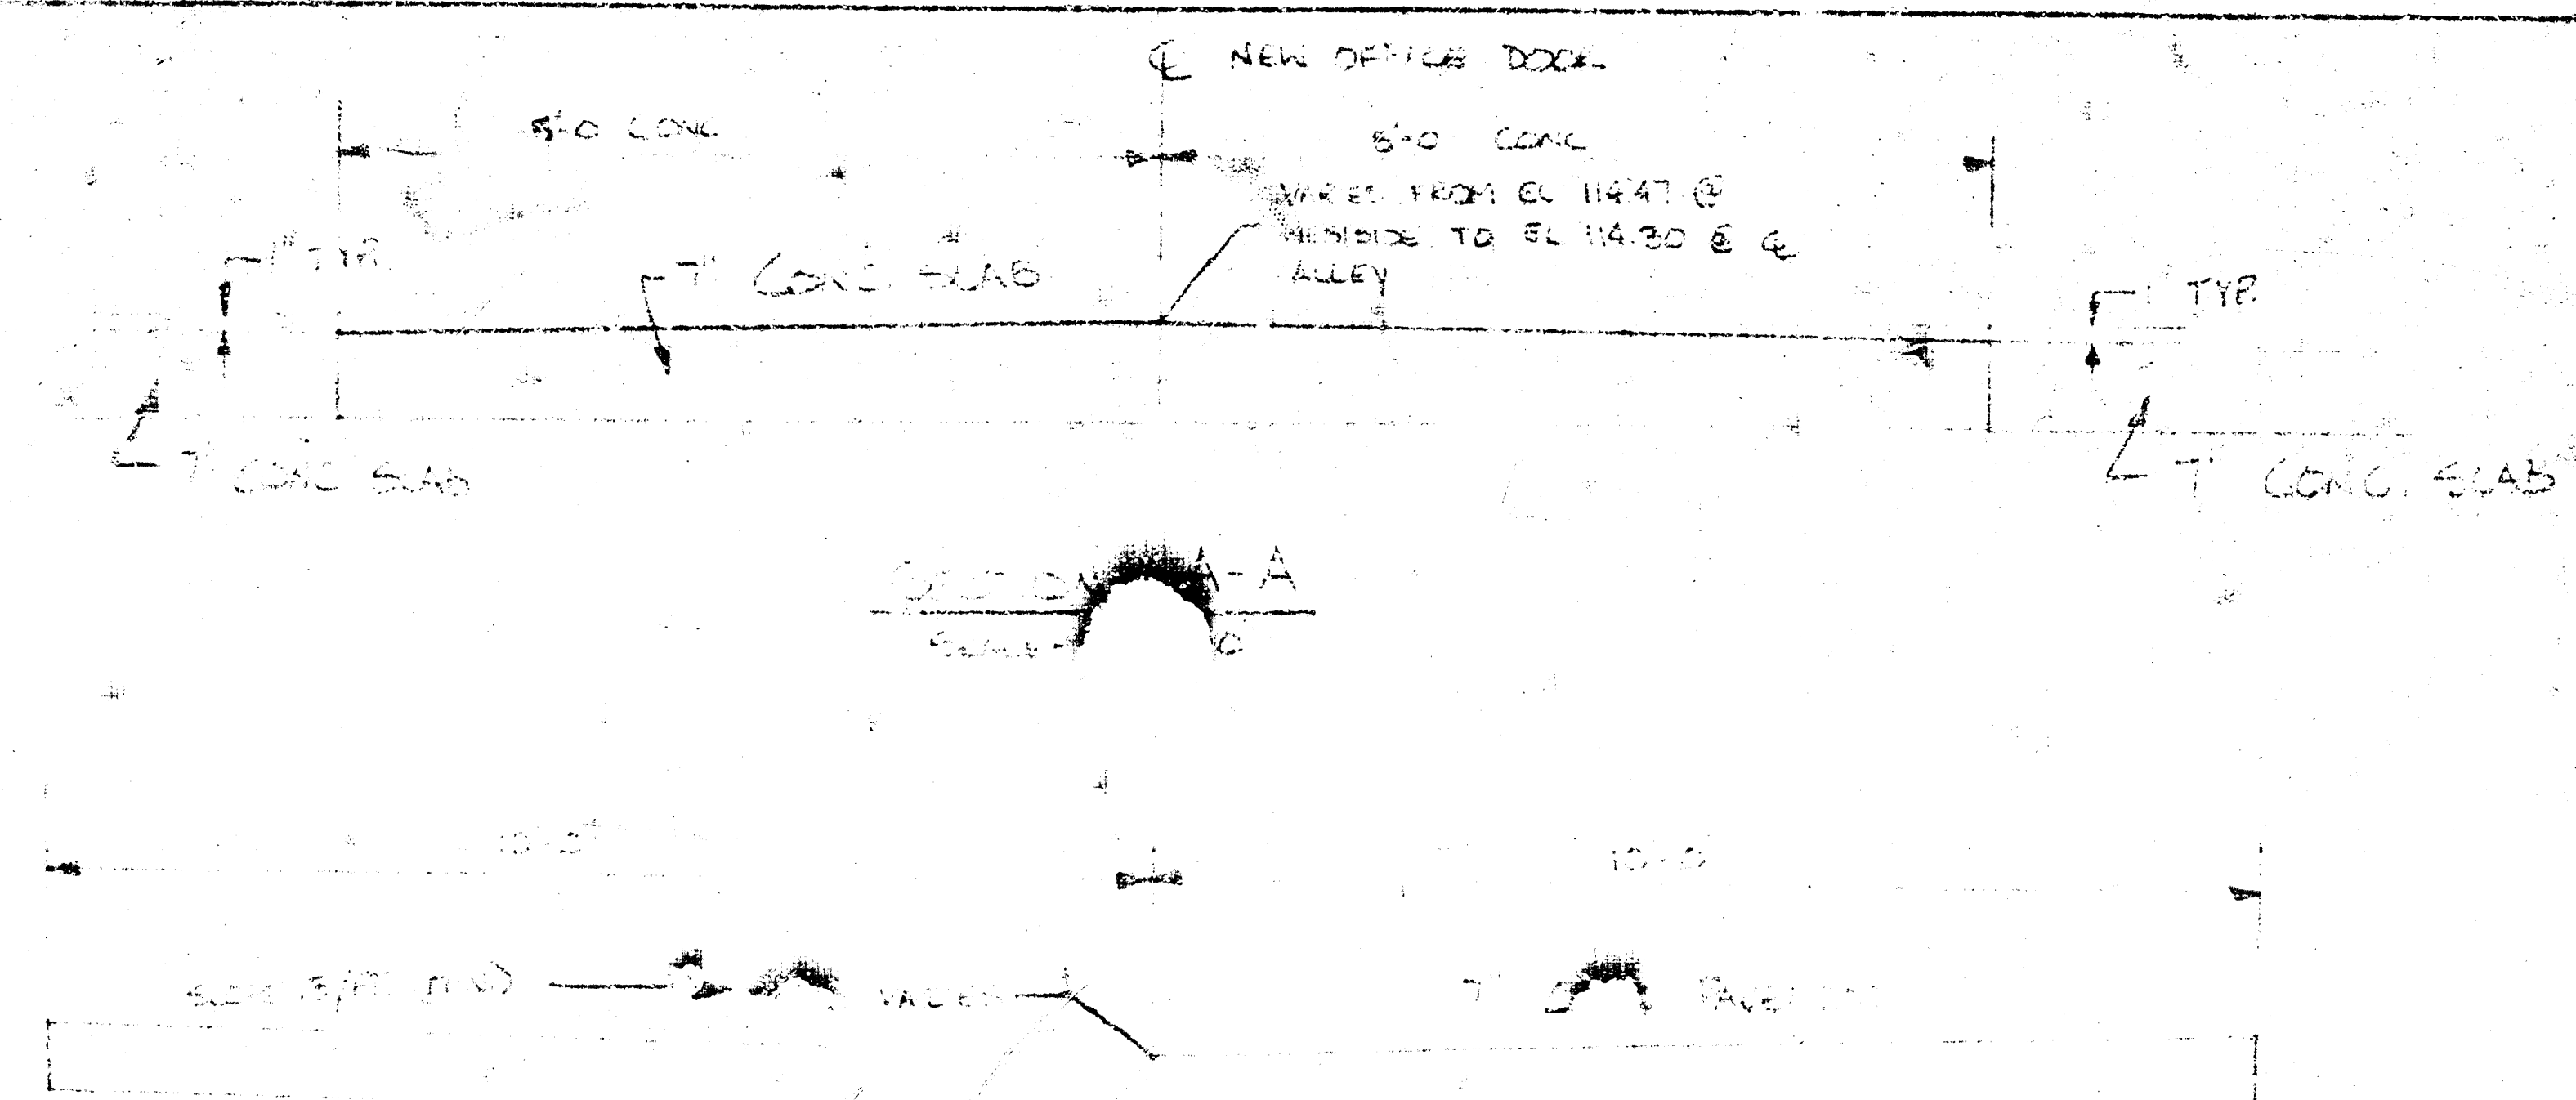


8-25-77
 APPROVED AS NOTED
 By CITY ENGINEER OF WICHITA
 Sanitary Sewers *[Signature]*
 Storm Sewers _____
 Driveway Approaches _____

NOTE TO CONTRACTOR
 This project will be constructed under the supervision of the CITY ENGINEER and conforming to the SPECIFICATIONS of the CITY OF WICHITA. The CONTRACTOR will reimburse the City of Wichita for all cost of engineering and inspection.

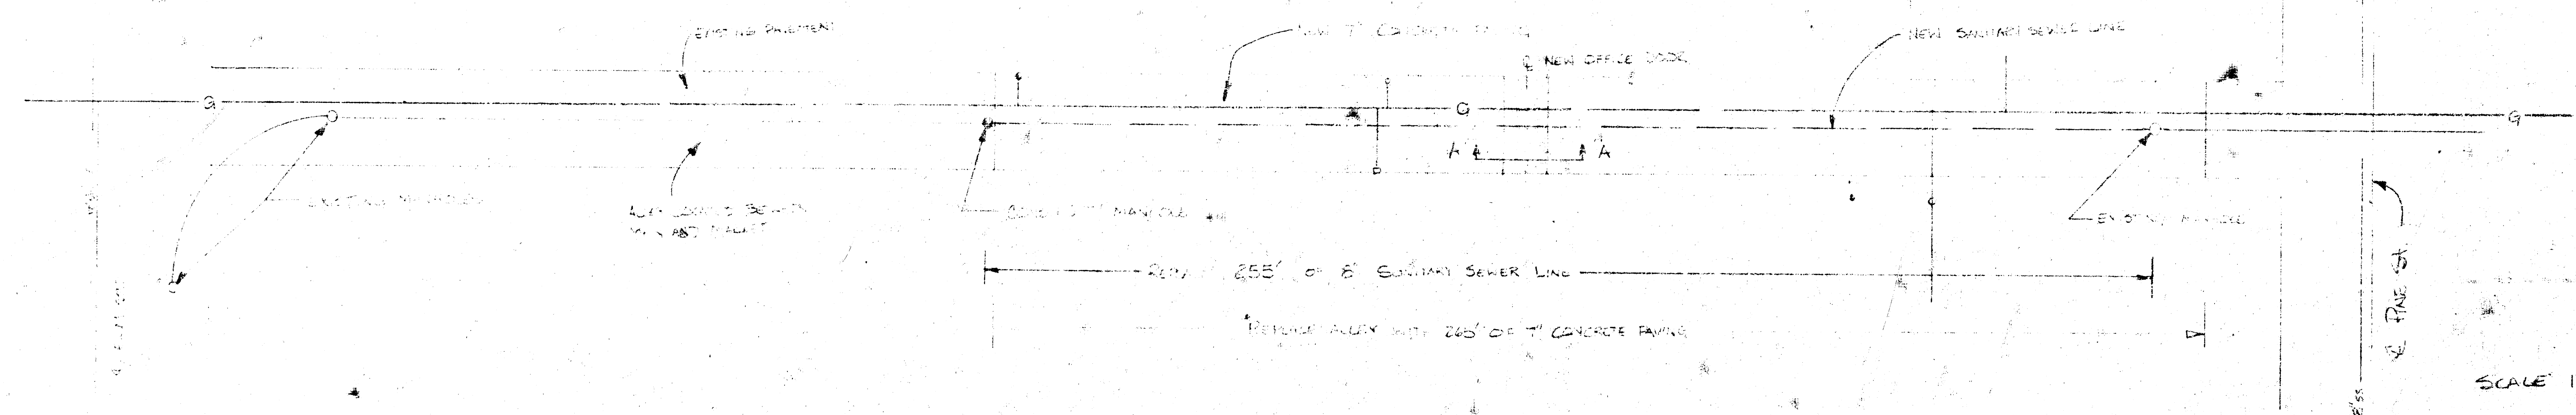

SCALE 1"=20'

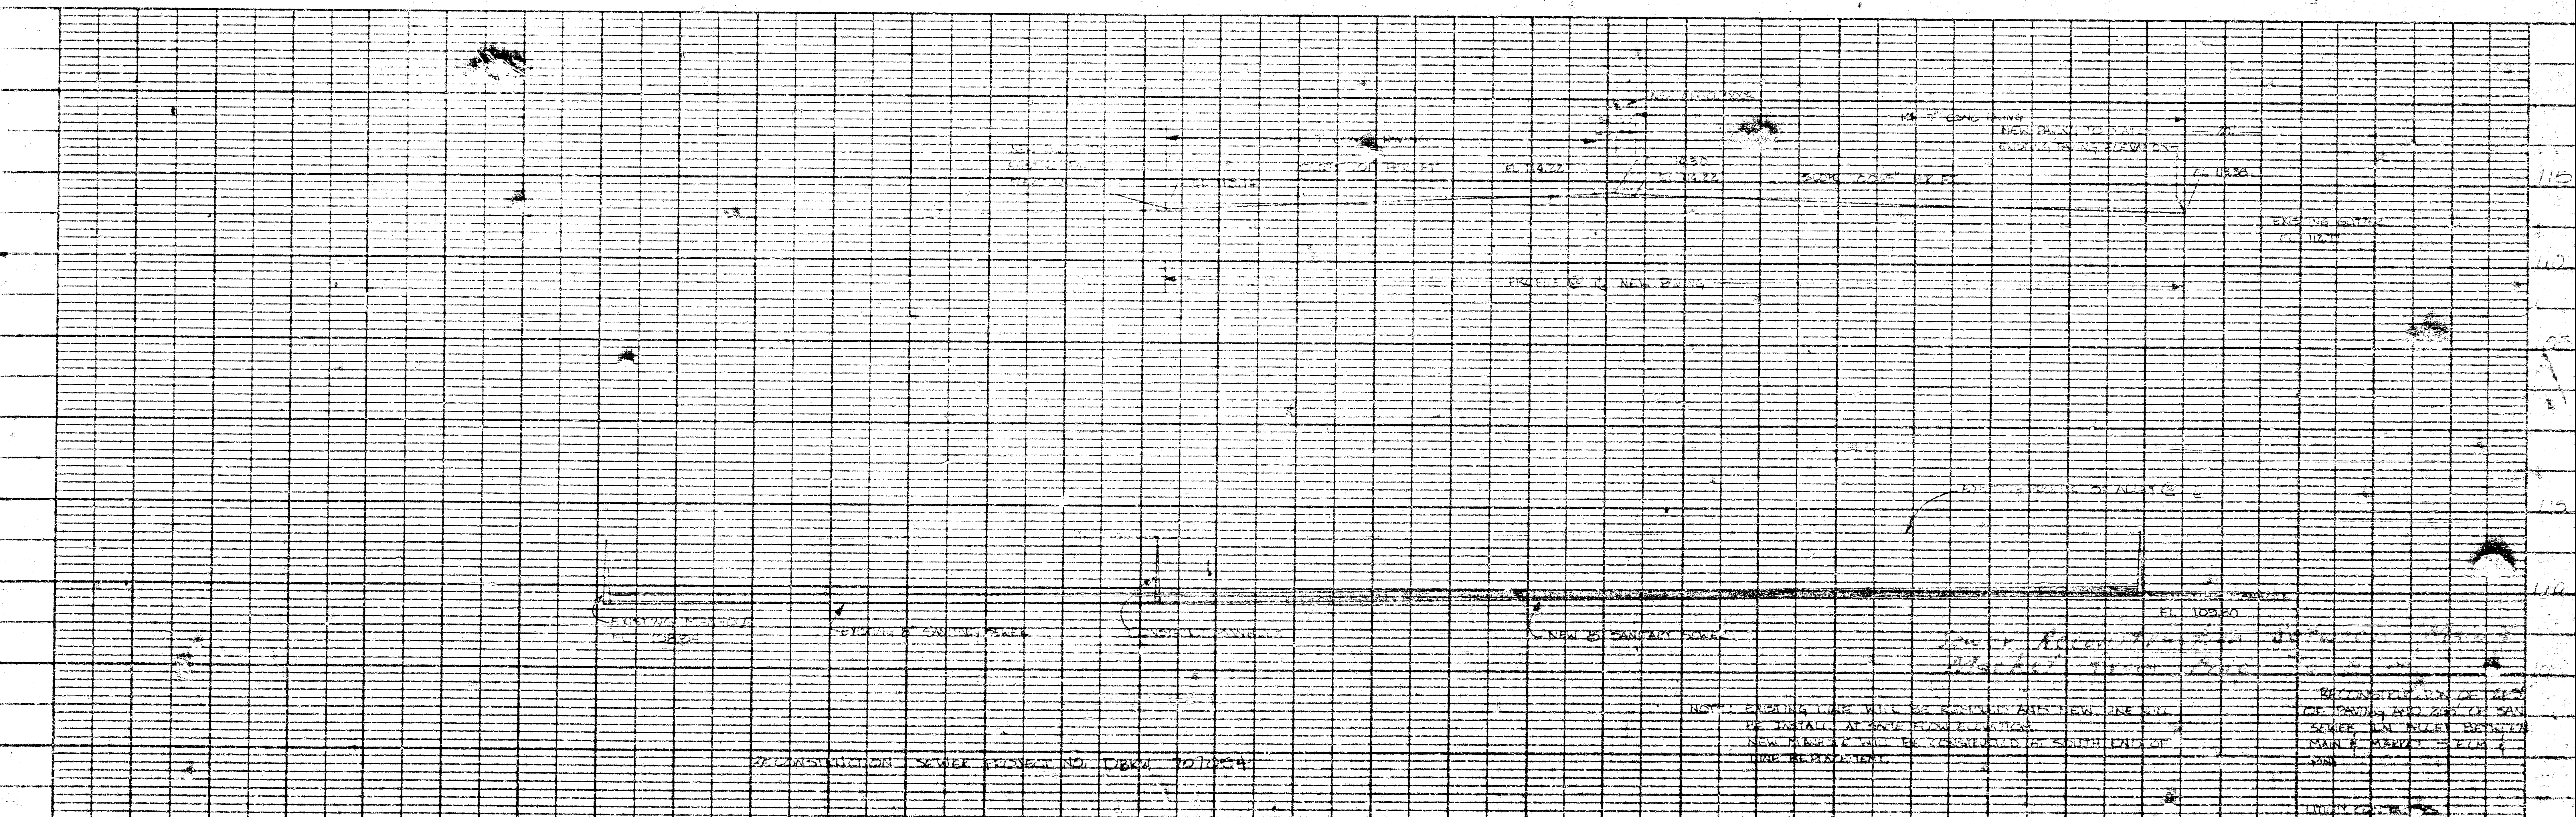

RECONSTRUCTION SEWER PROJECT NO. 1234

NOT: EXISTING LINE WILL BE REMOVED AND NEW LINE WILL BE INSTALLED AT SAME ELEVATION. NEW LINE WILL BE CONSTRUCTED TO SOUTH END OF DUNE REPAIRMENT.

RECONSTRUCTION SEWER PROJECT NO. 1234
 DATE: 8-25-77
 BY: [Signature]
 CHECKED: [Signature]
 APPROVED: [Signature]