


R.M. 103.13 CITY STANDARD N.E. COR HILLSIDE & PAWNEE. 2.5' E. Guy pole 1 24' N. of 'X' on curb.

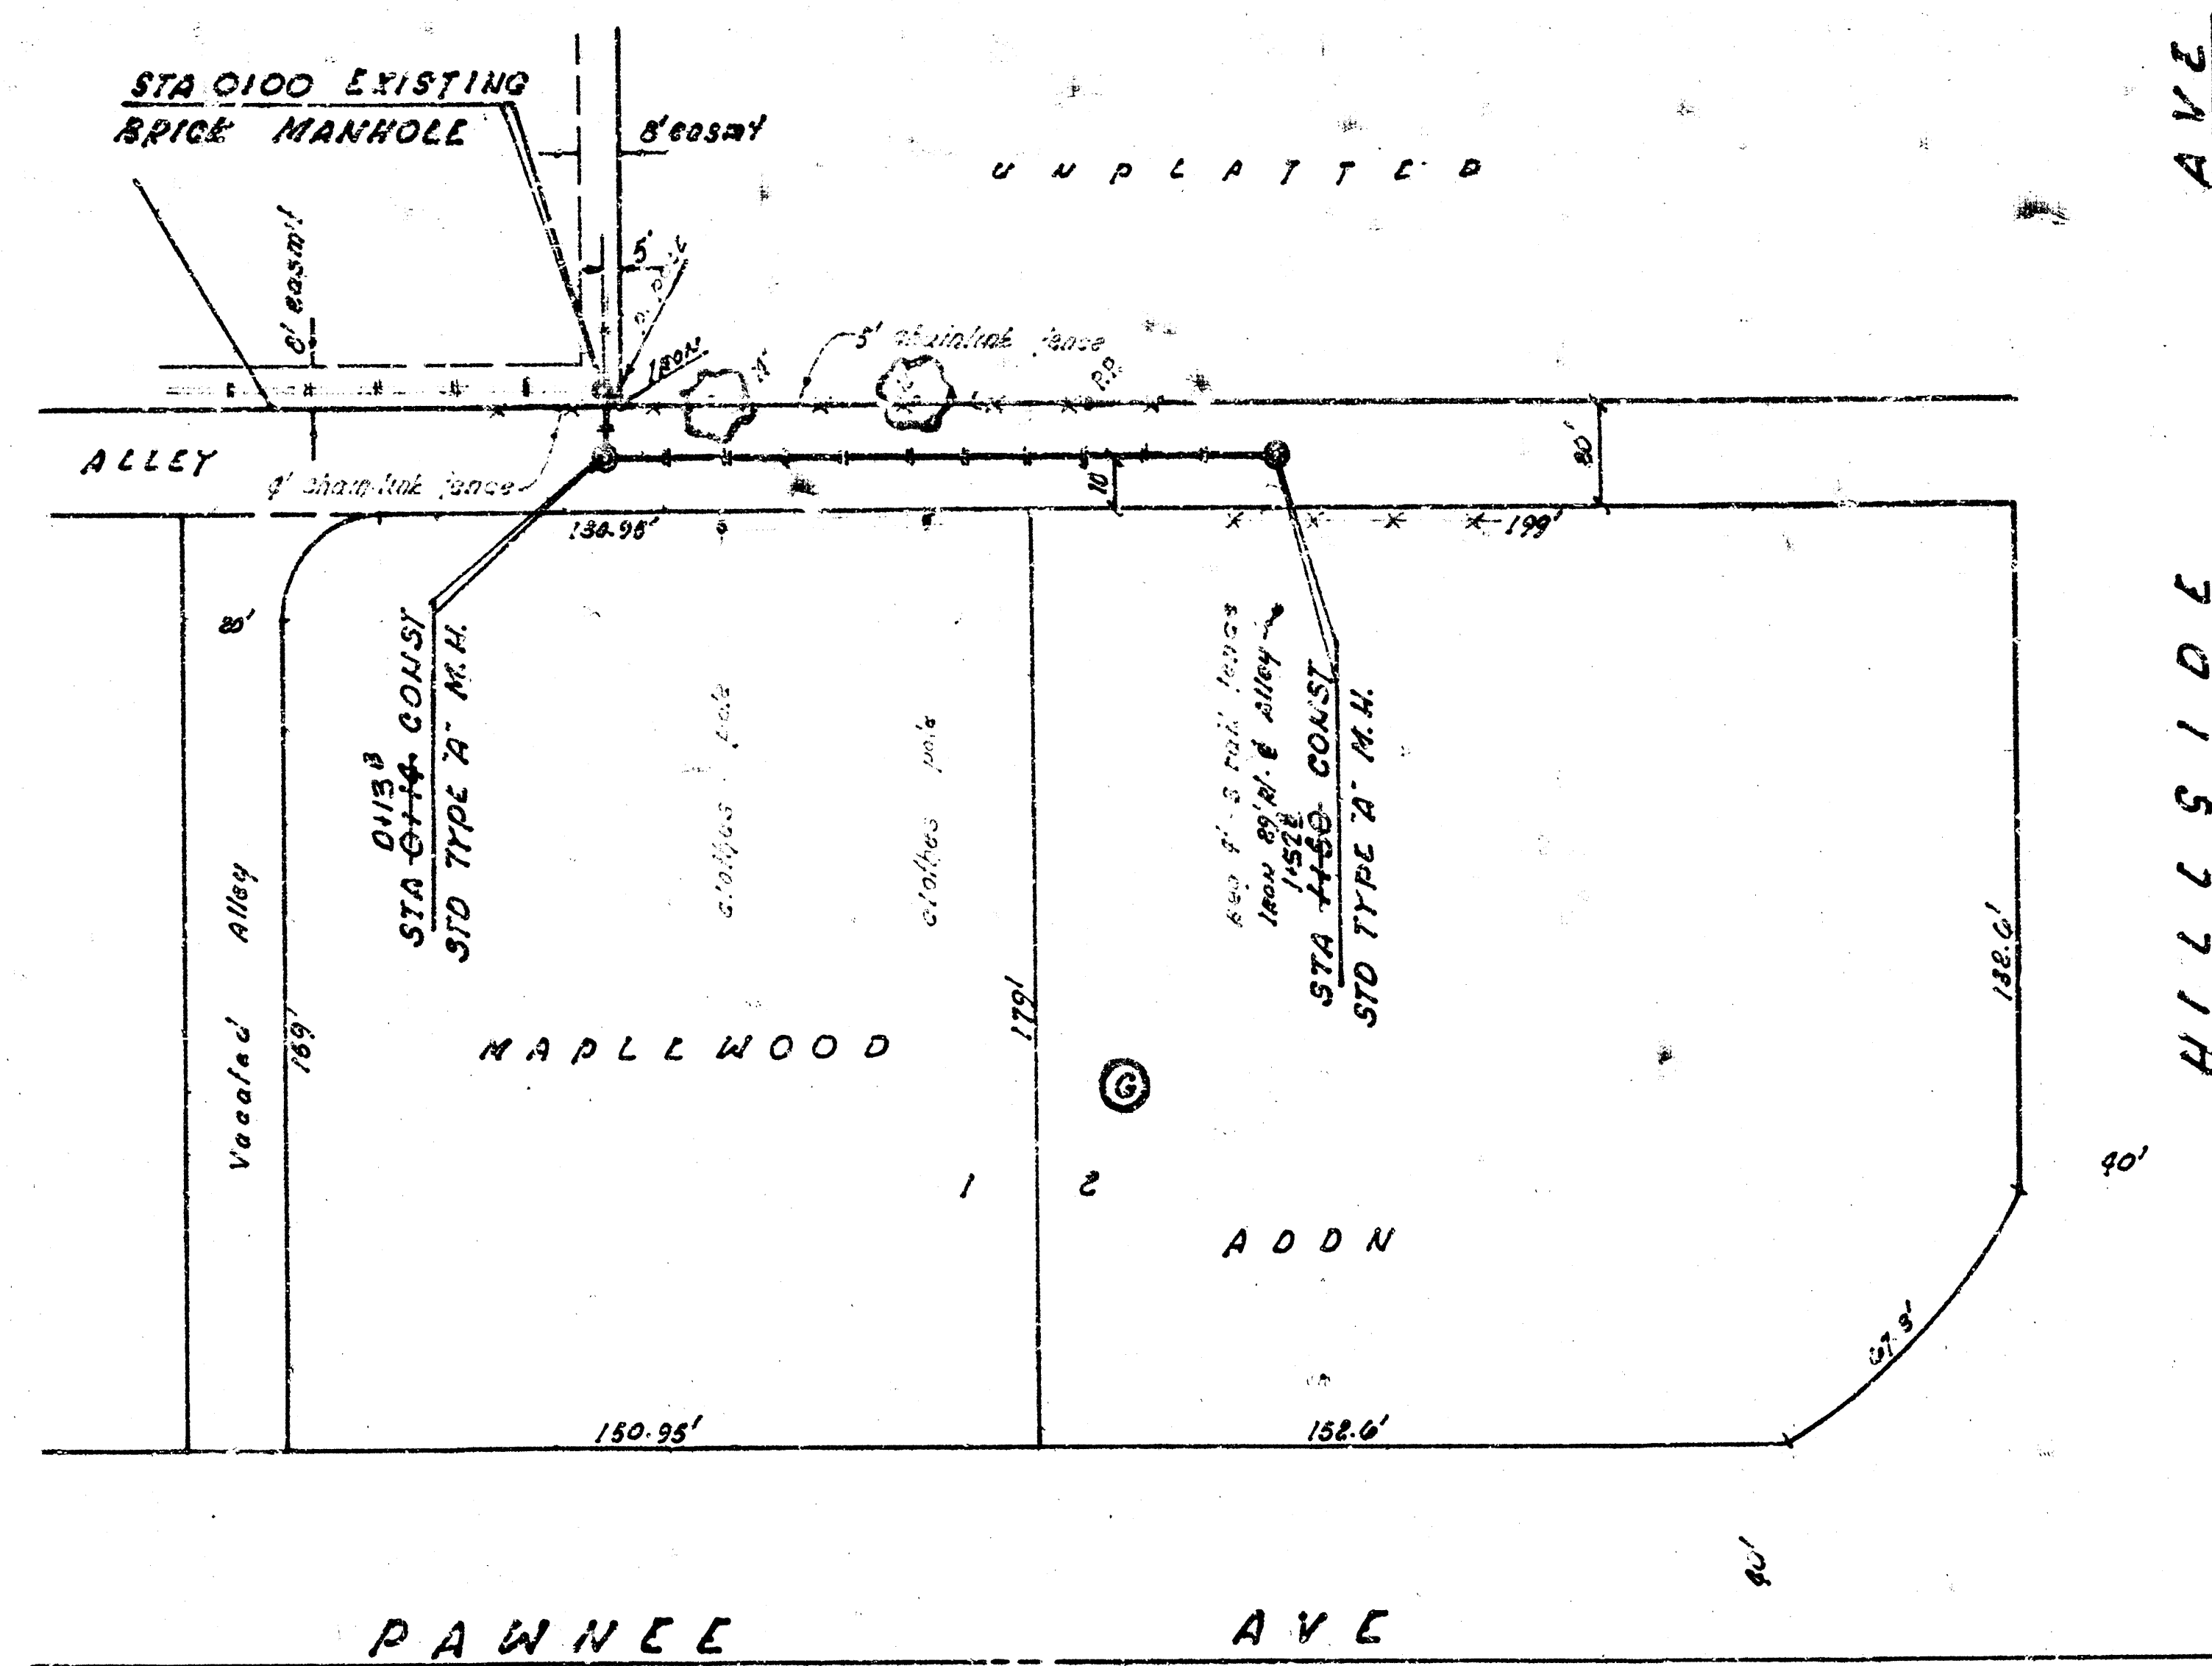


NOTE: Existing private sanitary line to be abandoned, and all service lines connected to private sewer to be re-connected to new sewer construction. All costs for re-connections to be incidental to project.

NOTE TO CONTRACTOR

This project will be constructed under the supervision of the CITY ENGINEER and conforming to the SPECIFICATIONS of the CITY OF WICHITA. The CONTRACTOR will reimburse the City of Wichita for all cost of Engineering, Plans, and Inspection.

PLAN SCALE 1"=40'
--PROFILE--
1"=2' VERT
1"=20' HORIZ

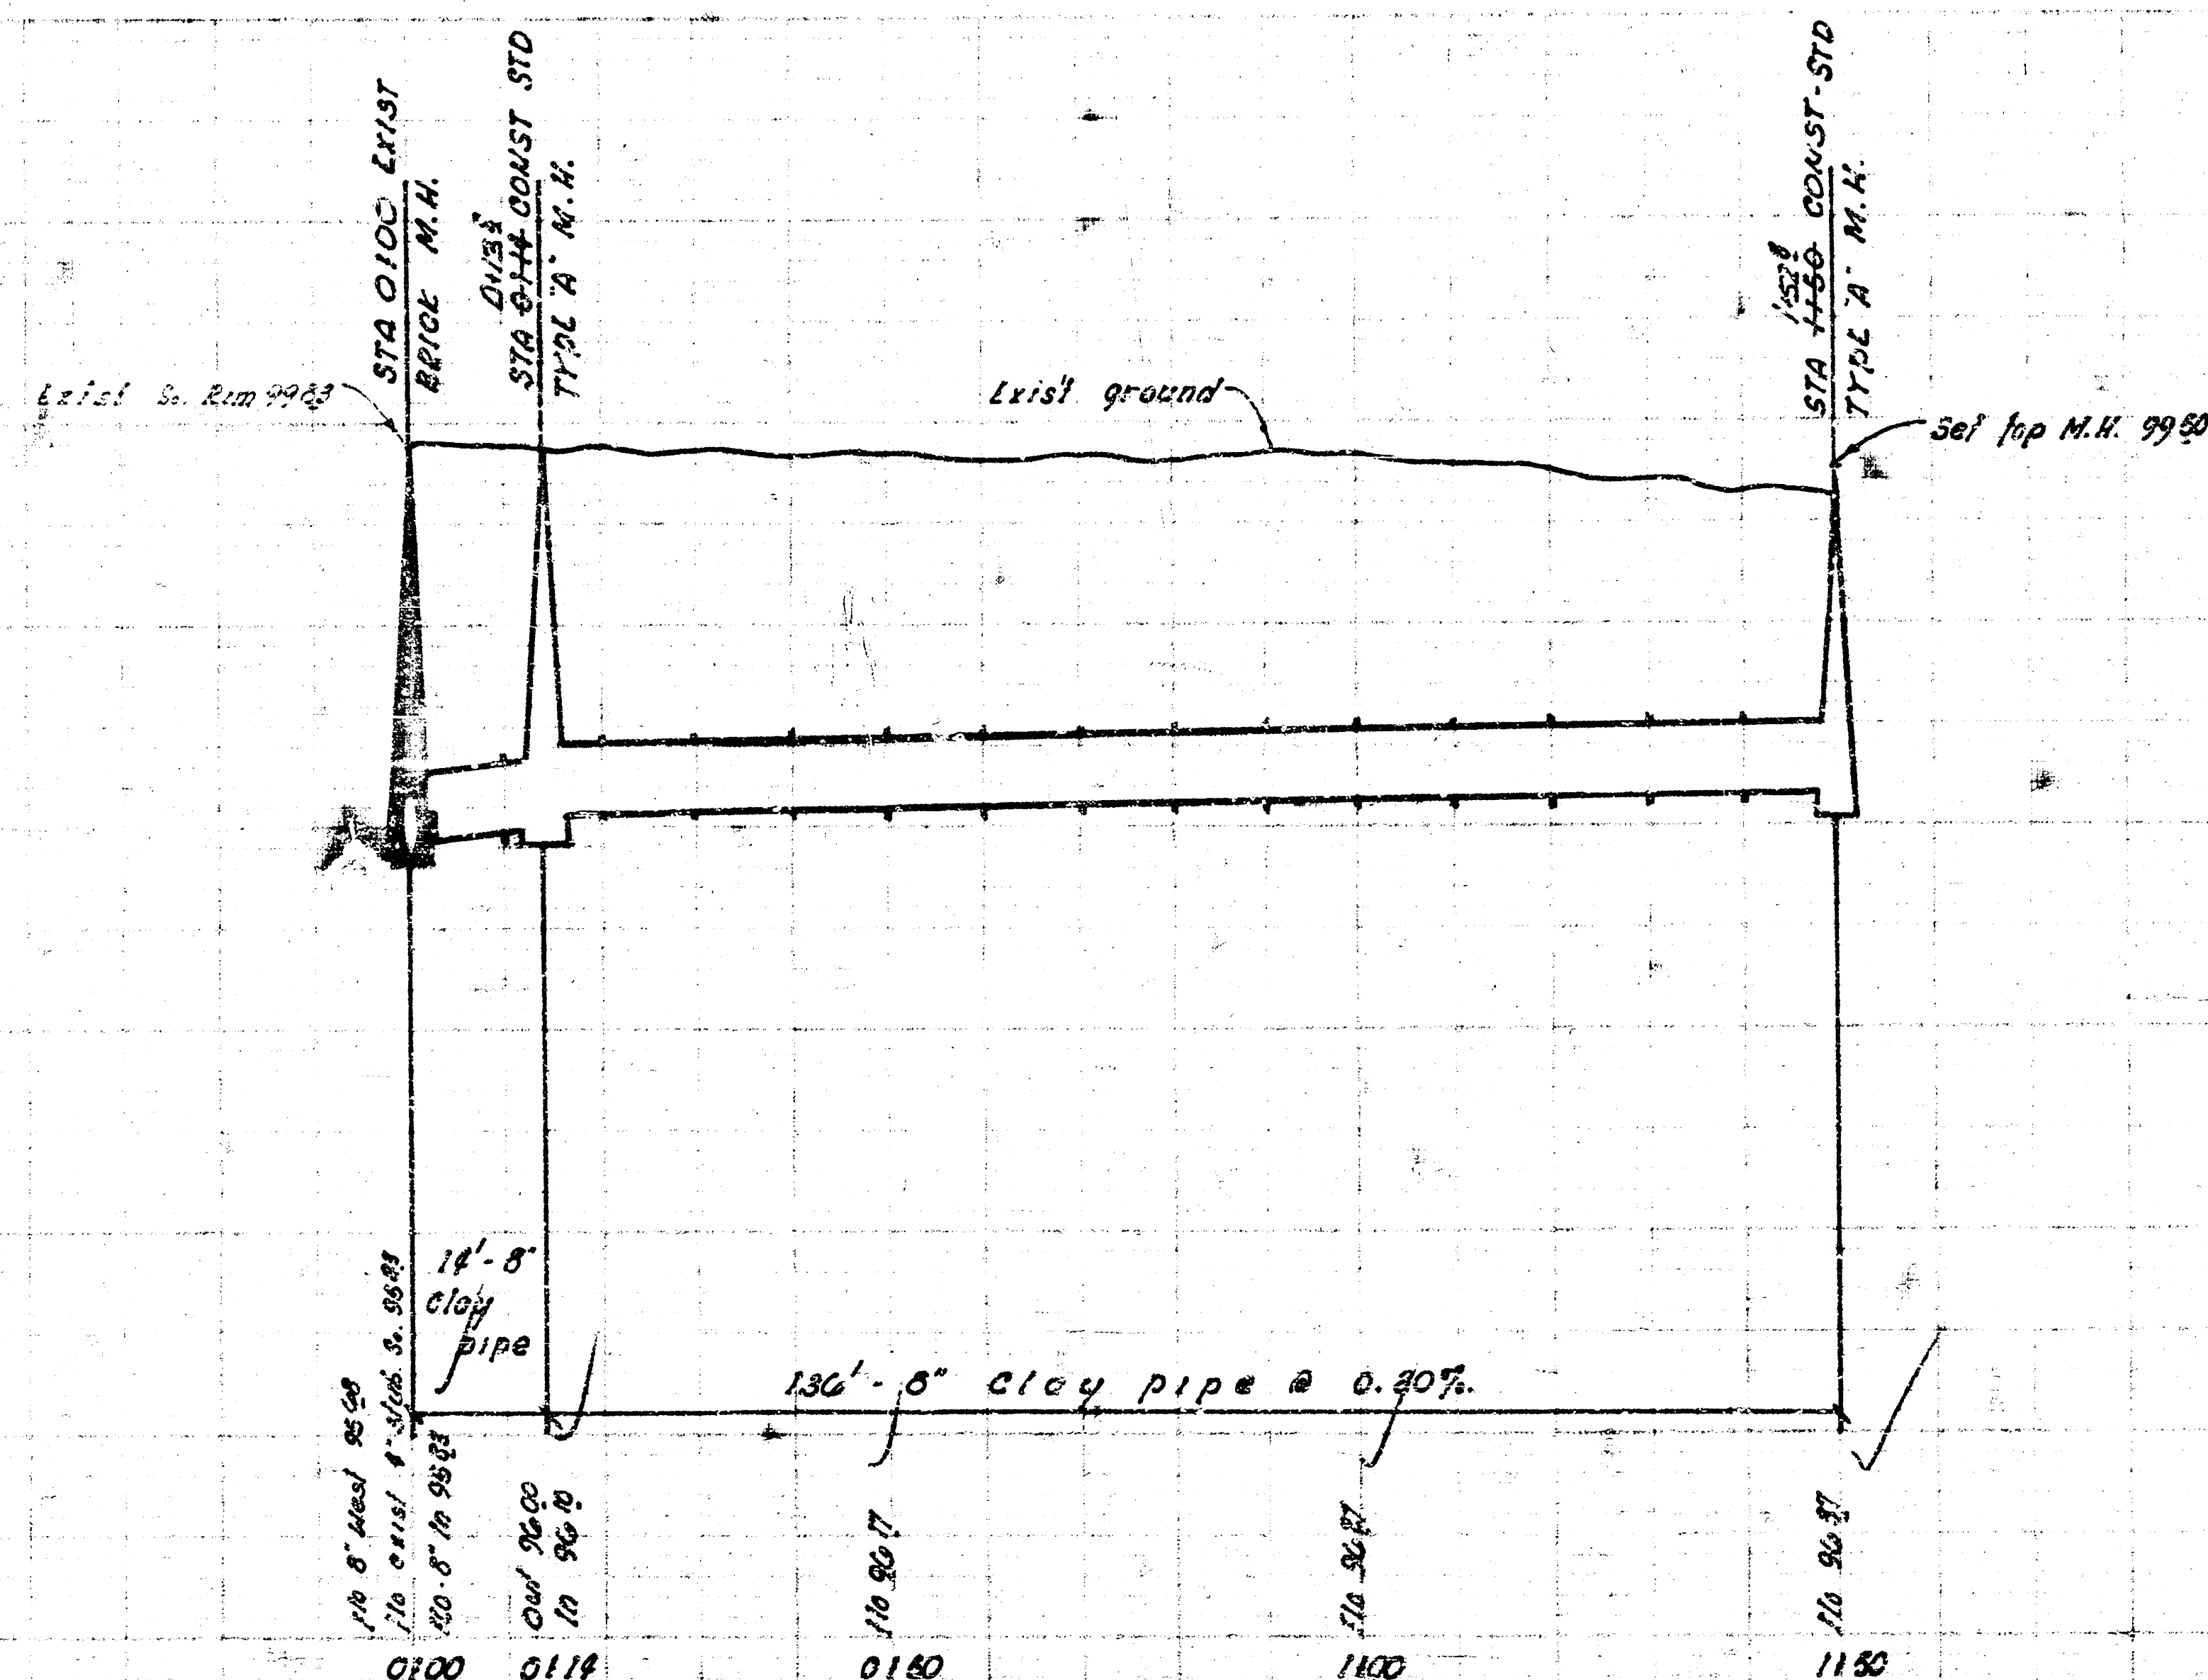

As BUILT 15 Sept 72 FINAL MEASUREMENT IN 245.4

SANITARY SEWER
N.W. COR of HILLSIDE & PAWNEE - MOBIL
OIL CO. (PRIVATE CONTRACT)
CITY OF WICHITA, KANSAS
R.W. LINN CITY ENGINEER
DATE SEPT. 1972 PROJ. # AARB 502038