

THE
LOYAL ORDER OF MOOSE

LODGE NO. 138

SANITARY SEWER

1958


EDIGER & COMPANY

Consulting Engineers & Architects

WICHITA, KANSAS

INDEX

- 1 SEWER DETAILS
- 2 PLAN & PROFILE
- 3 PLAN & PROFILE
- 4 PLAN & PROFILE

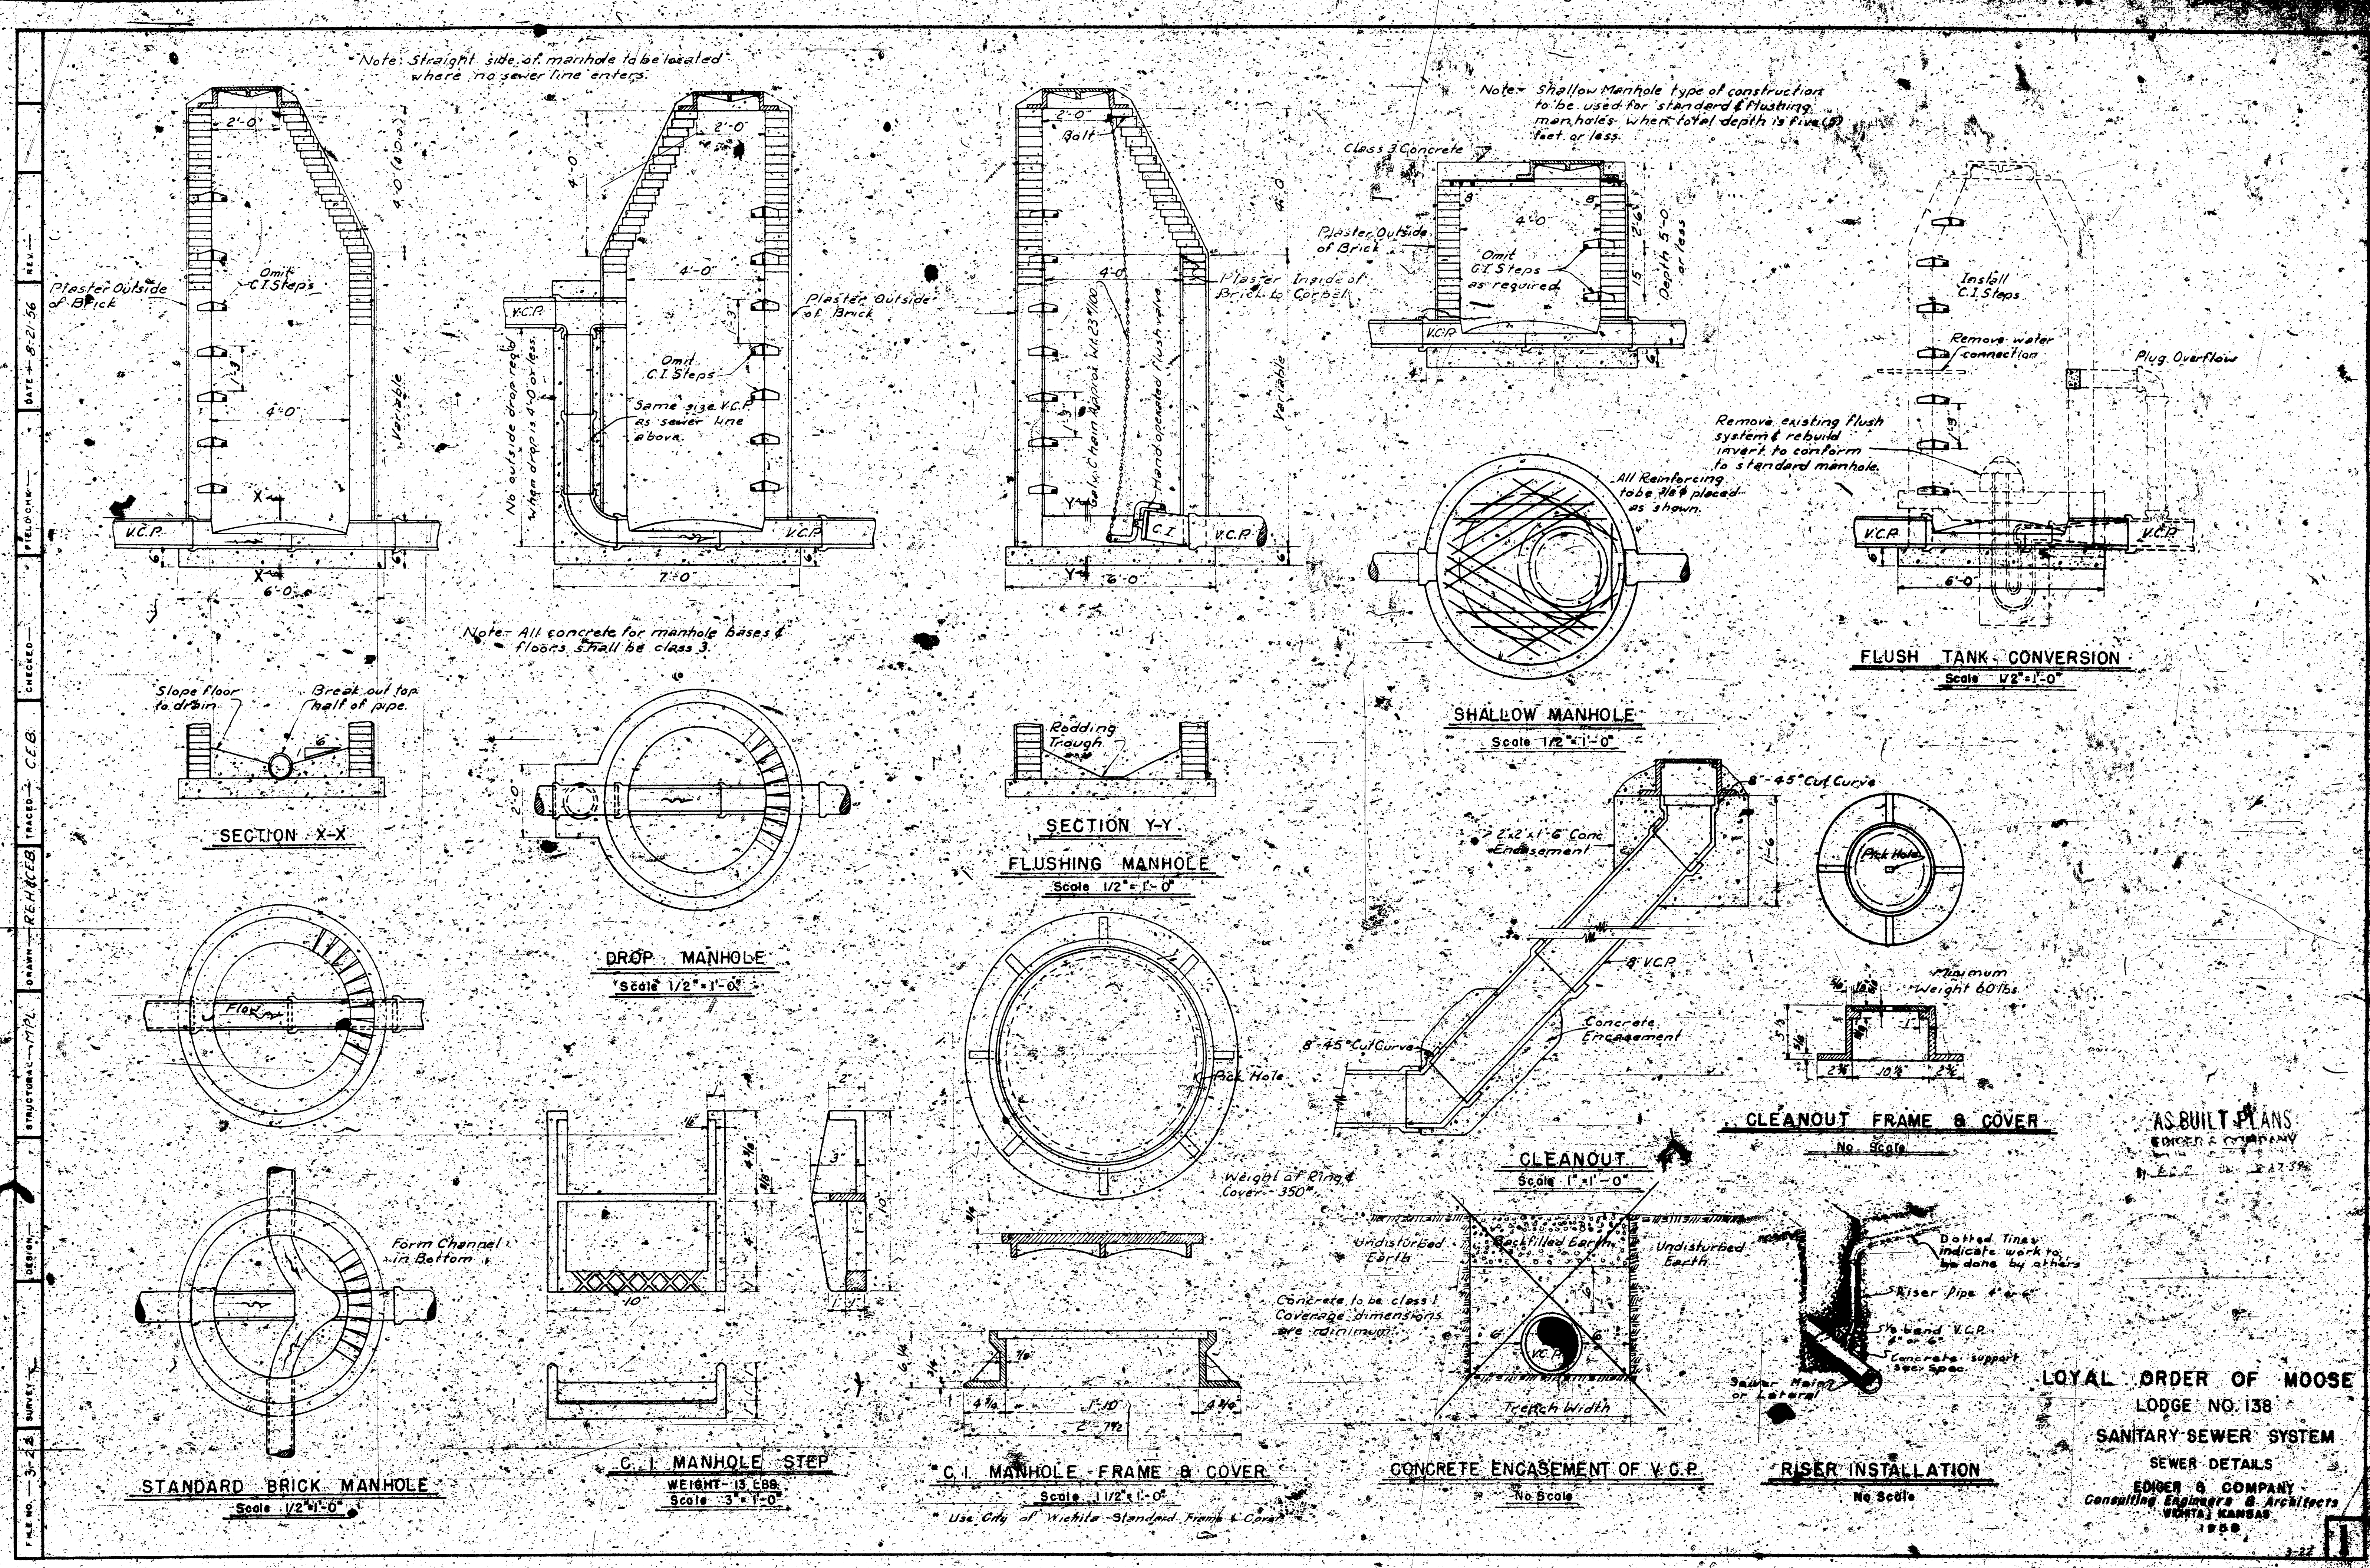

AS-BUILT PLANS
EDGER & COMPANY
No. 227-376


LOYAL ORDER OF MOOSE
LODGE NO. 138
SANITARY SEWER SYSTEM
SEWER DETAILS
EDGER & COMPANY
Consulting Engineers & Architects
WICHITA, KANSAS
1958



LOYAL ORDER OF MOOSE
LODGE NO. 136
SANITARY SEWER SYSTEM
PLAN & PROFILE
EDGES & COMPANY
Consulting Engineers & Architects
WINNAP, KANSAS
1958


PLAN
 NOTE BOOK
 NO.

PROFILE
 NOTE BOOK
 NO.

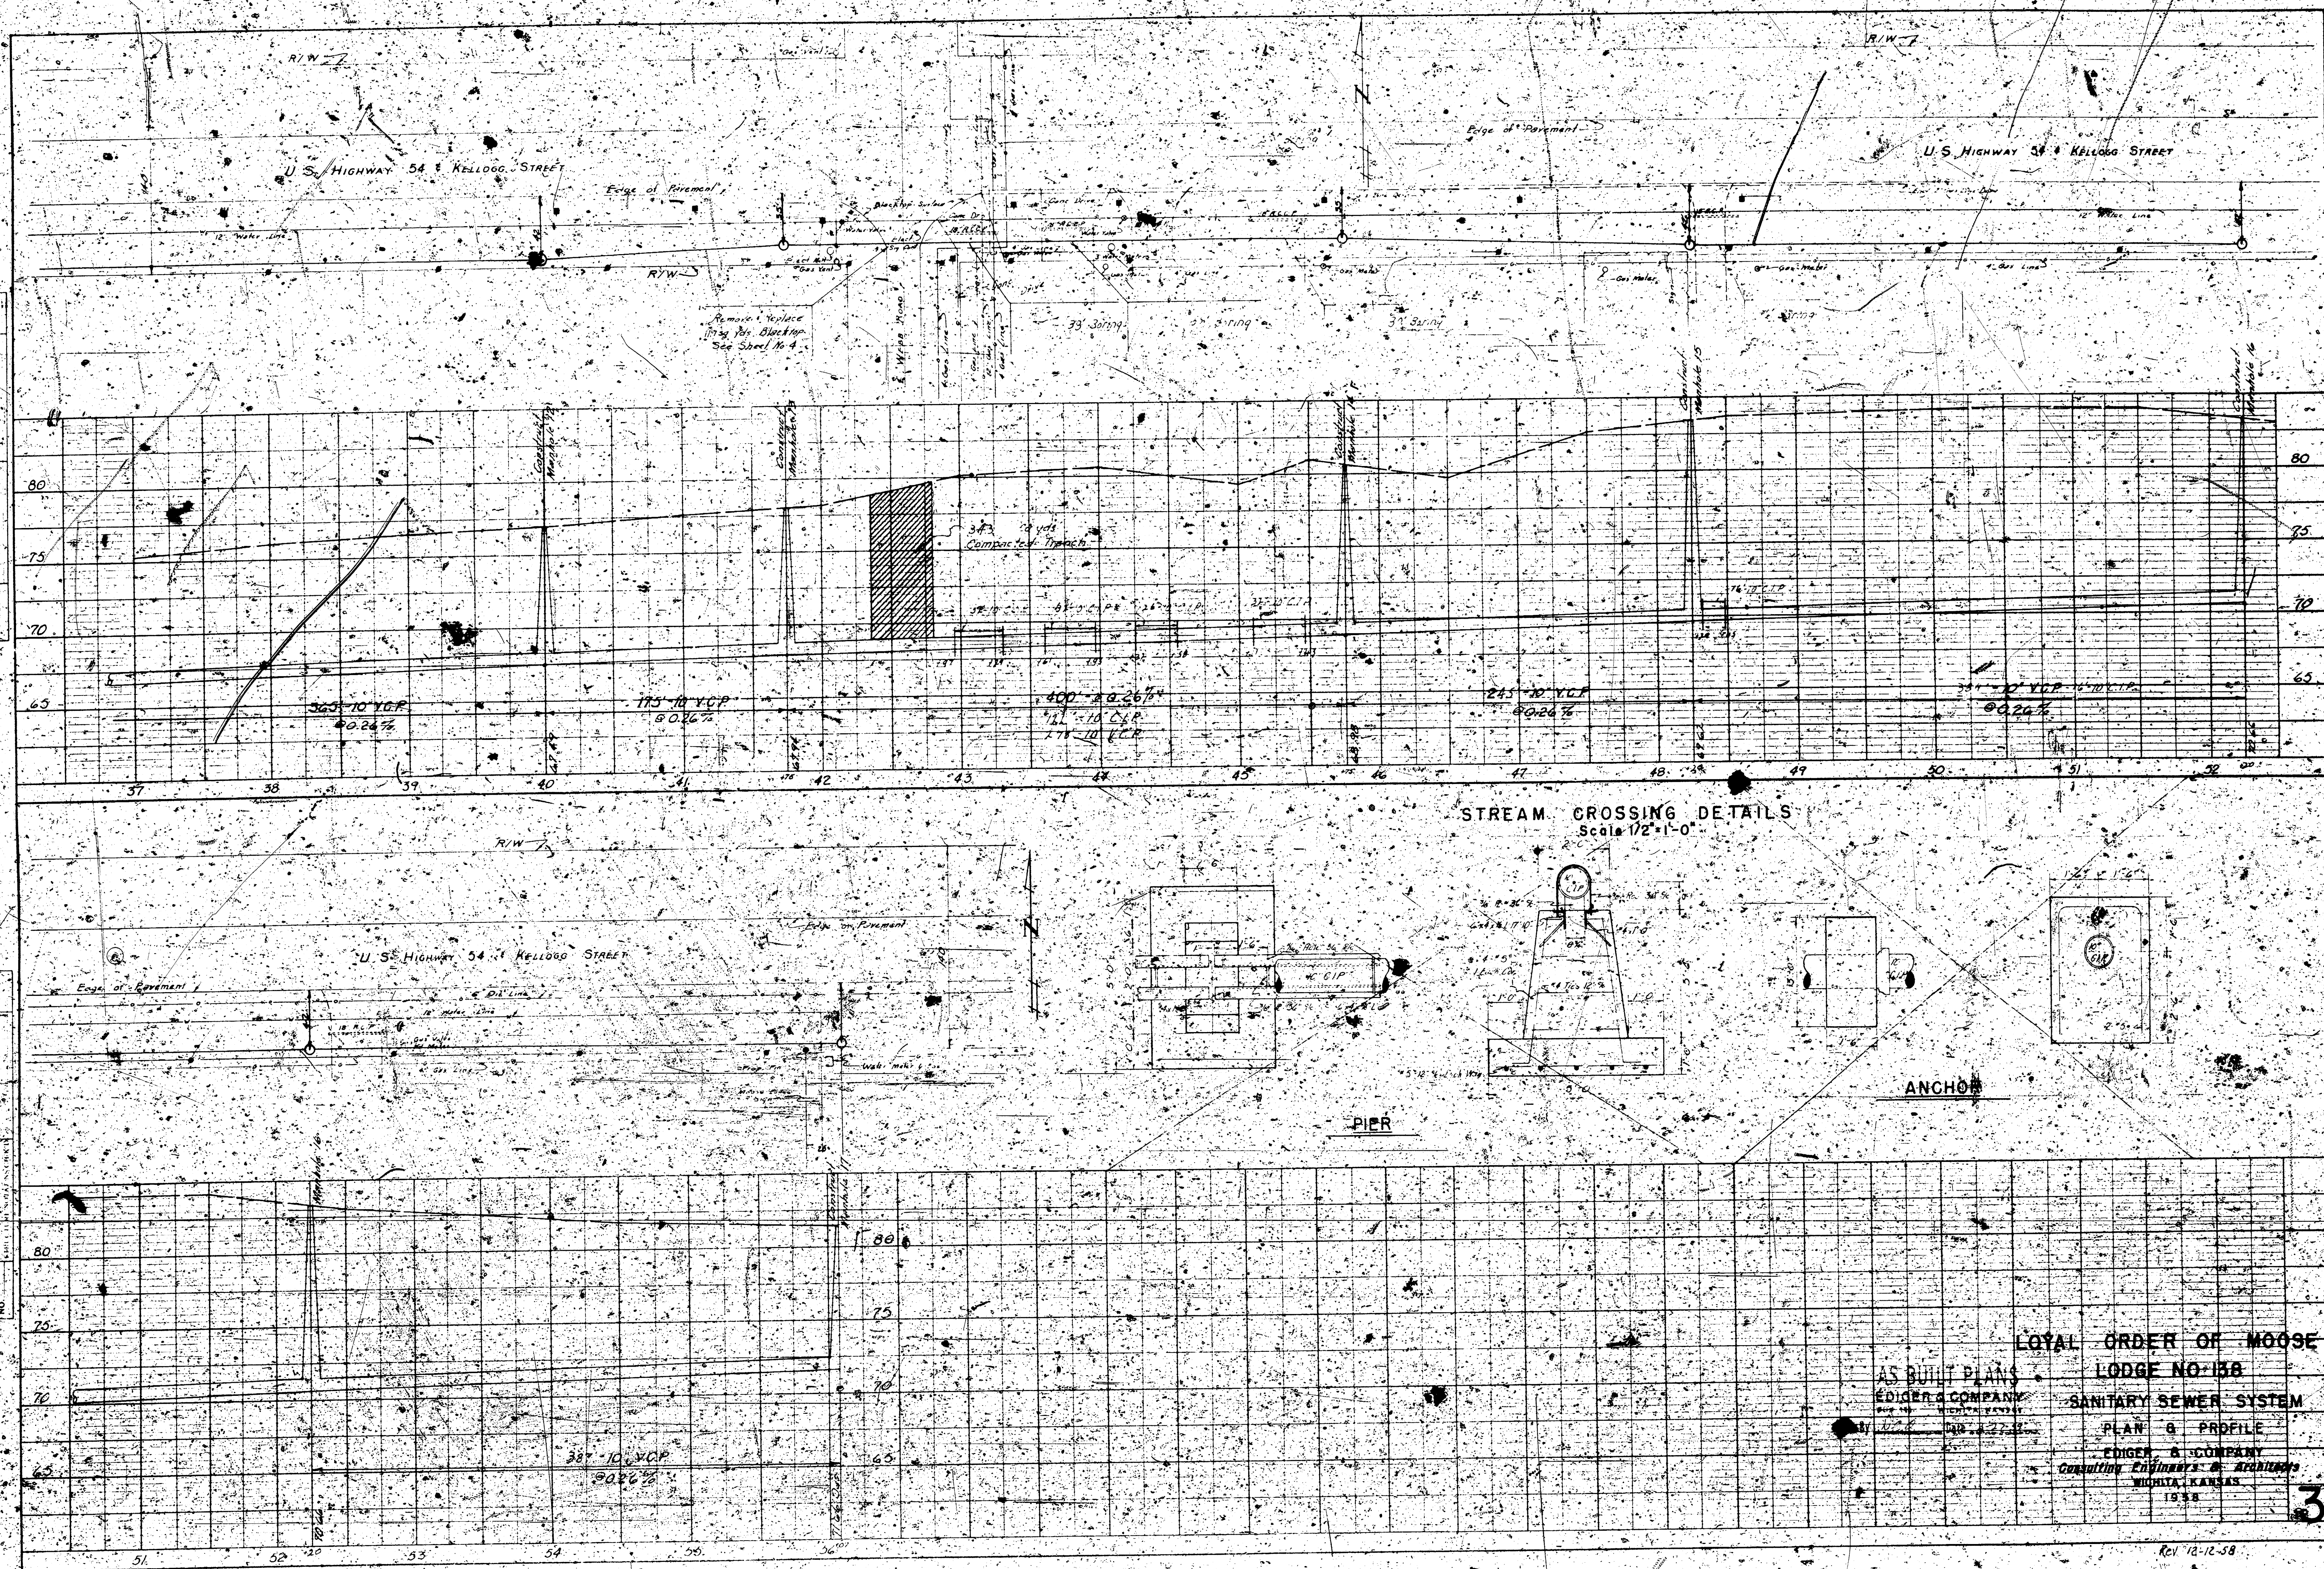

STREAM CROSSING DETAILS
 Scale 1/2" = 1'-0"

LOYAL ORDER OF MOOSE
 LODGE NO. 138
 SANITARY SEWER SYSTEM
 PLAN & PROFILE
 EDGER & COMPANY
 Consulting Engineers & Architects
 WICHITA, KANSAS
 1938

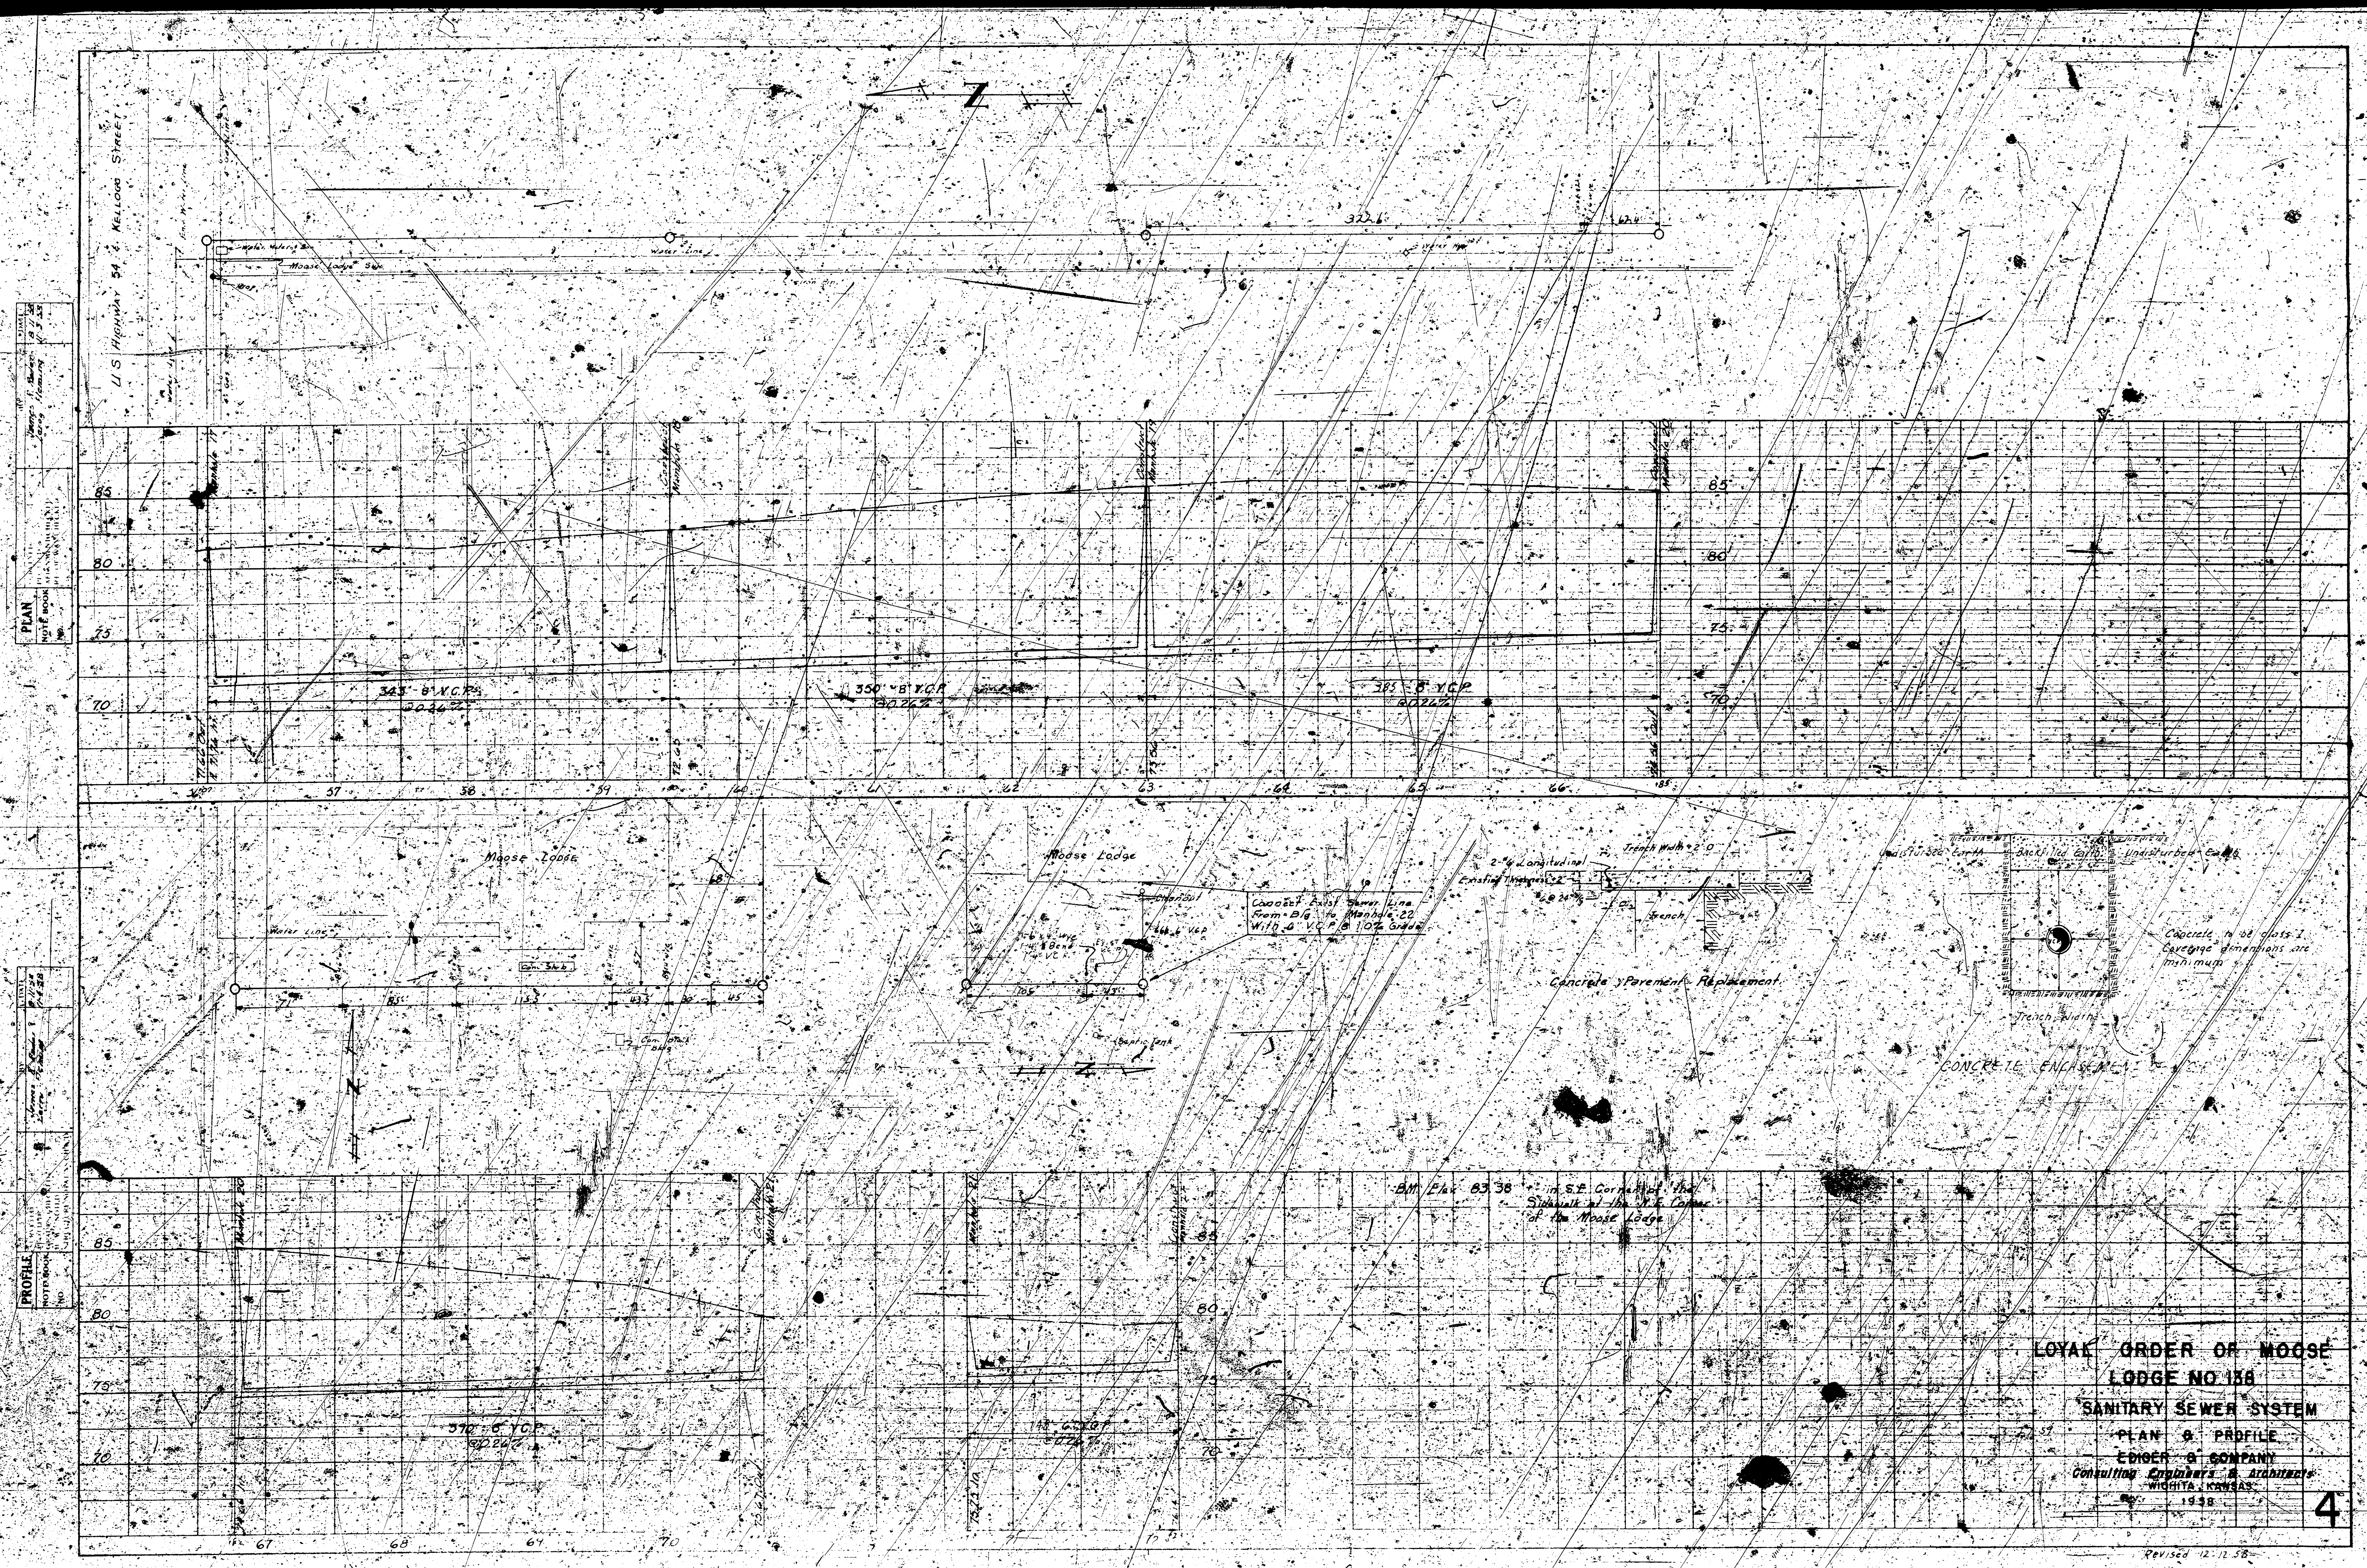

LOYAL ORDER OF MOOSE
LODGE NO 138

SANITARY SEWER SYSTEM

PLAN & PROFILE

EDISON & COMPANY
CONSULTING ENGINEERS & ARCHITECTS
WHEELING, MONTGOMERY

1938

4

Revised 12-11-38