

AS CONSTRUCTED


SANITARY SEWER AND FORCE MAIN

SERVING

THE MOORINGS ADDITION

REISS & GOODNESS ENGINEERS
2100 WEST 21ST STREET
WICHITA, KANSAS 67203
(316) 832-0283

DATE: 8-7-78

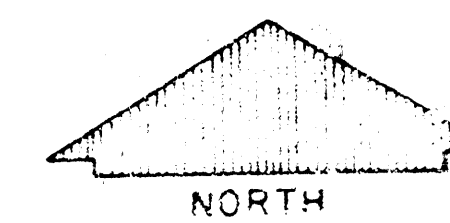

SCALE 1" = 300'

