



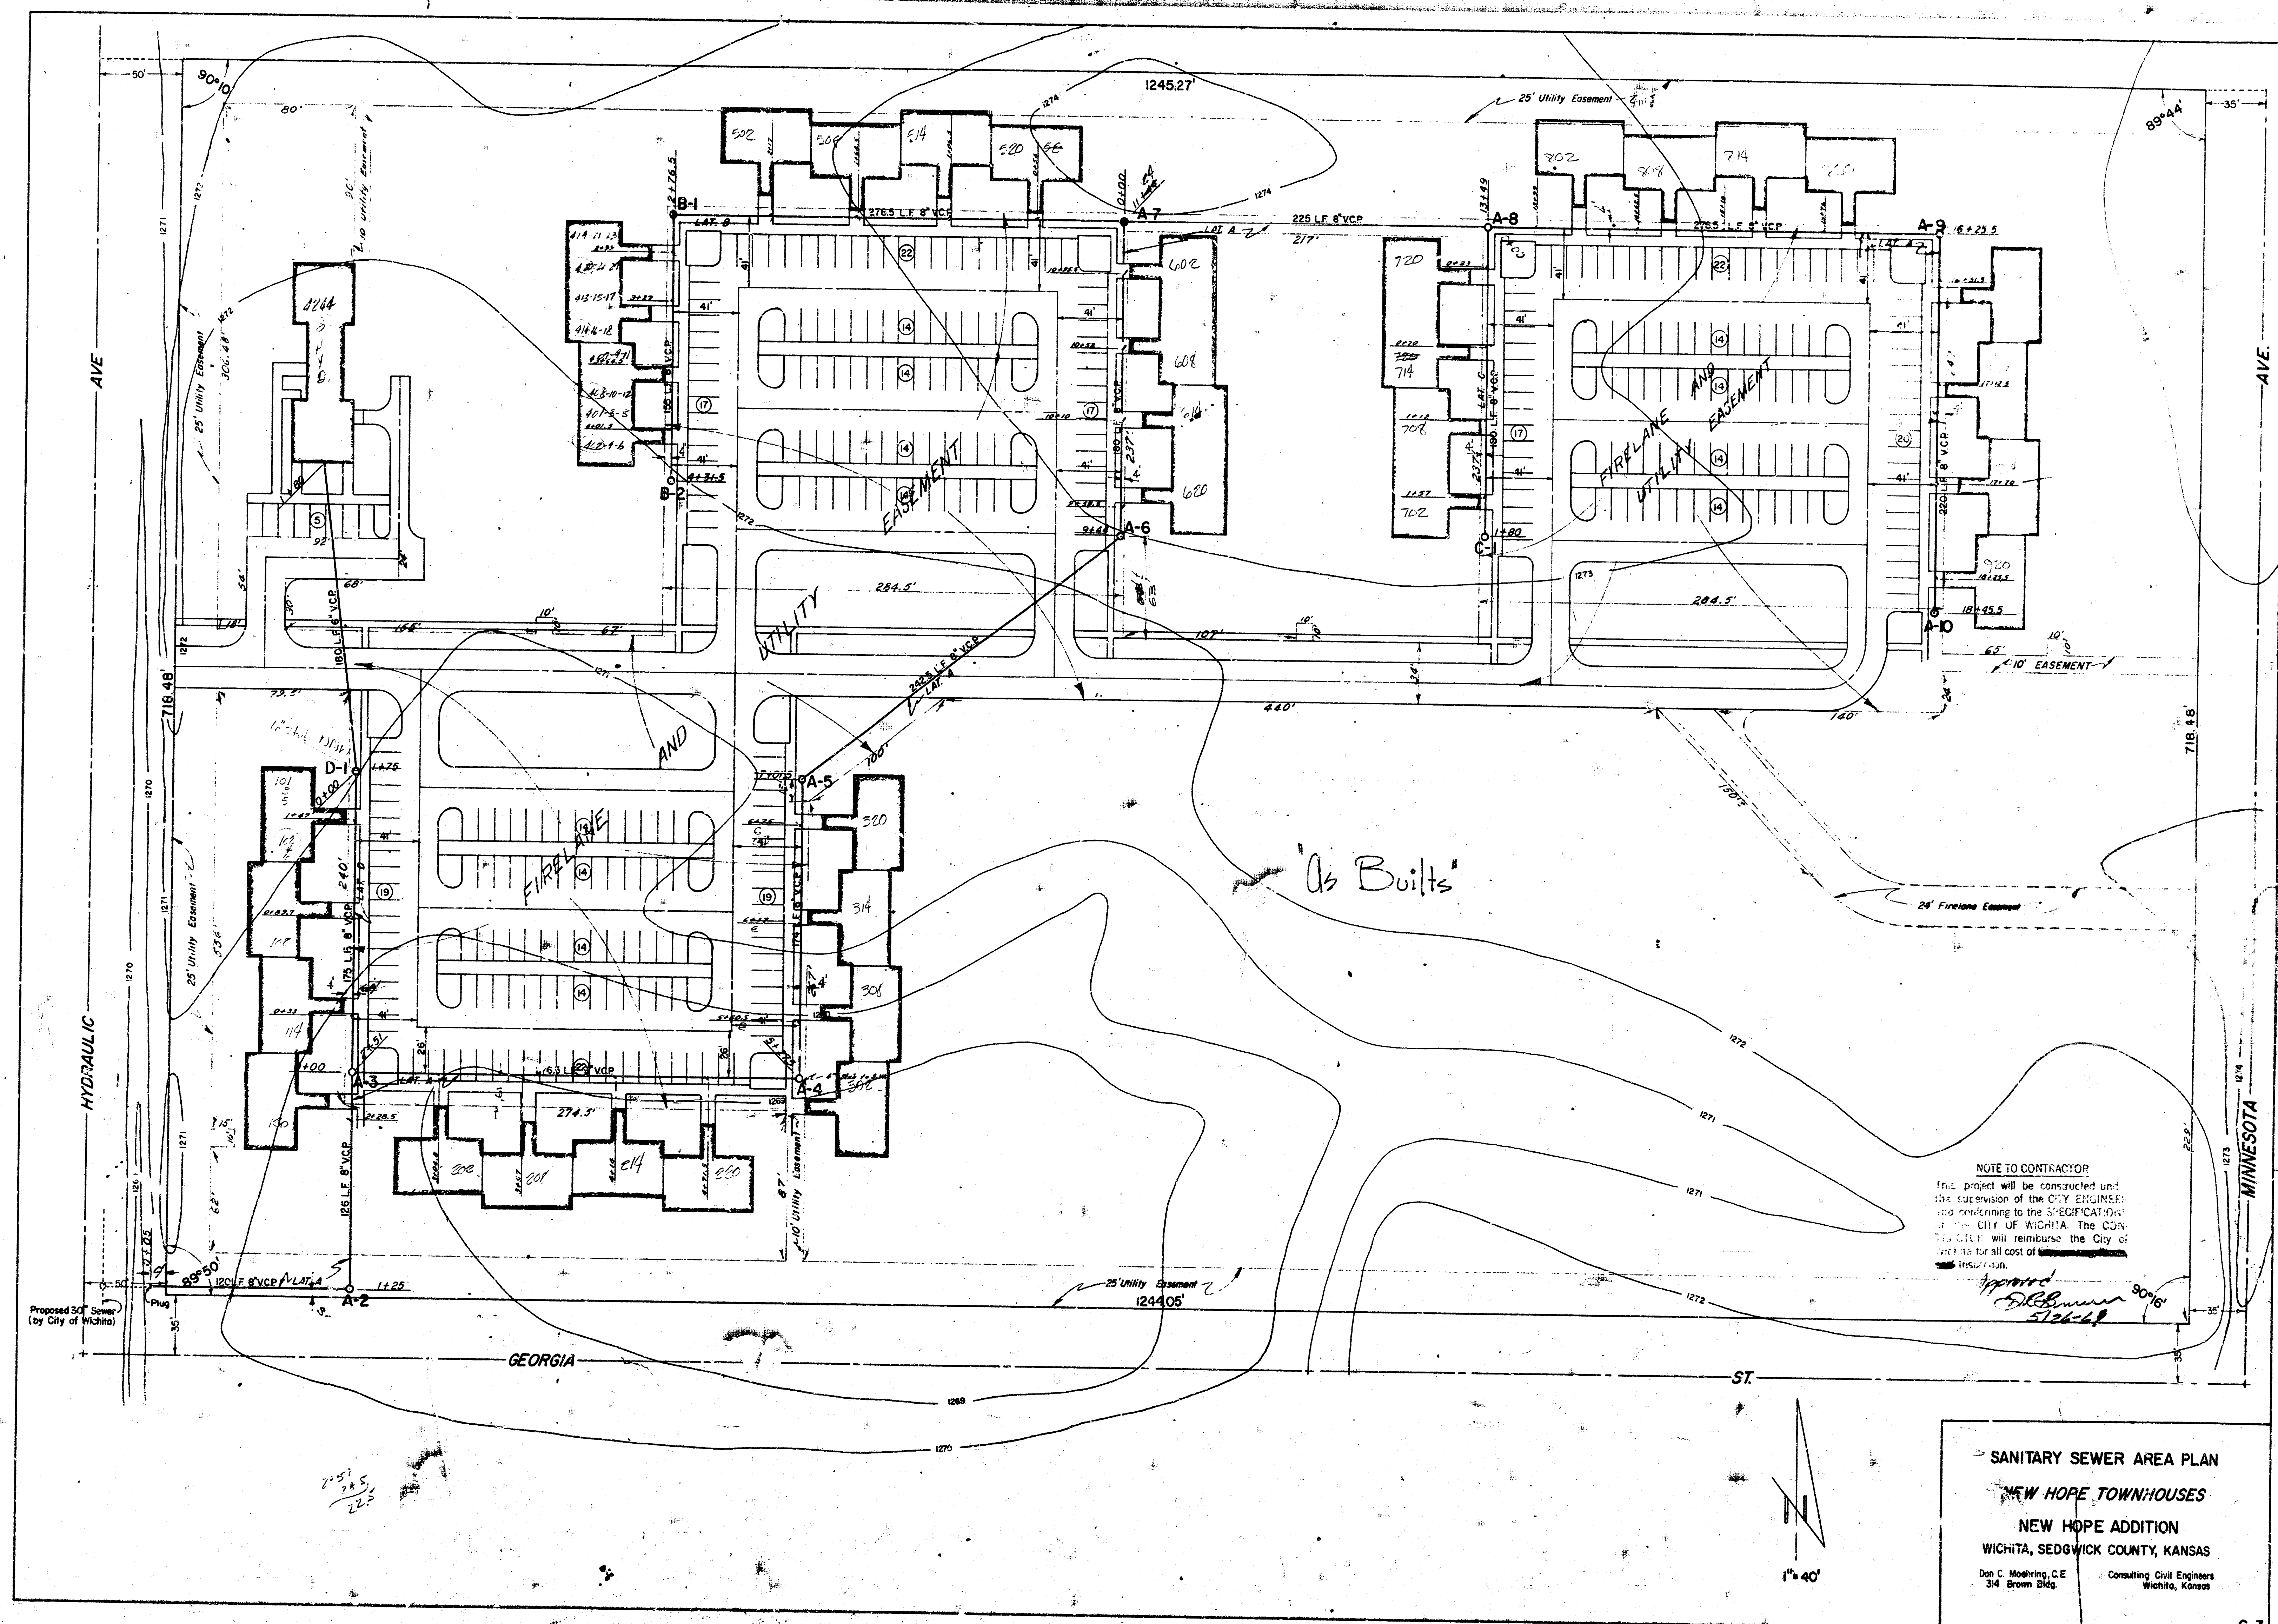

PLAN
 DATE: _____ BY: _____
 CHECKED: _____
 NOTE: BOOK NO. OF WAY CHECKED

PROFILE
 DATE: _____ BY: _____
 CHECKED: _____
 NOTE: BOOK NO. OF WAY CHECKED

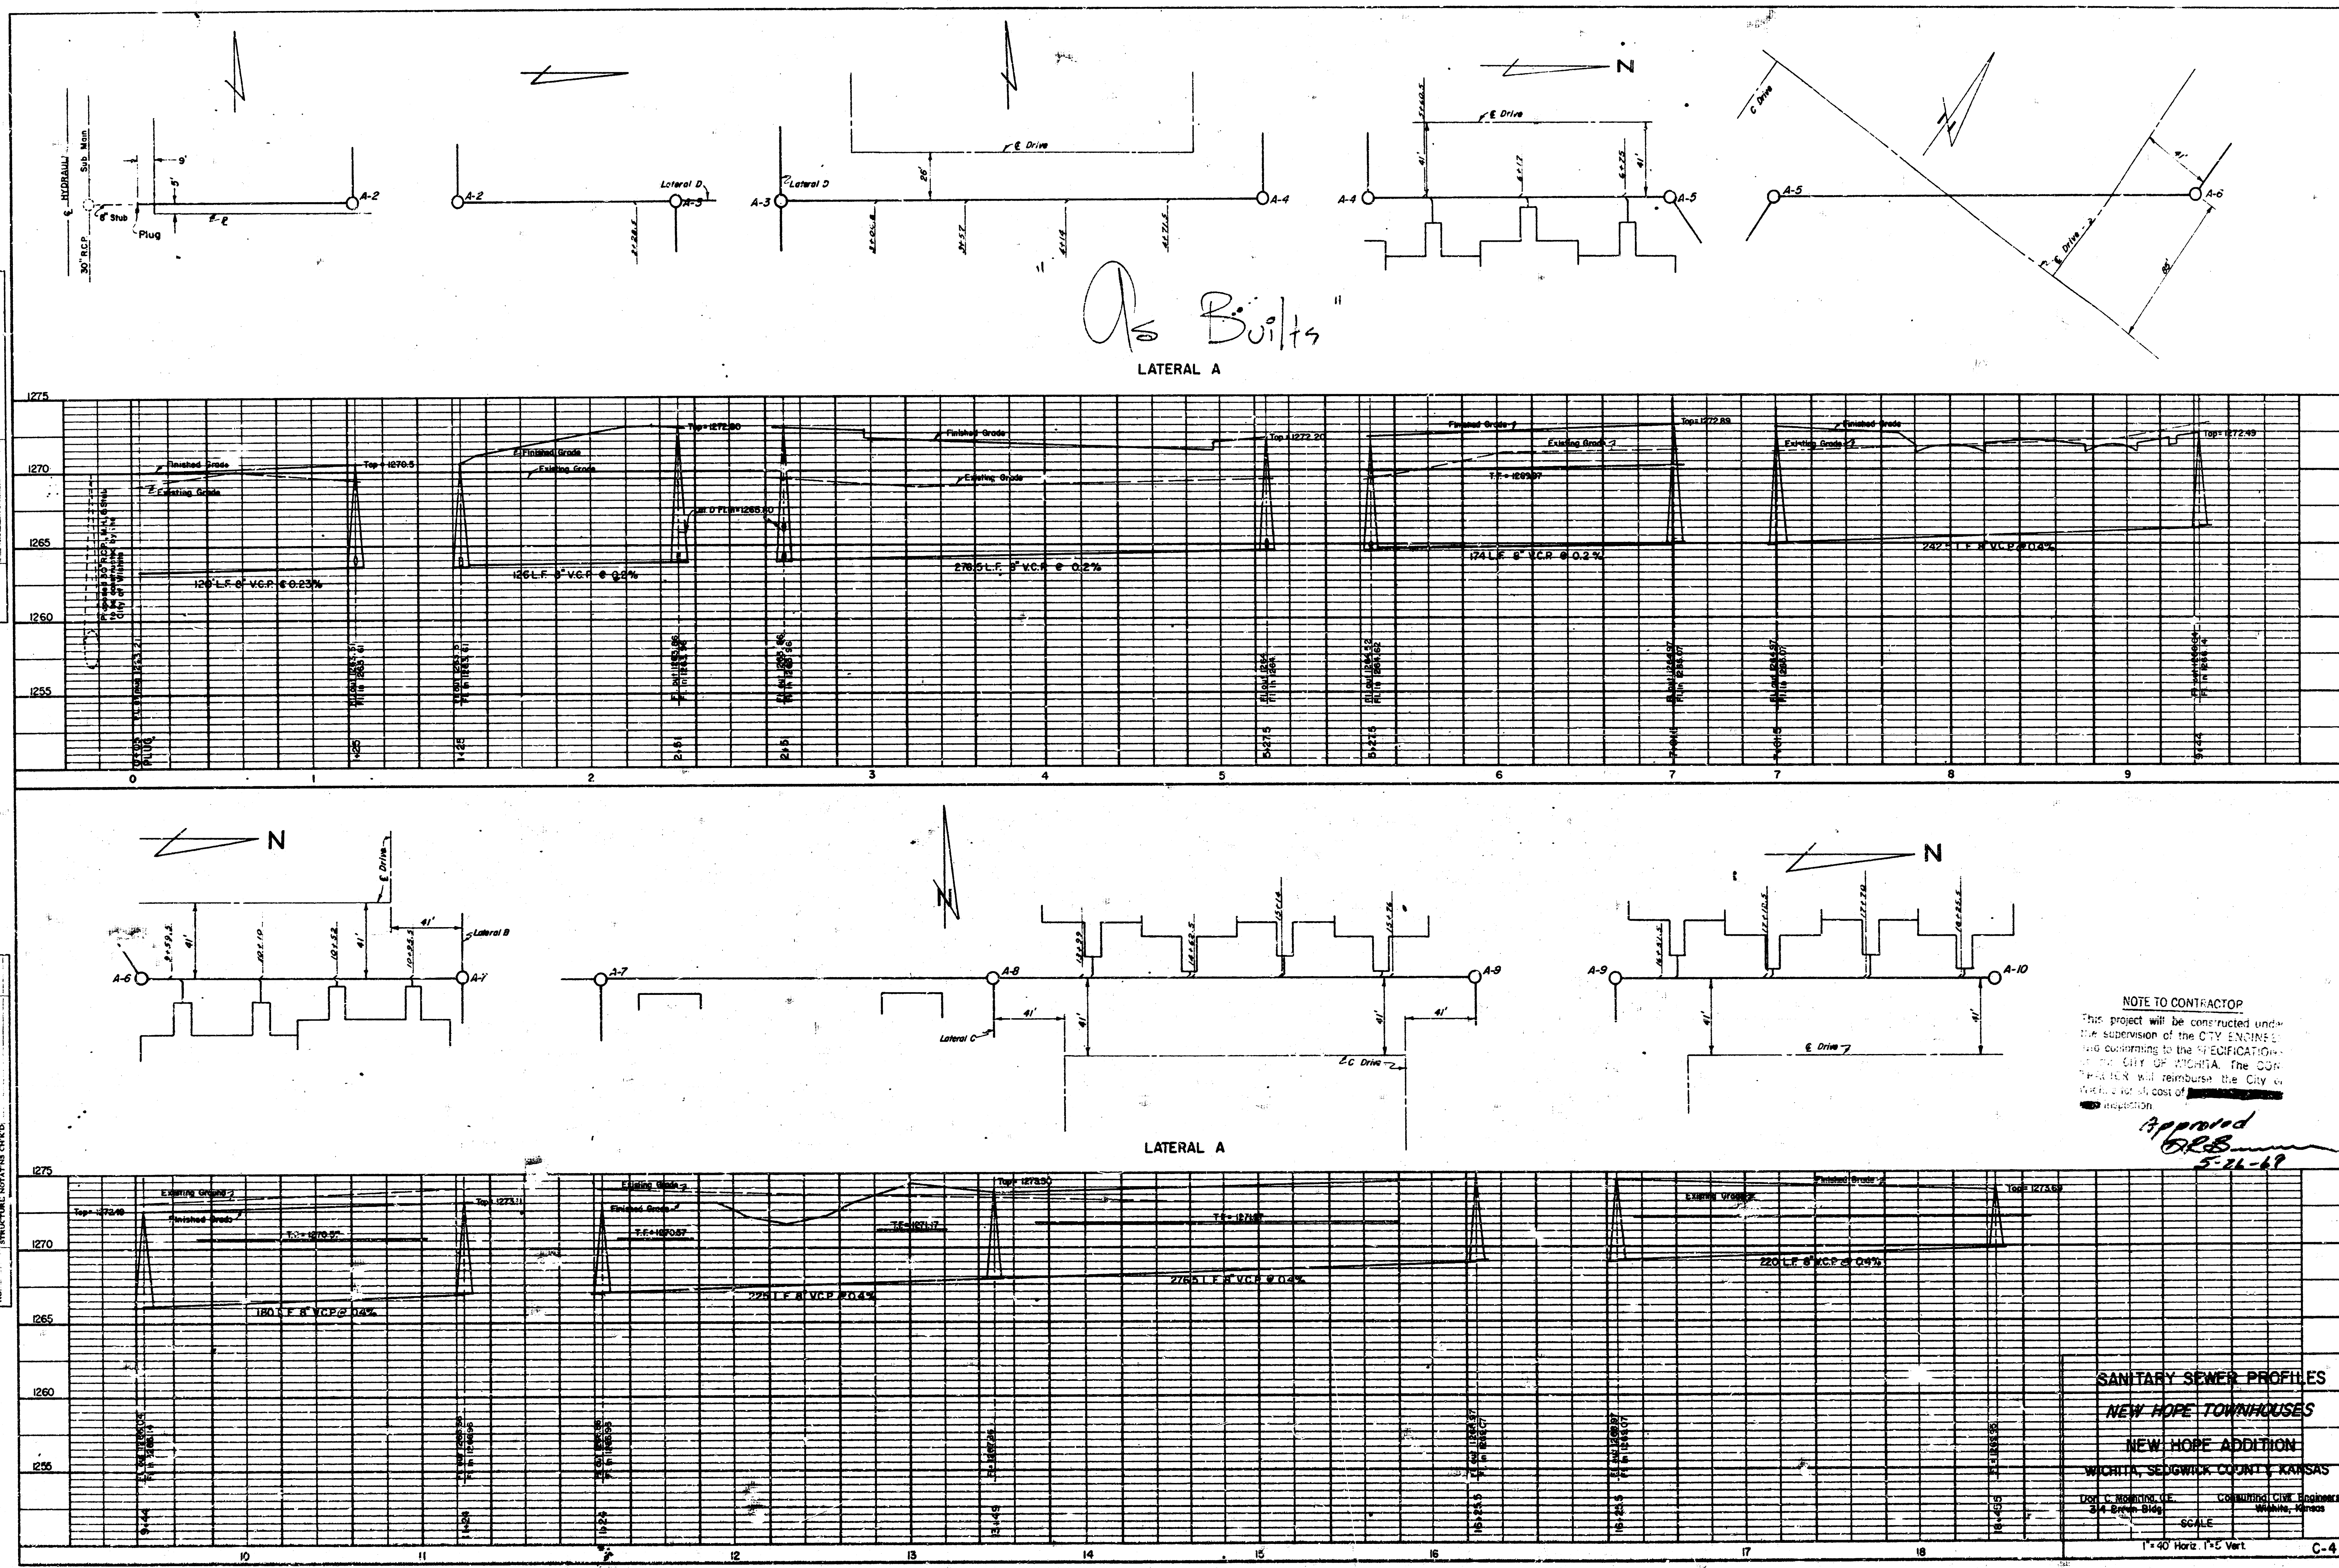

As Built
 LATERAL A

PLAN

DATE: _____ BY: _____

PROJECT: _____

NOTE: WORK IS TO BE COMPLETED BY _____

NO. _____


PROFILE


DATE: _____ BY: _____

PROJECT: _____


NOTE: WORK IS TO BE COMPLETED BY _____

NO. _____

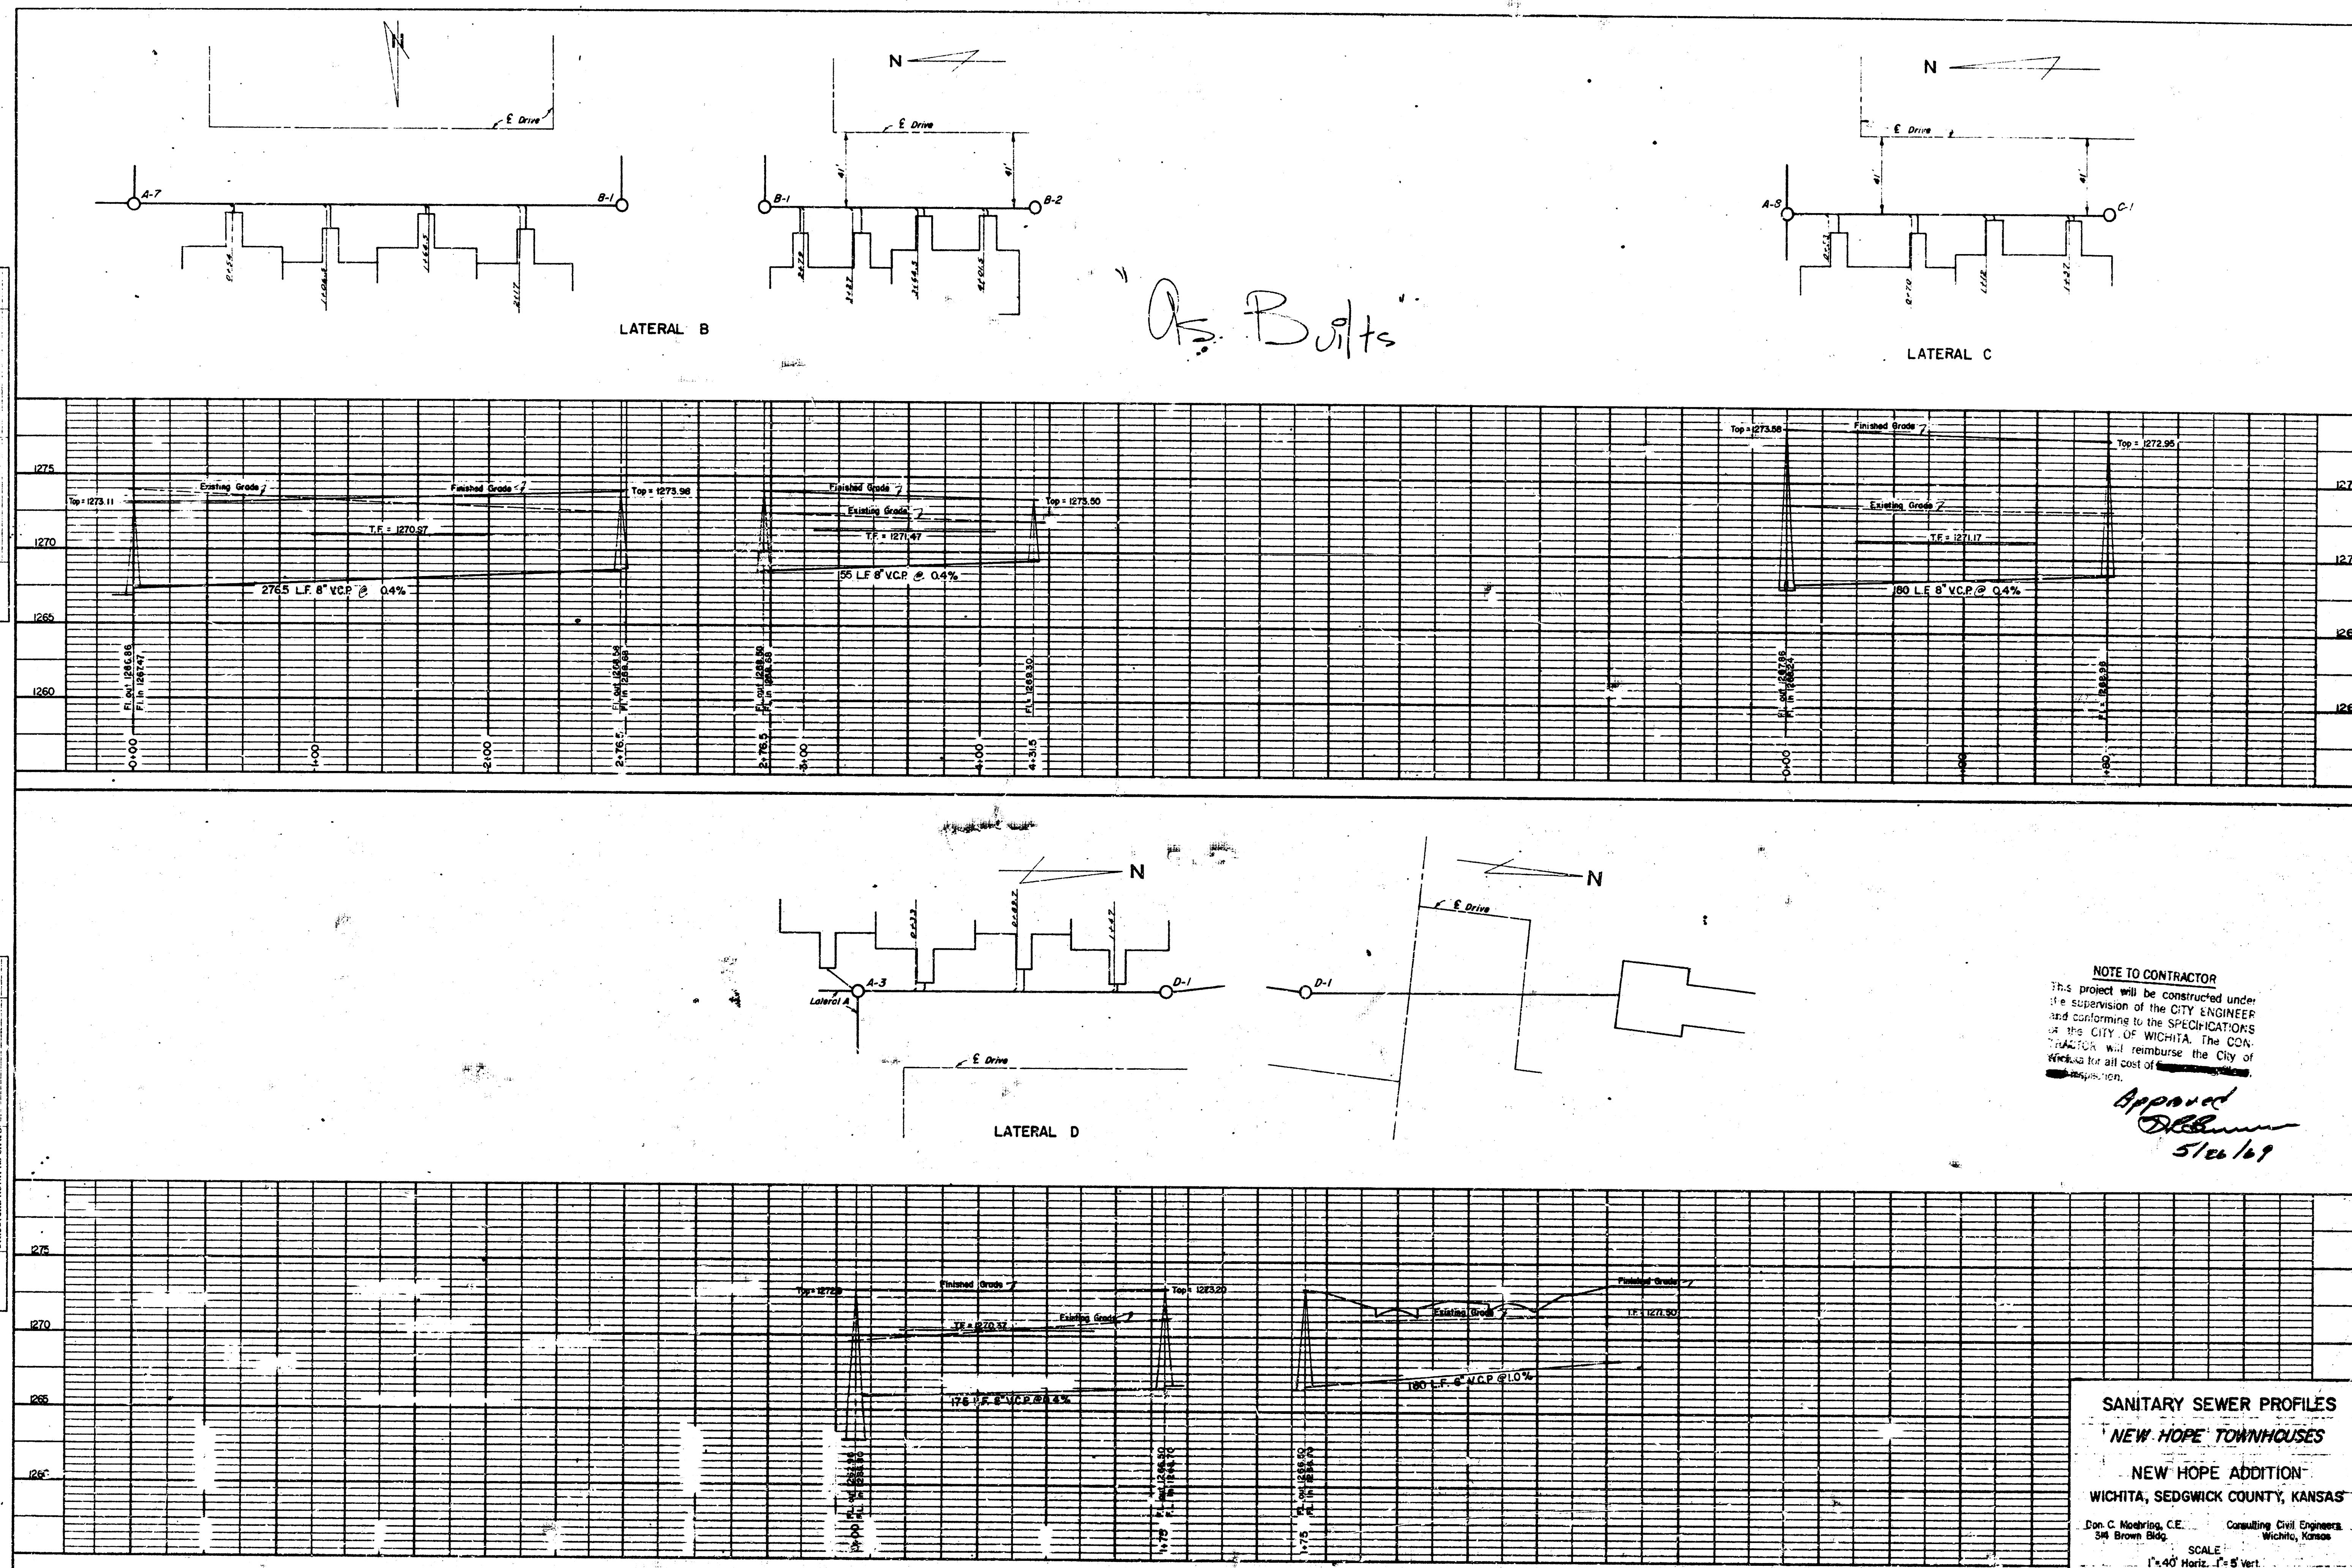


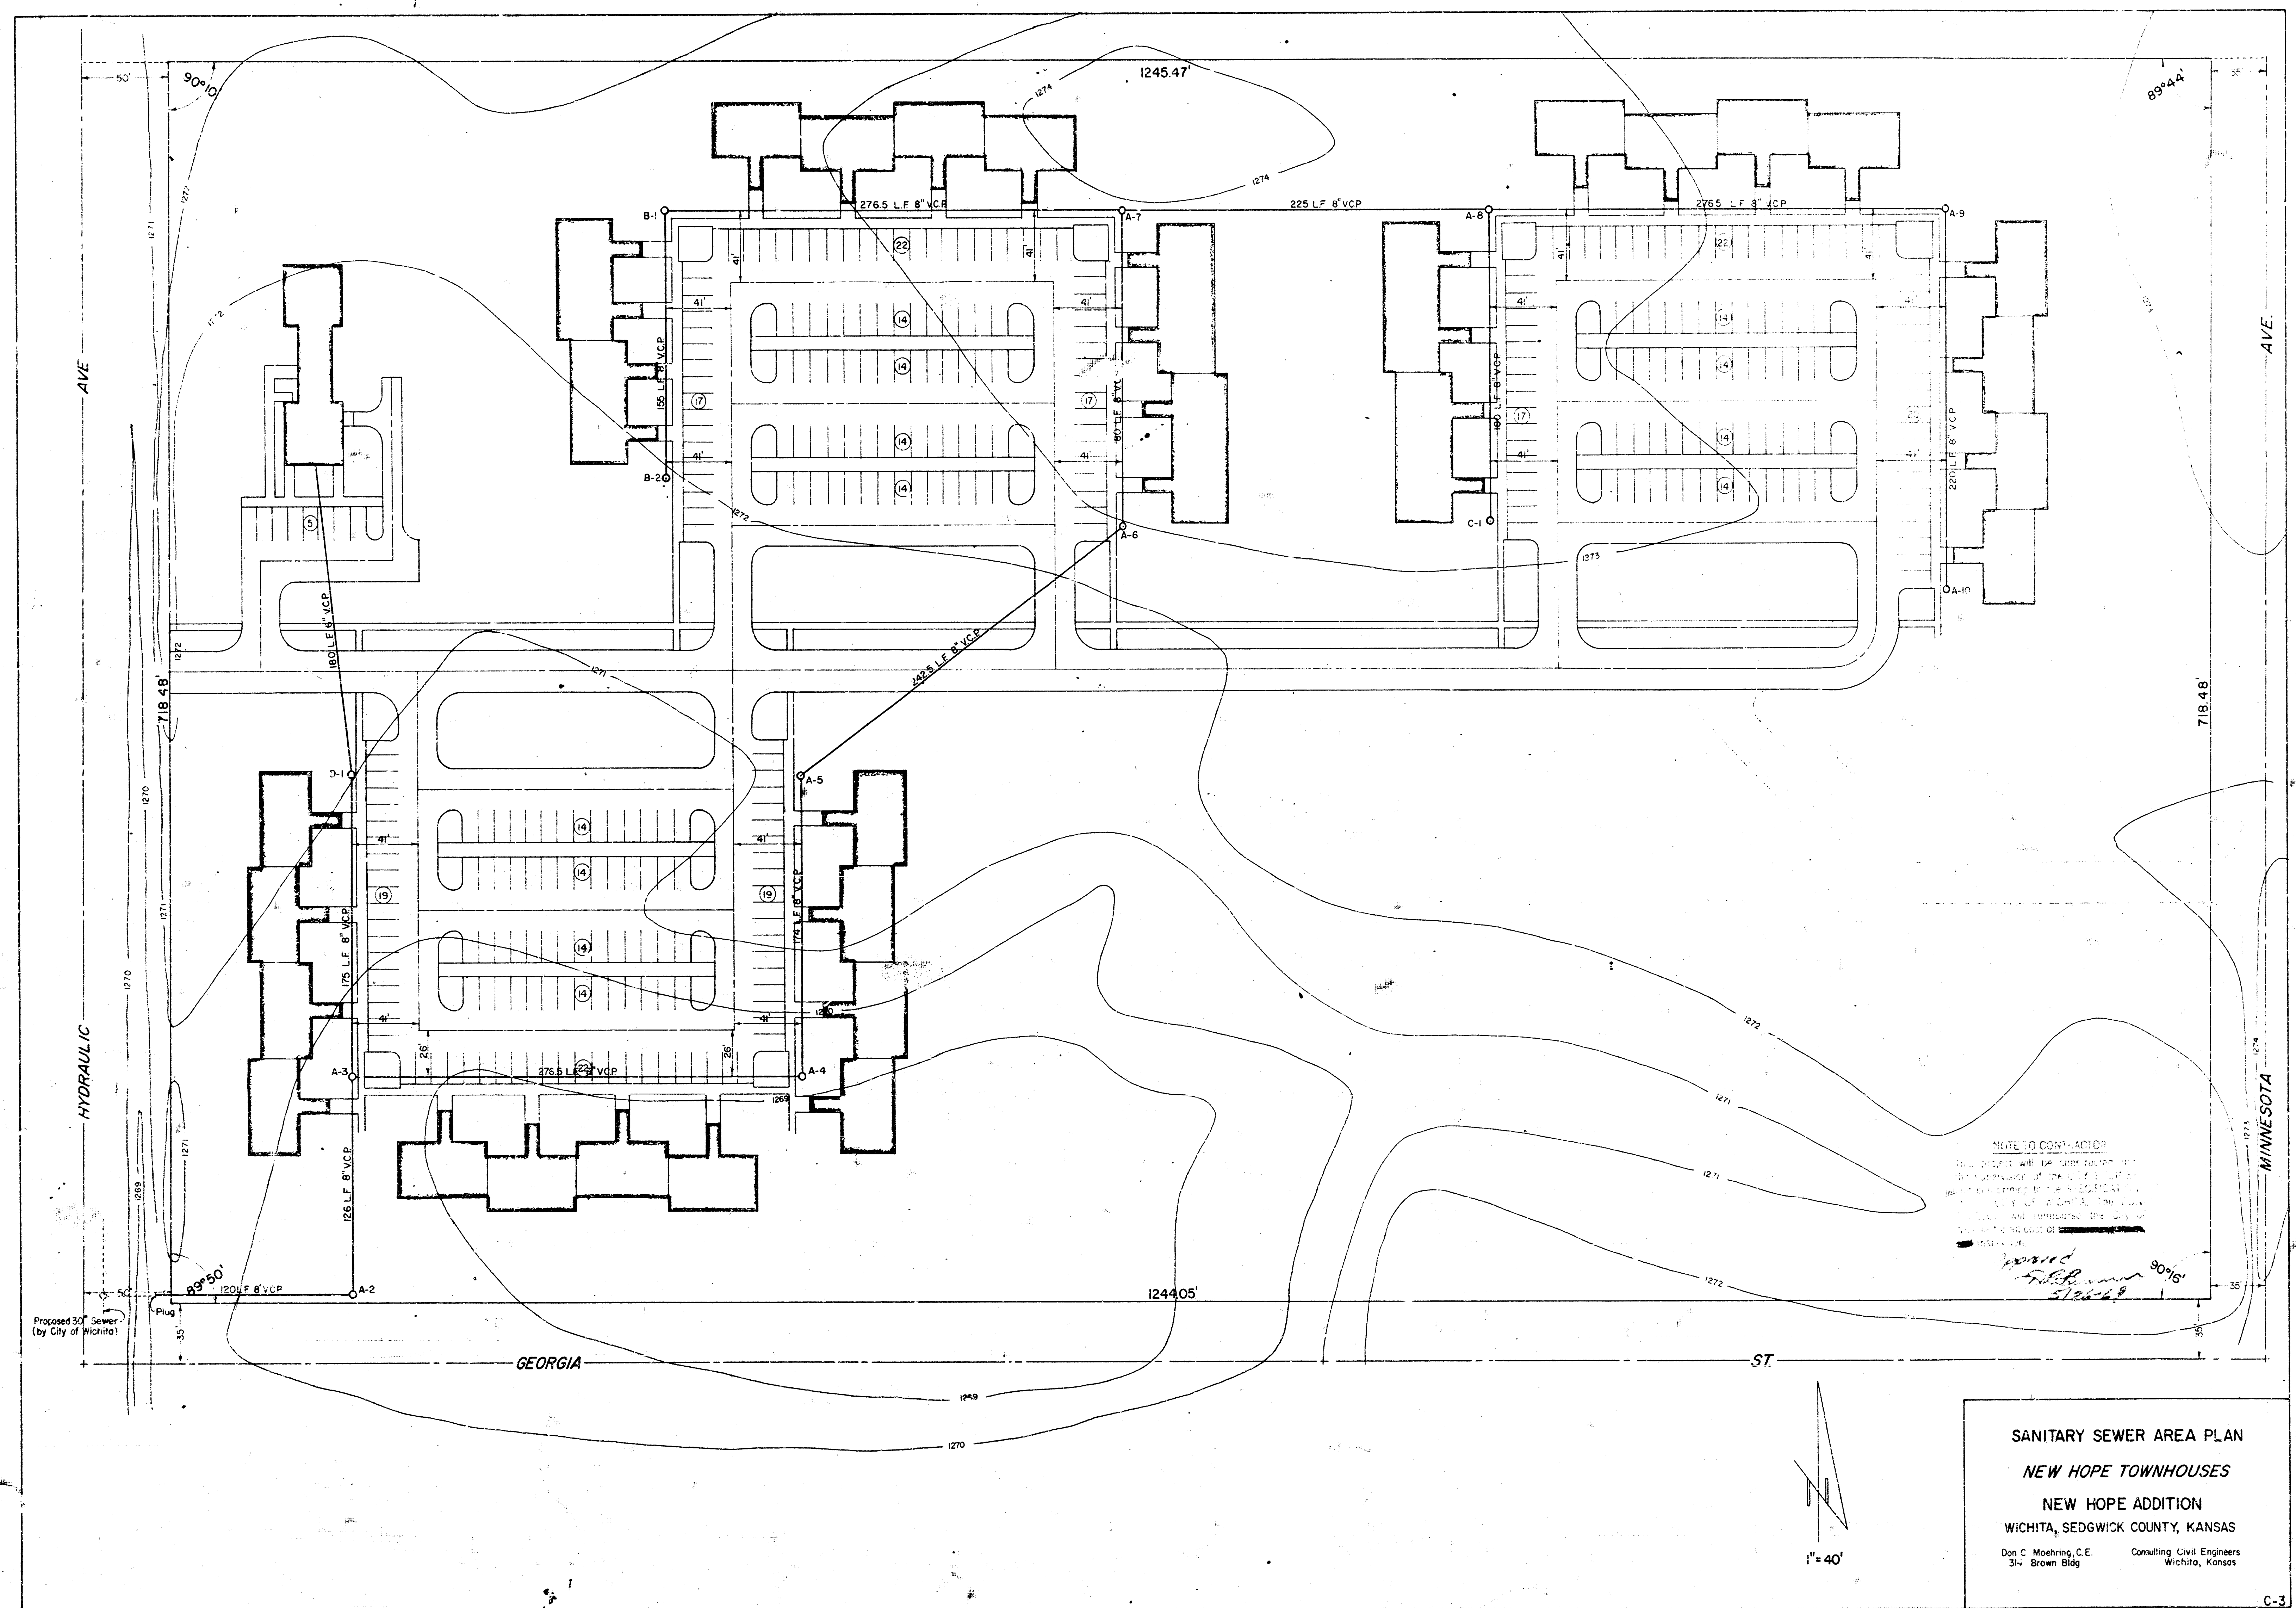


PLAN
 SANITARY SEWER
 NEW HOPE TOWNHOUSES
 NEW HOPE ADDITION
 WICHITA, SEDGWICK COUNTY, KANSAS

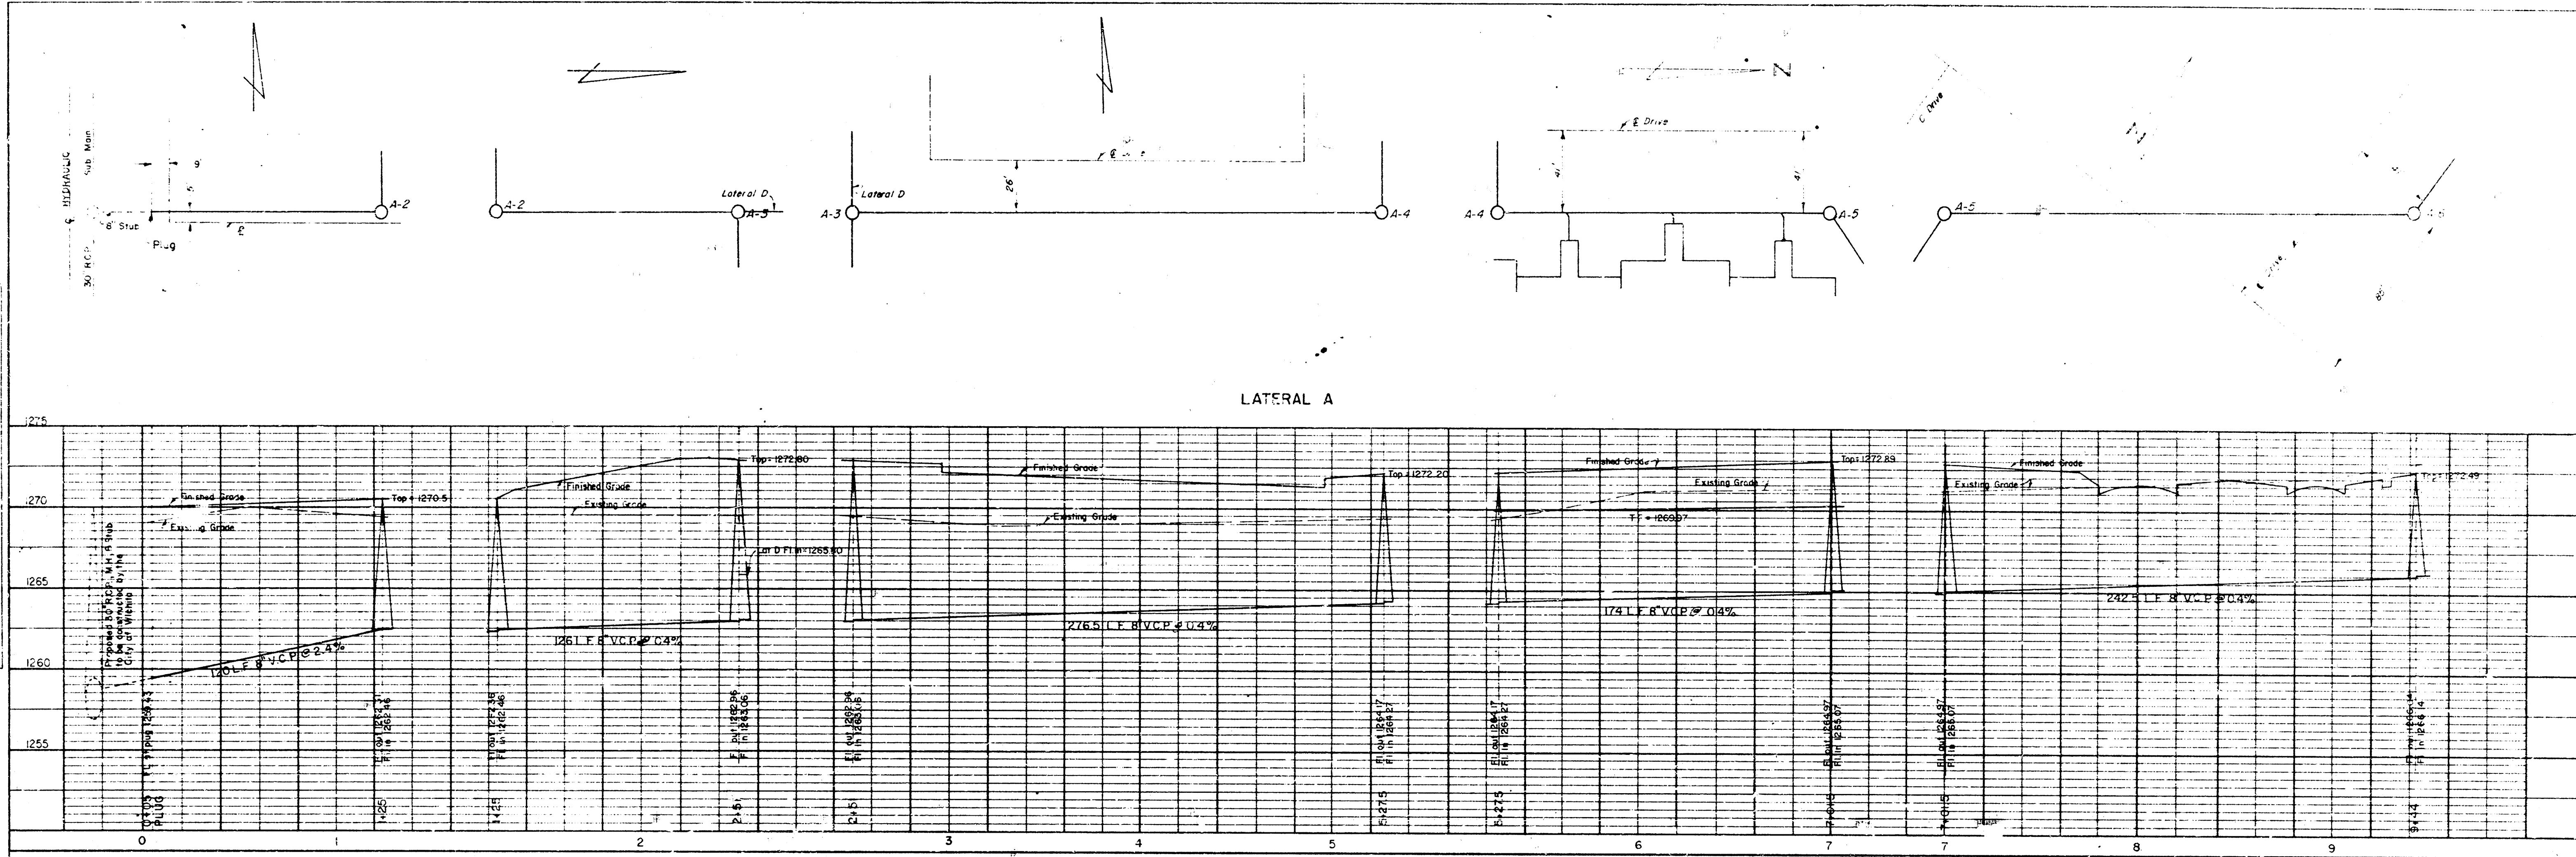


PROFILE
 SANITARY SEWER
 NEW HOPE TOWNHOUSES
 NEW HOPE ADDITION
 WICHITA, SEDGWICK COUNTY, KANSAS

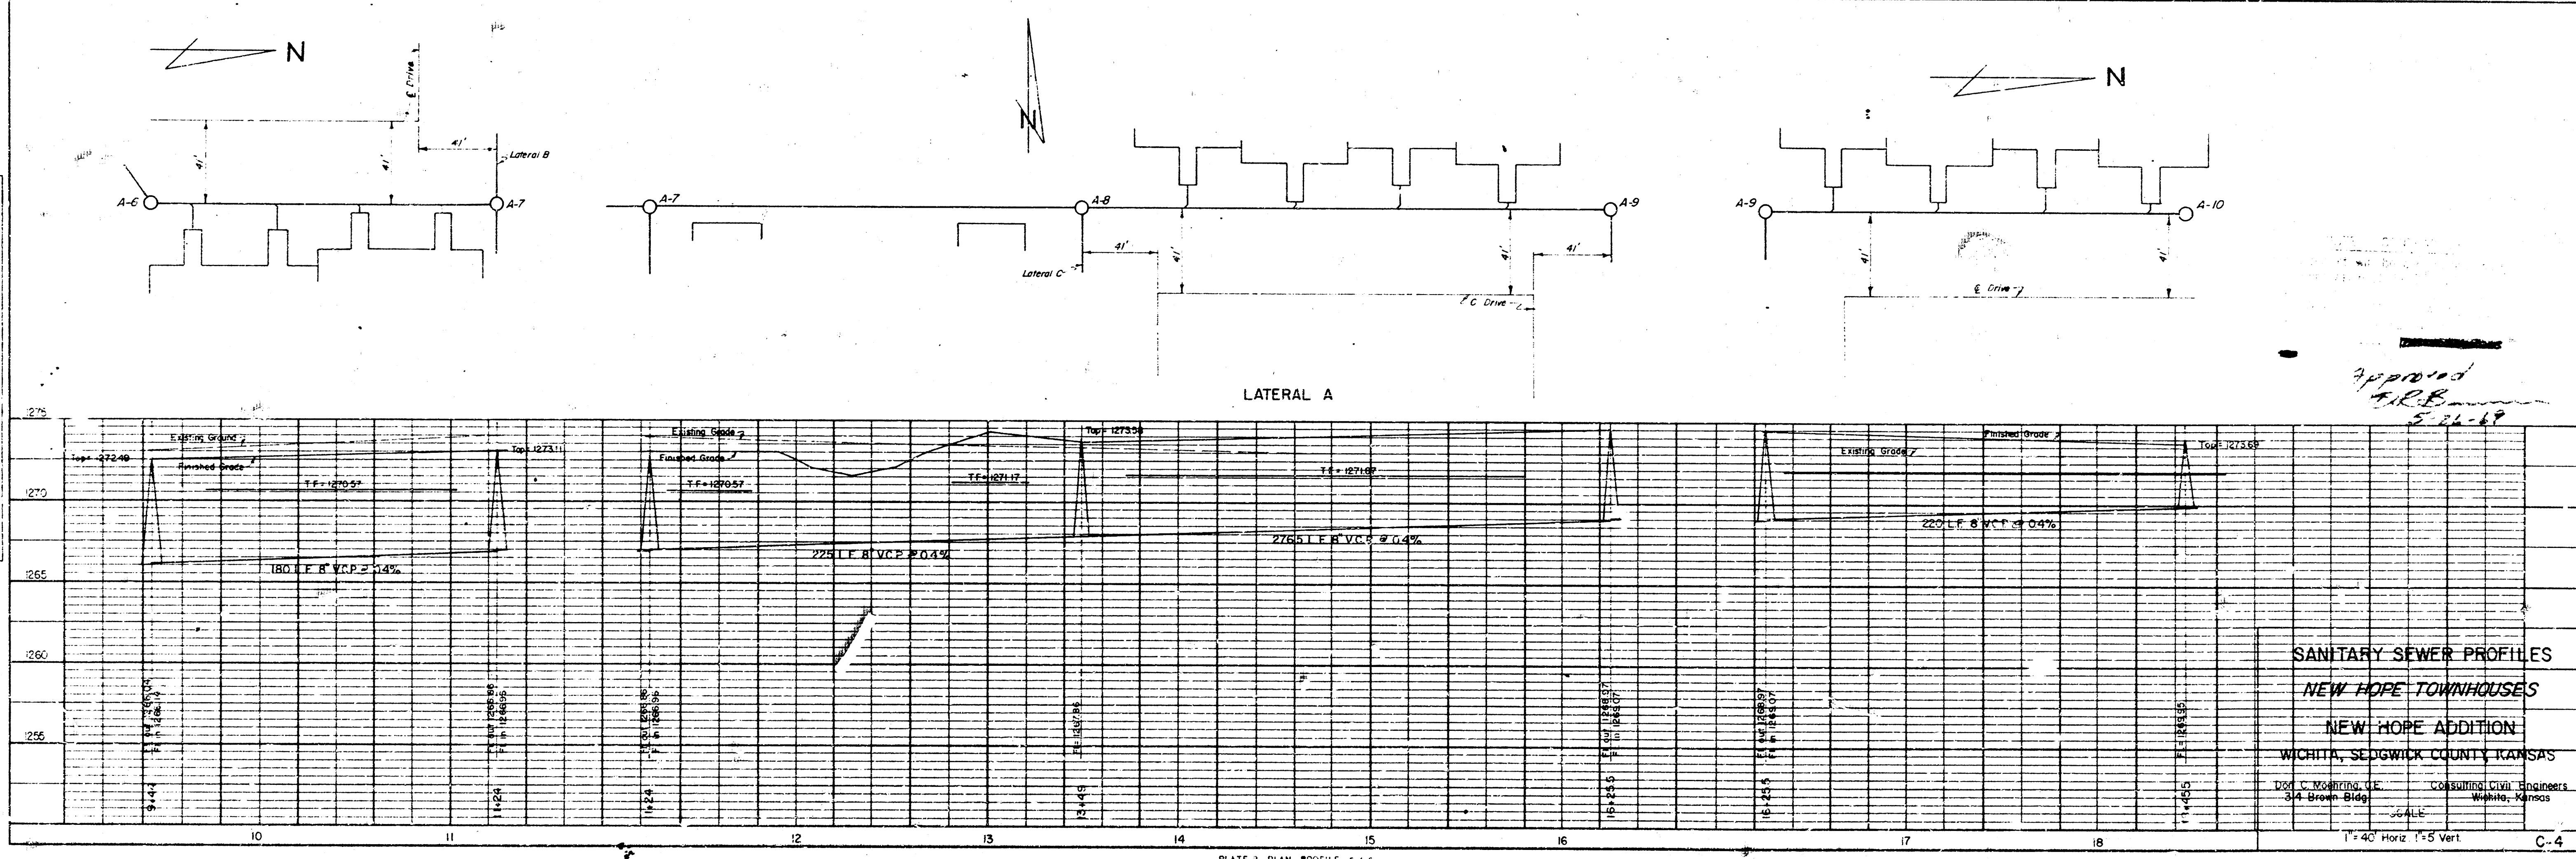

PLAN
UNITS: FEET
VERTICAL: FEET
HORIZONTAL: FEET
SCALE: 1" = 40'

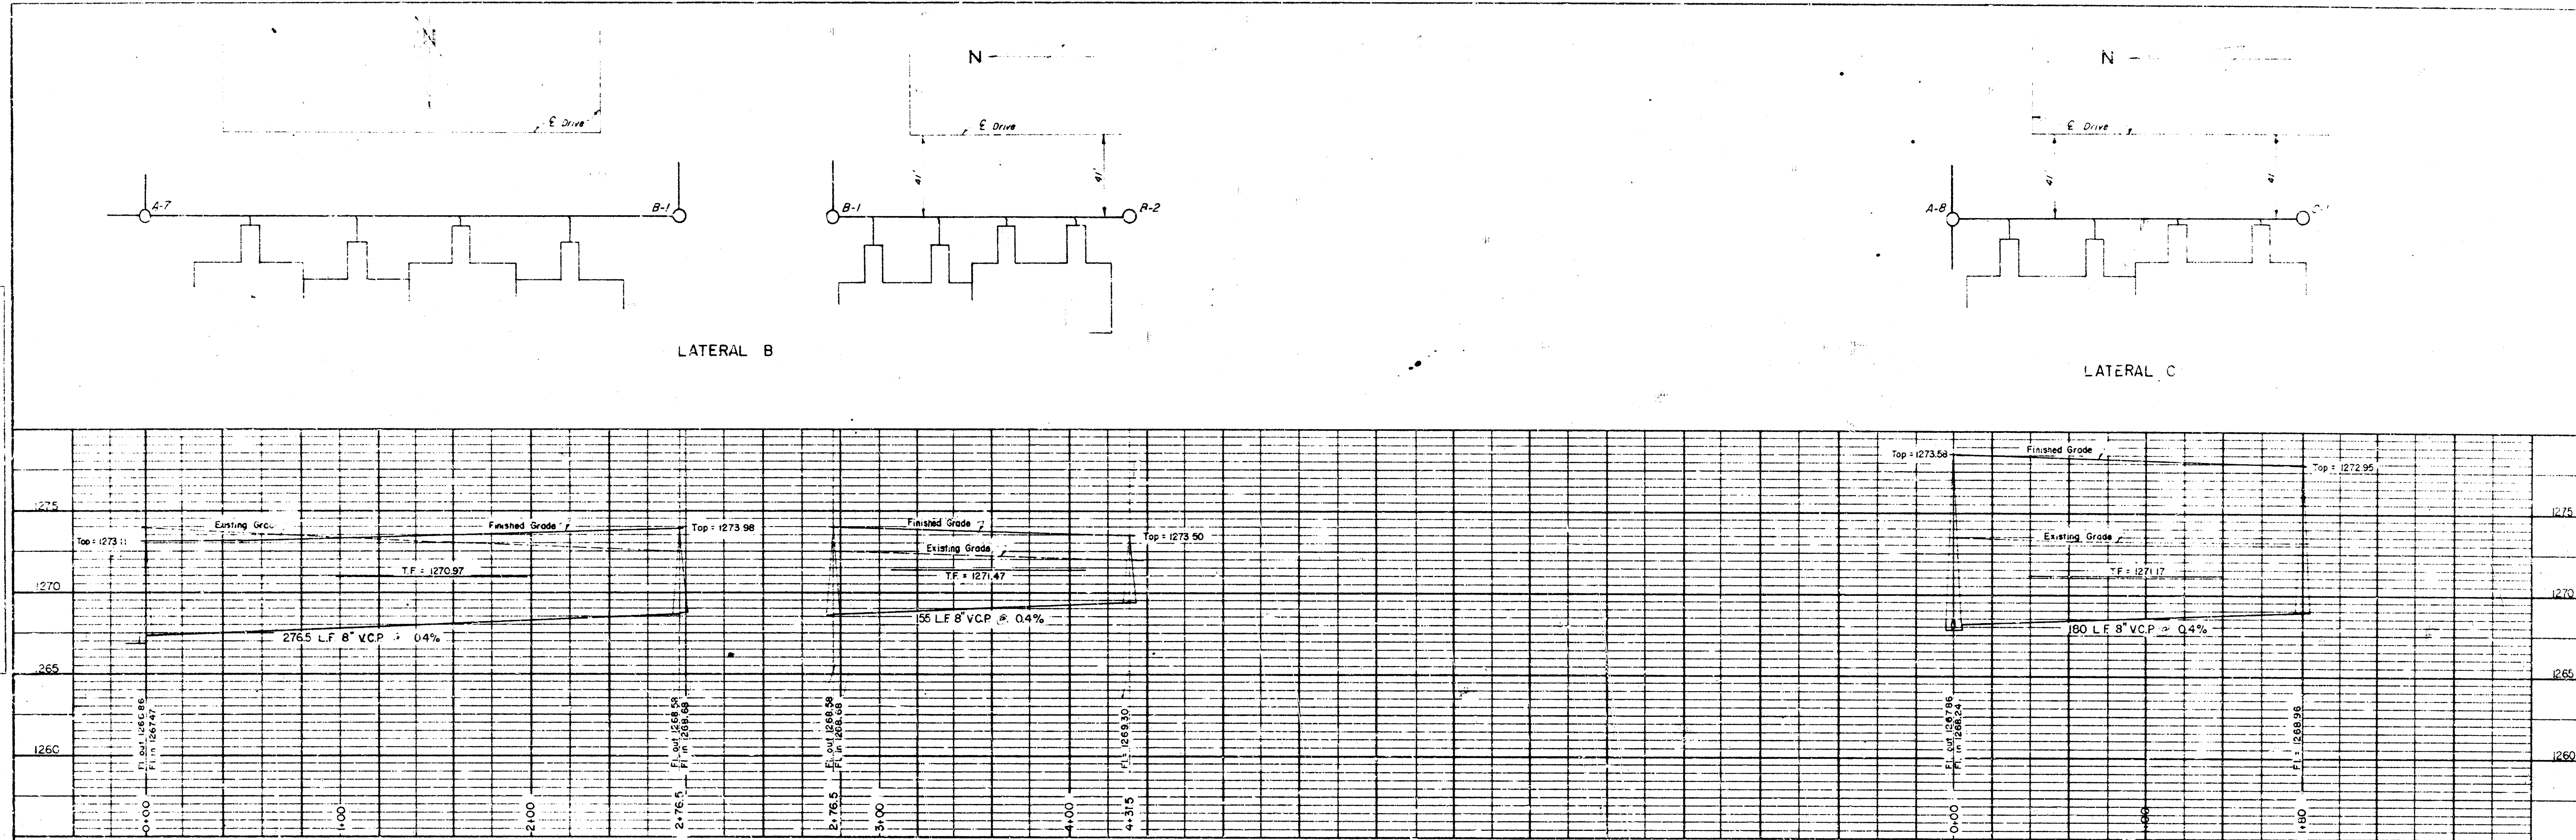

PROFILE
UNITS: FEET
VERTICAL: FEET
HORIZONTAL: FEET
SCALE: 1" = 40'

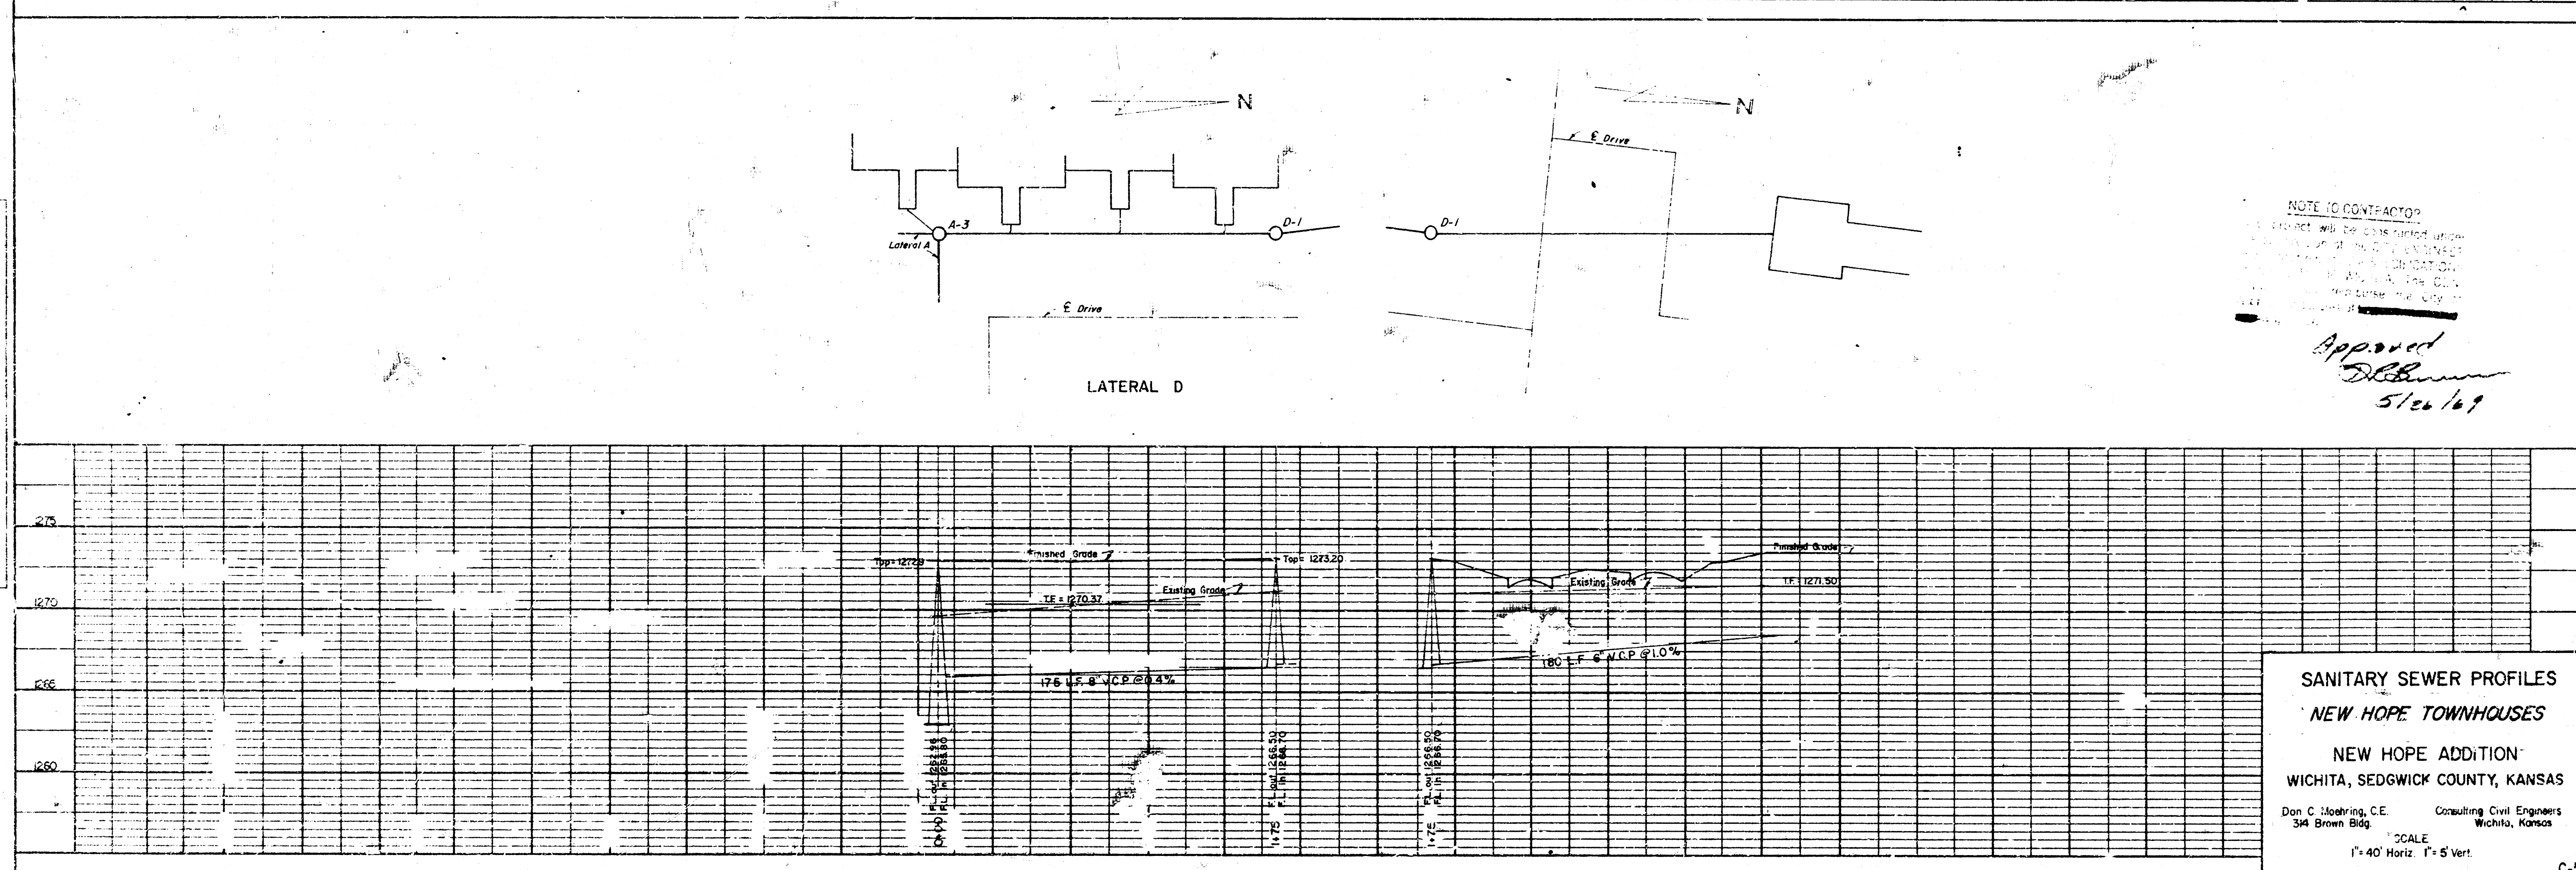

NOTE TO CONTRACTOR:
THESE PROFILES WERE PREPARED UNDER THE CLOSEST SUPERVISION OF THE ENGINEER AND ARE NOT TO BE USED FOR ANY OTHER PURPOSE.
APPROVED
5/12/69

SANITARY SEWER PROFILES
NEW HOPE TOWNHOUSES
NEW HOPE ADDITION
WICHITA, SEDGWICK COUNTY, KANSAS
Don C. Mooring, C.E. Consulting Civil Engineers
314 Brown Bldg. Wichita, Kansas