



**SANITARY SEWER PLANS FOR
GREENWICH OFFICE PARK
PHASE 1**

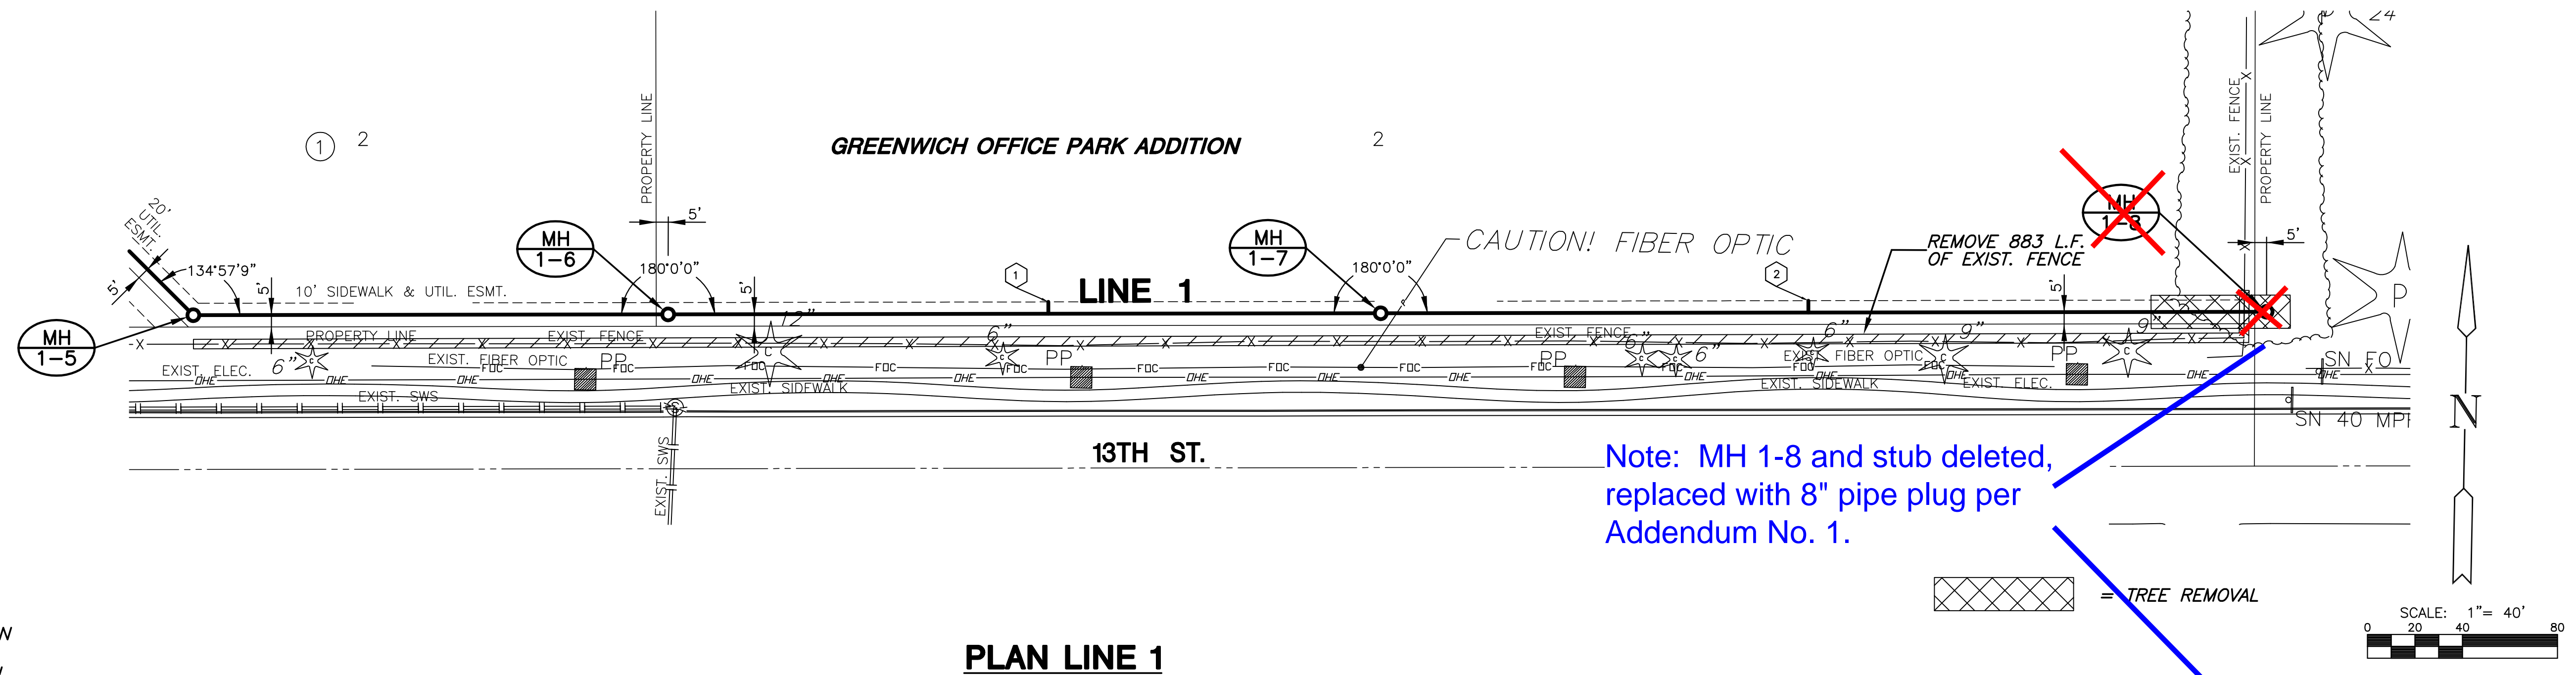


Note: MH 1-8 and stub deleted, replaced with 8" pipe plug per Addendum No. 1.

= TREE REMOVAL

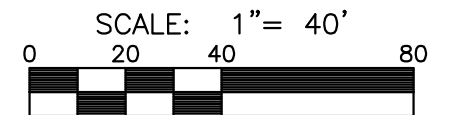

NOTE:
CONTRACTOR TO VERIFY
THE DEPTH AND LOCATION
OF EXISTING UTILITIES
PRIOR TO CONSTRUCTION.

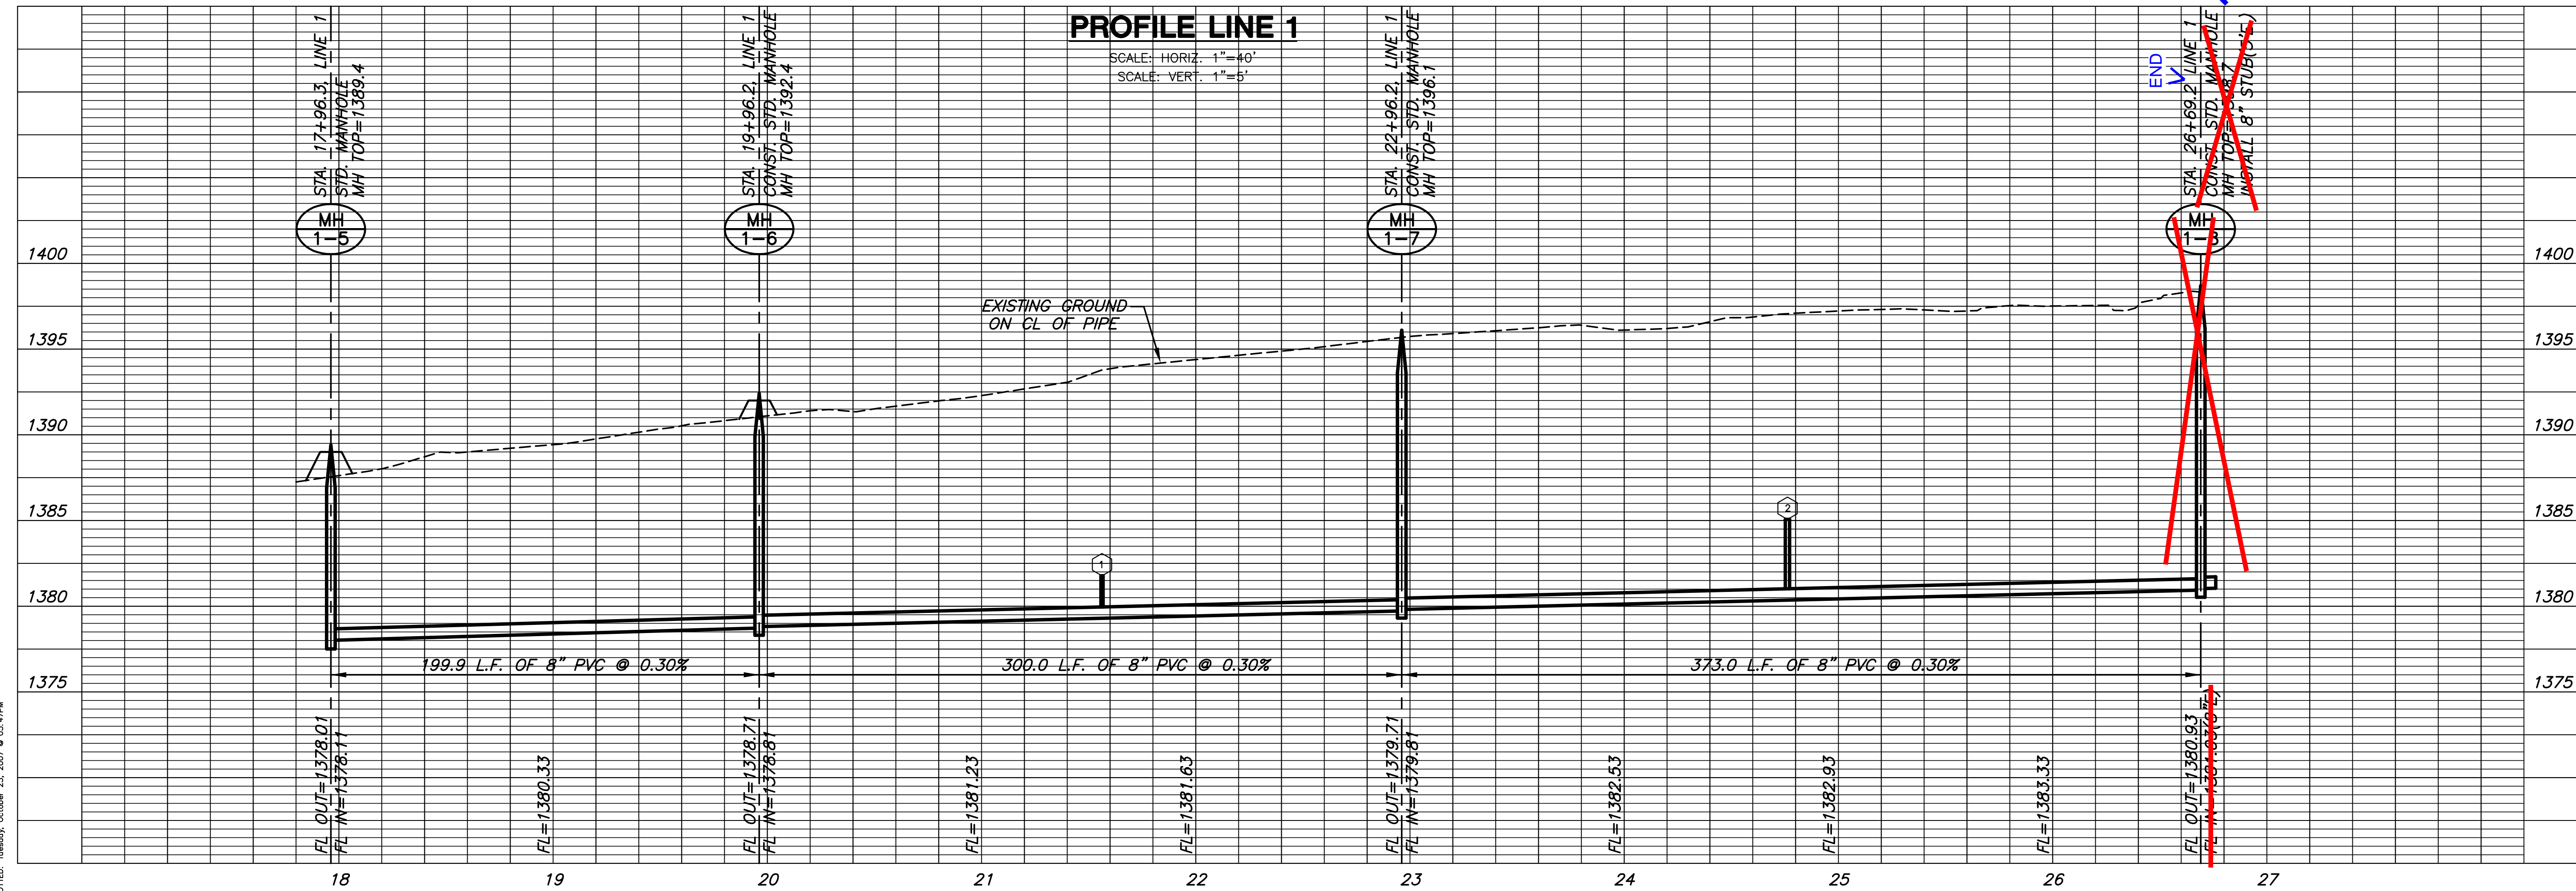

LINE 1
SHEET TITLE
468-84408
PROJECT NUMBER

DESIGN BY: SRS
DRAWN BY: MKEC
CHECKED BY: DFL

ISSUED: October 2007
REVISED:

SHEET NO.
5 of 12