


LATERAL 123, OF SANITARY SEWER NO. 23 IN THE CITY OF WICHITA, KANSAS

OCA NO. 744275
CITY OF WICHITA PROJECT NO. 468-84430
JAMES L. ARMOUR, P.E. - CITY ENGINEER

Mies Construction, Inc. - Contractor
Patton, City - Inspector
Released 6/3/08
As-Built
Risers
.pdf by JDL 6/23/08

INDEX OF SHEETS

SHEET NO. 1	TITLE SHEET
SHEET NO. 2	KEY MAP AND GENERAL NOTES
SHEET NO. 3	PLAT
SHEET NO. 4	PLAN/PROFILE
SHEET NO. 5	TYPE "P" MANHOLE DETAILS
SHEET NO. 6	FRAME & COVER DETAILS
SHEET NO. 7	RISER DETAILS
SHEET NO. 8-11	SOIL EROSION BMP DETAILS

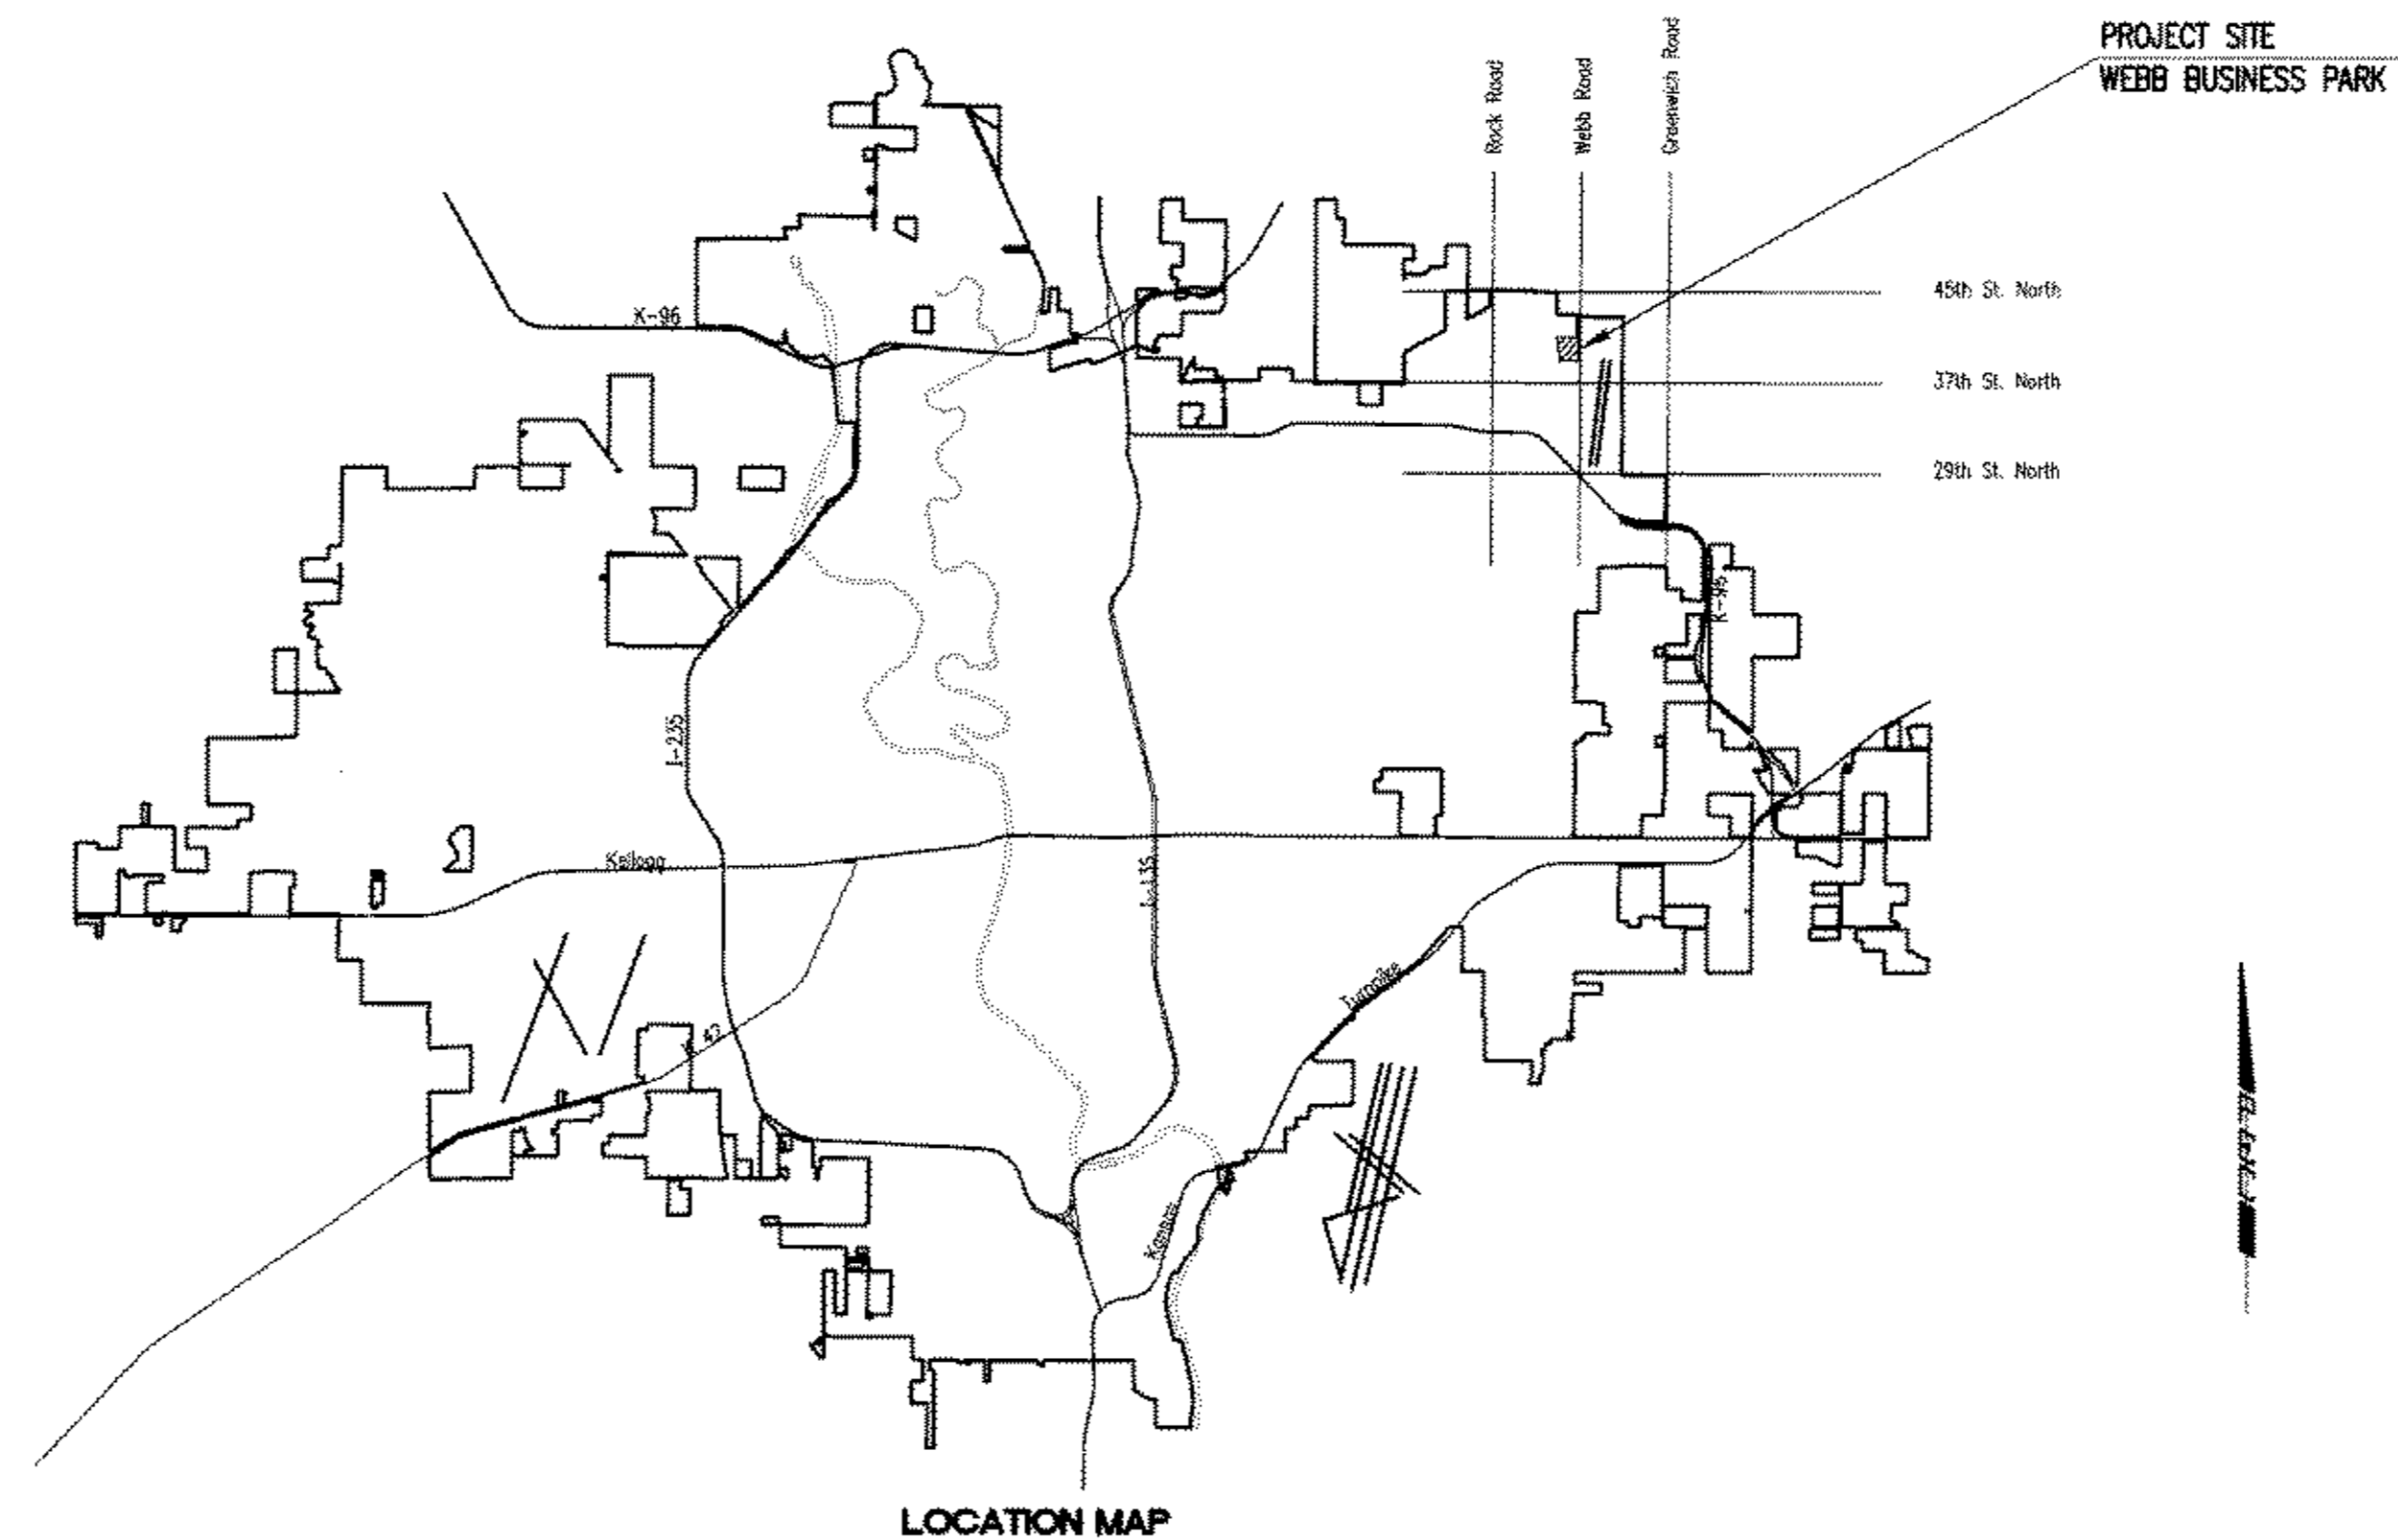

CONSTRUCTION SCHEDULE/SEQUENCE

THE CONTRACTOR FOR EACH OF THE FOLLOWING WEBB BUSINESS PARK PROJECTS SHALL COORDINATE THEIR EFFORTS WITH OTHER CONTRACTORS PERFORMING WORK IN THIS AREA SUCH THAT ANY NECESSARY SIMULTANEOUS CONSTRUCTION CAN PROCEED CONCURRENTLY WITHOUT CAUSING UNDUE DELAYS SO THAT CONSTRUCTION CAN BE COMPLETED WITHIN THE TIME FRAMES AS NOTED.

SANITARY SEWER (468-84430)
THE CONTRACTOR SHALL SEQUENCE HIS WORK TO COMPLETE, INCLUDING TESTING AND ACCEPTANCE, BY APRIL 30, 2008.

WATER DISTRIBUTION SYSTEM (448-90333)
THE CONTRACTOR SHALL COMPLETE WEBB BUSINESS PARK WATERLINE CONSTRUCTION BY MAY 16, 2008. THE CONTRACTOR SHALL COORDINATE INSTALLATION OF WATERLINES WITH THE STORM WATER DRAIN AND PAVING CONTRACTOR SO THAT STORM SEWERS CROSSING BELOW PROPOSED WATERLINES WILL BE INSTALLED PRIOR TO WATERLINE CONSTRUCTION.

STREETS/DRAINAGE (472-84611)
THE CONTRACTOR SHALL COMPLETE WEBB BUSINESS PARK STREETS CONSTRUCTION BY JULY 18, 2008.

STORM WATER DRAINAGE (468-84431)
THE CONTRACTOR SHALL COMPLETE WEBB BUSINESS PARK MASS GRADING CONSTRUCTION BY JUNE 4, 2008.

FEBRUARY 2008

PLANS PREPARED BY
PROFESSIONAL ENGINEERING CONSULTANTS, P.A.
ENGINEERS
WICHITA, KANSAS

