


STA. 25+38.7, LINE 2 CONSTRUCT
4' DIA. SHALLOW TYPE "A" MANHOLE
W/DEETER FRAME & GRATE NO. 1927
OR APPROVED EQUAL
MANHOLE TOP=199.4 AB
PROVIDE SEDIMENT BARRIER
N 12895.98 E 11537.90

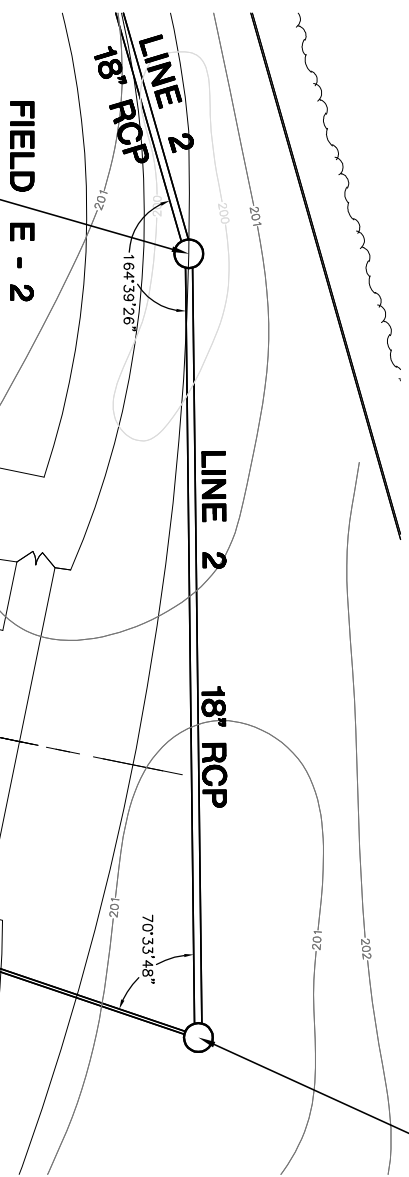


NORTHEAST BASEBALL COMPLEX

STA. 27+01.9, LINE 2, CONSTRUCT 4' DIA.
SHALLOW TYPE "A" MANHOLE
W/DEETER FRAME & GRATE NO. 1927 OR
APPROVED EQUAL, MANHOLE TOP=199.9 AB
PROVIDE SEDIMENT BARRIER
N 12656.30 E 11379.71

PLAN LINE 2
SCALE: 1"=20'

AS-BUILT AUGUST 2008

PROFILE LINE 2
SCALE: HORIZ. 1"=20'
SCALE: VERT. 1"=5'

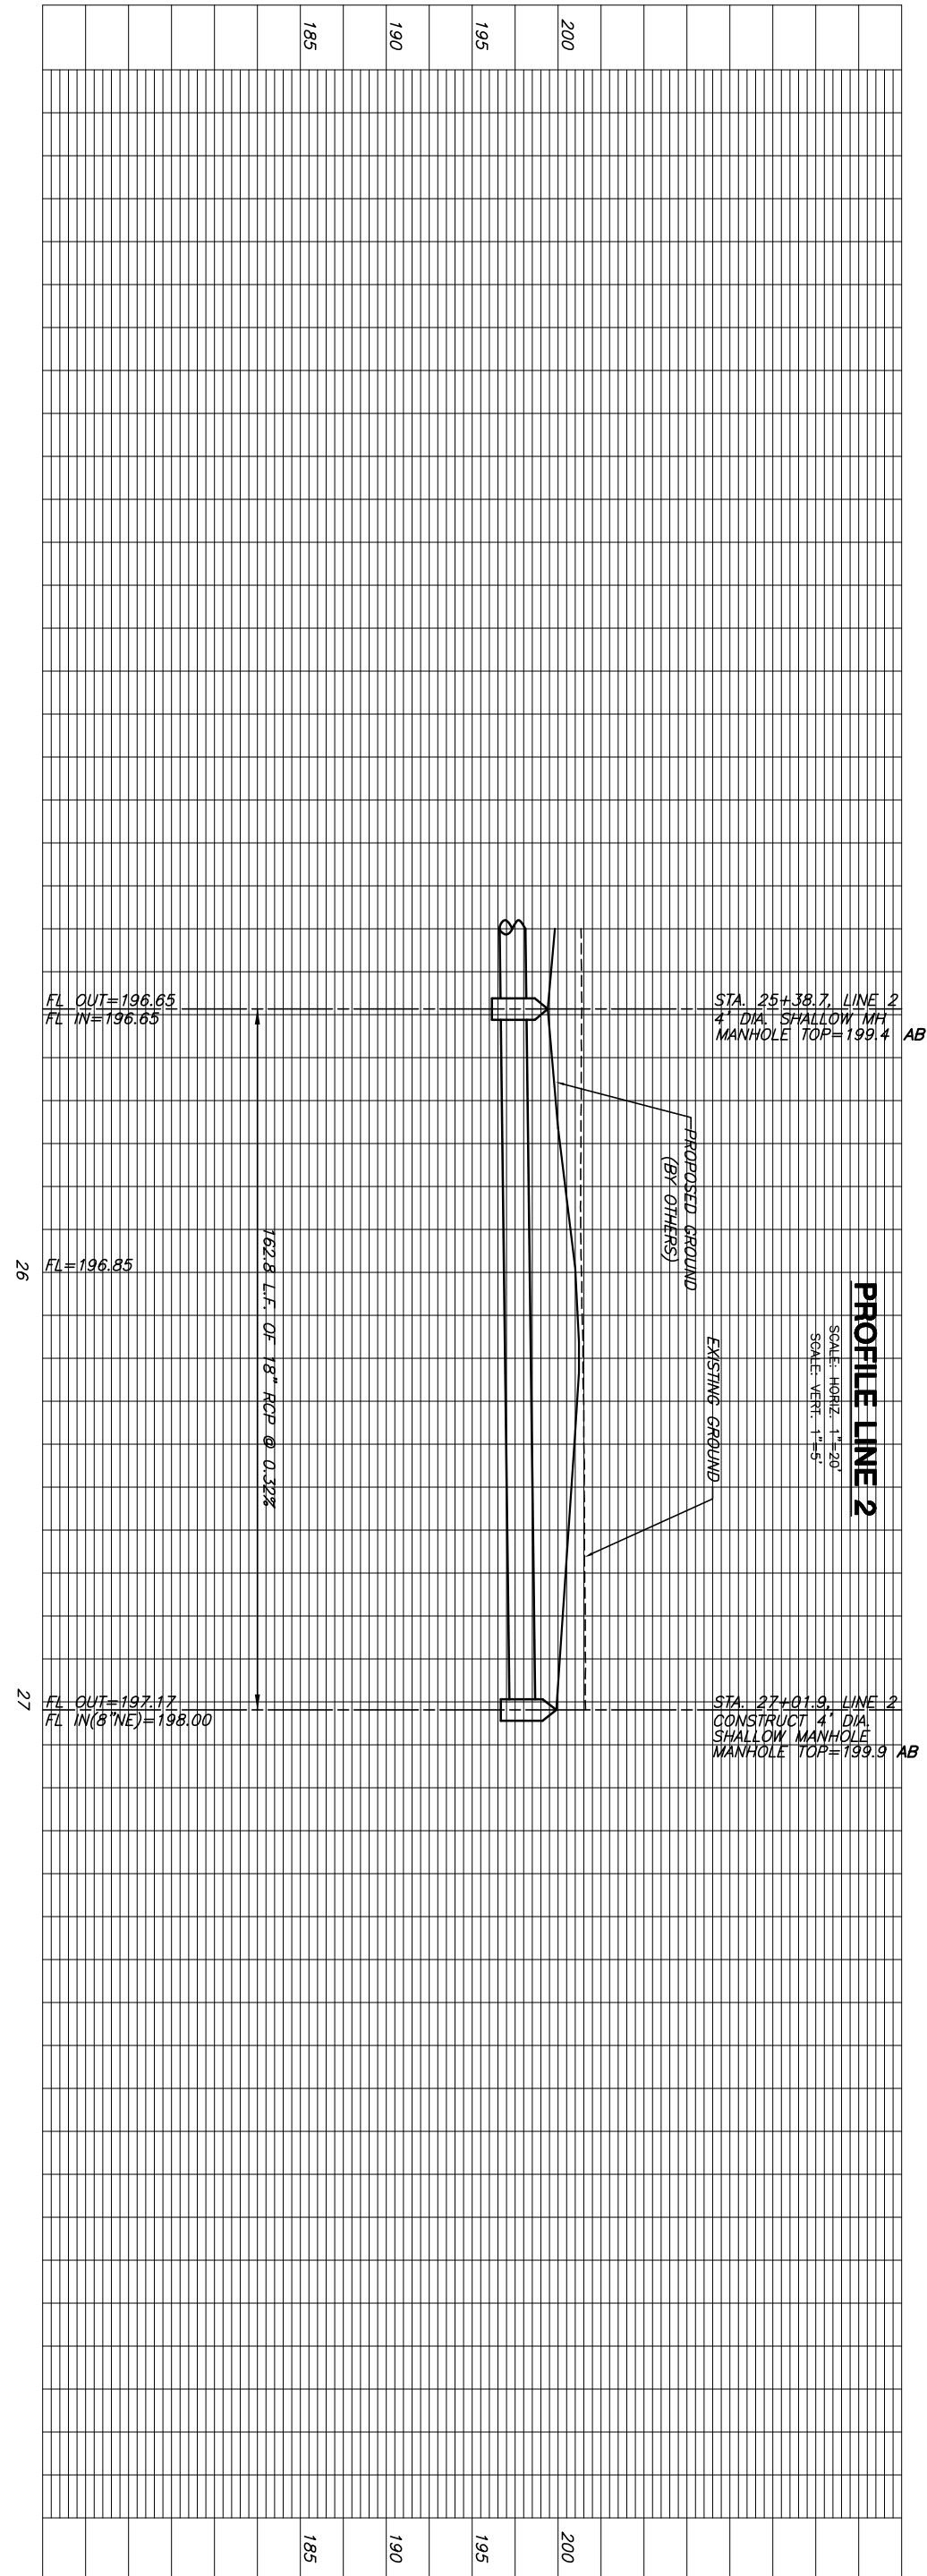

J:\CIVIL\064103_NE BASEBALL\DWG\SW\5104\CS\AB\BUD\06430506\AA\DWG

STORM WATER SEWER
NORTHEAST BASEBALL COMPLEX
PHASE 1

MKEEC
ENGINEERING
CONSULTANTS, INC.
411 N. WEBB ROAD
WICHITA, KS. 67206
316-684-9600

SHEET TITLE
LINE 2
PROJECT NUMBER
1853PPS

DESIGN BY
JTC
DRAWN BY
DGC
CHECKED BY
GJA

ISSUED
August 2008
REVISED

SHEET NO.
11 of 17