


PROFILE LINE 1
SCALE: HORIZ. 1"=20'
SCALE: VERT. 1"=5'

AS-BUILT AUGUST 2008

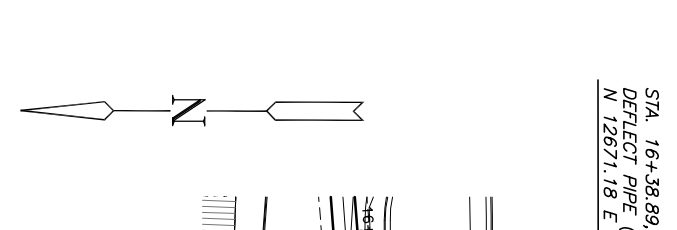

PLAN LINE 1
SCALE: 1"=40'

ISSUED AUGUST 2007	JTC I DDG I GJA DESIGNED DRAWN CHECKED
REVISION DECEMBER 2007	
SHEET NO. 4 OF 6	

STREET TITLE
LINE 1
PROJECT NUMBER
1332PPW

WATER PLANS FOR NORTHEAST BASEBALL COMPLEX

411 N. WEBB ROAD
WICHITA, KS 67206
316-684-9600

MKREC
ENGINEERING
CONSULTANTS, INC.
316-684-9600