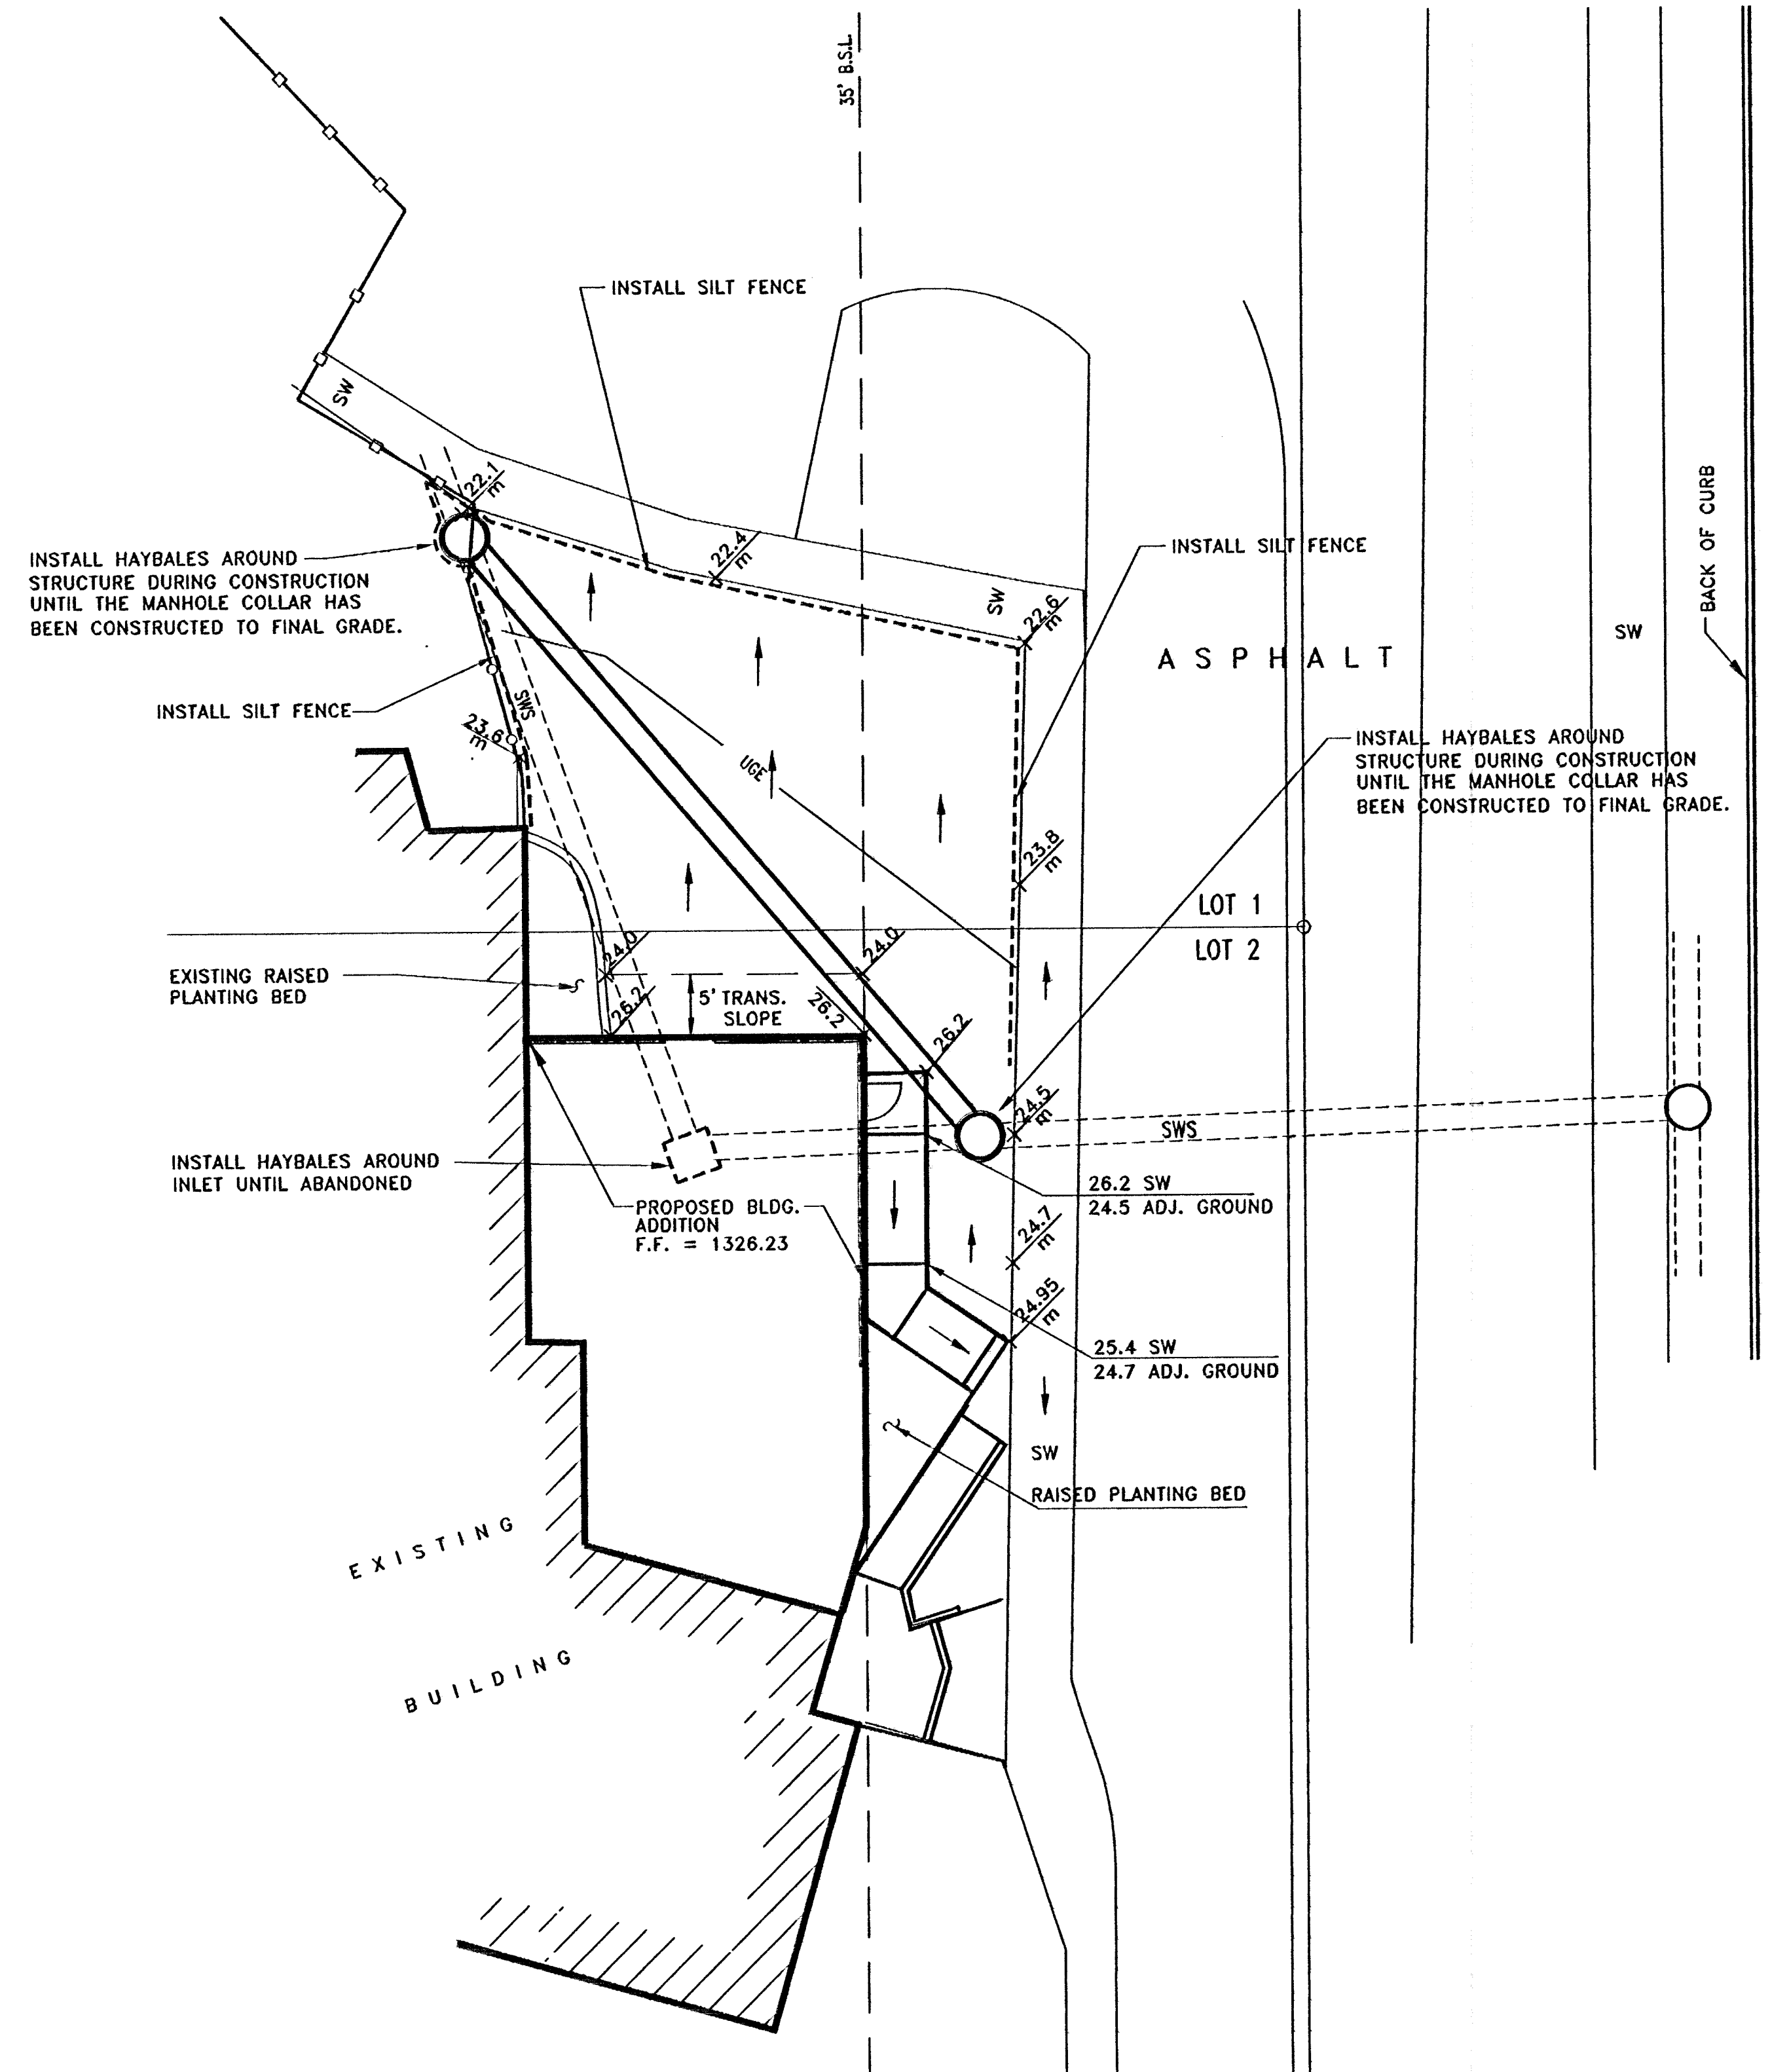


SCALE:
1" = 10'

LEGEND

- m = MATCH ELEVATION
- SW = SIDEWALK
- SWS = STORM WATER SEWER
- UGE = UNDERGROUND ELECTRIC
- = DIRECTION OF DRAINAGE
- X 23.4 = PROPOSED SPOT ELEVATIONS
- = SILT FENCE

AS-BUILT 7-31-2007

REISS & GOODNESS ENGINEERS
2160 WEST 21st STREET
WICHITA, KANSAS 67203
(316) 832-0213

SCALE: 1" = 10'
DATE: 12/31/06
PROJECT NO. M50506
SHEET: 5 of 7

REVISION	DIRECTORY	DRAWN BY	FILE NAME	CHECKED BY	DESIGNED BY	PROJECT
	C:\WP6\MSO\LEARN.CTR	C.E.	LEARN_CTR_REV.		R.P.	

SITE GRADING AND EROSION CONTROL PLAN

CUSTOMER LOTS 1 & 2 PARK WEST PLAZA ADD'N.