

STORM SEWER PLANS
TO SERVE
WAL★MART SUPERCENTER #4321-00
WICHITA, SEDGWICK COUNTY, KANSAS
NW 53RD ST. NORTH & N. MERIDIAN
2007
CITY OF WICHITA PRIVATE PROJECT NO. 1757PPS (607861)
JAMES ARMOR, P.E., CITY ENGINEER

RESOURCE LIST

GAS COMPANY
AQUILA GAS COMPANY
1611 SOUTH HOOVER
WICHITA, KANSAS 67209
PH: (316) 941-1608
CONTACT: CALVIN BRIGGS

KANSAS GAS SERVICE
1021 EAST 26TH STREET NORTH
WICHITA, KANSAS 67219
PH: (316) 832-3101
CONTACT: CHARLENE LAWLESS

KANSAS DEPT. OF TRANSPORTATION
(KDOT)
DISTRICT 5 (SOUTH CENTRAL DIVISION)
ROBERT COOK - DISTRICT ENGINEER
PH: (620) 663-3381

CIVIL ENGINEERS
SMC CONSULTING ENGINEERS, P.C.
TERENCE L. HAYNES, P.E.
815 WEST MAIN ST.
OKLAHOMA CITY, OK 73106
PH: (405) 232-7715
FAX: (405) 232-7859

ELECTRIC COMPANY
WESTAR ENERGY
201 NORTH MARKET
WICHITA, KS 67202
PH: (316) 261-6524
CONTACT: SHANE PRICE


WATER & SEWER COMPANY
CITY OF WICHITA, KS
CITY HALL 455 NORTH MAIN
WICHITA, KS 67202
PH: (316) 268-4553
FAX: (620) 421-7089
CONTACT: BILL PERKINS

PLANNING / ZONING
CITY OF WICHITA
METROPOLITAN AREA PLANNING
DEPARTMENT
CITY HALL - 10TH FLOOR
455 NORTH MAIN
WICHITA, KANSAS 67202
PH: (316) 268-4421
CONTACT: DONNA GOLTRY

TELEPHONE COMPANY
SOUTHWESTERN BELL
154 NORTH BROADWAY, ROOM 210
WICHITA, KS 67202
PH: (316) 268-2245
CONTACT: BOB ALLEY

OWNERS' ADDRESS

WAL-MART STORES, INC.
702 S.W. 8TH STREET
BENTONVILLE, AR 72716
PH: (479) 273-4000

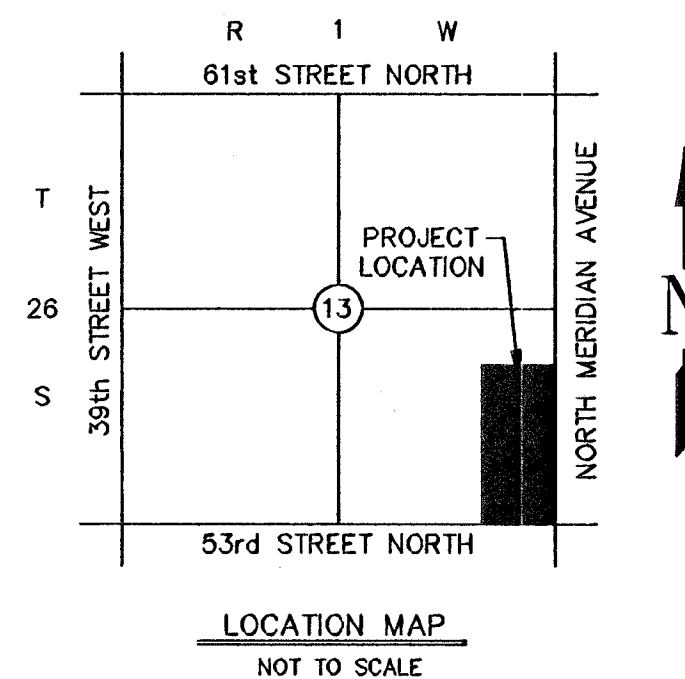

NOTE TO CONTRACTOR
CALL KANSAS ONE
1-800-522-6543

This number is to be used for information on the location of all underground utilities. Contact this number prior to any excavation.

APPROVED AS NOTED
By CITY ENGINEER OF WICHITA

Sanitary Sewers _____

Storm Sewers VRH 3/29/07

Driveway Approaches _____

Water Mains _____

NOTE TO CONTRACTOR

INSPECTION AND TESTING FOR THIS PROJECT IS TO BE PROVIDED BY A LICENSED CONSULTING ENGINEERING FIRM UNDER CONTRACT WITH THE OWNER/DEVELOPER. SAID INSPECTION TO BE IN ACCORDANCE WITH THE CITY OF WICHITA STANDARD CONSTRUCTION ENGINEERING PRACTICES AND CERTIFIED BY A LICENSED PROFESSIONAL ENGINEER. NO WORK SHALL BE PERFORMED IN DEDICATED EASEMENTS OR THE PUBLIC RIGHT-OF-WAY BY THE CONTRACTOR WITHOUT SUCH INSPECTION NOR SHALL ANY WORK BE COMMENCED IN DEDICATED EASEMENT OR ANY RIGHT-OF-WAY WITHOUT WRITTEN AGREEMENT BY THE CITY ENGINEER.

BENCH MARKS:

BM #1
R.R. SPIKE IN WEST SIDE OF P.P.
AT N.E.N. CORNER OF INTER.
25th AND MERIDIAN
ELEV=1332.98

BM #2
R.R. SPIKE IN NORTH SIDE OF P.P.
WEST OF MERIDIAN ON SOUTH
SIDE OF 53rd STREET
ELEV=1331.15

BM #3
R.R. SPIKE IN NORTH SIDE OF
4th P.P. WEST OF MERIDIAN
ON SOUTH SIDE OF NW 53rd
ELEV=1332.60

BM #4
R.R. SPIKE IN NORTH SIDE OF
6th P.P. WEST OF MERIDIAN
ON SOUTH SIDE OF NW 53rd
ELEV=1333.28

BM #5
CUT "X" ON T/C ON E. SIDE OF
MERIDIAN W OF S. PI IN SWLK &
APPROX 60' S OF DR 5474 MERIDIAN
ELEV=1332.91

BM #6
CUT "X" ON SOUTH END OF CONC.
HOOD INLET ON EAST SIDE
OF MERIDIAN AT 5556 MERIDIAN
ELEV=1332.18

1. An effort has been made to locate and show approximate location of underground utilities. Buried utilities are not necessarily shown. It is the Contractors responsibility to locate and preserve all utility services.

2. Proposed utility services have been coordinated with the local utility companies. Contractor is responsible for contacting all utility companies prior to construction.

3. All quantity estimates shown in this set of plans are the Engineer's estimate and are provided for general information only. The Contractor is solely responsible for calculating his own quantities.

4. All construction shall be done in accordance with Wal-Mart Sitework Specifications, and where applicable, as per the City of Wichita's Standard Specifications for Public Improvements and Kansas Department of Transportation's Standard Specifications for Highway Construction, latest edition.

I, Terence L. Haynes, Kansas Professional Engineer #14583, do hereby state that these storm sewer plans, prepared by me or under my direct, responsible supervision, are in strict conformance with the applicable Codes of the City of Wichita and the sound principles and practice of the Civil Engineering profession


TERENCE L. HAYNES, P.E. #14583

REVIEWED BY: _____

CITY ENGINEER

As built

Contractor: Utility Contractors
Inspector: LA Ely Gamm
Company: K.E. Miller
Date: 10/30/07

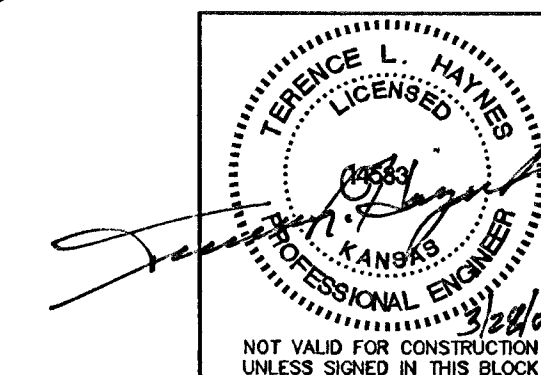

TITLE SHEET STORM SEWER PLANS TO SERVE	
WAL-MART SUPERCENTER #4321-00	
N.W. 53rd ST. NORTH & N. MERIDIAN WICHITA, KANSAS	
SMC Consulting Engineers, P.C. 815 West Main - Oklahoma City, OK 73106 PH: 405-232-7715 Fax: 405-232-7859 KANSAS CERTIFICATE OF AUTHORIZATION NO. E-335 EXP. DEC. 31, 2008	
SMC	
No. 1	Date 03/29/07
Per City comments	
DATE: 03/23/07	
DRAWN BY: MDS	
PROJECT NO.: 4344.00	
ENGINEER: TERENCE L. HAYNES, P.E. #14583	
SCALE: NONE	
SHEET NO. C-8.1	