



CITY OF WICHITA, KANSAS
Jim Armour, P.E., City Engineer

1. Title Sheet
- 2.-4. Sanitary Sewer Plan and Profile
- 5.-7. Storm Sewer Plan and Profile
8. Type P Manhole
9. Type 1-A Inlet Detail
10. Plat
11. Pond Detail


8. *Properties within the project may have underground irrigation systems (lawn sprinklers) which conflict with new construction. Contractor shall remove such components as needed during construction of the project. The irrigation system shall be reinstalled in like kind before project completion. Any irrigation system modifications required because of project improvements shall be coordinated with the property owner. Portions of underground irrigation systems not in conflict with new construction shall be protected from damage and shall remain in place. All work related to underground irrigations/sprinklers shall be subsidiary to Site Restoration.*

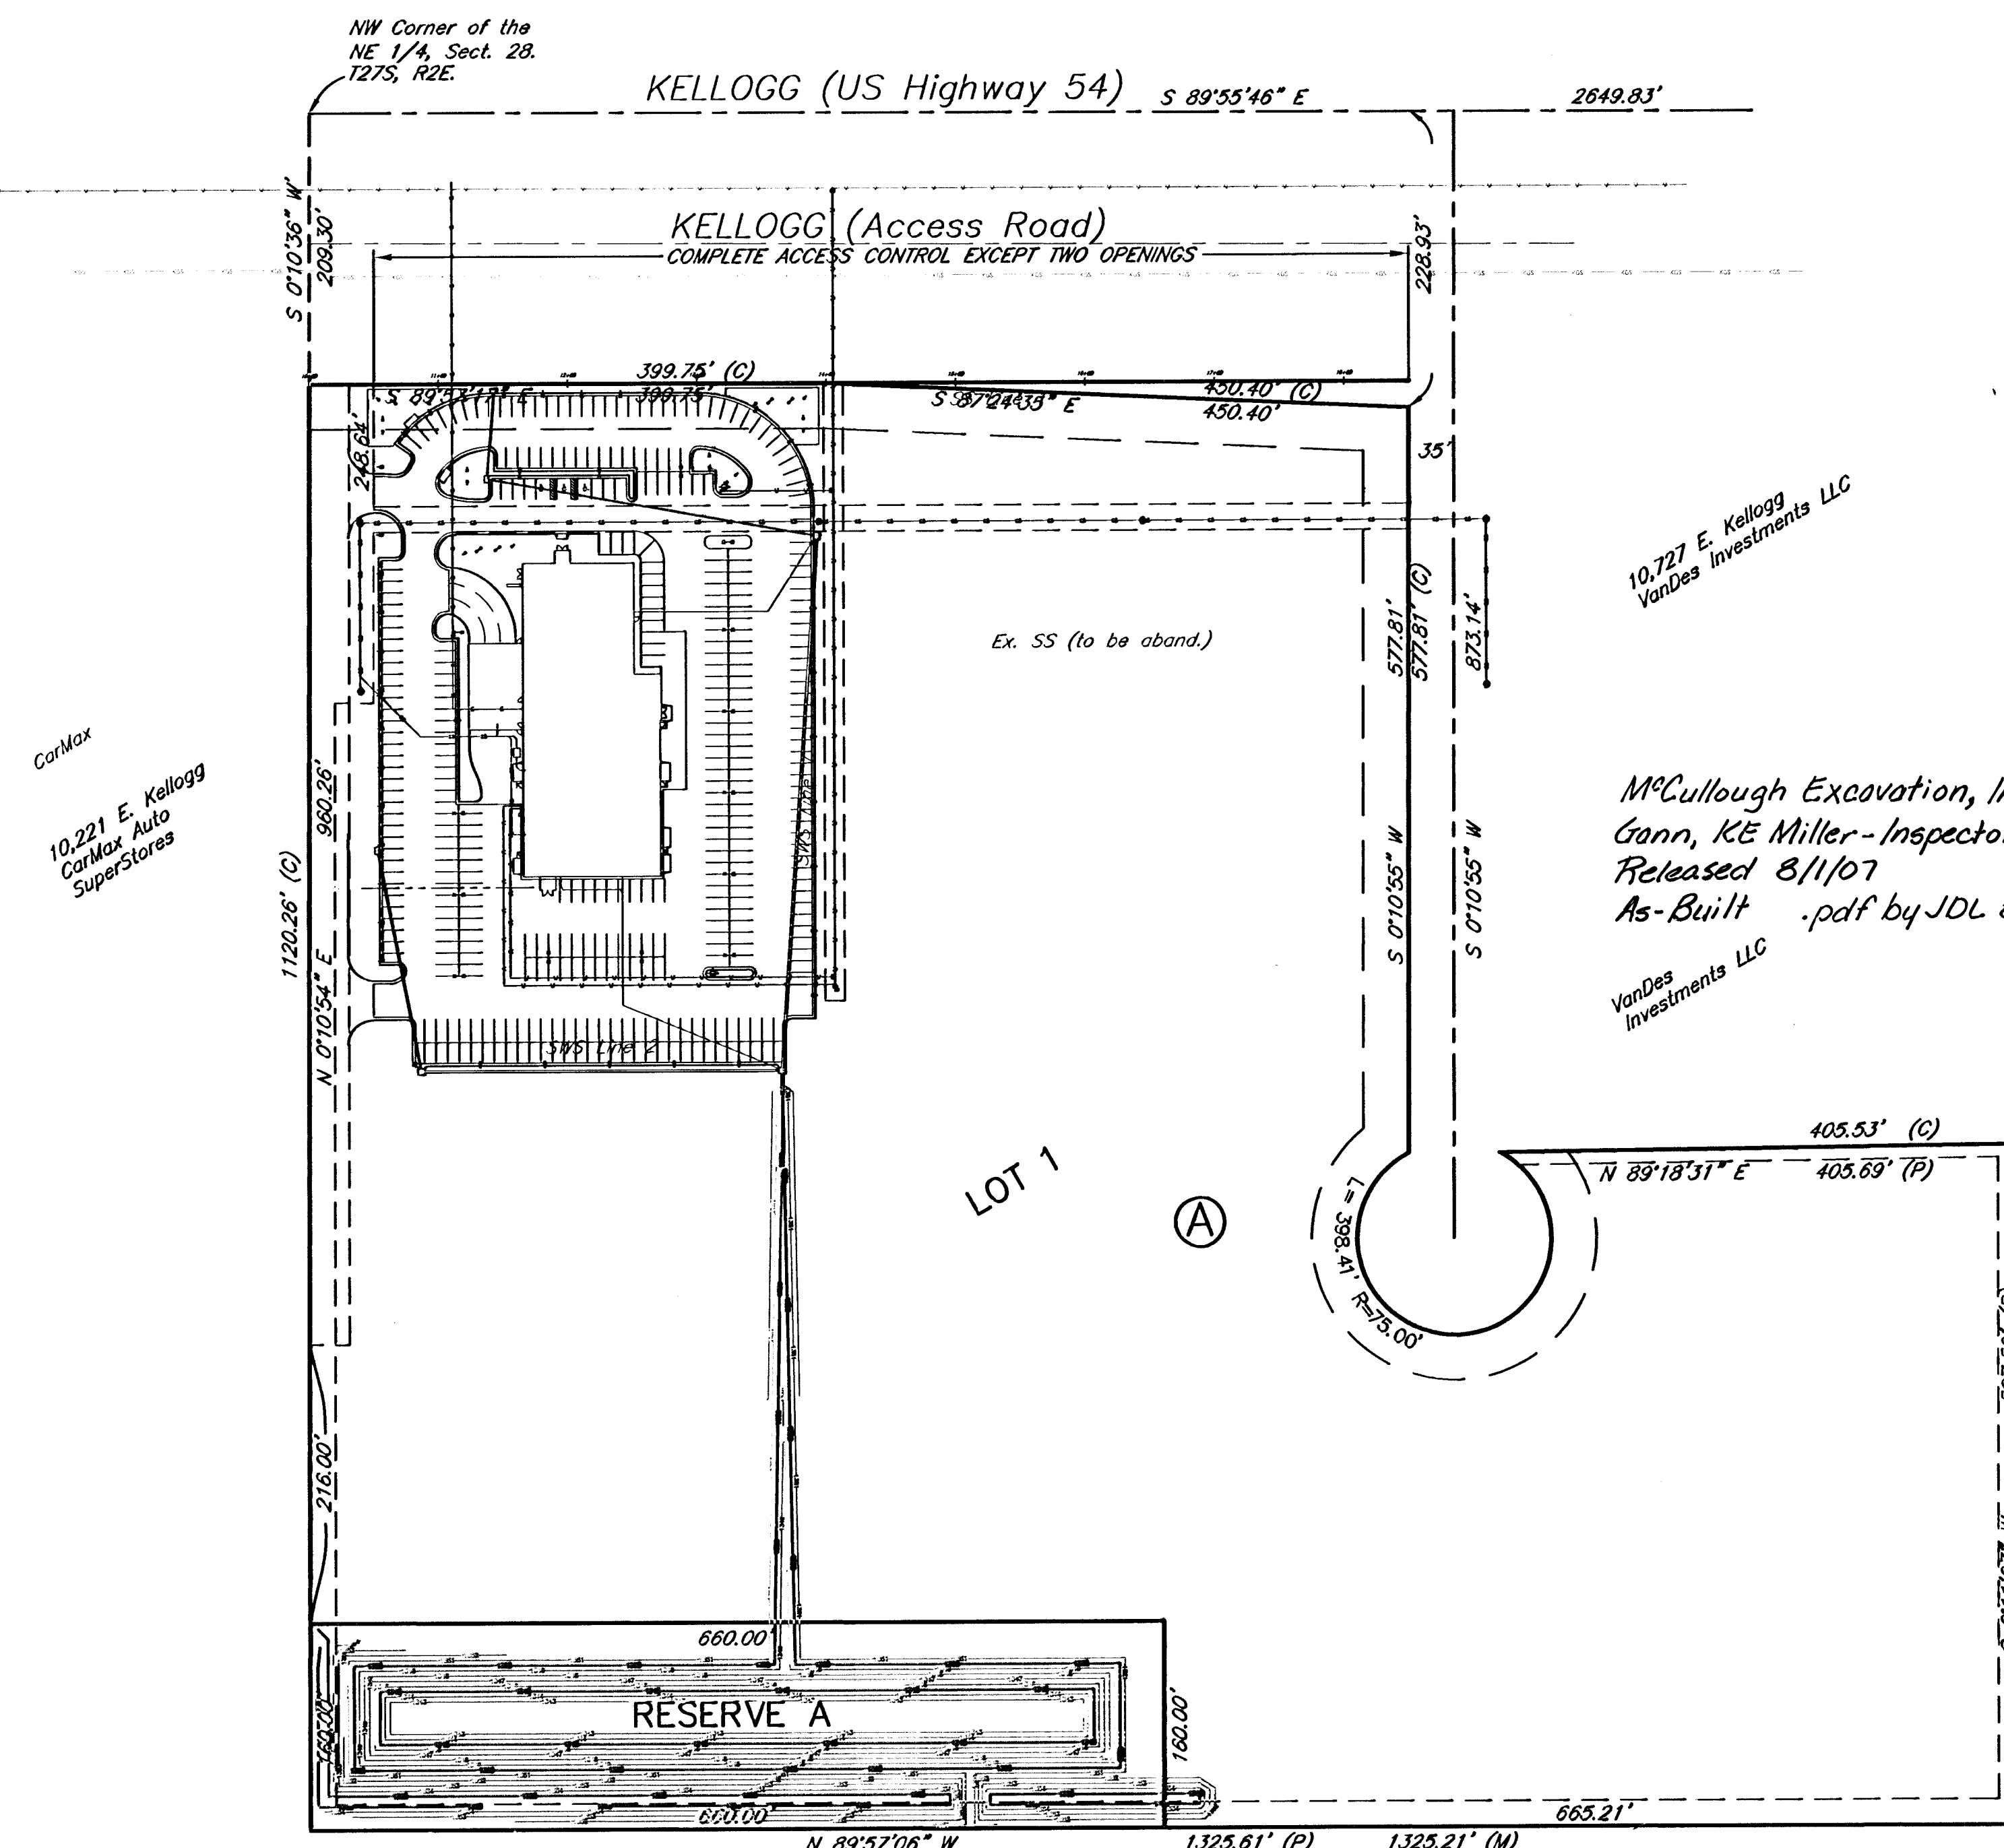

MARCH, 2007
KANSAS TURNPIKE AUTHORITY (1-35)

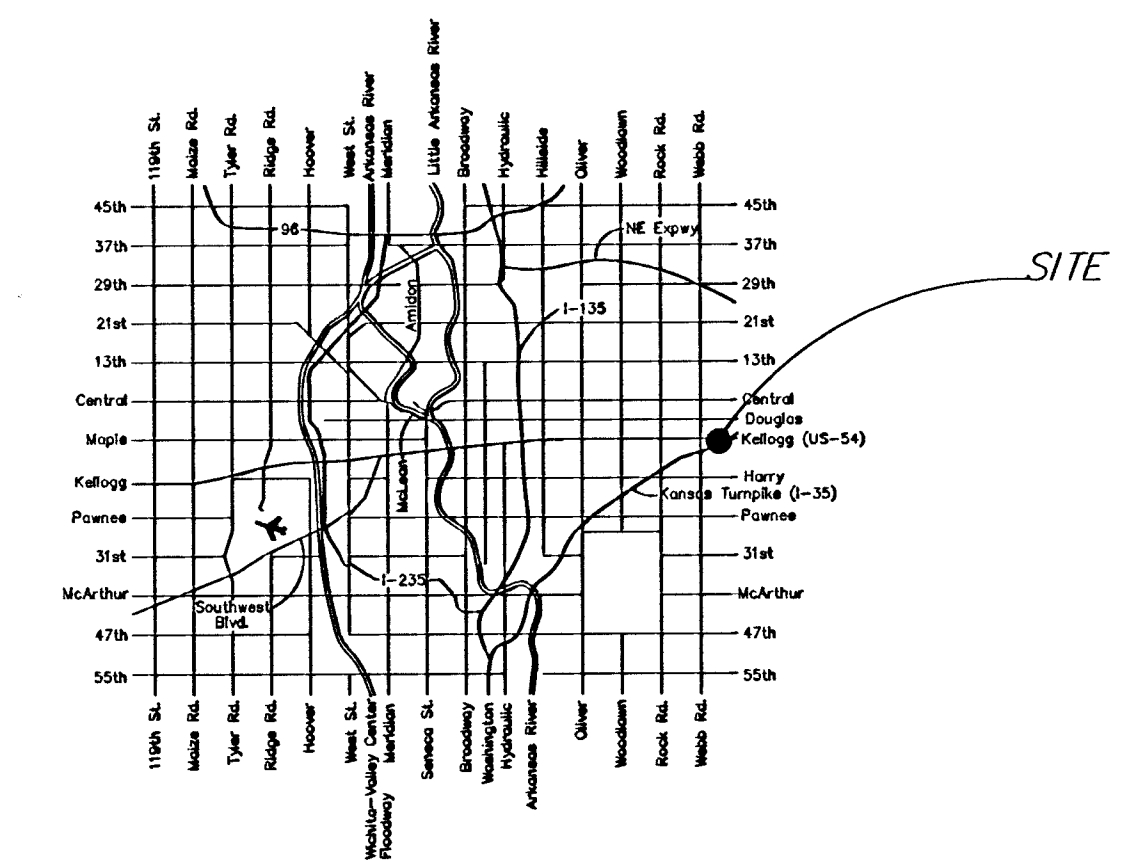

City of Wichita

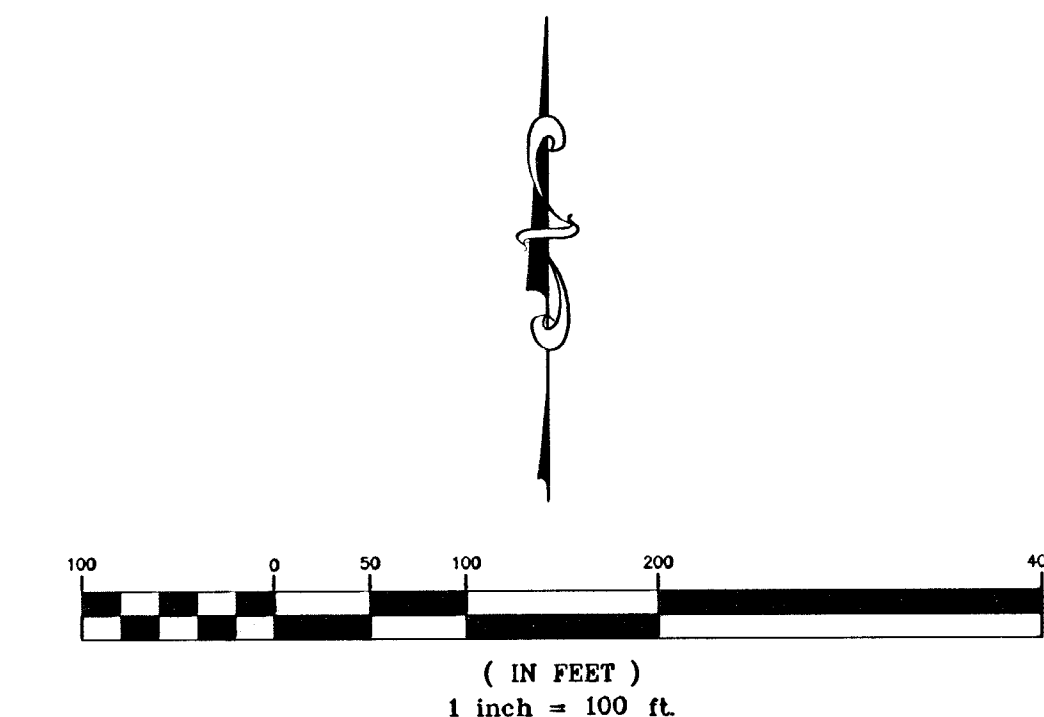

McCullough Excavation, Inc.- Contractor
Gann, KE Miller -Inspector
Released 8/11/07
As-Built .pdf by JDL 8/11/07


APPROVED AS NOTED

City Engineer Office URH 5/1/07

NOTE TO CONTRACTORS

Installation, inspection and testing for this project is to be provided by a Licensed Consulting Engineering Firm under contract with the Owner/Developer. Such inspection to be in accordance with the City of Wichita standards and specifications, engineering practices and certified by a Licensed Professional Engineer. No work shall be performed in dedicated easements or public right-of-way by the Contractor without such inspection nor shall any work be commenced without written authorization by the City Engineer. All Construction and Materials shall comply with the City of Wichita Specifications and Standards (on file and available in the City Engineer's Office).

Benchmark:
 "+ " cut N. top of curb,
 N. median of access Road.
 Elev. 1360.60

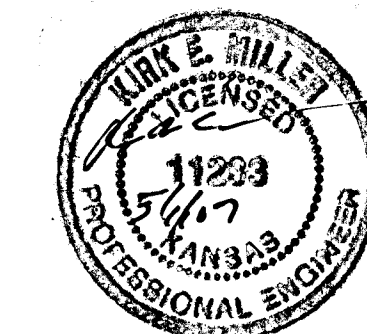

kemiller
engineering

516 S. Market,
Wichita, KS 67202

316/264-0242