


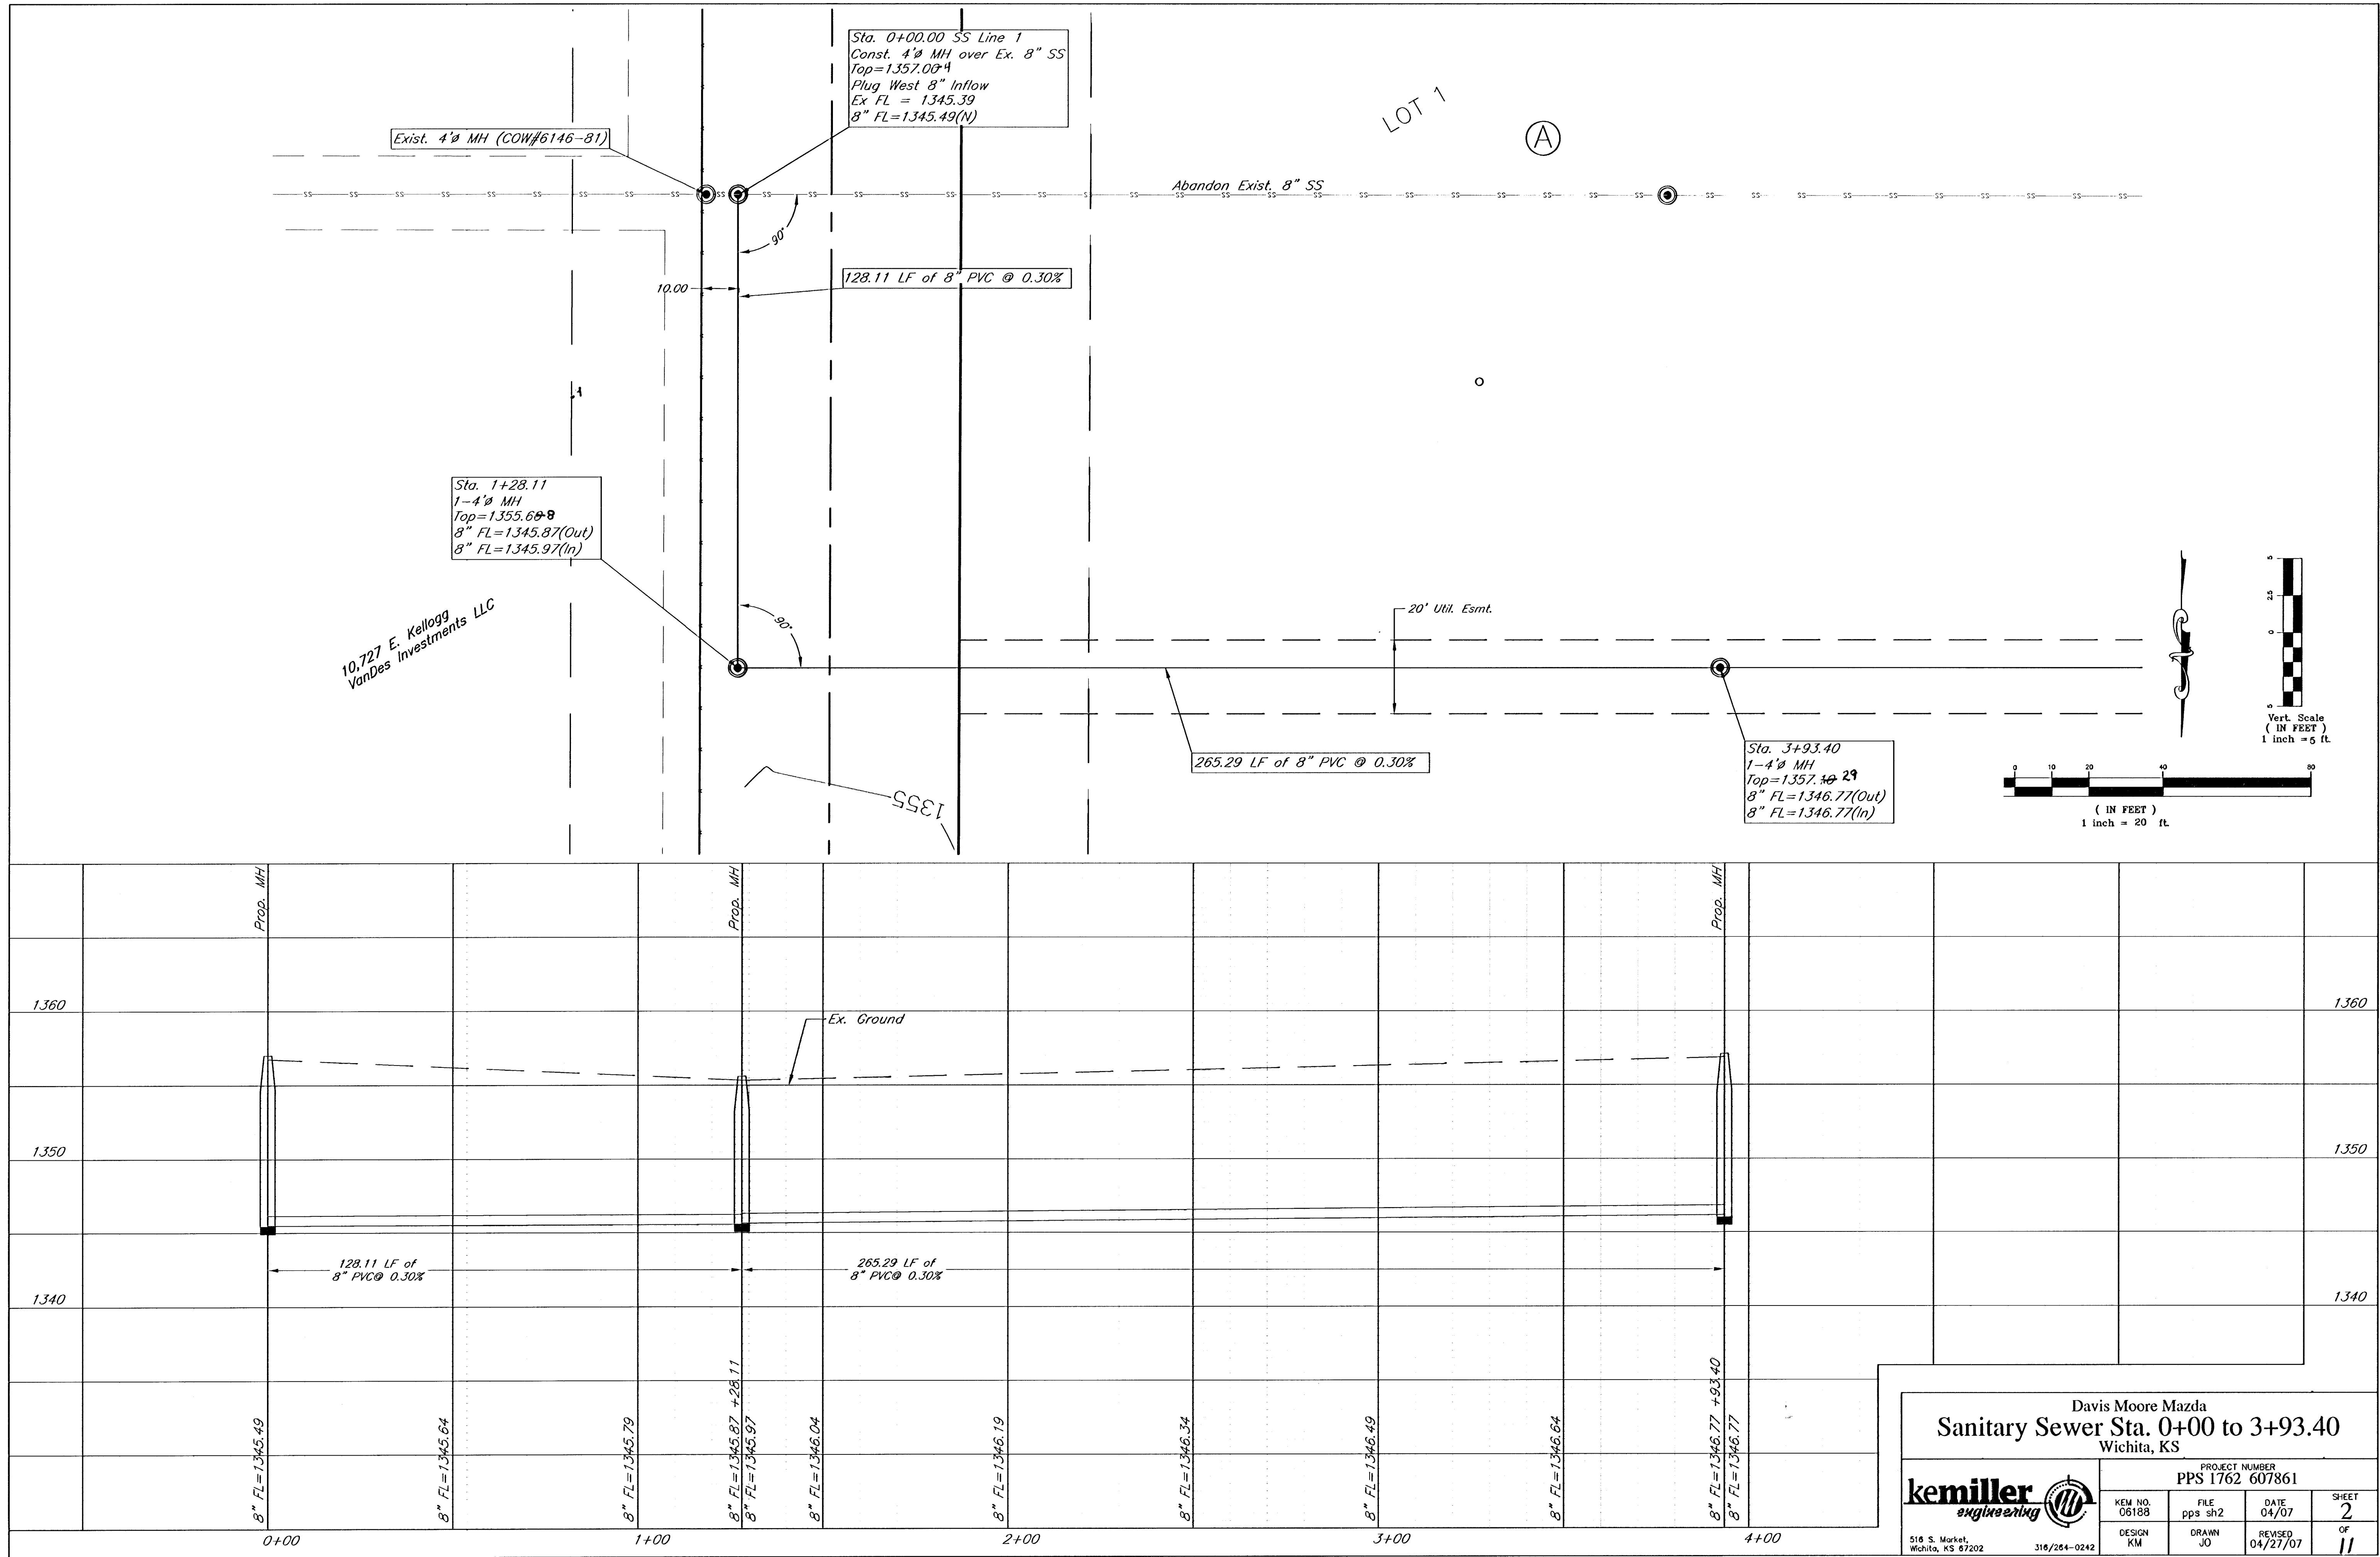

Davis Moore Mazda
Sanitary Sewer Sta. 0+00 to 3+93.40
Wichita, KS

kemiller 

PROJECT NUMBER
PPS 1762 607861

KEM NO.	FILE	DATE	SHEET
06188	pps sh2	04/07	2
DESIGN KM	DRAWN JO	REVISED 04/27/07	OF 11

318 S. Market,
Wichita, KS 67202

318/284-0242