


NOTE:
CONTRACTOR TO VERIFY
LOCATION AND ELEVATION OF
EXIST. 8" WATER LINE PRIOR
TO CONSTRUCTION.

PLAN LINE 1

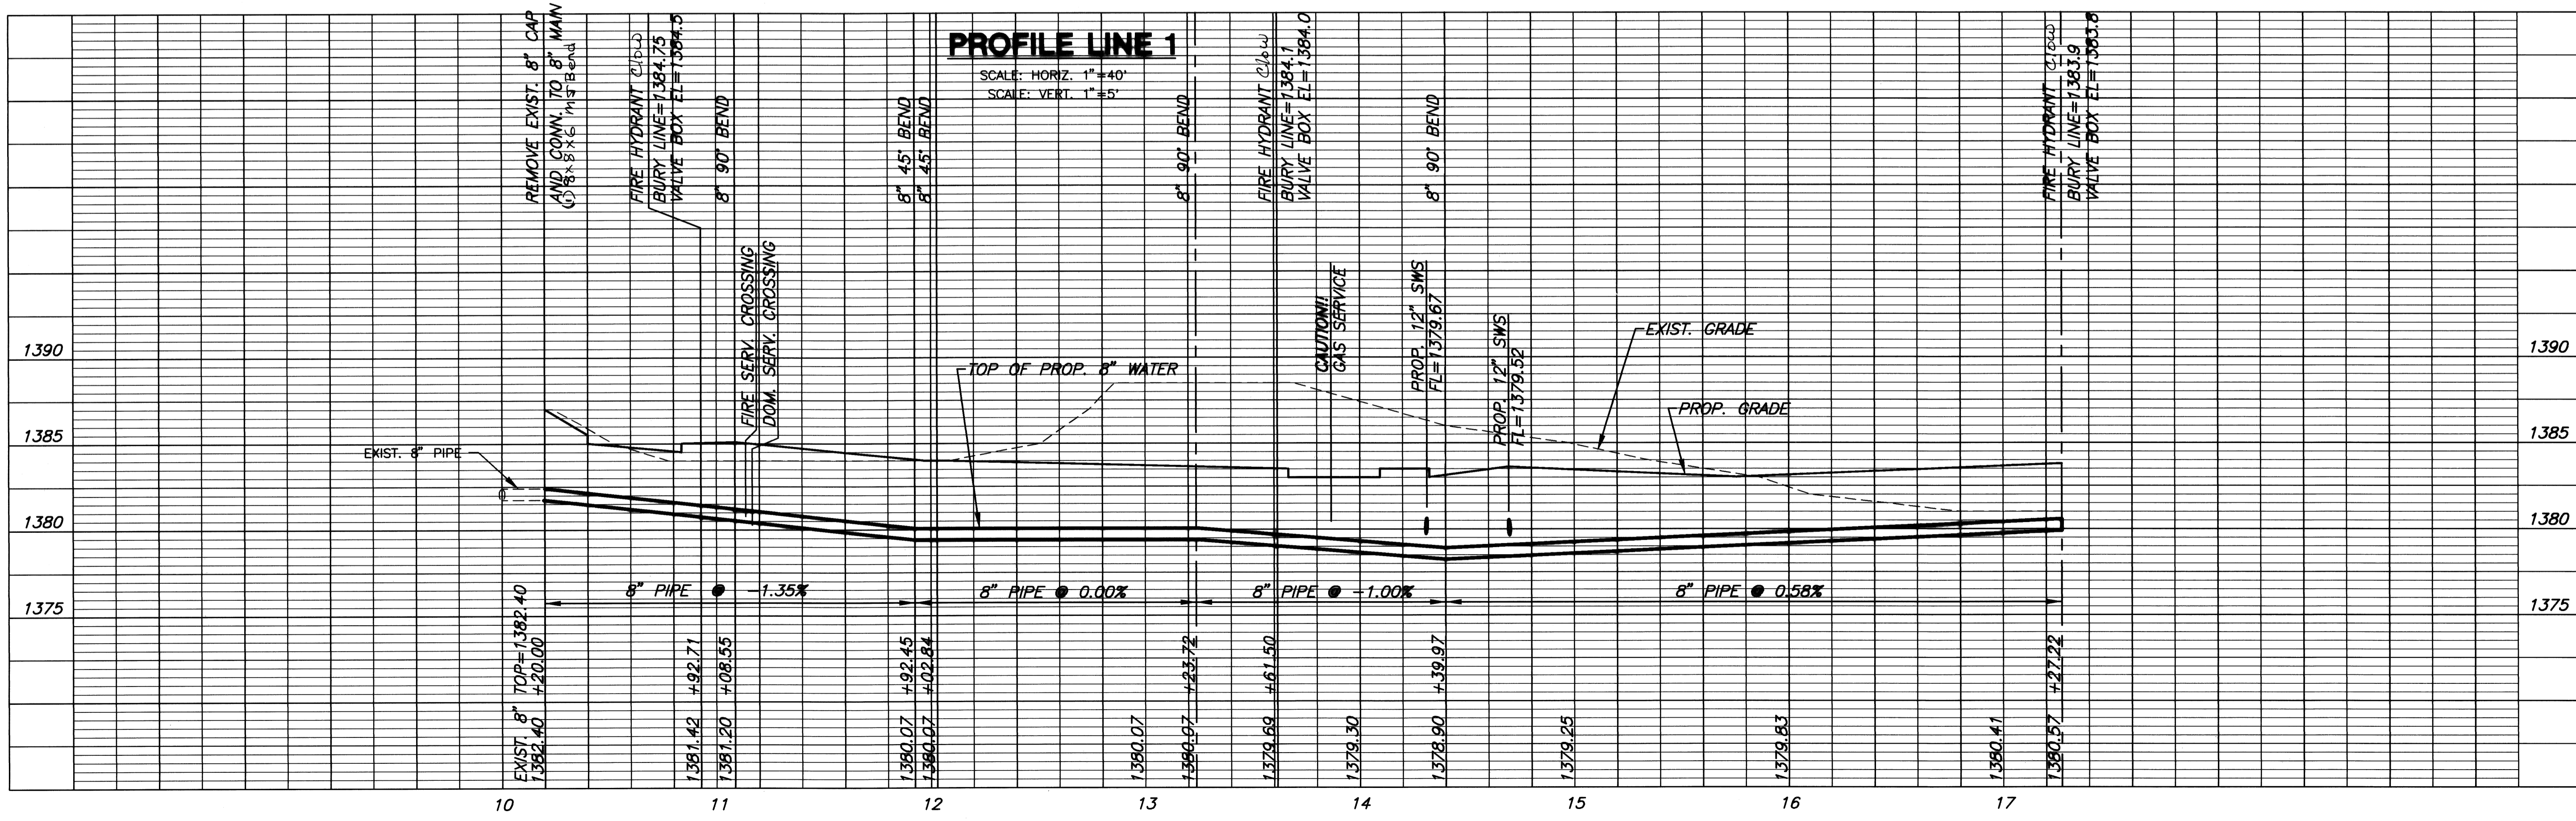

PROFILE LINE 1

**PRIVATE WATER
LINE 1**

SHEET TITLE
PROJECT NUMBER

DESIGN BY
DRAWN BY
CHECKED BY

ISSUED
REVISED