


STA 50+12.00  
 1-FIRE HYDRANT ASSEMBLY  
 (SEE DETAIL SHEETS)  
 L=12.0'  
 BURY LINE ELEV=1275.00  
 VALVE BOX ELEV=1275.00  
 1-8" MJ PLUG (W)  
 N 5573.8265  
 E 4104.1346

STA 31+86.32 (LINE B)=  
 STA 52+39.24 (LINE C)  
 1- 8"x8" CIMJ TEE  
 1- 8" VALVE ASSEMBLY (W)  
 (MJ GATE VALVE)  
 TOP VALVE BOX EL.=1275.70  
 N 5573.8257  
 E 4331.3791

SCALE:  
 PLAN: 1"=20'  
 PROFILE: 1"=20' HORIZ  
 1"=5' VERT

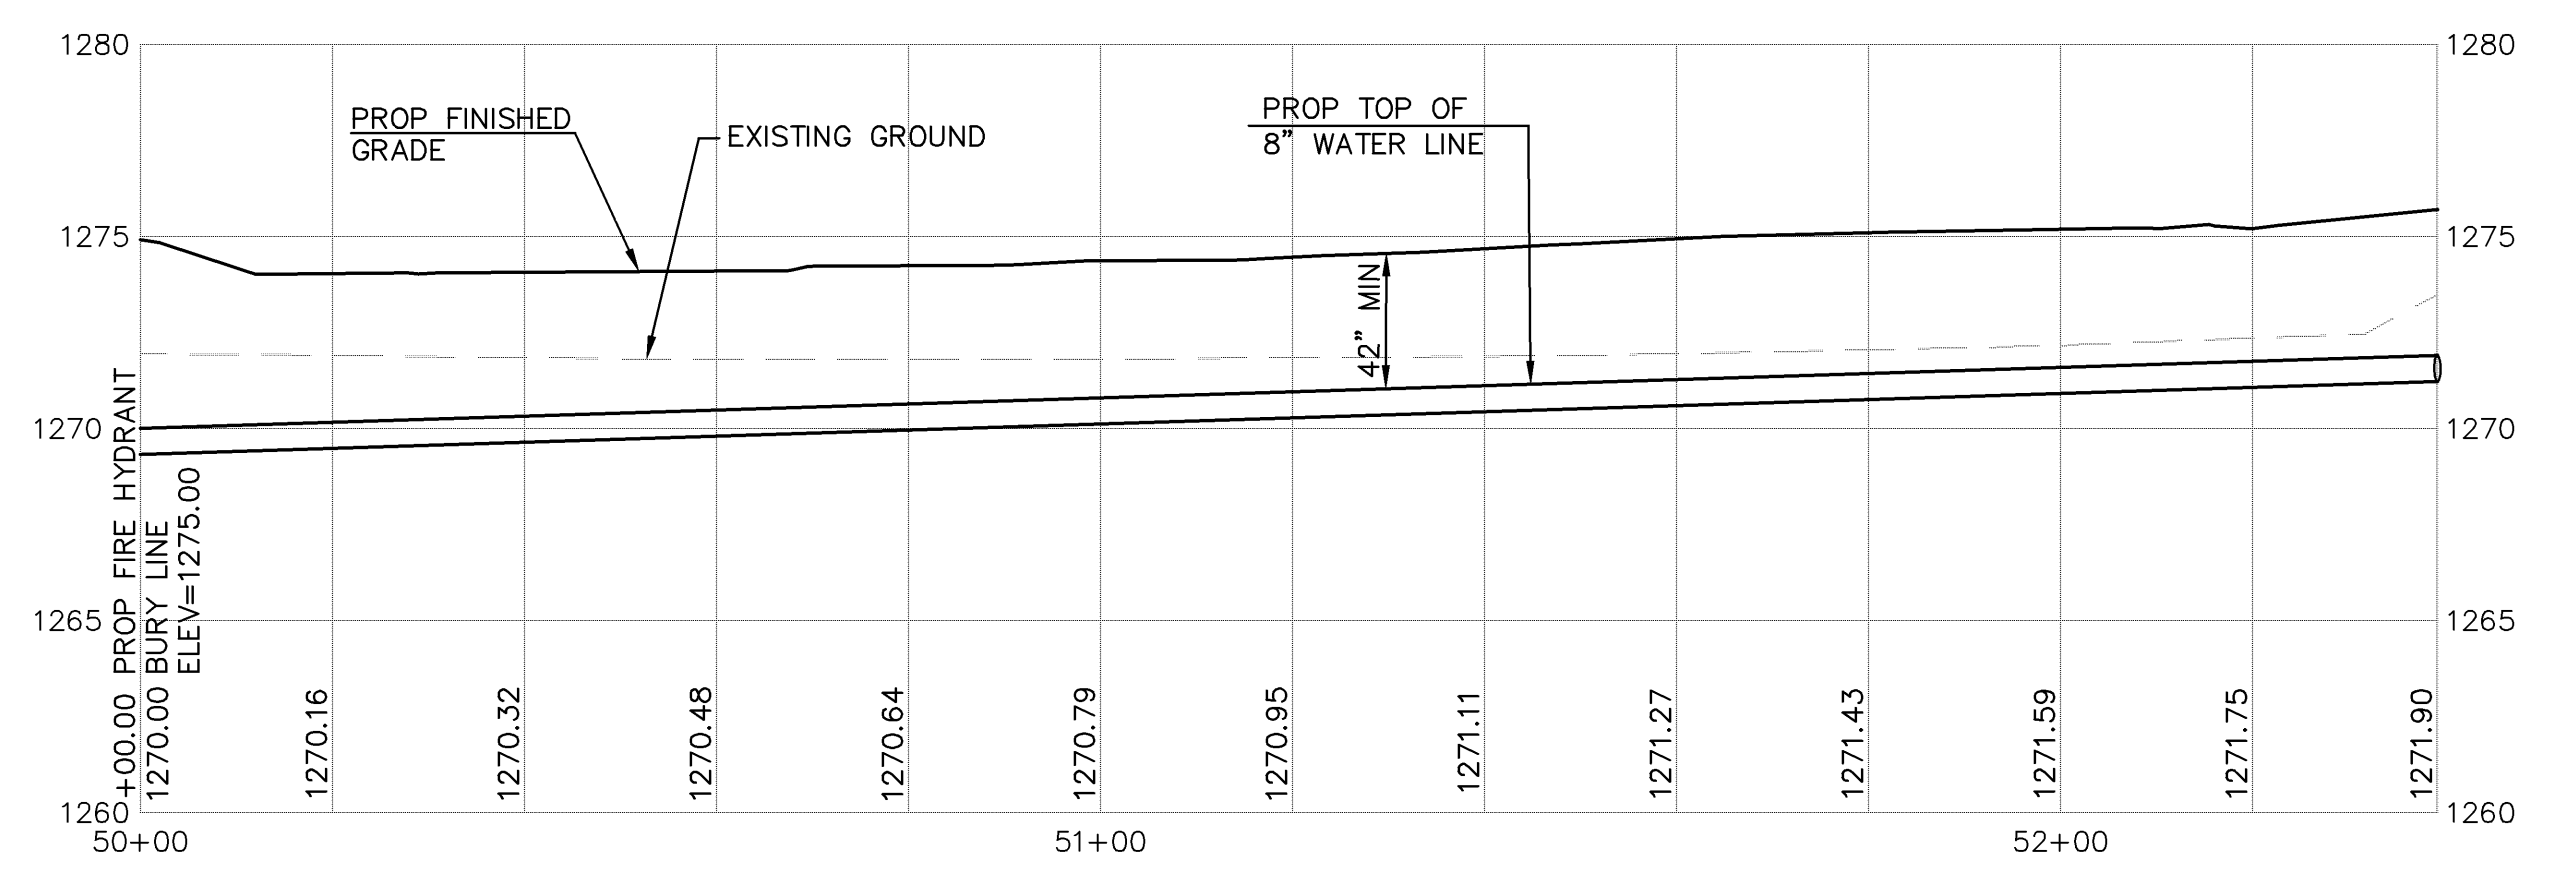

AS-BUILT

<p>2319 NORTH JACKSON          P.O. BOX 1304          JUNCTION CITY, KANSAS 66441          785-762-5040 FAX 785-762-7744          E-MAIL jk@kveing.com          WEB SITE www.kveing.com</p>	
<p>KAW VALLEY ENGINEERING, INC. - CONSULTING ENGINEERS          Offices: Junction City, ks. Kansas City, Mo. Lenexa, ks.</p>	
<p><b>THE HOME DEPOT ADDITION</b>  <b>47TH STREET SOUTH &amp; BROADWAY AVENUE</b>  <b>WICHITA, KANSAS</b></p>	
<p><b>WATER LINE "C" - PLAN &amp; PROFILE</b></p>	
PROJ. NO.	A06_2806
DATE	AUG 2006
DESIGNER	SDM
DRAWN BY	JL
CFN	2806WPP
SHEET	3
5A OF 10	
REV	DATE DESCRIPTION
3	5-13-08 AS BUILT PLANS
2	1-29-07 REVISED PER CITY
1	11-27-06 REVISED PER CITY
DSN	DWN
CHK	CHK

G:\A06\_2806\DESIGN\WATER\AS BUILT\2806WPP.dwg, 5/13/2008 10:31:11 AM, jly

THIS DRAWING SHALL NOT BE UTILIZED BY ANY PERSON, FIRM, OR CORPORATION IN WHOLE OR IN PART WITHOUT THE SPECIFIC PERMISSION OF KAW VALLEY ENGINEERING, INC.