

CURVE TABLE

△ = 116°37'20" R = 219.00' T = 351.75' L = 145.76' LC = 372.70'

CURVE DATA BASED ON WATER LINE △ / 2 = 58°18'40"


STATION	ARC	CHORD LENGTH		TOTAL	
		6' LT Offset	6' RT Offset	DEFLECTION	DEFLECTION
12+88.20	-	-	-	00°00'00"	00°00'00"
13+00.00	11.80'	11.48'	-	01°32'37"	01°32'37"
13+25.00	25.00'	24.30'	-	03°16'13"	04°48'50"
13+50.00	25.00'	24.30'	-	03°16'13"	08°05'03"
13+75.00	25.00'	24.30'	-	03°16'13"	11°21'16"
14+00.00	25.00'	24.30'	-	03°16'13"	14°37'29"
14+25.00	25.00'	24.30'	-	03°16'13"	17°53'42"
14+50.00	25.00'	24.30'	-	03°16'13"	21°09'56"
14+75.00	25.00'	24.30'	-	03°16'13"	24°26'09"
15+00.00	25.00'	24.30'	-	03°16'13"	27°42'22"
15+25.00	25.00'	24.30'	-	03°16'13"	30°58'35"
15+50.00	7.00'	6.81'	-	00°54'56"	31°53'31"
15+50.00	18.00'	17.50'	-	02°21'17"	34°14'48"
15+75.00	25.00'	24.30'	-	03°16'13"	37°31'01"
16+00.00	25.00'	24.30'	-	03°16'13"	40°47'14"
16+25.00	25.00'	24.30'	-	03°16'13"	44°03'27"
16+50.00	25.00'	24.30'	-	03°16'13"	47°19'40"
16+75.00	25.00'	24.30'	-	03°16'13"	50°35'53"
17+00.00	25.00'	24.30'	-	03°16'13"	53°52'07"
17+25.00	25.00'	24.30'	-	03°16'13"	57°08'20"
17+33.96	8.96'	8.72'	-	01°10'20"	58°18'40"

Def/Ft = 7.84874 Min.

RECORD DRAWING
M.T. 1-12-09

PLAN LINES 2 & 4

PROFILE LINE 2

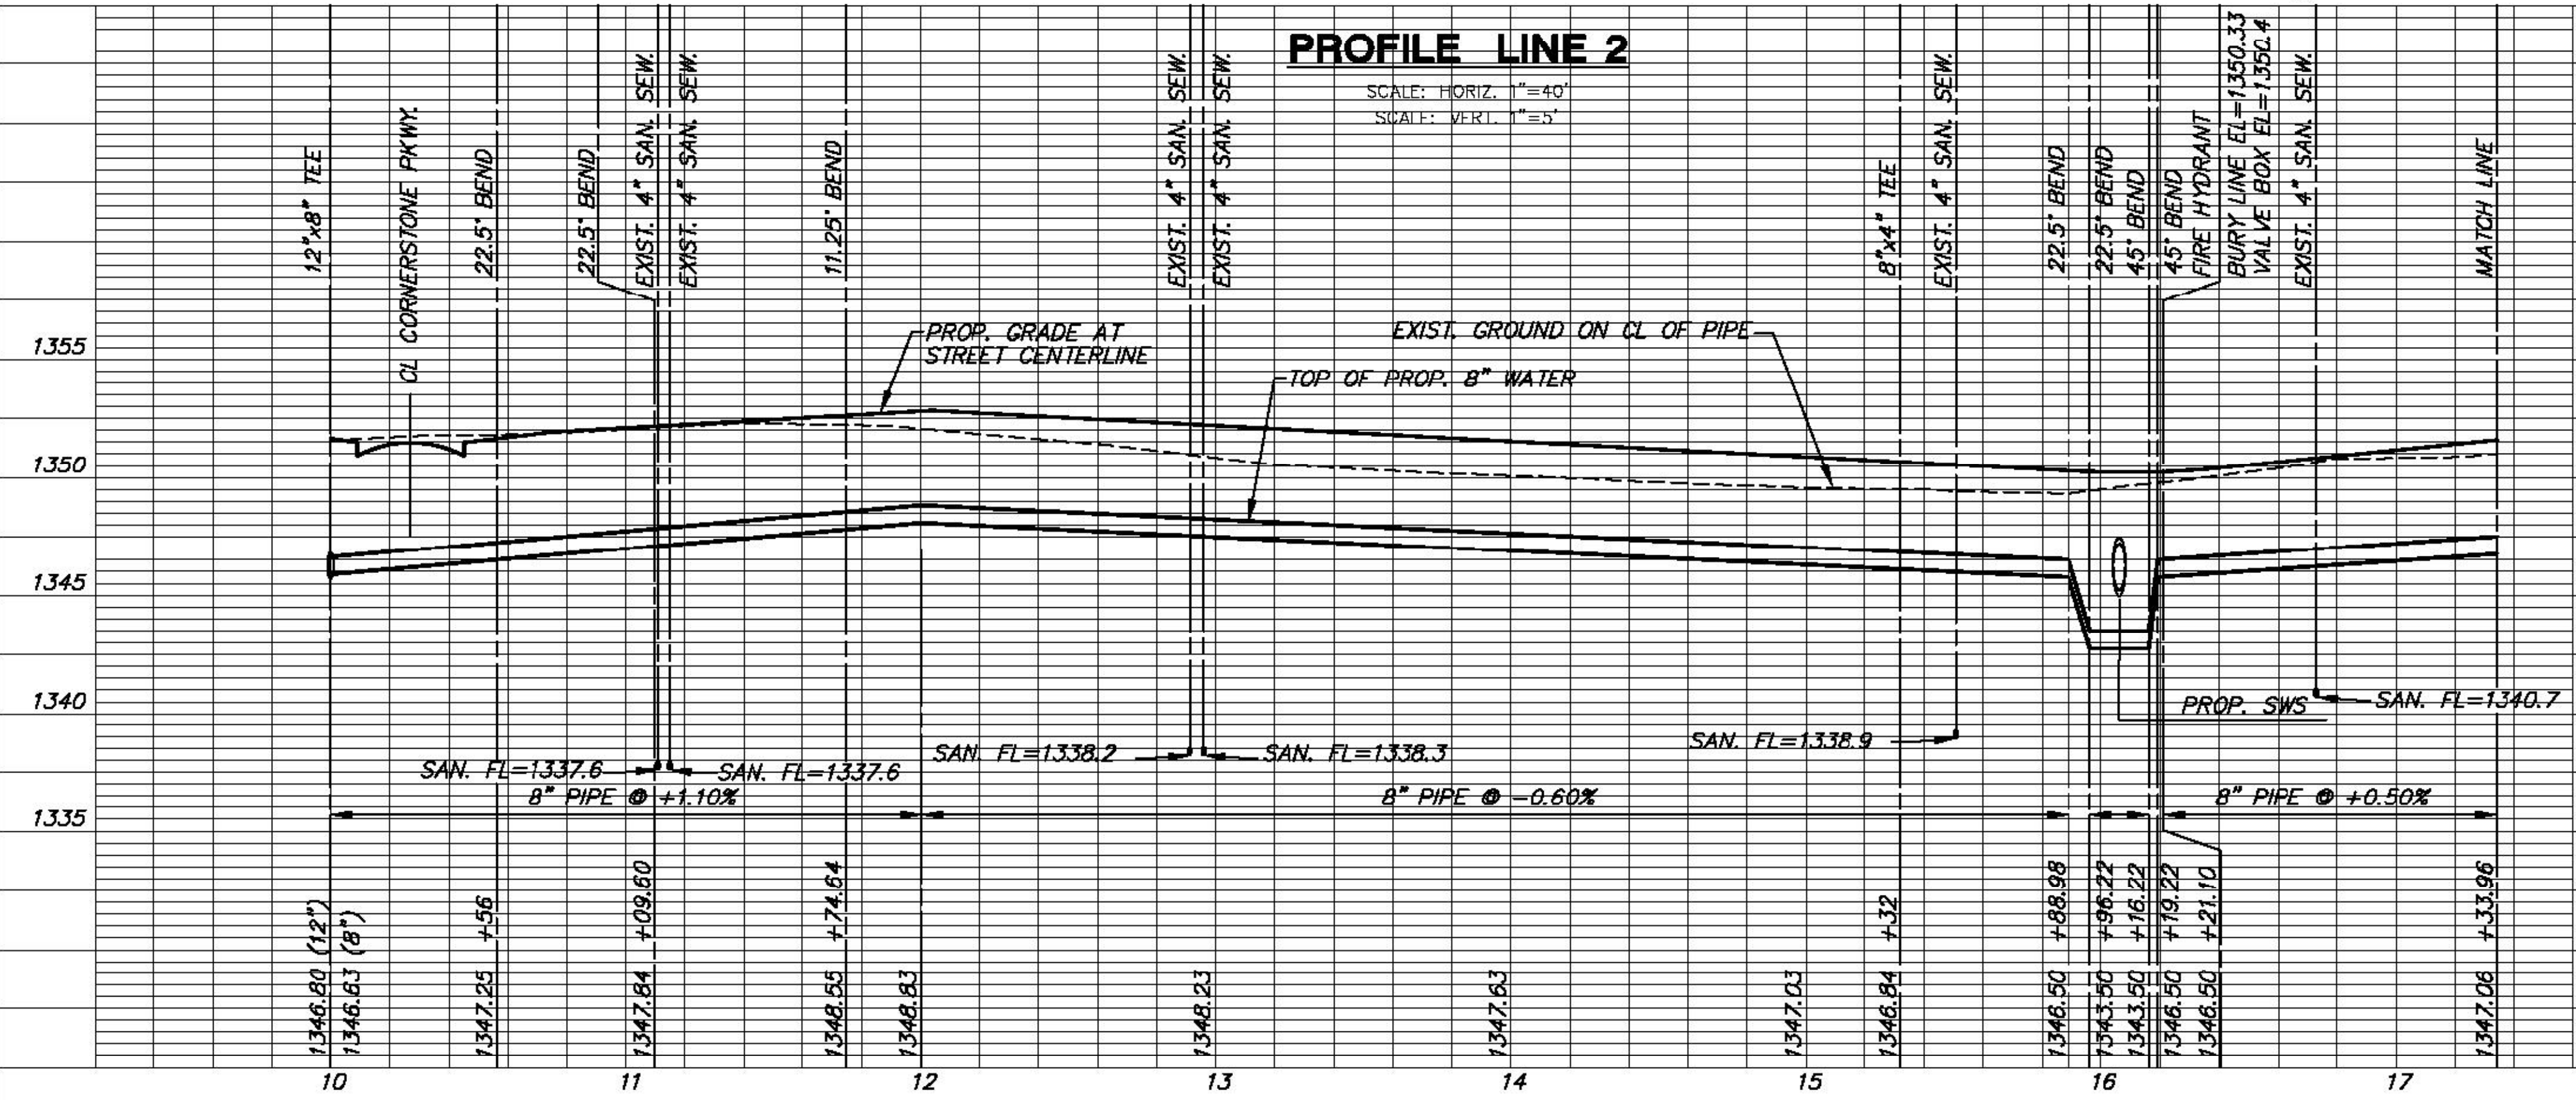

PROFILE LINE 4

