



STORM WATER SEWER PLANS
THE GROVE AT WICHITA

LOT 1, BLOCK 1 CAMPUS CREST

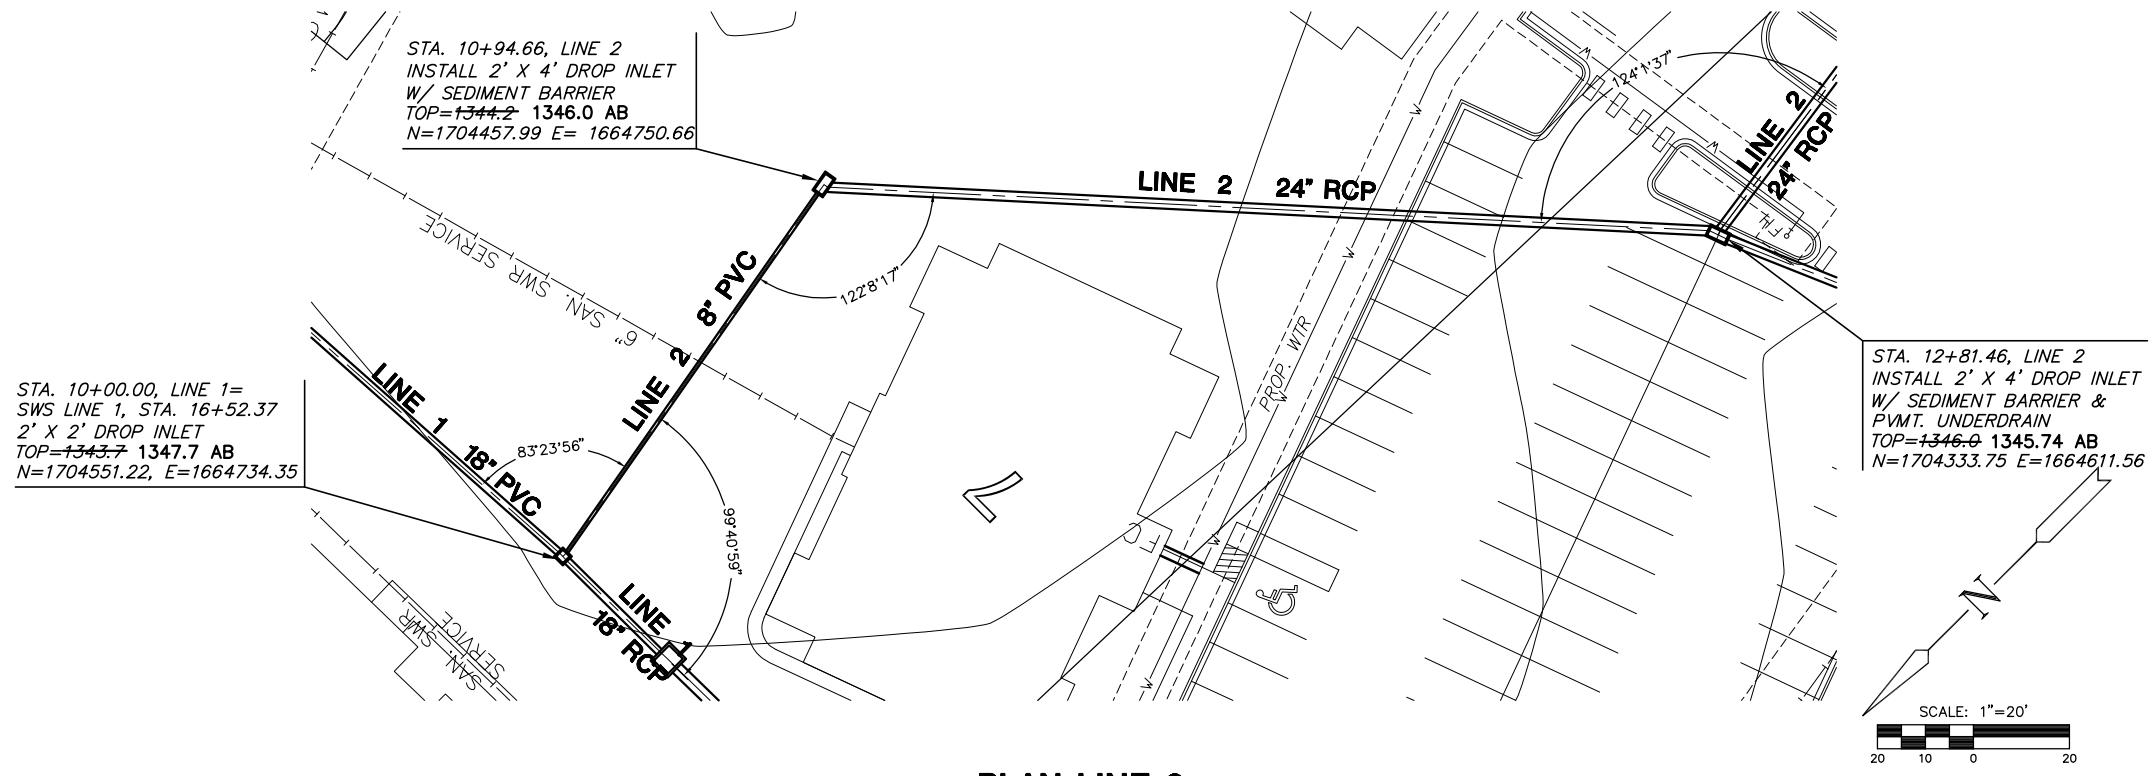

PLAN LINE 2

AS-BUILT 4-1-09

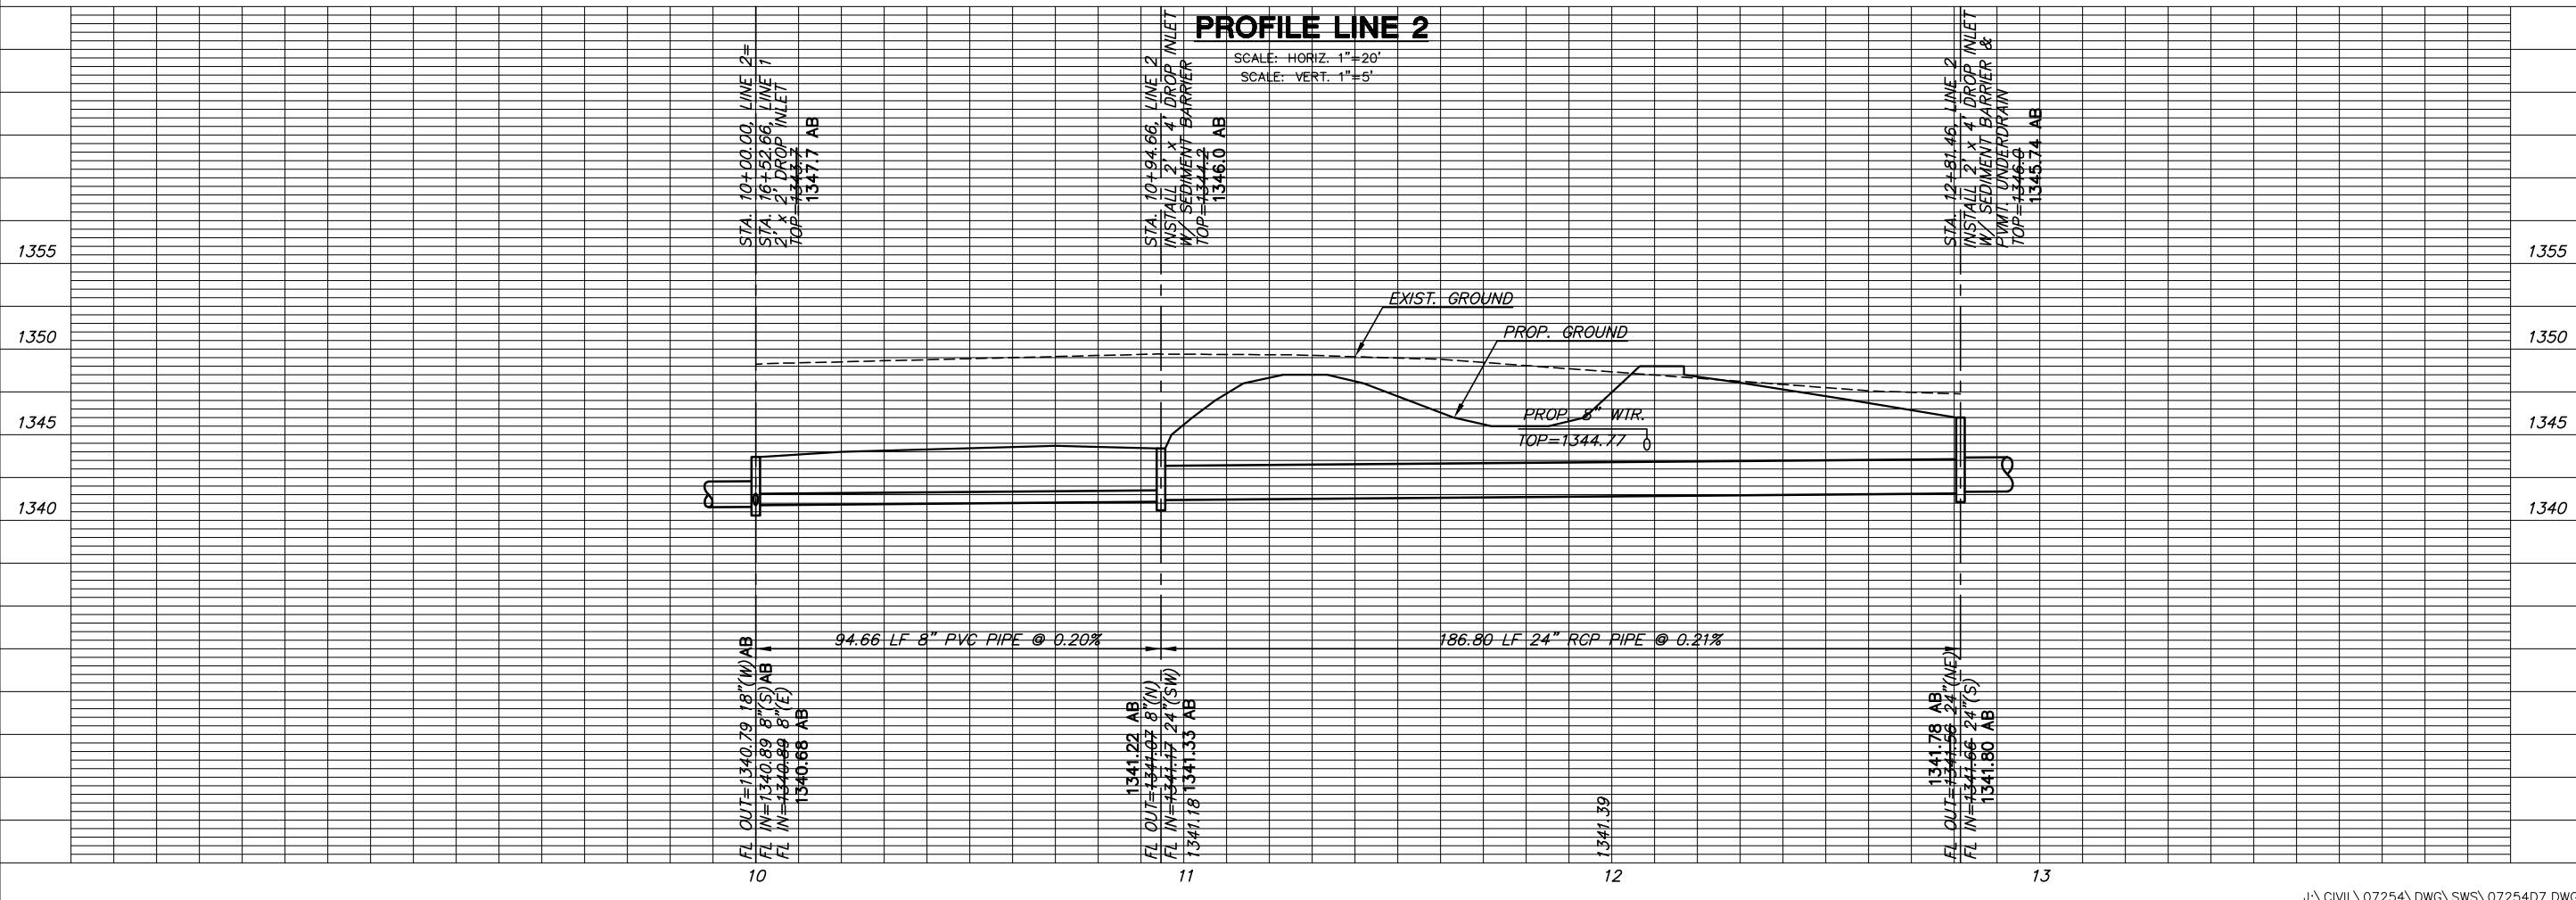

PROFILE LINE 2

SCALE: HORIZ. 1"=20'
SCALE: VERT. 1"=5'

PLOTTED: Thursday, April 02, 2009 @ 02:51PM

LINE 2
SHEET TITLE
07008 (CC)
07254 (MKEC)
PROJECT NUMBER

DESIGN BY: **SRS**
DRAWN BY: **JWC**
CHECKED BY: **GJA**

ISSUED: **DECEMBER 2007**
REVISED: **MARCH 2008**

SHEET NO.
11 of 15