

GENERAL NOTES:

- Contractor will be required to provide notice to utility companies a minimum of Forty-Eight (48) hours prior to any excavation, as follows:
 Kansas One-Call 687-2470
 The Contractor must notify the following in case of an emergency:
 Cox Communications 262-4270
 Kansas Gas Service 1-888-482-4950
 Westar Energy 383-8650
 Aquila Energy 1-800-4303-0357
 AT&T 268-2245
 City of Wichita Water Dept. 268-4563
 City of Wichita Sewer Maint. 268-4024
 City of Wichita Storm Sewer Maint. 268-4090
 City of Wichita Traffic Maint. 268-4034
- Utility service lines, poles, valve boxes, meters, and etcetera are to be adjusted as necessary by others prior to construction unless the plans specifically call for their adjustment by the Contractor or unless the plans specifically identify a utility to be adjusted by its owner during construction. Existing utilities and their location, as shown on the plans, represent the best information obtainable for design. The Contractor will be required to work around existing utilities within the right-of-way which do not conflict with proposed construction.
- All excess material from channel excavation shall be stockpiled within 500 feet west or south of the extent of channel construction at a location to be determined by the engineer. Stockpile shall be seeded with Rye Grass at 5 lbs./1000 sq. ft. and surrounded with silt fencing (x3500 L.F.).
- Trees and shrubs in public right-of-way which are in direct conflict with proposed new construction shall be removed by the Contractor with the Engineer's approval. Trees and shrubs which are not in direct conflict with proposed new construction shall be saved and protected from damage.
- The Contractor shall be responsible for preserving property irons. The Contractor will be required to re-establish any property irons which are damaged or destroyed by his construction operations. Such irons shall be re-established by a licensed land surveyor in accordance with state laws.
- At conclusion of construction, an as-built survey will be completed by the engineer. The contractor will be required to finish and smooth grade all locations as necessary that are not within ±0.3" of plan grade. The contractor shall include all costs associated with the regrading and/or remobilization in the bid item "Channel Excavation."
- All existing and proposed erosion control measures including silt fencing, erosion control mat, straw bales, inlet barriers, and const. entrance shall be maintained throughout construction by the contractor and until project is accepted by the City of Wichita. The on-site engineer shall complete weekly reports on the status of erosion control measures. The contractor shall be required to comply with maintenance and/or replacement of erosion control measures as determined by the on-site engineer until project is accepted by City of Wichita.
- The Contractor shall protect traffic by use of proper and necessary flags, lights, signals, barricades or other warning devices as needed, all in accordance with the latest edition of the Manual On Uniform Traffic Control Devices, U.S. Department of Transportation, Federal Highway Administration. Cost to be included in lump sum bid item "Traffic Control."
- All areas disturbed during construction shall be seeded, mulched, and fertilized as follows (Permanent Seeding):
 Seed: Kansas Premium Fescue Blend: 8 lbs./1000 sq. ft.
 Annual Rye Grass: 2 lbs./1000 sq. ft.
 Mulch: Prairie Hay, 2 tons/acre (no mulch required in areas where Erosion Control Matting is installed)
 Fertilizer: 12-24-12: 850 lbs./acre
 All costs associated with seeding, mulching, and fertilizing shall be included in bid item "Project Seeding." All seeding operations shall conform to City of Wichita Standard Specifications.
- Best available topsoil shall be stripped and stockpiled separately. Channel bottom and side slopes shall be overexcavated 9" and replaced with 9" of best available topsoil. Topsoil shall be compacted to a minimum of 90% Standard Proctor Density. Cost of overexcavation is incidental to Bid Item "Channel Excavation."
- Abandoned dewatering wells will be encountered during construction of the channel. Contractor shall cut or break well pipe at least 2 feet below proposed grade. All costs associated with cutting or breaking dewatering wells shall be included in "Site Clearing and Restoration."
- See Special Provisions for Required Construction Completion Date and related Incentives/Damages.

STORM WATER DRAIN #307

to serve

NORTHGATE ADDITION & UNPLATTED TRACT "B"

CITY OF WICHITA, KANSAS

James L. Armour, P.E. City Engineer

Project Number

468-84253

O.C.A. Number

751445

Sheet Index


Title Sheet	1
Channel Plan	2-7
RCBC Plan	8
Const. Phasing & Shoofty Plan	9
Traffic Control Detail	10
RCBC Details	11-14
Handrail Details	15
Erosion Control BMP's	16-19
Channel Cross Sections	20,21
Coordinate Sheet	22

Benchmark

COW Benchmark at the intersection of Meridian and 53rd St. N, NE Corner
 Top of Concrete Headwall.
 44' North of Centerline
 37' East of Centerline
 50.90' NE of Section Corner
 9' NE of and radial to curb
 26' East of Section Line
 Elev. = 1391.37 NGVD29

COW Benchmark at the intersection of Meridian and Kaywest, NW Corner,
 59' West of Centerline
 32.3' North of Centerline
 11.8' North of N curb line of Kaywest
 4.8' NW of center of Power Pole
 Elev. = 1379.35 NGVD29


SITE

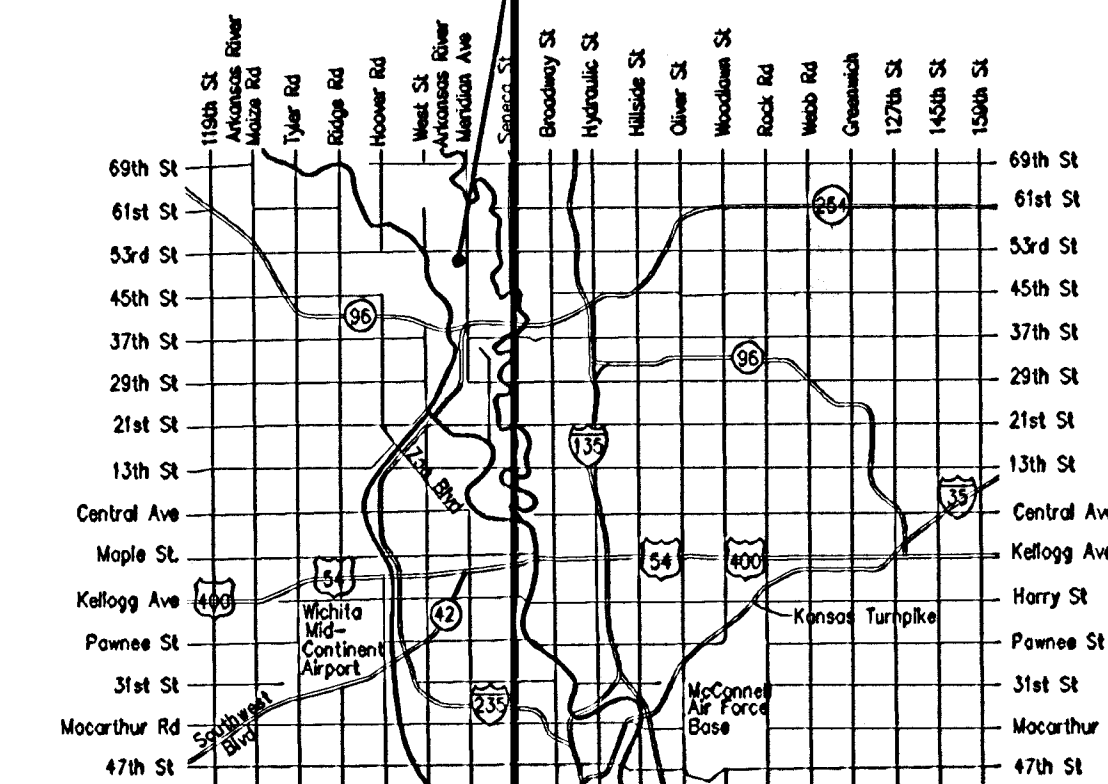

Vicinity Map

AsB. It- 6/18/07 KK

March 2007

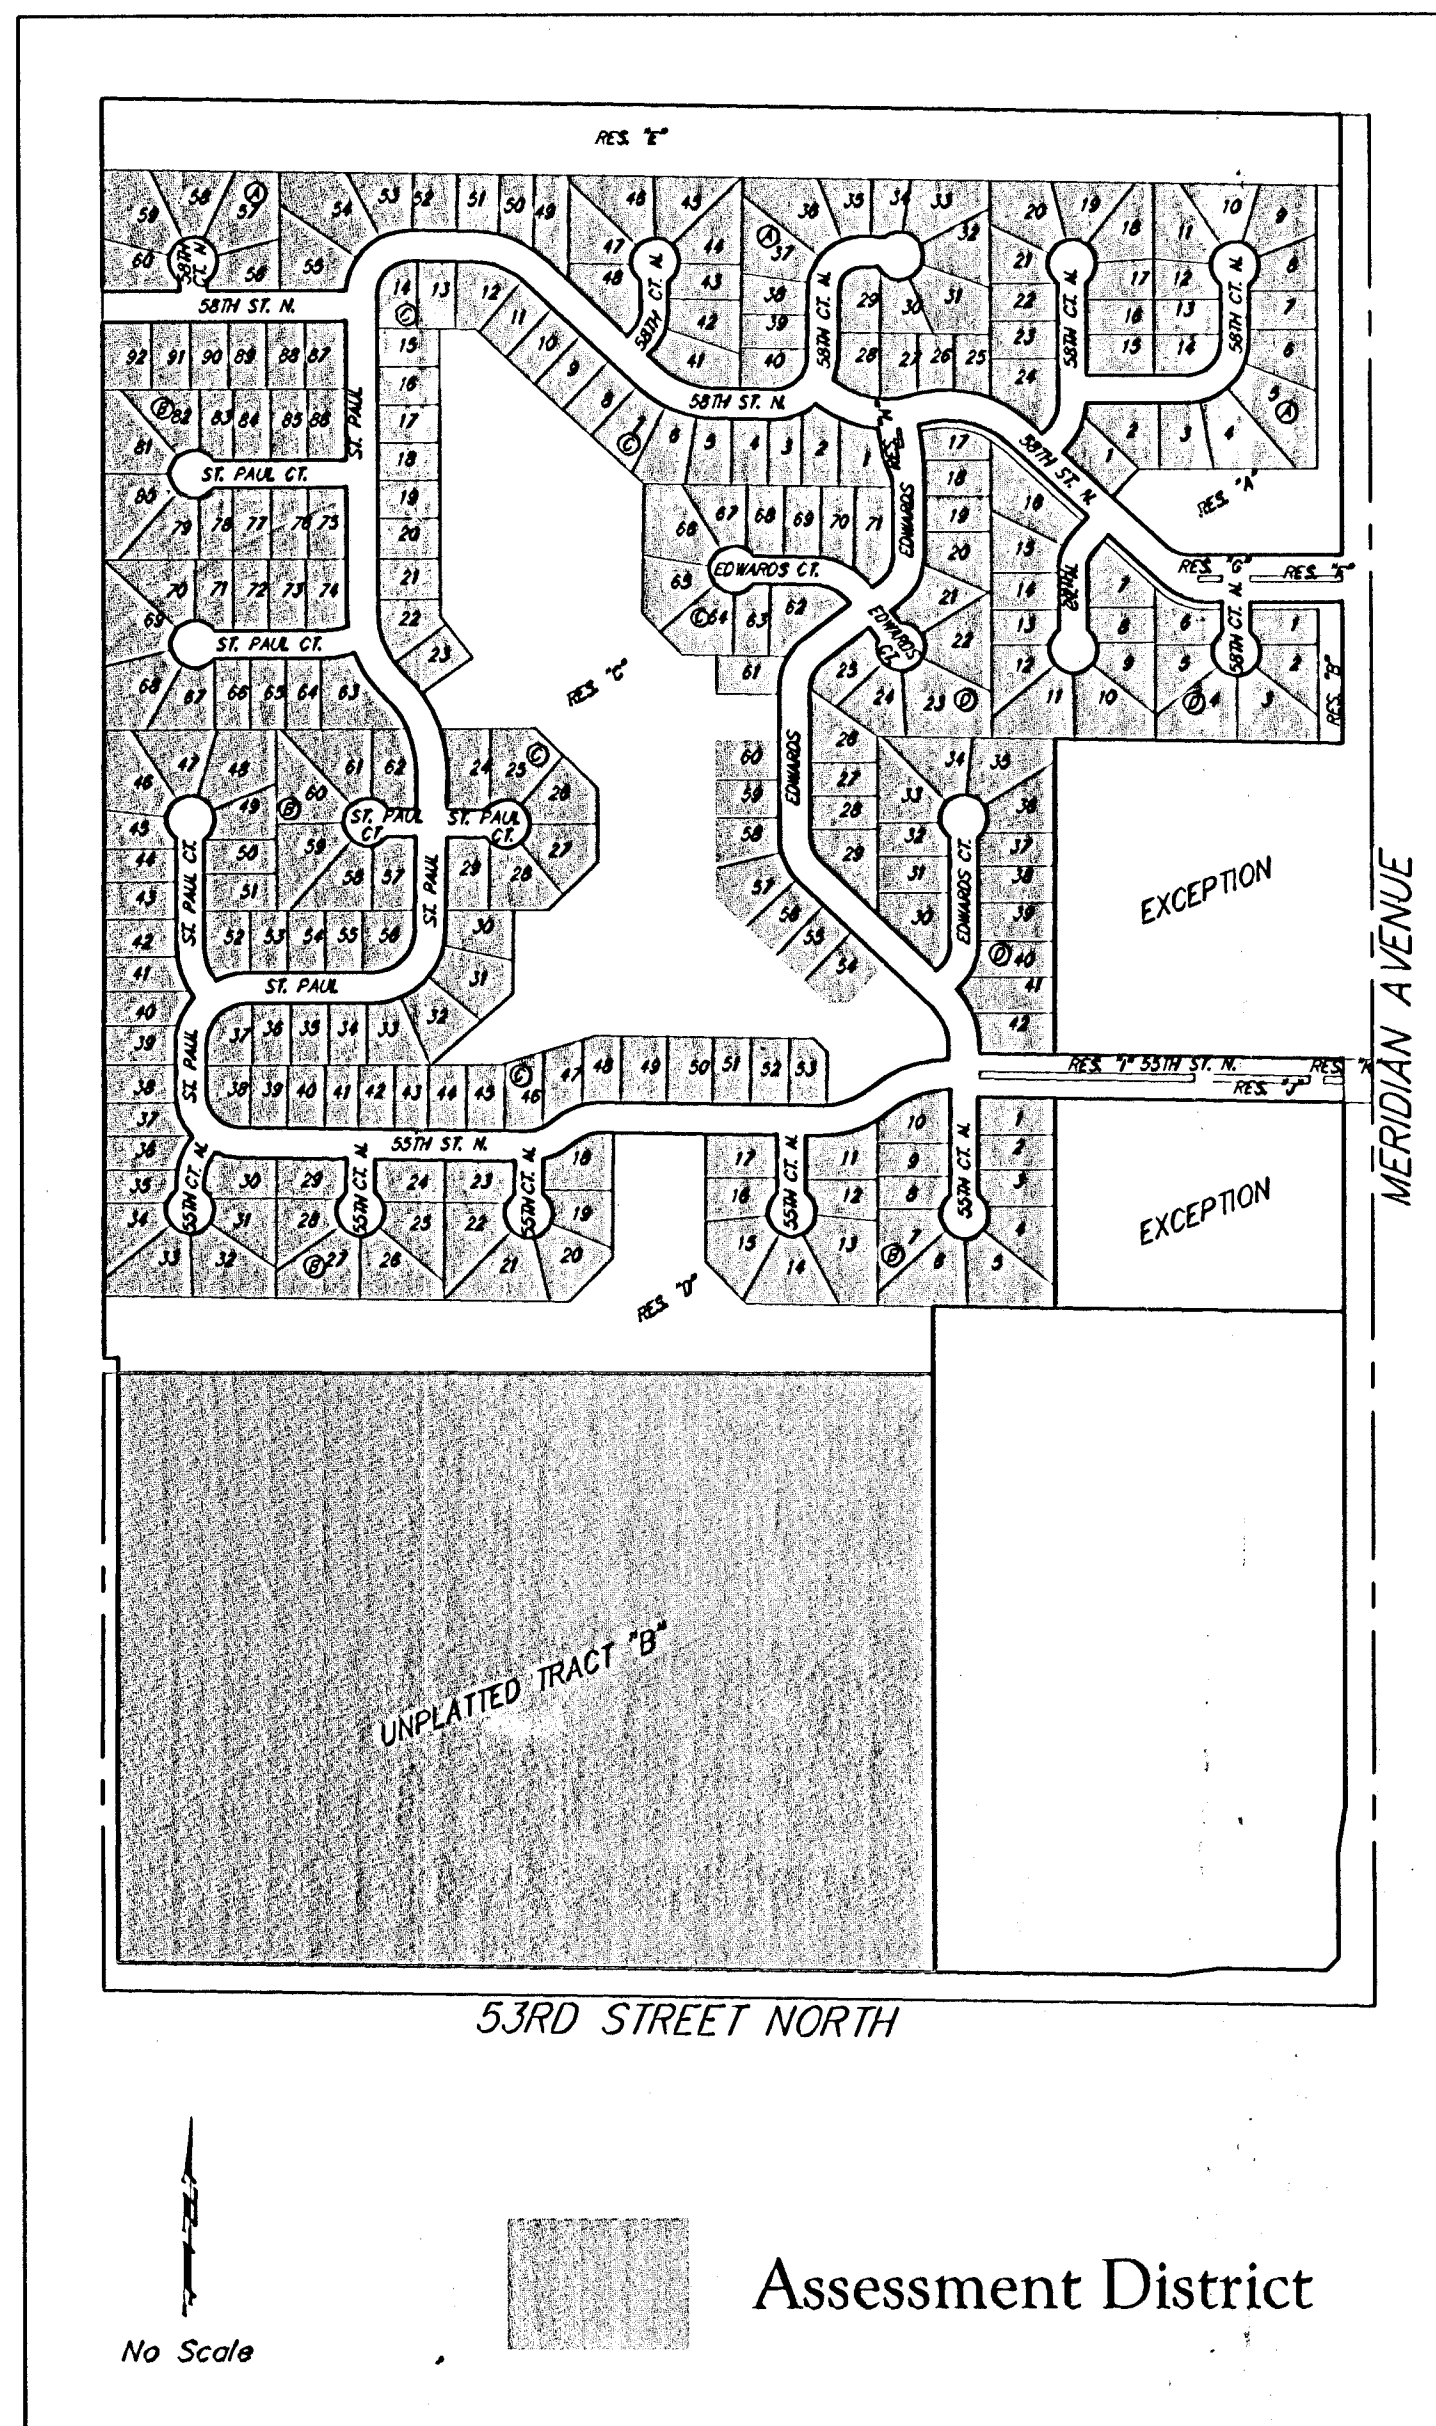

R & R Realty LLC
 Bldg. 1000
 8100 E 22nd St N
 Wichita, KS 67226-2310

Scale: 1" = 200'


EARTH WORK TOTALS	
	C.Y. Excavation C.Y. Fill
Channel Grading	34,094

Earthwork quantities are unadjusted and are for reference only. All cost shall be incidental to "Channel Excavation".

CBB Northlakes LLC
 4647 N Meridian
 Wichita, KS 67204-2401



Baughman Company, P.A. 315 Ellis St. Wichita, KS 67211 P 316-262-7271 F 316-262-0149
 ENGINEERING | SURVEYING | PLANNING | LANDSCAPE ARCHITECTURE

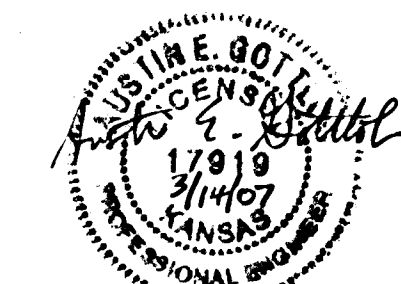


COIW Benchmark at the Intersection of Meridian and 53rd St N, NE Corner, Top of Concrete Headwall, 44' North of Centerline, 37' East of Centerline, 50.90' NE of Section Corner, 9' NE of and radial to curb, 26' East of Section Line, Elev. = 1331.37 NGVD29

COIW Benchmark at the Intersection of Meridian and Keywest, NW Corner, 59' West of Centerline, 32.3' North of Centerline, 11.8' North of N curb line of Keywest, 4.8' NW of center of Power Pole, Elev. = 1329.36 NGVD29

CBB Northlakes LLC
4647 N Meridian
Wichita, KS 67204-2401

Scale: 1" = 20'

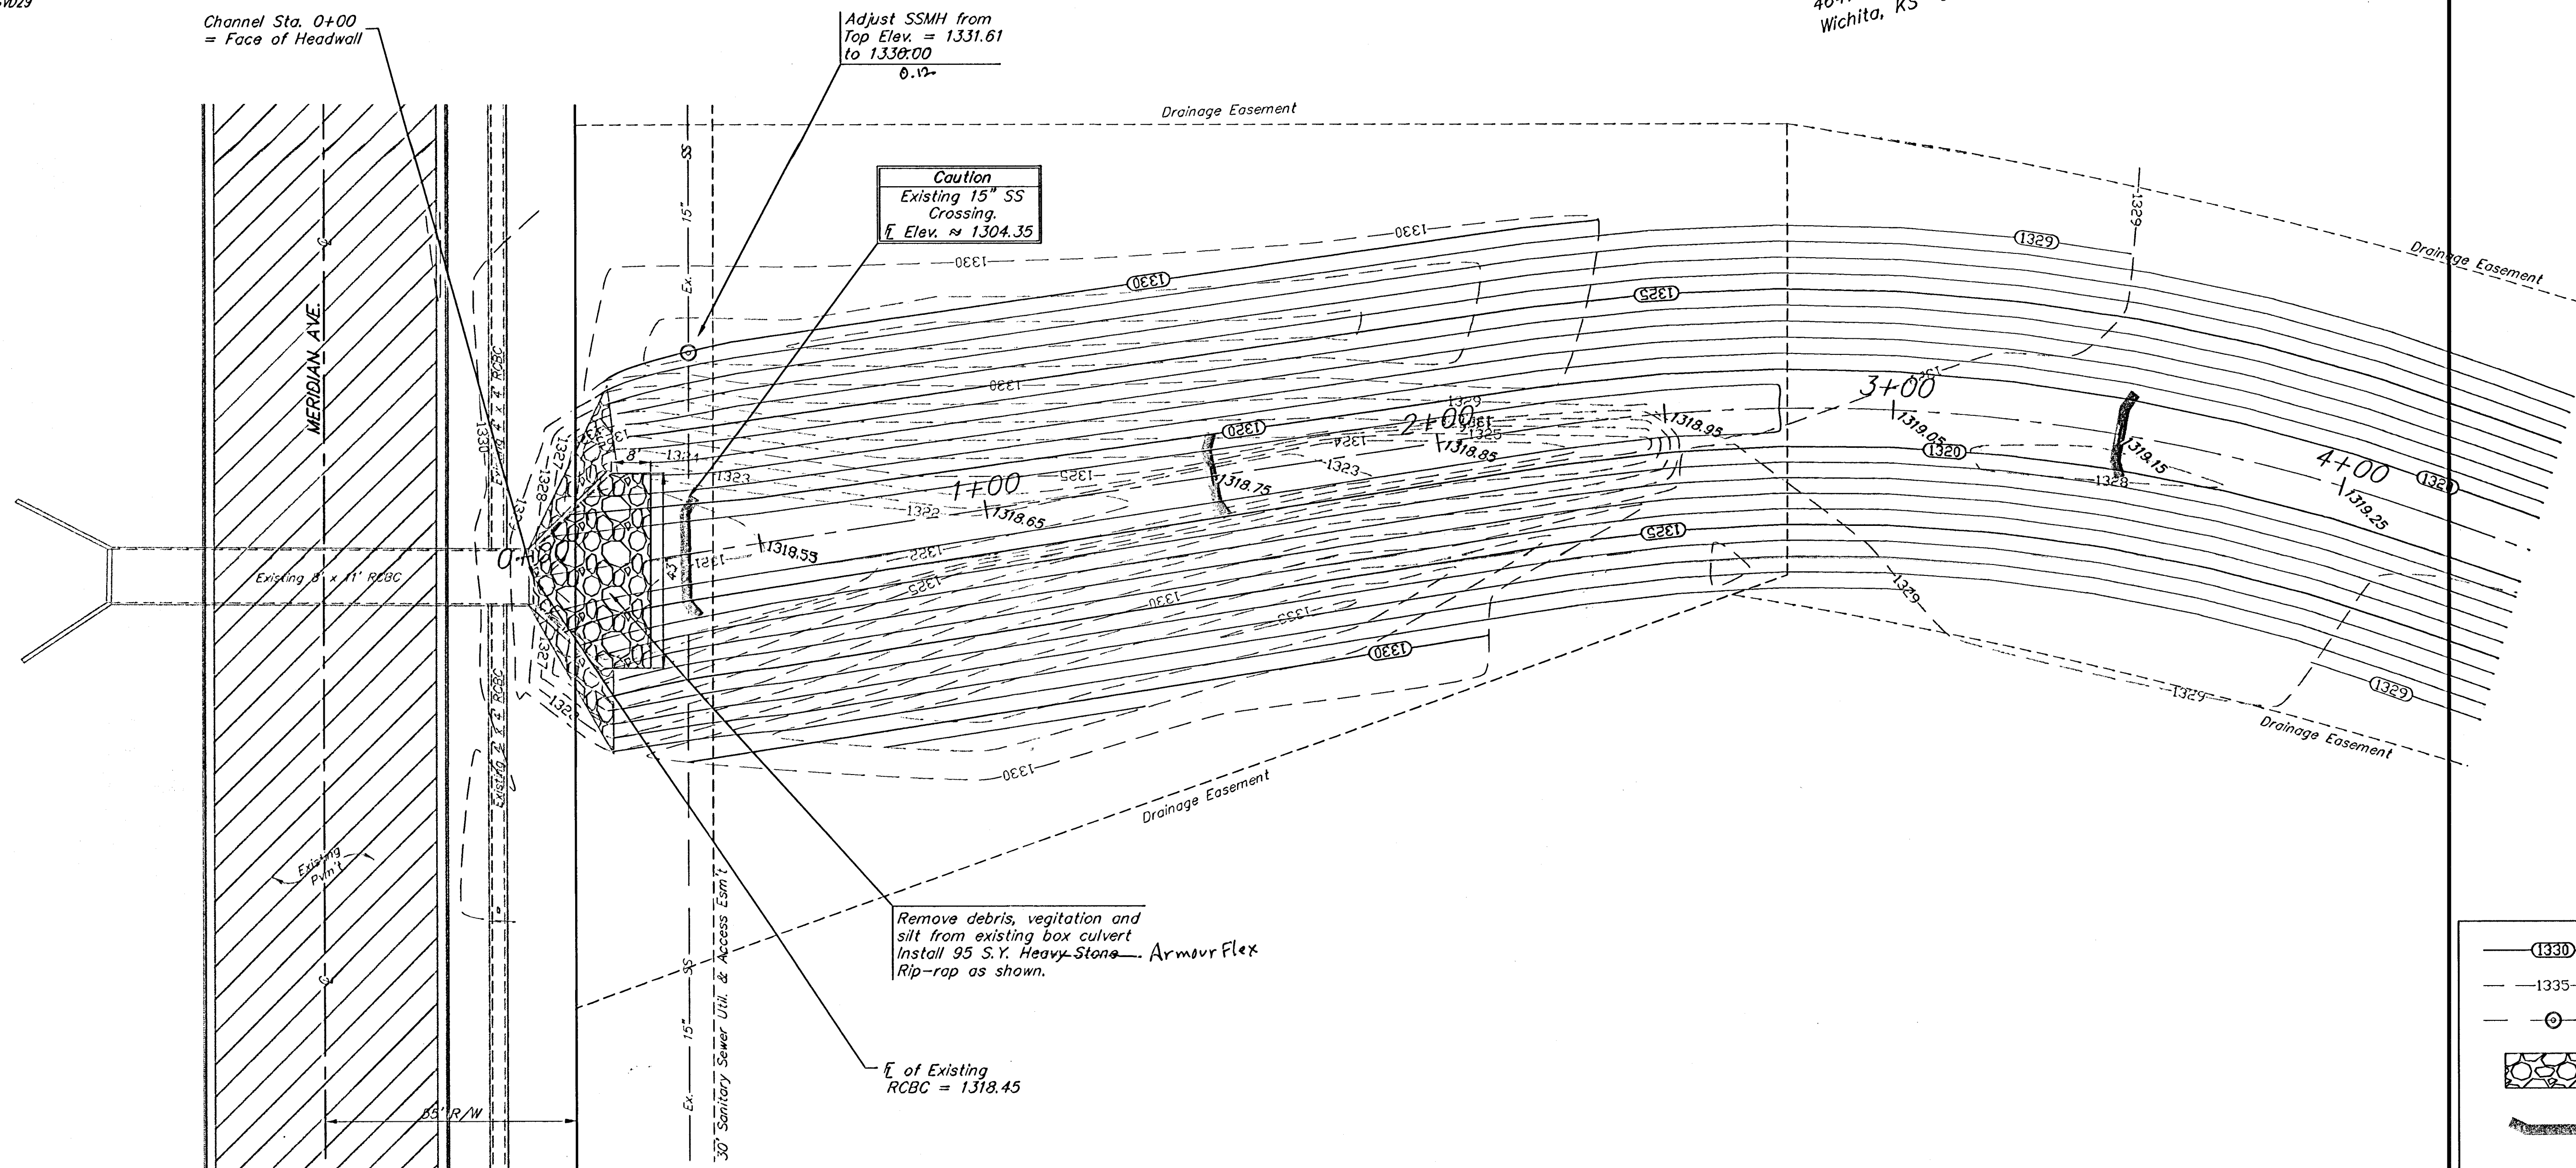

Caution
Existing 15" SS
Crossing.
F. Elev. = 1304.35

Adjust SSMH from
Top Elev. = 1331.61
to 1330.00
0.12-

Remove debris, vegetation and
silt from existing box culvert
Install 95 S.Y. Heavy Stone - Armour Flex
Rip-rap as shown.

E of Existing
RCBC = 1318.45

EROSION CONTROL MEASURE	UNITS	QUANTITY
INSTALL STRAW BALE BARRIER	EA	3
INSTALL HEAVY-STONE RIP RAP	SY	95

QUANTITIES ARE FOR INFORMATION ONLY!
CONTRACTOR SHALL VERIFY QUANTITIES PER
FINAL BID QUANTITY SHEET.

Proposed Contours
 Existing Contours
 Existing San. Sewer
 Rip Rap to be installed
 Straw Bale Barriers to be installed (This Project)
 Dewatering Well (Abandoned)

As Built 6/18/07 KR



Northgate Offsite Drainage
Channel Plan
 Storm Water Drain #307
 Baughman Company, P.A. 315 E. 10th St. Wichita, KS 67211 P 316-265-7211 F 316-262-0149
 ENGINEERING | SURVEYING | PLANNING | LANDSCAPE ARCHITECTURE
 PROJECT NUMBER: 468-04253 DESIGN: RDM/AEG DRAWN: RDM
 APPROVED: AEG DATE: 3-14-07
 SCALE: Noted
 SHEET: **2 OF 22**
 Northgate\53rd St SWD\OFFSITE CHANNEL.dwg

COW Benchmark at the Intersection of Meridian and 53rd St N, NE Corner, Top of Concrete Headwall, 44' North of Centerline, 37' East of Centerline, 50.90' NE of Section Corner, 9' NE of and radial to curb, 26' East of Section Line, Elev. = 1331.37 NGVD29

COW Benchmark at the intersection of Meridian and Keywest, NW Corner, 59' West of Centerline, 32.3' North of Centerline, 11.8' North of N curb line of Keywest, 4.8' NW of center of Power Pole, Elev. = 1329.36 NGVD29

CBB Northlakes LLC
4647 N Meridian
Wichita, KS 67204-2401

Scale: 1" = 20'

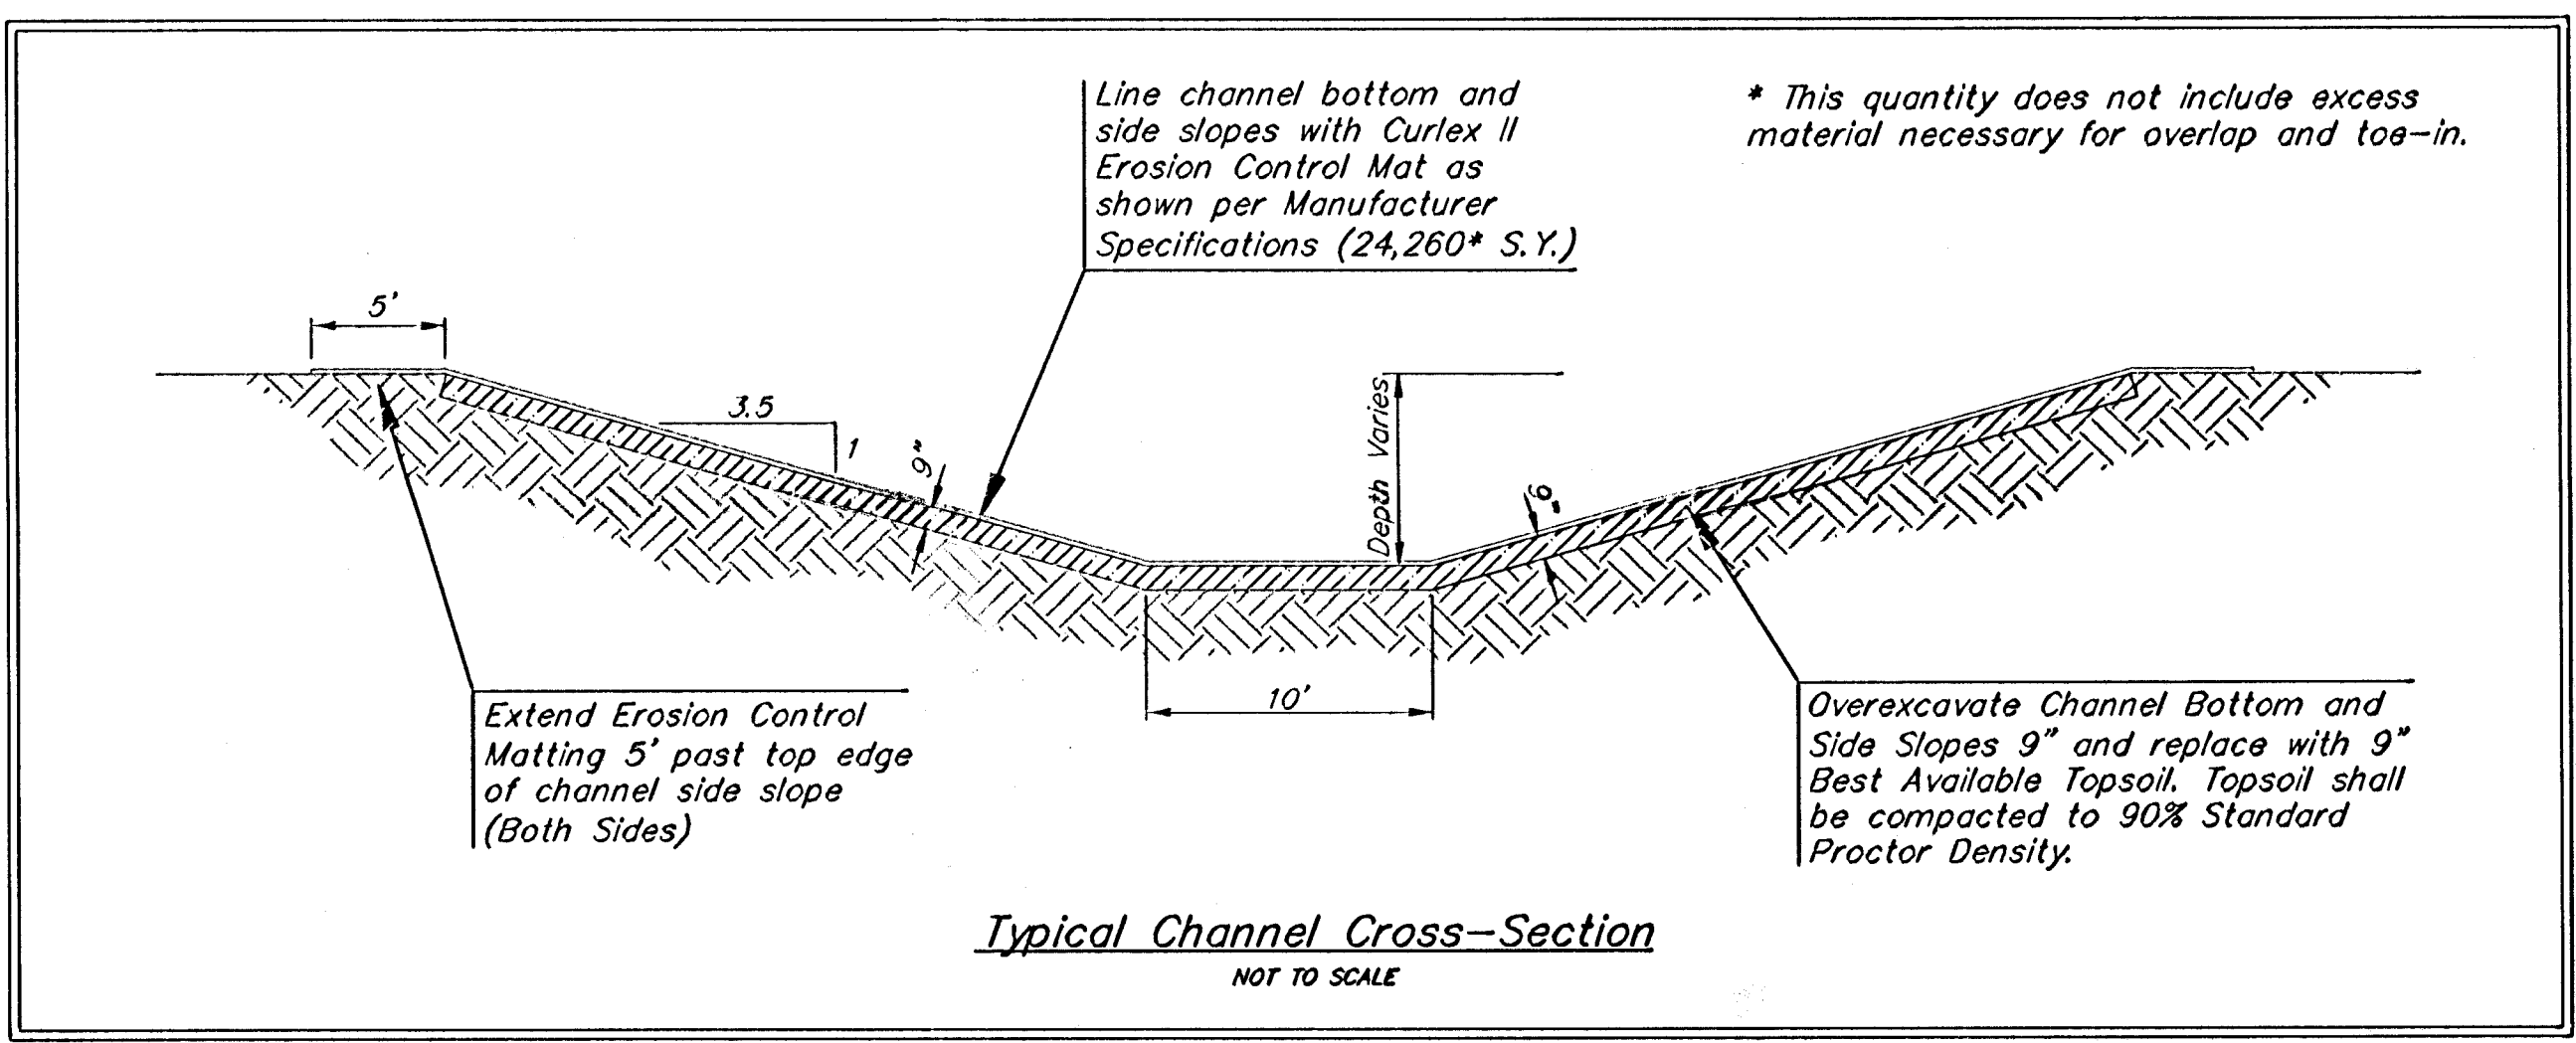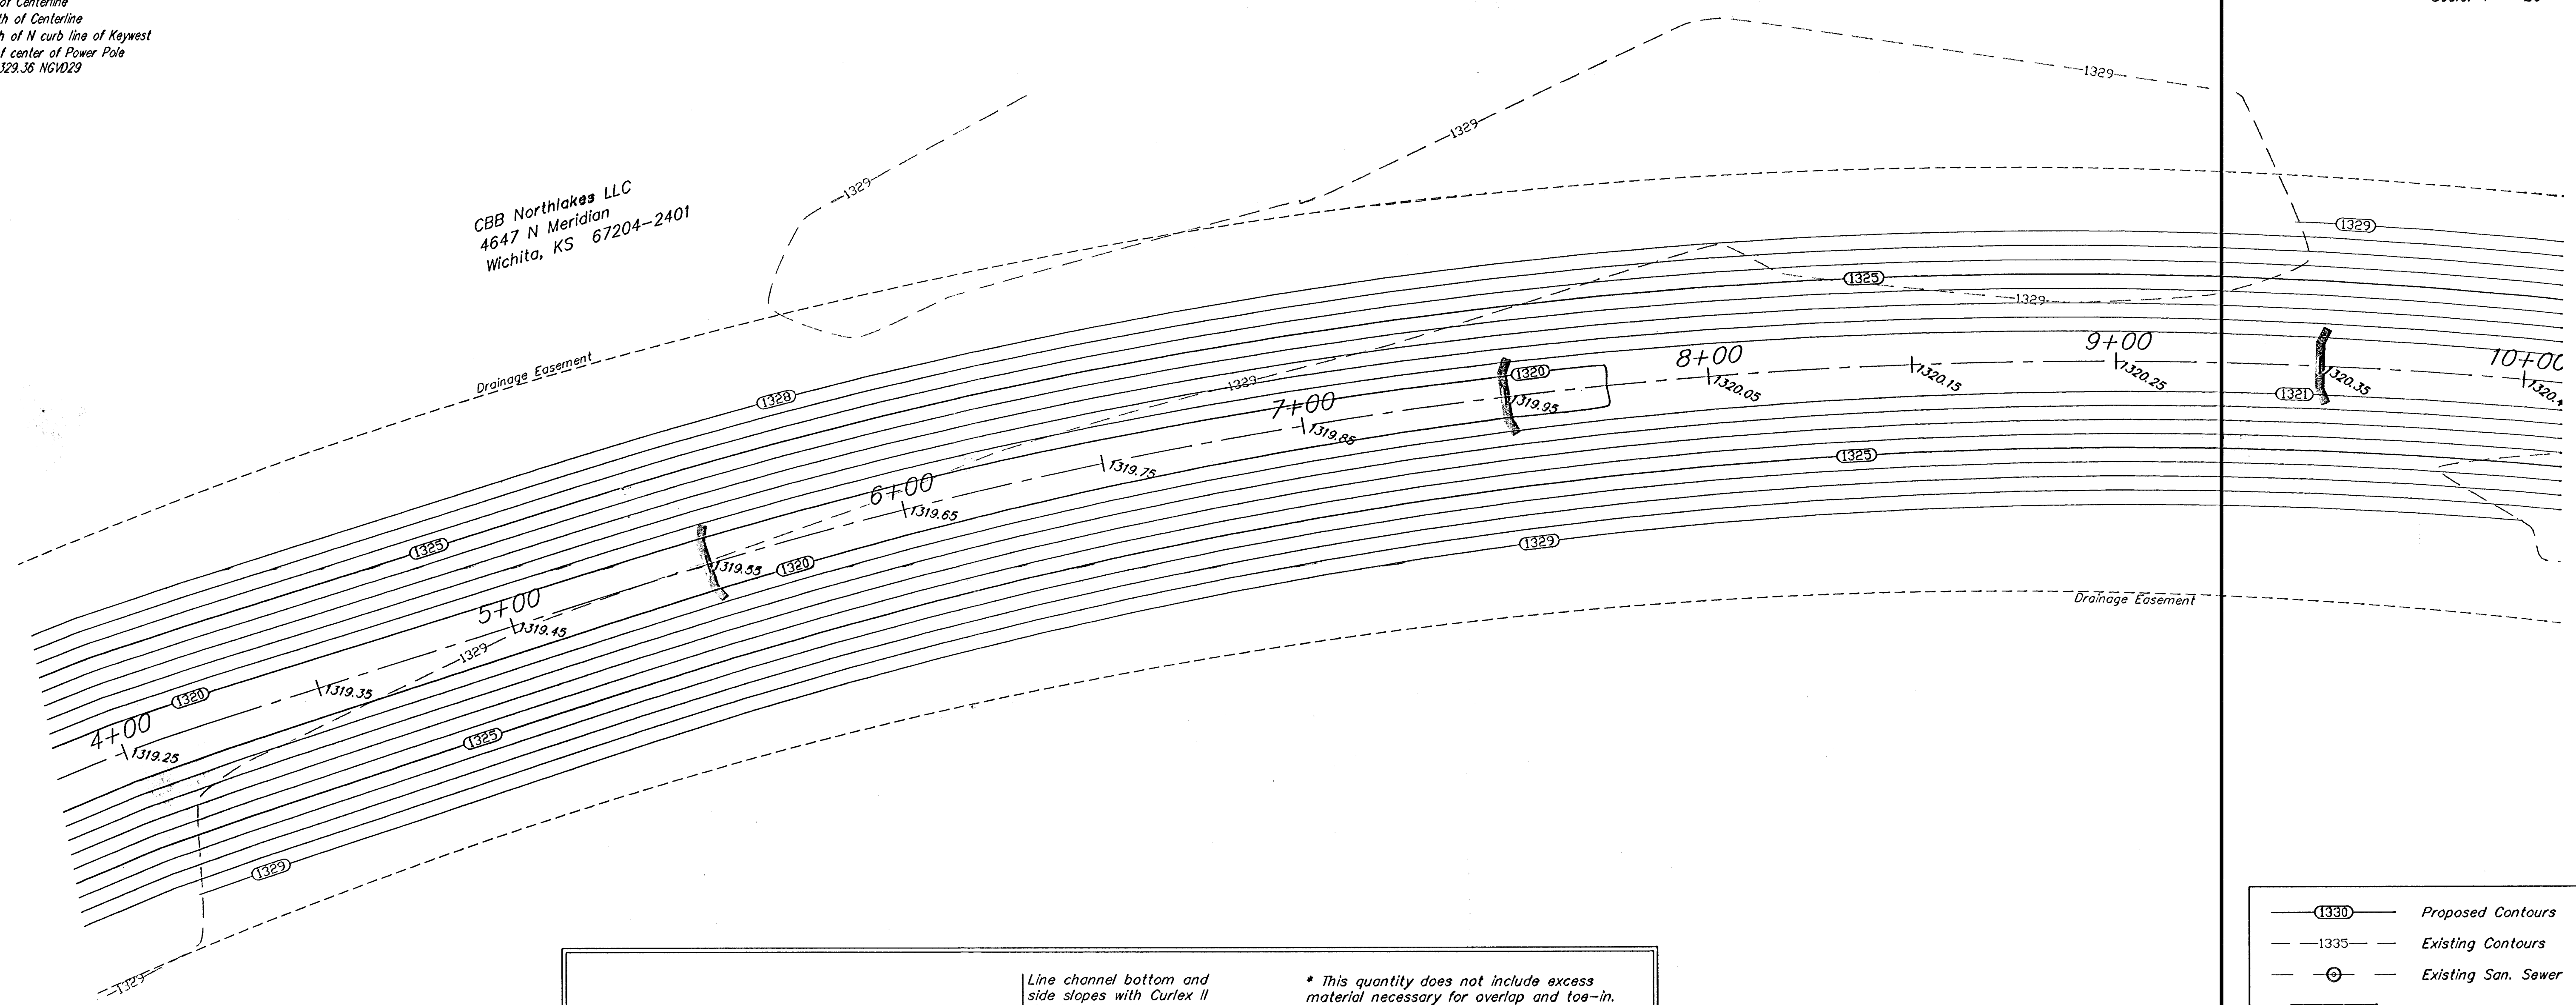

EROSION CONTROL MEASURE	UNITS	QUANTITY
INSTALL STRAW BALE BARRIER	EA	3
INSTALL EROSION CONTROL MATTING	SY	24,260

QUANTITIES ARE FOR INFORMATION ONLY!
CONTRACTOR SHALL VERIFY QUANTITIES PER FINAL BID QUANTITY SHEET.

- Proposed Contours
- Existing Contours
- Existing San. Sewer
- Rip Rap to be installed
- Straw Bale Barriers to be installed (This Project)
- Dewatering Well (Abandoned)

As Built 6/18/07 KR

Northgate Offsite Drainage
Channel Plan
Storm Water Drain #307

Baughman
Baughman Company, P.A. 315 Ellis St. Wichita, KS 67211 P 316-263-7271 F 316-262-0149
ENGINEERING | SURVEYING | PLANNING | LANDSCAPE ARCHITECTURE


PROJECT NUMBER 468-84233	DESIGN RDM/AEG	DRAWN RDM
REVISIONS:	APPROVED AEG	DATE 3-14-07
SCALE Noted		SHEET
		3 OF 22

Northgate\OFFSITE CHANNEL.dwg


COW Benchmark at the Intersection of Meridian and 53rd St N, NE Corner, Top of Concrete Headwall, 44' North of Centerline, 37' East of Centerline, 50.90' NE of Section Corner, 9' NE of and radial to curb, 26' East of Section Line, Elev. = 1331.37 NGVD29

COW Benchmark at the intersection of Meridian and Keywest, NW Corner, 59' West of Centerline, 32.3' North of Centerline, 11.8' North of N curb line of Keywest, 4.8' NW of center of Power Pole, Elev. = 1329.36 NGVD29

CBB Northlakes LLC
4647 N Meridian
Wichita, KS 67204-2401

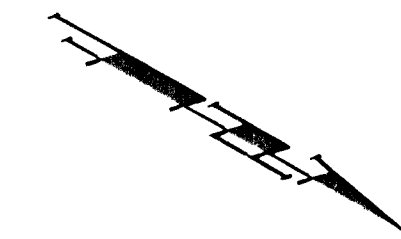

Scale: 1" = 20'

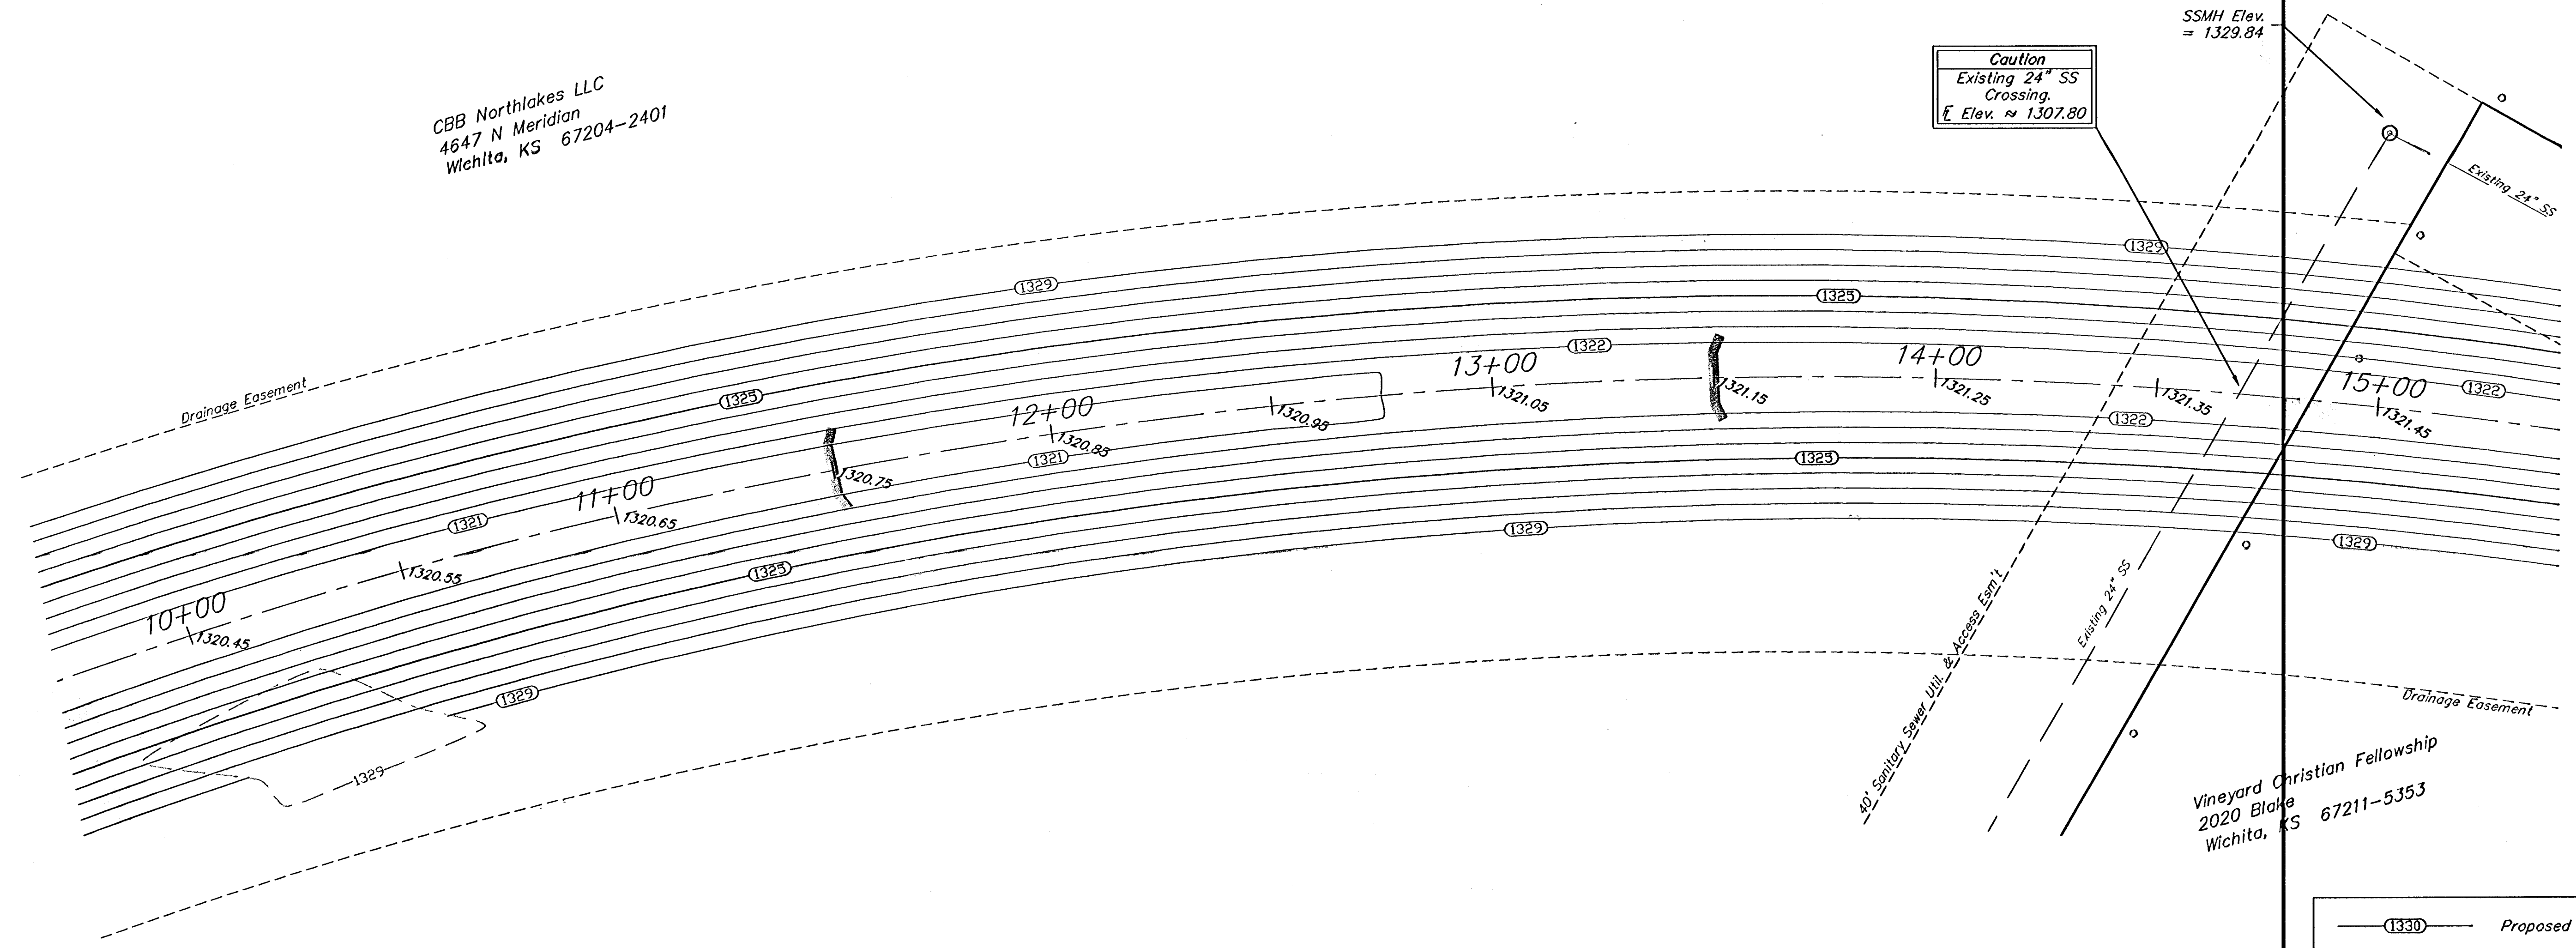

Vineyard Christian Fellowship
2020 Blake
Wichita, KS 67211-5353

	Proposed Contours
	Existing Contours
	Existing San. Sewer
	Rip Rap to be installed
	Straw Bale Barriers to be installed (This Project)
	Dewatering Well (Abandoned)

As Built 6/18/05 KX

EROSION CONTROL MEASURE	UNITS	QUANTITY
INSTALL STRAW BALE BARRIER	EA	2

QUANTITIES ARE FOR INFORMATION ONLY!
CONTRACTOR SHALL VERIFY QUANTITIES PER FINAL BID QUANTITY SHEET.


		Northgate Offsite Drainage Channel Plan Storm Water Drain #307	
<small>Baughman Company, P.A. 318 Elm St. Wichita, KS 67211 P 316-263-7711 F 316-263-0149 ENGINEERING SURVEYING PLANNING LANDSCAPE ARCHITECTURE</small>			
PROJECT NUMBER 468-04123	DESIGN RDM/AEG	DRAWN RDM	DATE 3-14-07
REVISIONS	APPROVED AEG	SCALE Noted	SHEET 4 OF 22
<small>Northgate\OFFSITE CHANNEL.dwg</small>			

COW Benchmark at the intersection of Meridian and 53rd St N, NE Corner, Top of Concrete Headwall, 44' North of Centerline, 37' East of Centerline, 50.90' NE of Section Corner, 9' NE of and radial to curb, 26' East of Section Line, Elev. = 1331.37 NGVD29

COW Benchmark at the intersection of Meridian and Keywest, NW Corner, 59' West of Centerline, 32.3' North of Centerline, 11.8' North of N curb line of Keywest, 4.8' NW of center of Power Pole, Elev. = 1329.36 NGVD29

Scale: 1" = 20'

CBB Northlakes LLC
4647 N Meridian
Wichita, KS 67204-2401

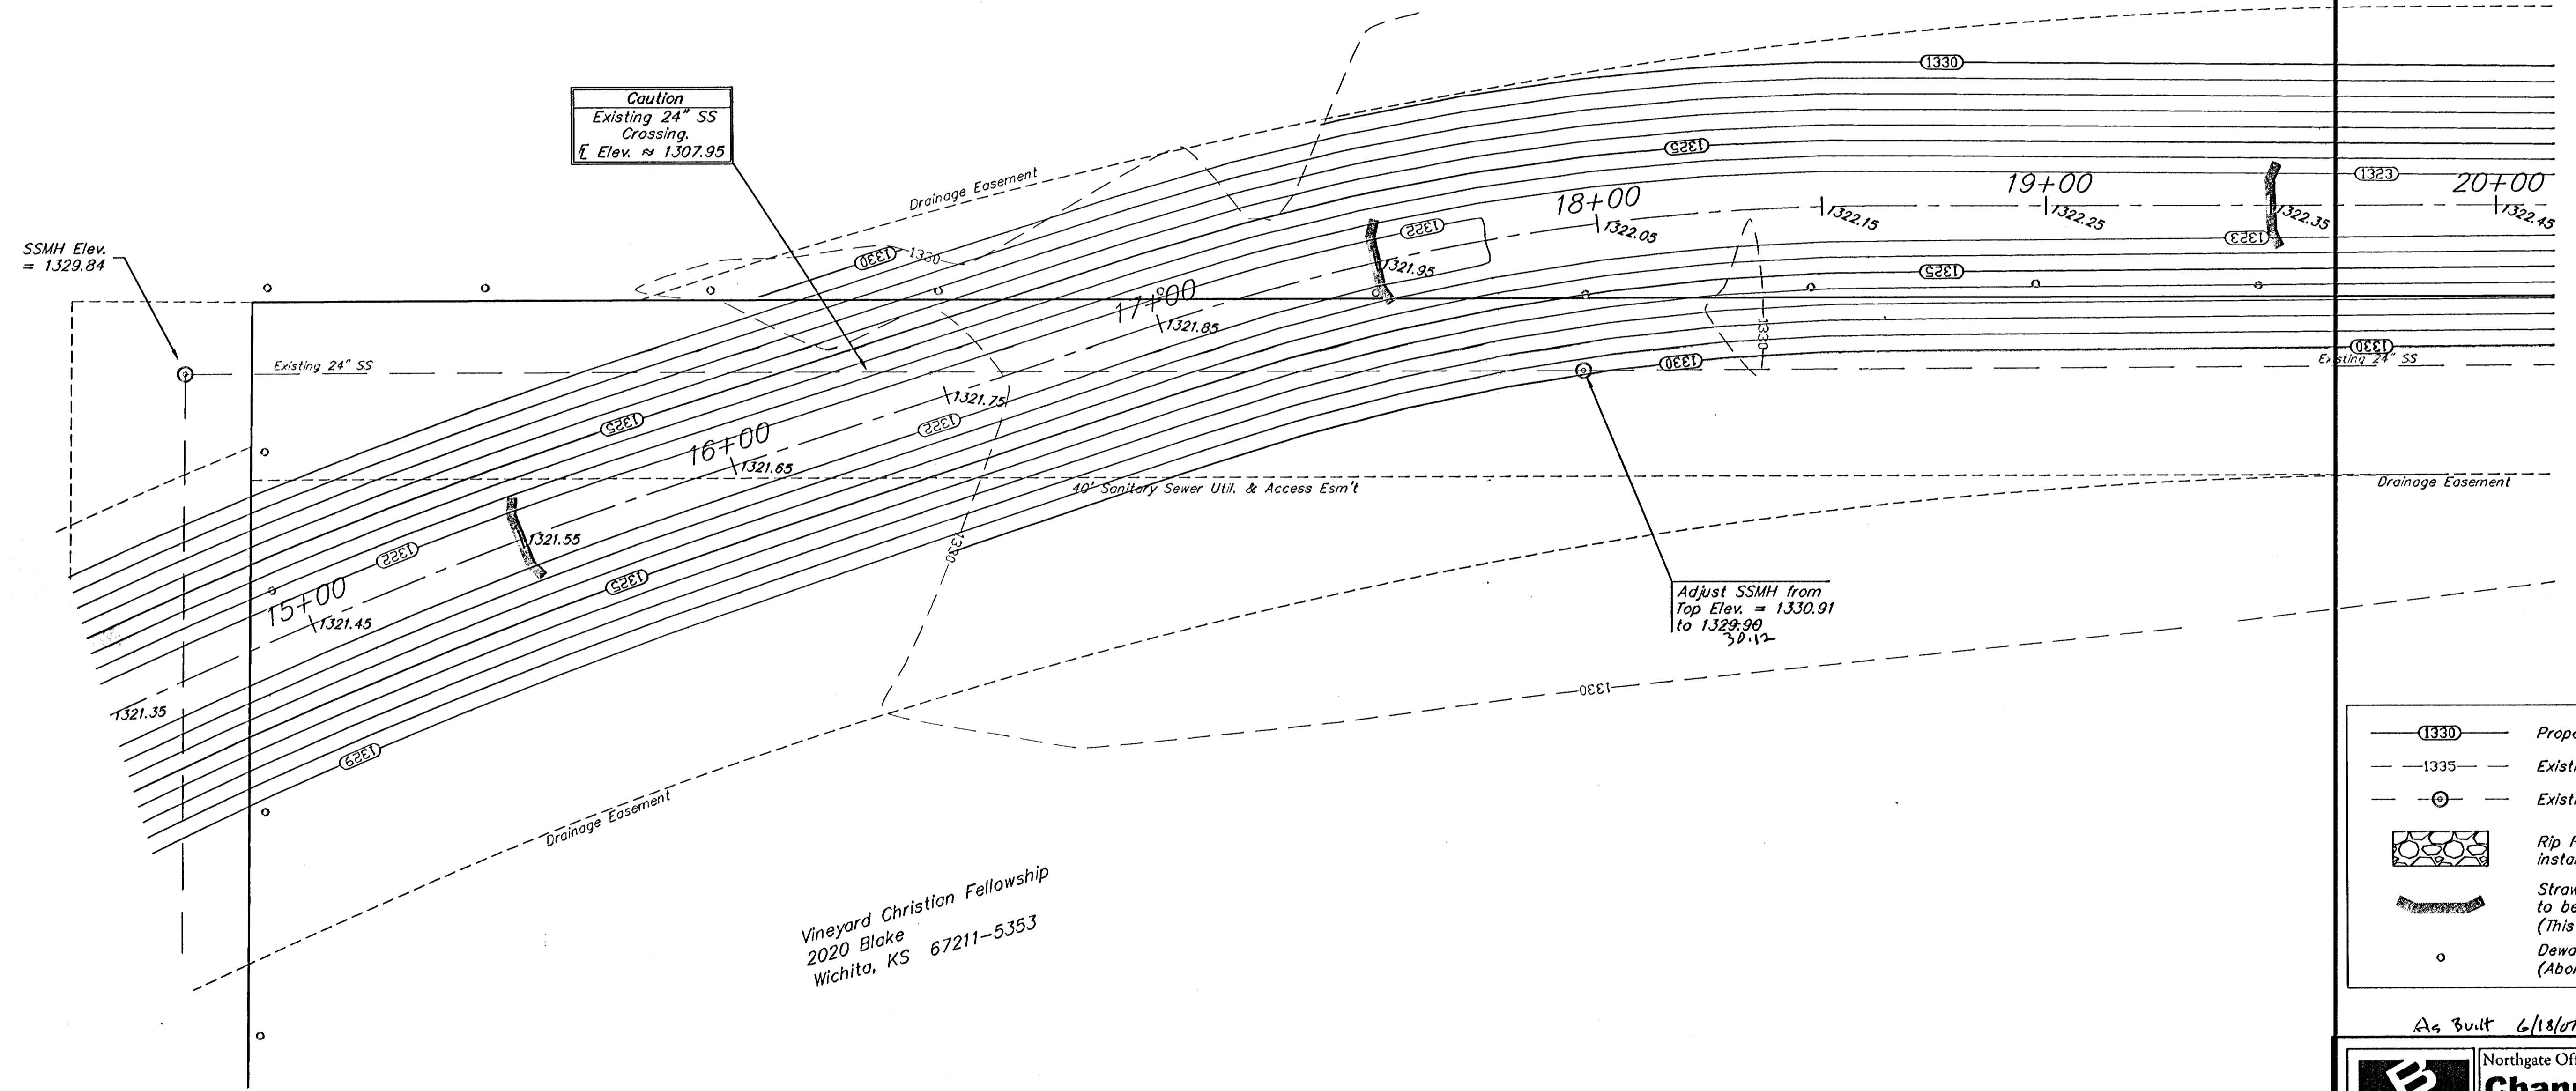

Caution
Existing 24" SS Crossing,
Elev. ≈ 1307.95

Adjust SSMH from
Top Elev. = 1330.91
to 1329.90
30.1%

Vineyard Christian Fellowship
2020 Blake
Wichita, KS 67211-5353

	Proposed Contours
	Existing Contours
	Existing San. Sewer
	Rip Rap to be installed
	Straw Bale Barriers to be installed (This Project)
	Dewatering Well (Abandoned)

As Built 6/18/07 KK

EROSION CONTROL MEASURE	UNITS	QUANTITY
INSTALL STRAW BALE BARRIER	EA	3

QUANTITIES ARE FOR INFORMATION ONLY!
CONTRACTOR SHALL VERIFY QUANTITIES PER FINAL BID QUANTITY SHEET.

Northgate Offsite Drainage
Channel Plan
Storm Water Drain #307

Baughman Company, P.A. 315 Ellis St. Wichita, KS 67211 P 316-263-7711 F 316-263-0149
ENGINEERING | SURVEYING | PLANNING | LANDSCAPE ARCHITECTURE

PROJECT NUMBER 468-24253	DESIGN RDM/AEG	DRAWN RDM
REVISIONS	APPROVED AEG	DATE 3-14-07
SCALE Noted		SHEET
		5 OF 22

Northgate\OFFSITE CHANNEL.dwg

COW Benchmark at the Intersection of Meridian and 53rd St N, NE Corner, Top of Concrete Headwall, 44' North of Centerline, 37' East of Centerline, 50.90' NE of Section Corner, 9' NE of and radial to curb, 26' East of Section Line, Elev. = 1331.37 NGVD29

COW Benchmark at the intersection of Meridian and Keywest, NW Corner, 59' West of Centerline, 32.3' North of Centerline, 11.8' North of N curb line of Keywest, 4.8' NW of center of Power Pole, Elev. = 1329.35 NGVD29


CBB Northlakes LLC
4647 N Meridian
Wichita, KS 67204-2401

Regrade Area to drain to Rip-Rap



Armor Flox
Install 70 S.Y. Heavy-Stone Rip-rap on side slope of channel as shown. See detail this sheet.

Scale: 1" = 20'

Remove Trees only as necessary for channel construction. All trees not in direct conflict with proposed channel shall remain and shall be protected from damage. Any trees that need trimmed shall be side trimmed with a chainsaw.

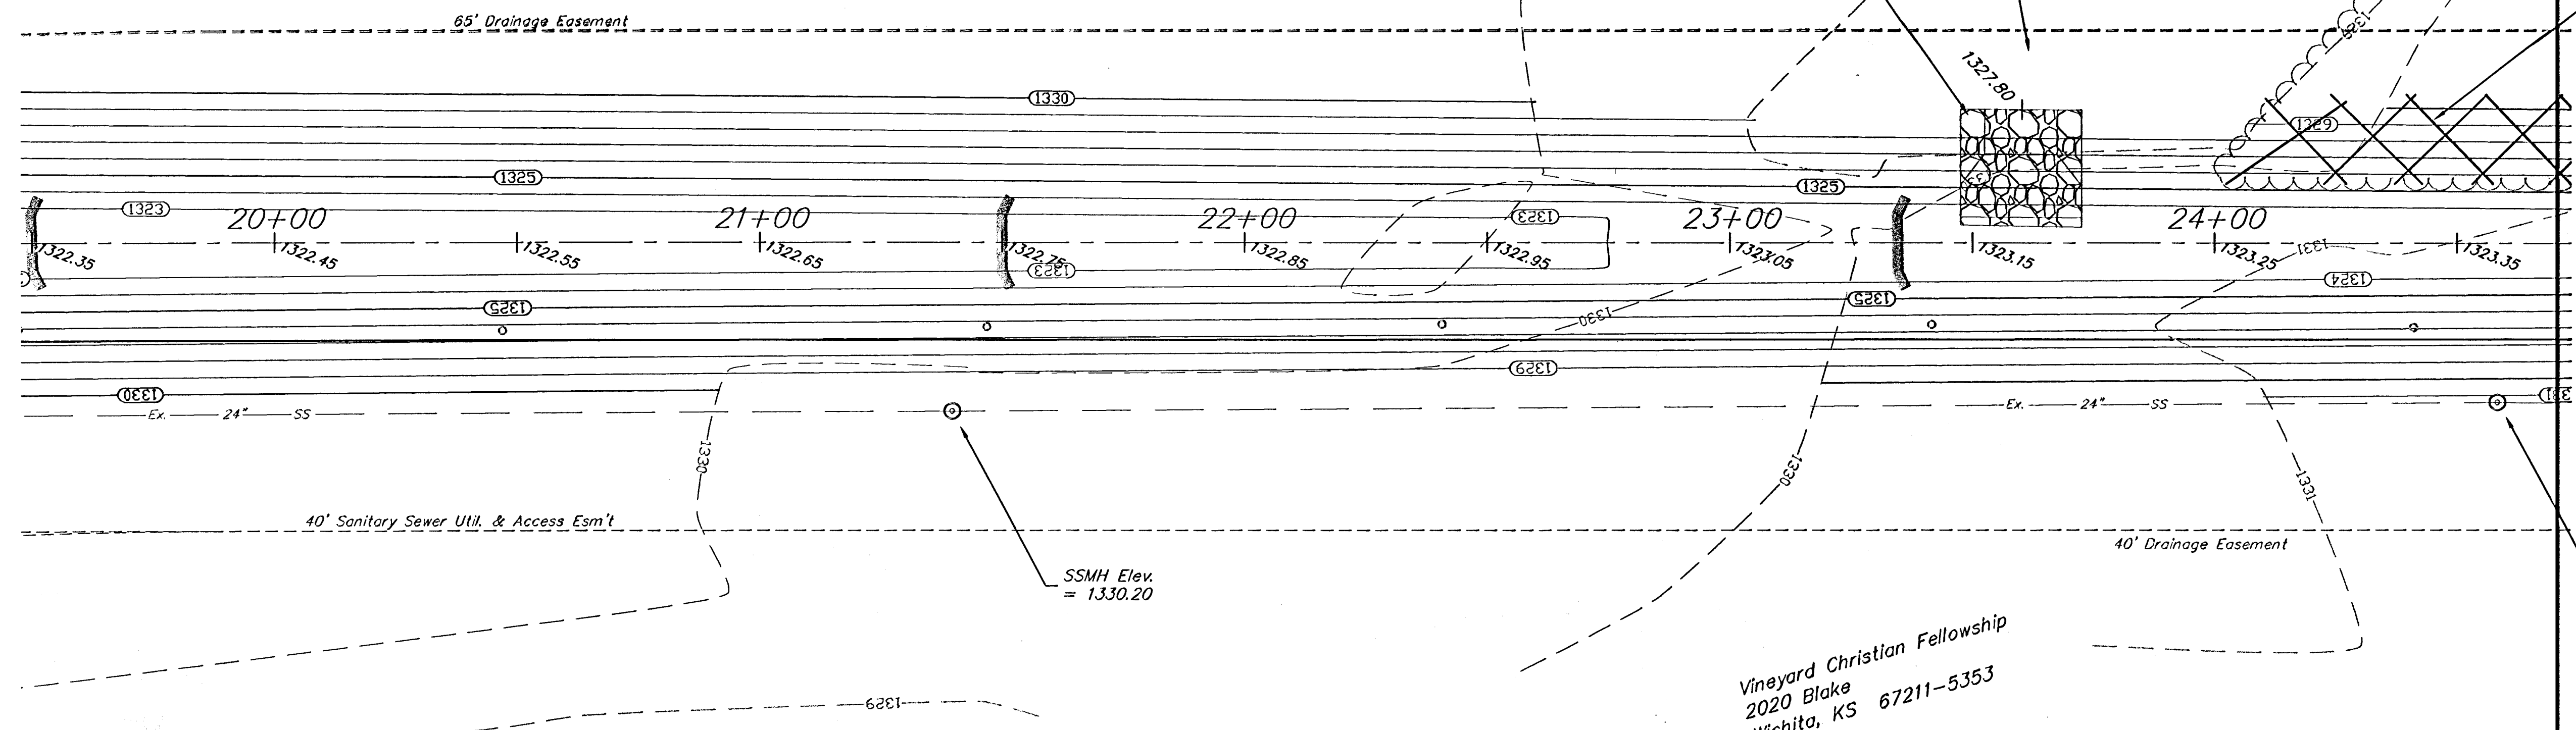

Vineyard Christian Fellowship
2020 Blake
Wichita, KS 67211-5353

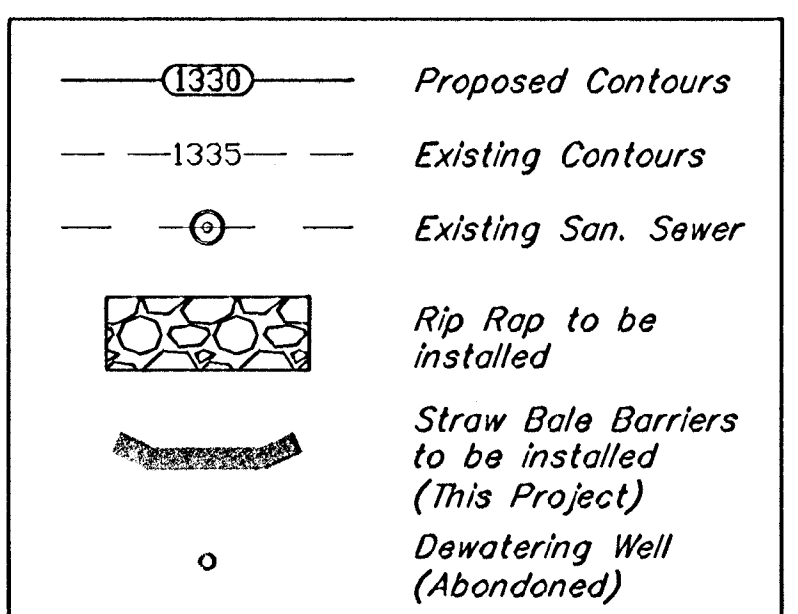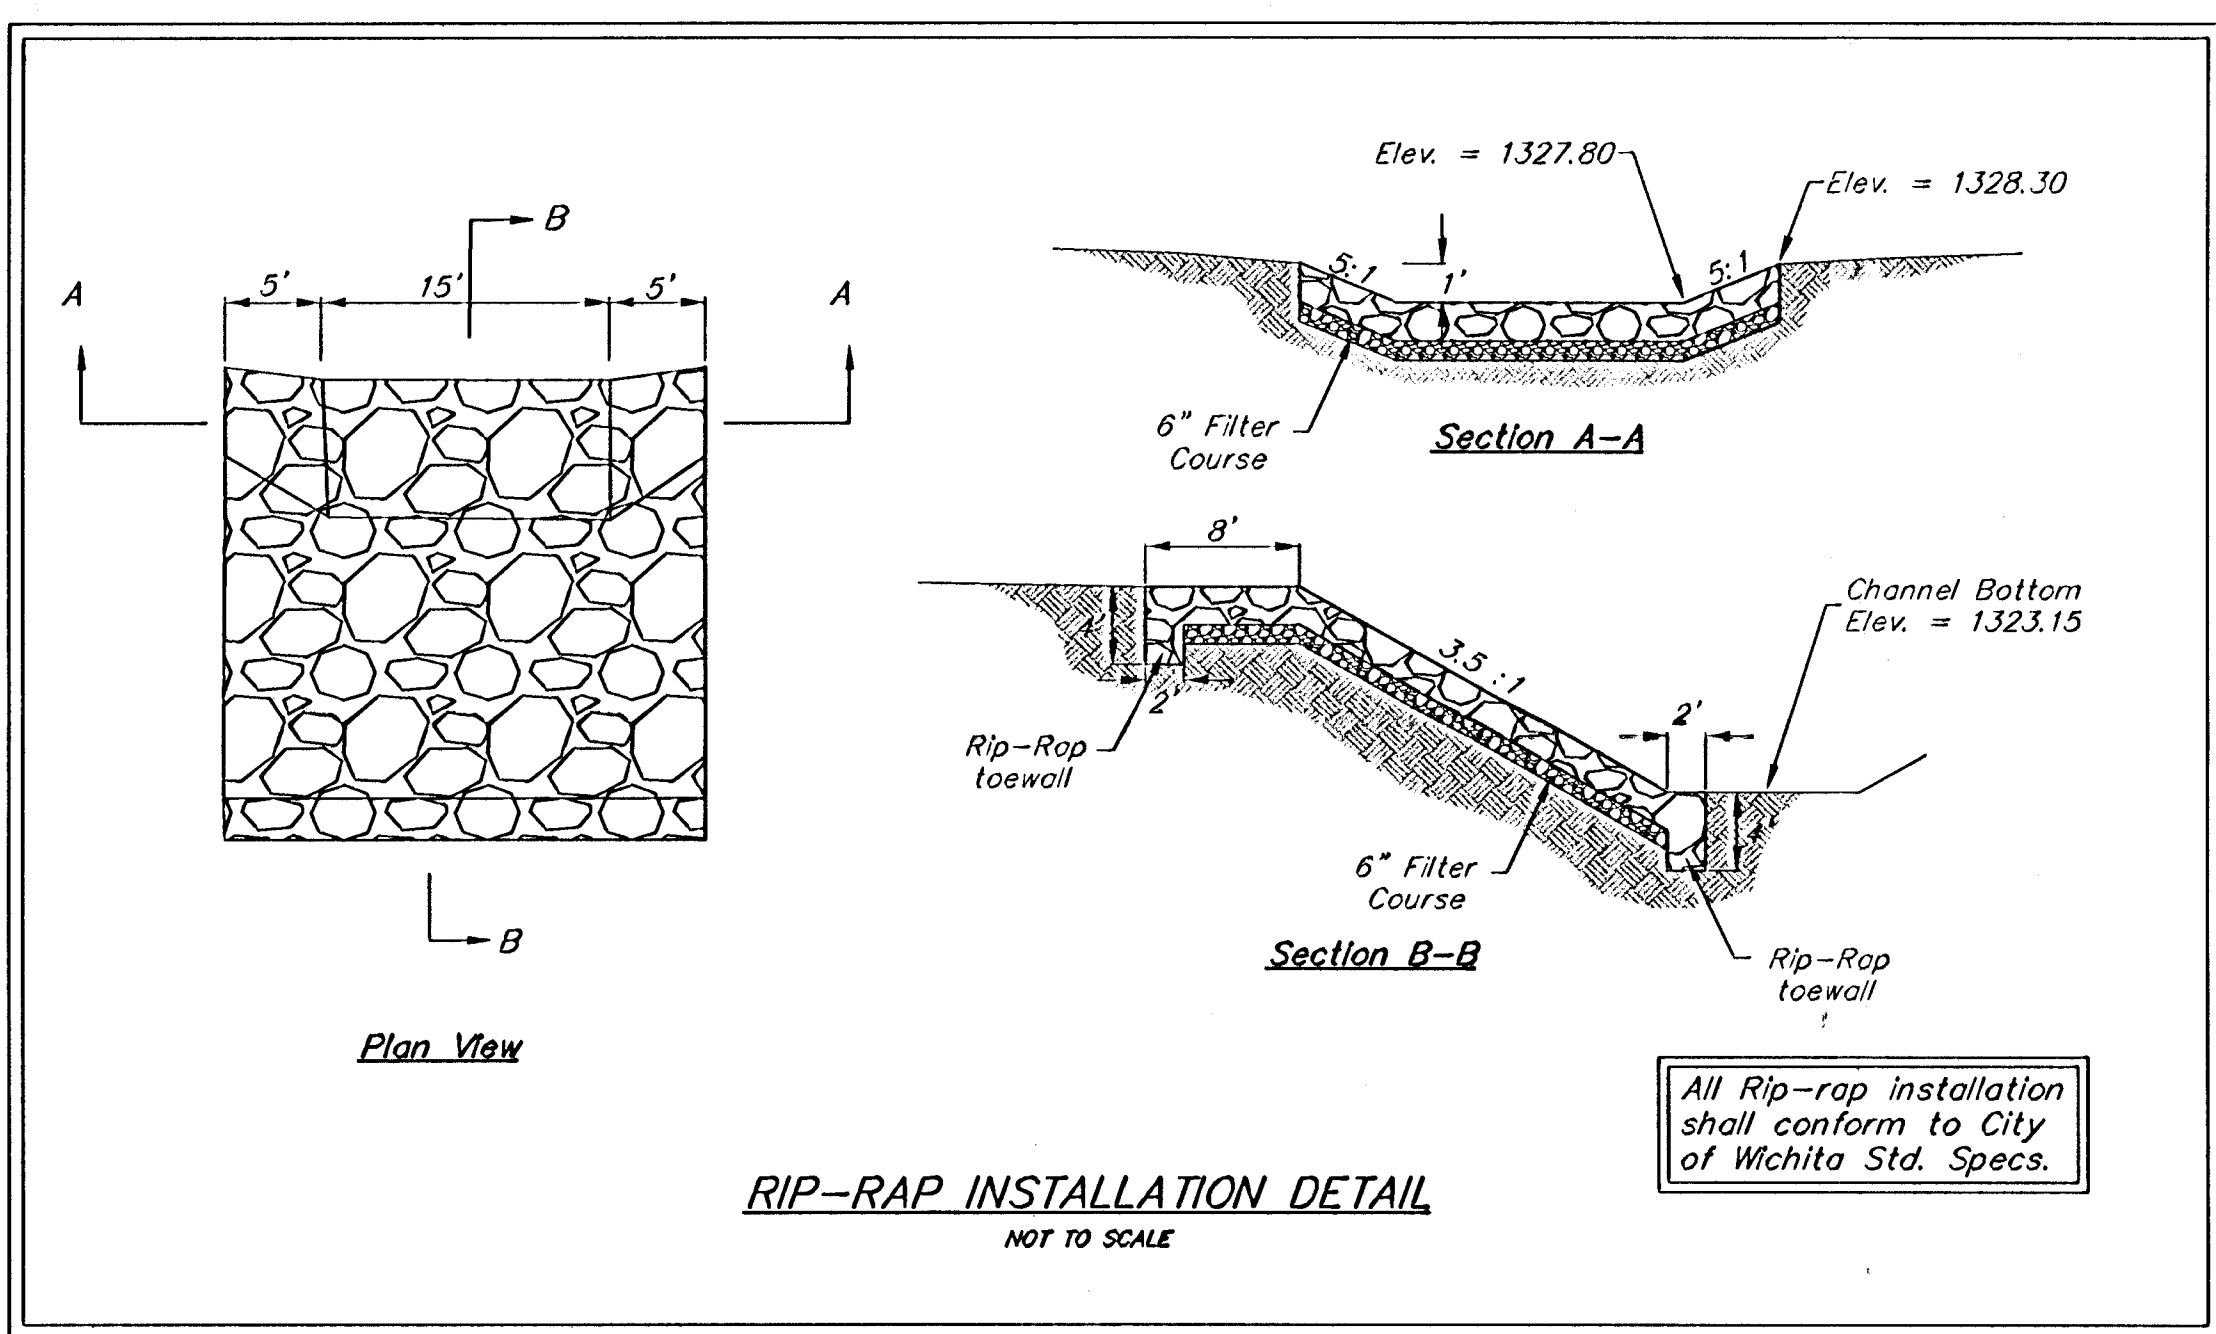

EROSION CONTROL MEASURE	UNITS	QUANTITY
INSTALL STRAW BALE BARRIER	EA	2
INSTALL HEAVY-STONE RIP RAP	SY	70

QUANTITIES ARE FOR INFORMATION ONLY!
CONTRACTOR SHALL VERIFY QUANTITIES PER FINAL BID QUANTITY SHEET.

As Built 6/19/07 K.E.

Notthgate Offsite Drainage
Channel Plan
Storm Water Drain #307

Baughman Engineering & Surveying, P.A. 115 1/2 St. William, KS 67211 P 316-262-7711 F 316-262-6149
ENGINEERING | SURVEYING | PLANNING | LANDSCAPE ARCHITECTURE

PROJECT NUMBER 468-84253	DESIGN RDM/AEG	DRAWN RDM
REVISIONS	APPROVED AEG	DATE 3-14-07
SCALE Noted		SHEET 6 OF 22

Notthgate\OFFSITE CHANNEL.dwg

COW Benchmark at the Intersection of Meridian and 53rd St N, NE Corner, Top of Concrete Headwall, 44' North of Centerline, 37' East of Centerline, 50.90' NE of Section Corner, 9' NE of and radial to curb, 26' East of Section Line, Elev. = 1331.37 NGVD29

COW Benchmark at the intersection of Meridian and Keywest, NW Corner, 59' West of Centerline, 32.3' North of Centerline, 11.8' North of N curb line of Keywest, 4.8' NW of center of Power Pole, Elev. = 1329.36 NGVD29

Scale: 1" = 20'

Remove Trees only as necessary for channel construction. All trees not in direct conflict with proposed channel shall remain and shall be protected from damage. Any trees that need trimmed shall be side trimmed with a chainsaw.

CBB Northlakes LLC
4647 N Meridian
Wichita, KS 67204-2401

Contractor shall reconstruct ditches after construction of RCBC and shall re-establish preconstruction ditch grades (Both Sides). Reconstructed ditches shall be lined with Curlex II Erosion Control Matting (Approx. 270 S.Y.).

Elev. of Proposed RCBC = 1324.31

Elev. of Proposed RCBC = 1324.00

65' Drainage Easement

R & R Realty LLC
Bldg 1000
1100 E 22nd St N
Wichita, KS 67226-2310

4+00

25+00

26+00

27+00

SSMH Elev. = 1331.95

40' Sanitary Sewer Util. & Access Esm't

SSMH Elev. = 1331.63

40' Drainage Easement







Vineyard Christian Fellowship
2020 Blake
Wichita, KS 67211-5353

Caution
Existing 24" SS
Crossing,
Elev. ≈ 1308.85

Contractor shall Construct and Maintain one Construction Entrance onto Existing Paved Roadway (53rd St. N). Temporary 15" Pipe shall be installed in ditch. Cost of Pipe shall be incidental to Bid Item "Construction Entrance Installed"

EROSION CONTROL MEASURE	UNITS	QUANTITY
INSTALL STRAW BALE BARRIER	EA	2
INSTALL EROSION CONTROL MATTING	SY	270

QUANTITIES ARE FOR INFORMATION ONLY!
CONTRACTOR SHALL VERIFY QUANTITIES PER FINAL BID QUANTITY SHEET.

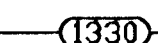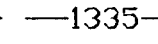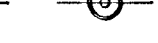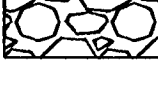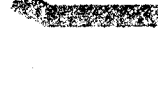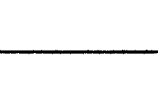-  Proposed Contours
-  Existing Contours
-  Existing San. Sewer
-  Rip Rap to be installed
-  Straw Bale Barriers to be installed (This Project)
-  Dewatering Well (Abandoned)

As Built 5/18/07

Notgate Offsite Drainage
Channel Plan
Storm Water Drain #307

Baughman Company, P.A. 315 Ellis St. Wichita, KS 67211 P:3162633711 F:3162620149
ENGINEERING | SURVEYING | PLANNING | LANDSCAPE ARCHITECTURE

PROJECT NUMBER
468-84253

DESIGN
RDM/AEG

APPROVED
AEG

SCALE
Noted

SHEET

DRAWN
RDM

DATE
3-14-07

3-14-07

7 OF 22

Northgate\OFFSITE CHANNEL.dwg

COV Benchmark at the Intersection of Meridian and 53rd St N, NE Corner, Top of Concrete Headwall, 44' North of Centerline, 37' East of Centerline, 50.90' NE of Section Corner, 9' NE of and radial to curb, 26' East of Section Line, Elev. = 1331.37 NG1029

COV Benchmark at the intersection of Meridian and Keywest, NW Corner, 59' West of Centerline, 32.3' North of Centerline, 11.8' North of N curb line of Keywest, 4.8' NW of center of Power Pole, Elev. = 1329.35 NG1029

Vineyard Christian Fellowship
2020 Blake
Wichita, KS 67211-5353

CBB Northlakes LLC
4647 N Meridian
Wichita, KS 67204-2401

R & R Realty LLC
Bldg 1000
8100 E 22nd St N
Wichita, KS 67226-2310

Scale: 1" = 20' Horizontal
1" = 5' Vertical



Note: Existing AT&T Lines have been adjusted and encased prior to construction. Special care shall be given to reconstruct ditch backslope to provide plenty of cover for AT&T Lines. Contractor shall coordinate RCBC construction around existing AT&T lines with Jason Edwards 268-2759.

Sta 0+00, Line 1. Begin Construction of 2-8'x4' Precast RCBC with Cast-in-place R.C. Headwall and Flared Wingwalls, the cost of which shall be included in the cost of RCBC. See details, sheets 9-12. Install 220 S.Y. Heavy-Stone Rip-rap. Install hand rail along Hubguard per detail, sheet 15.

Install 41 L.F. Flowable Fill per Sedgwick County Specifications. See Backfill/Street Replacement Detail, this sheet. Extend Flowable Fill 2' beyond edge of pavement, both sides.

Saw-cut, remove and replace A.C. Pavement as necessary for construction of RCBC. All costs associated with Removal and Replacement of A.C. Pavement and Replacement of Permanent Striping shall be included in "Site Clearing & Restoration"

Sta 1+83.8, Line 1. End construction of 2-8'x4' RCBC. Grade around end of RCBC as shown. Install 35 S.Y. Heavy-stone Rip-rap. Cost of excavation and grading in this area to be included in the cost of RCBC.

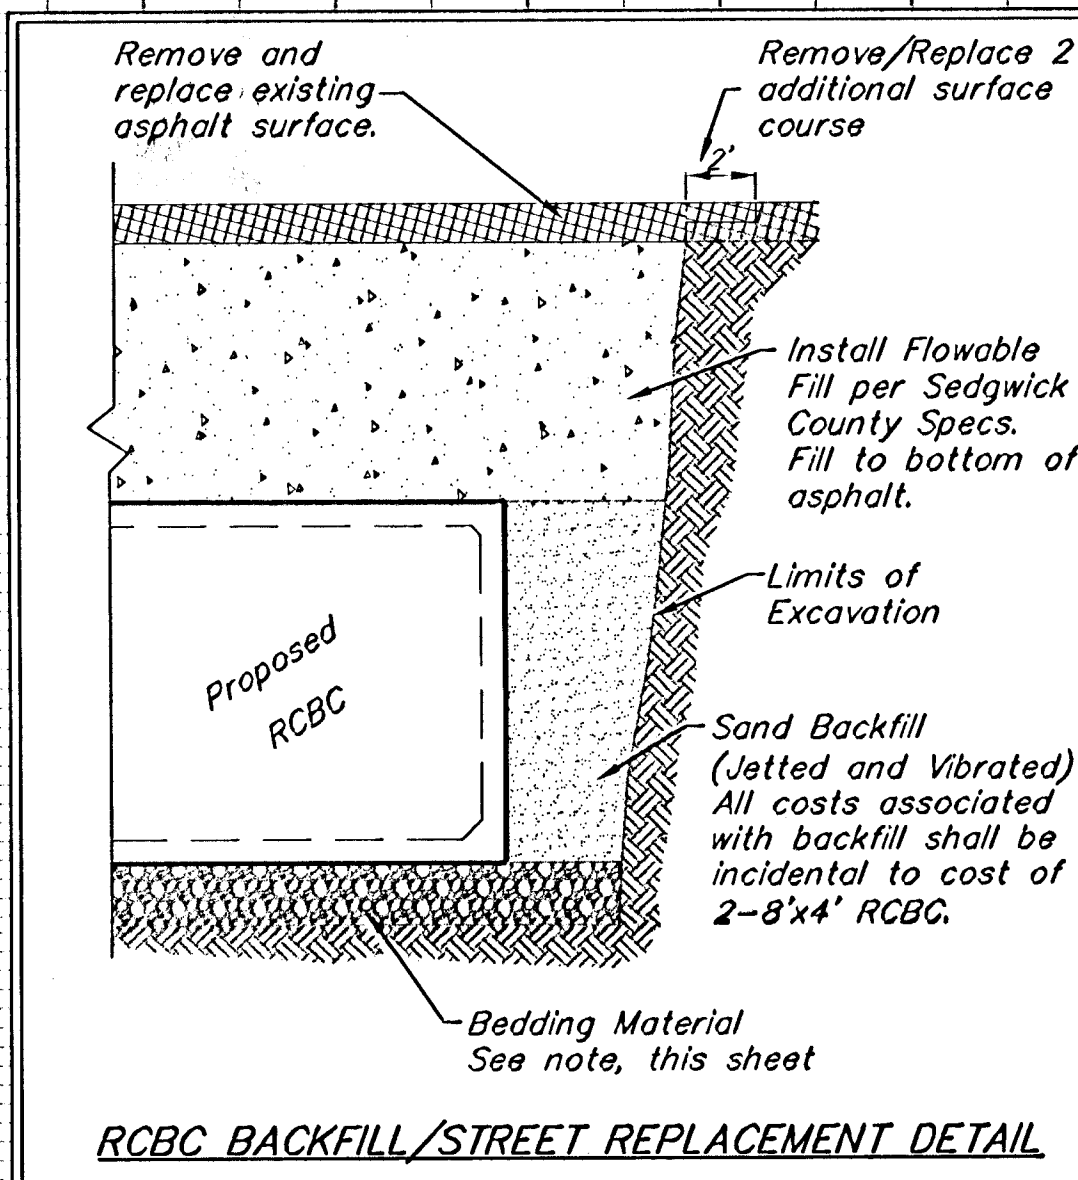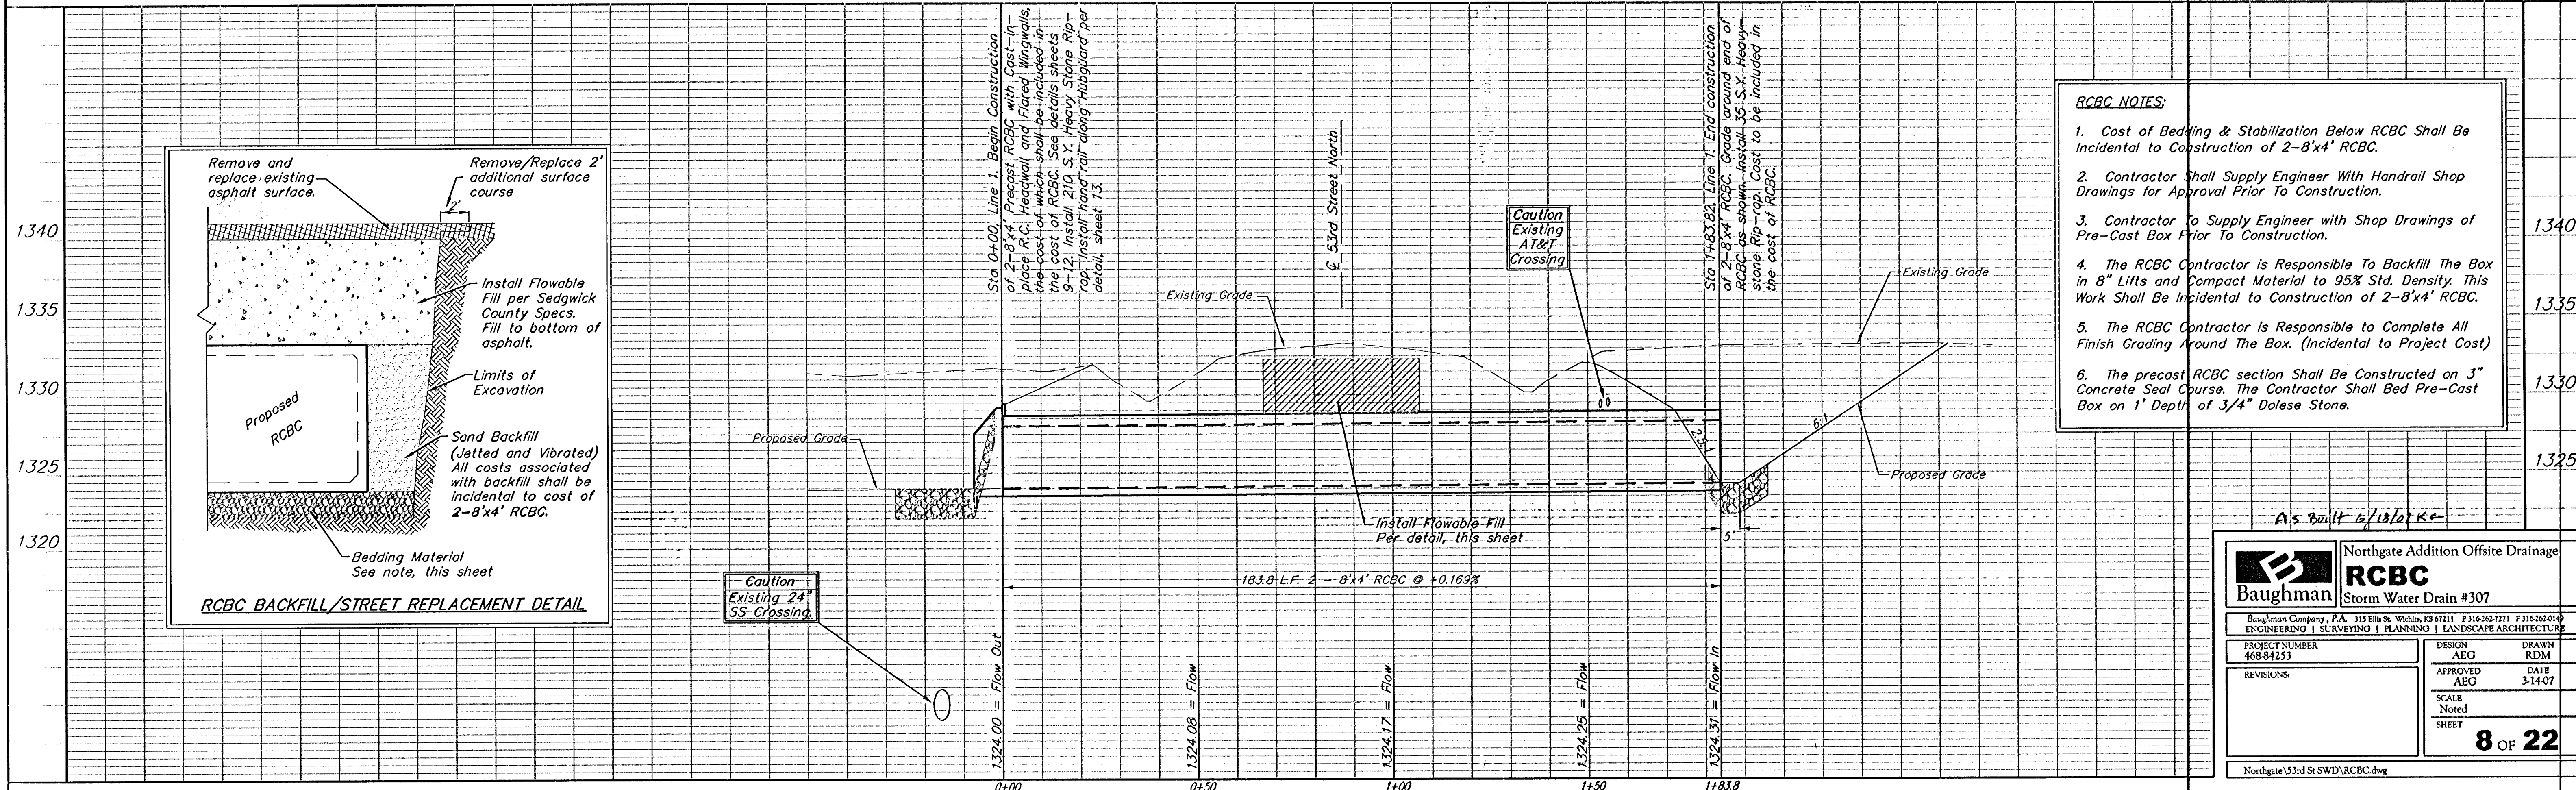

- RCBC NOTES:**
1. Cost of Bedding & Stabilization Below RCBC Shall Be Incidental to Construction of 2-8'x4' RCBC.
 2. Contractor Shall Supply Engineer With Handrail Shop Drawings for Approval Prior To Construction.
 3. Contractor To Supply Engineer with Shop Drawings of Pre-Cast Box Prior To Construction.
 4. The RCBC Contractor is Responsible To Backfill The Box in 8" Lifts and Compact Material to 95% Std. Density. This Work Shall Be Incidental to Construction of 2-8'x4' RCBC.
 5. The RCBC Contractor is Responsible to Complete All Finish Grading Around The Box. (Incidental to Project Cost)
 6. The precast RCBC section Shall Be Constructed on 3" Concrete Seal Course. The Contractor Shall Bed Pre-Cast Box on 1' Depth of 3/4" Dolese Stone.

AS BUILT 6/18/04

Baughman Northgate Addition Offsite Drainage
RCBC Storm Water Drain #307

Baughman Company, P.A. 315 8th St. Wichita, KS 67211 F 3162637271 F 3162637049
ENGINEERING | SURVEYING | PLANNING | LANDSCAPE ARCHITECTURE




PROJECT NUMBER 468-0423	DESIGN AEG	DRAWN RDM
REVISIONS:	APPROVED AEG	DATE 3-14-07
SCALE Noted		SHEET 8 OF 22

Northgate 53rd St SWD/RCBC.dwg

RCBC Construction Phase 1

R & R Realty LLC
Bldg. 1000
8100 E 22nd St N
Wichita, KS 67226-2310

CBB Northlakes LLC
4647 N Meridian
Wichita, KS 67204-2401

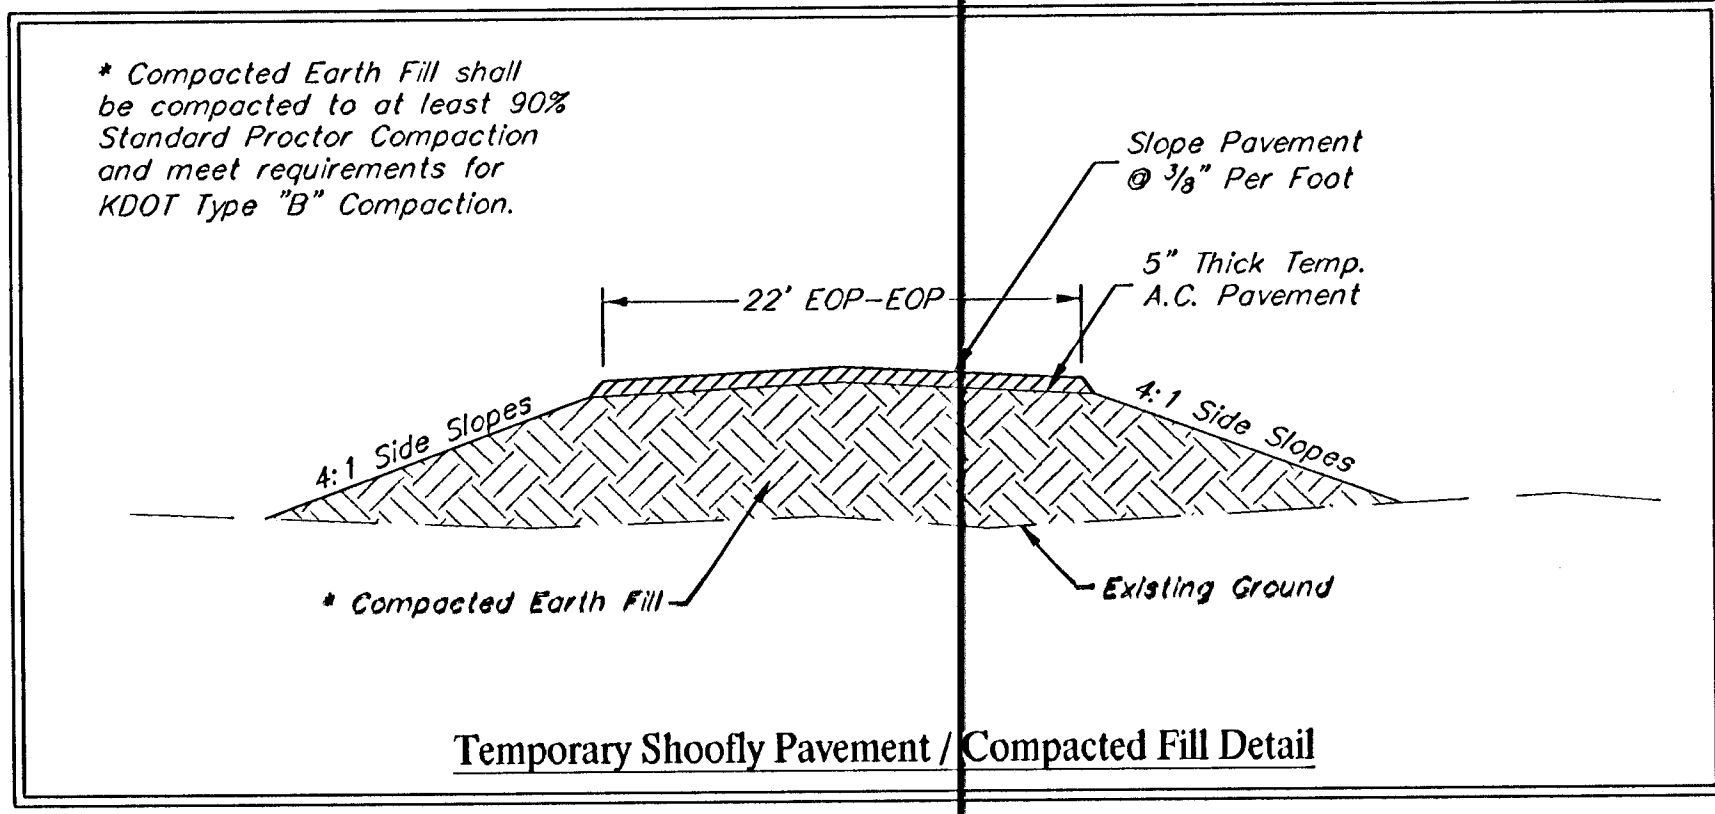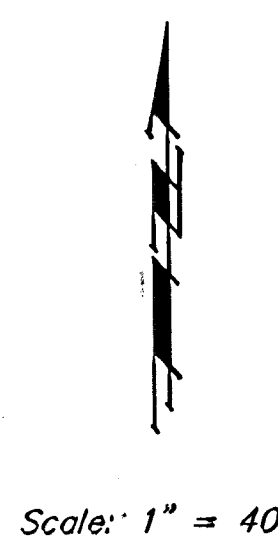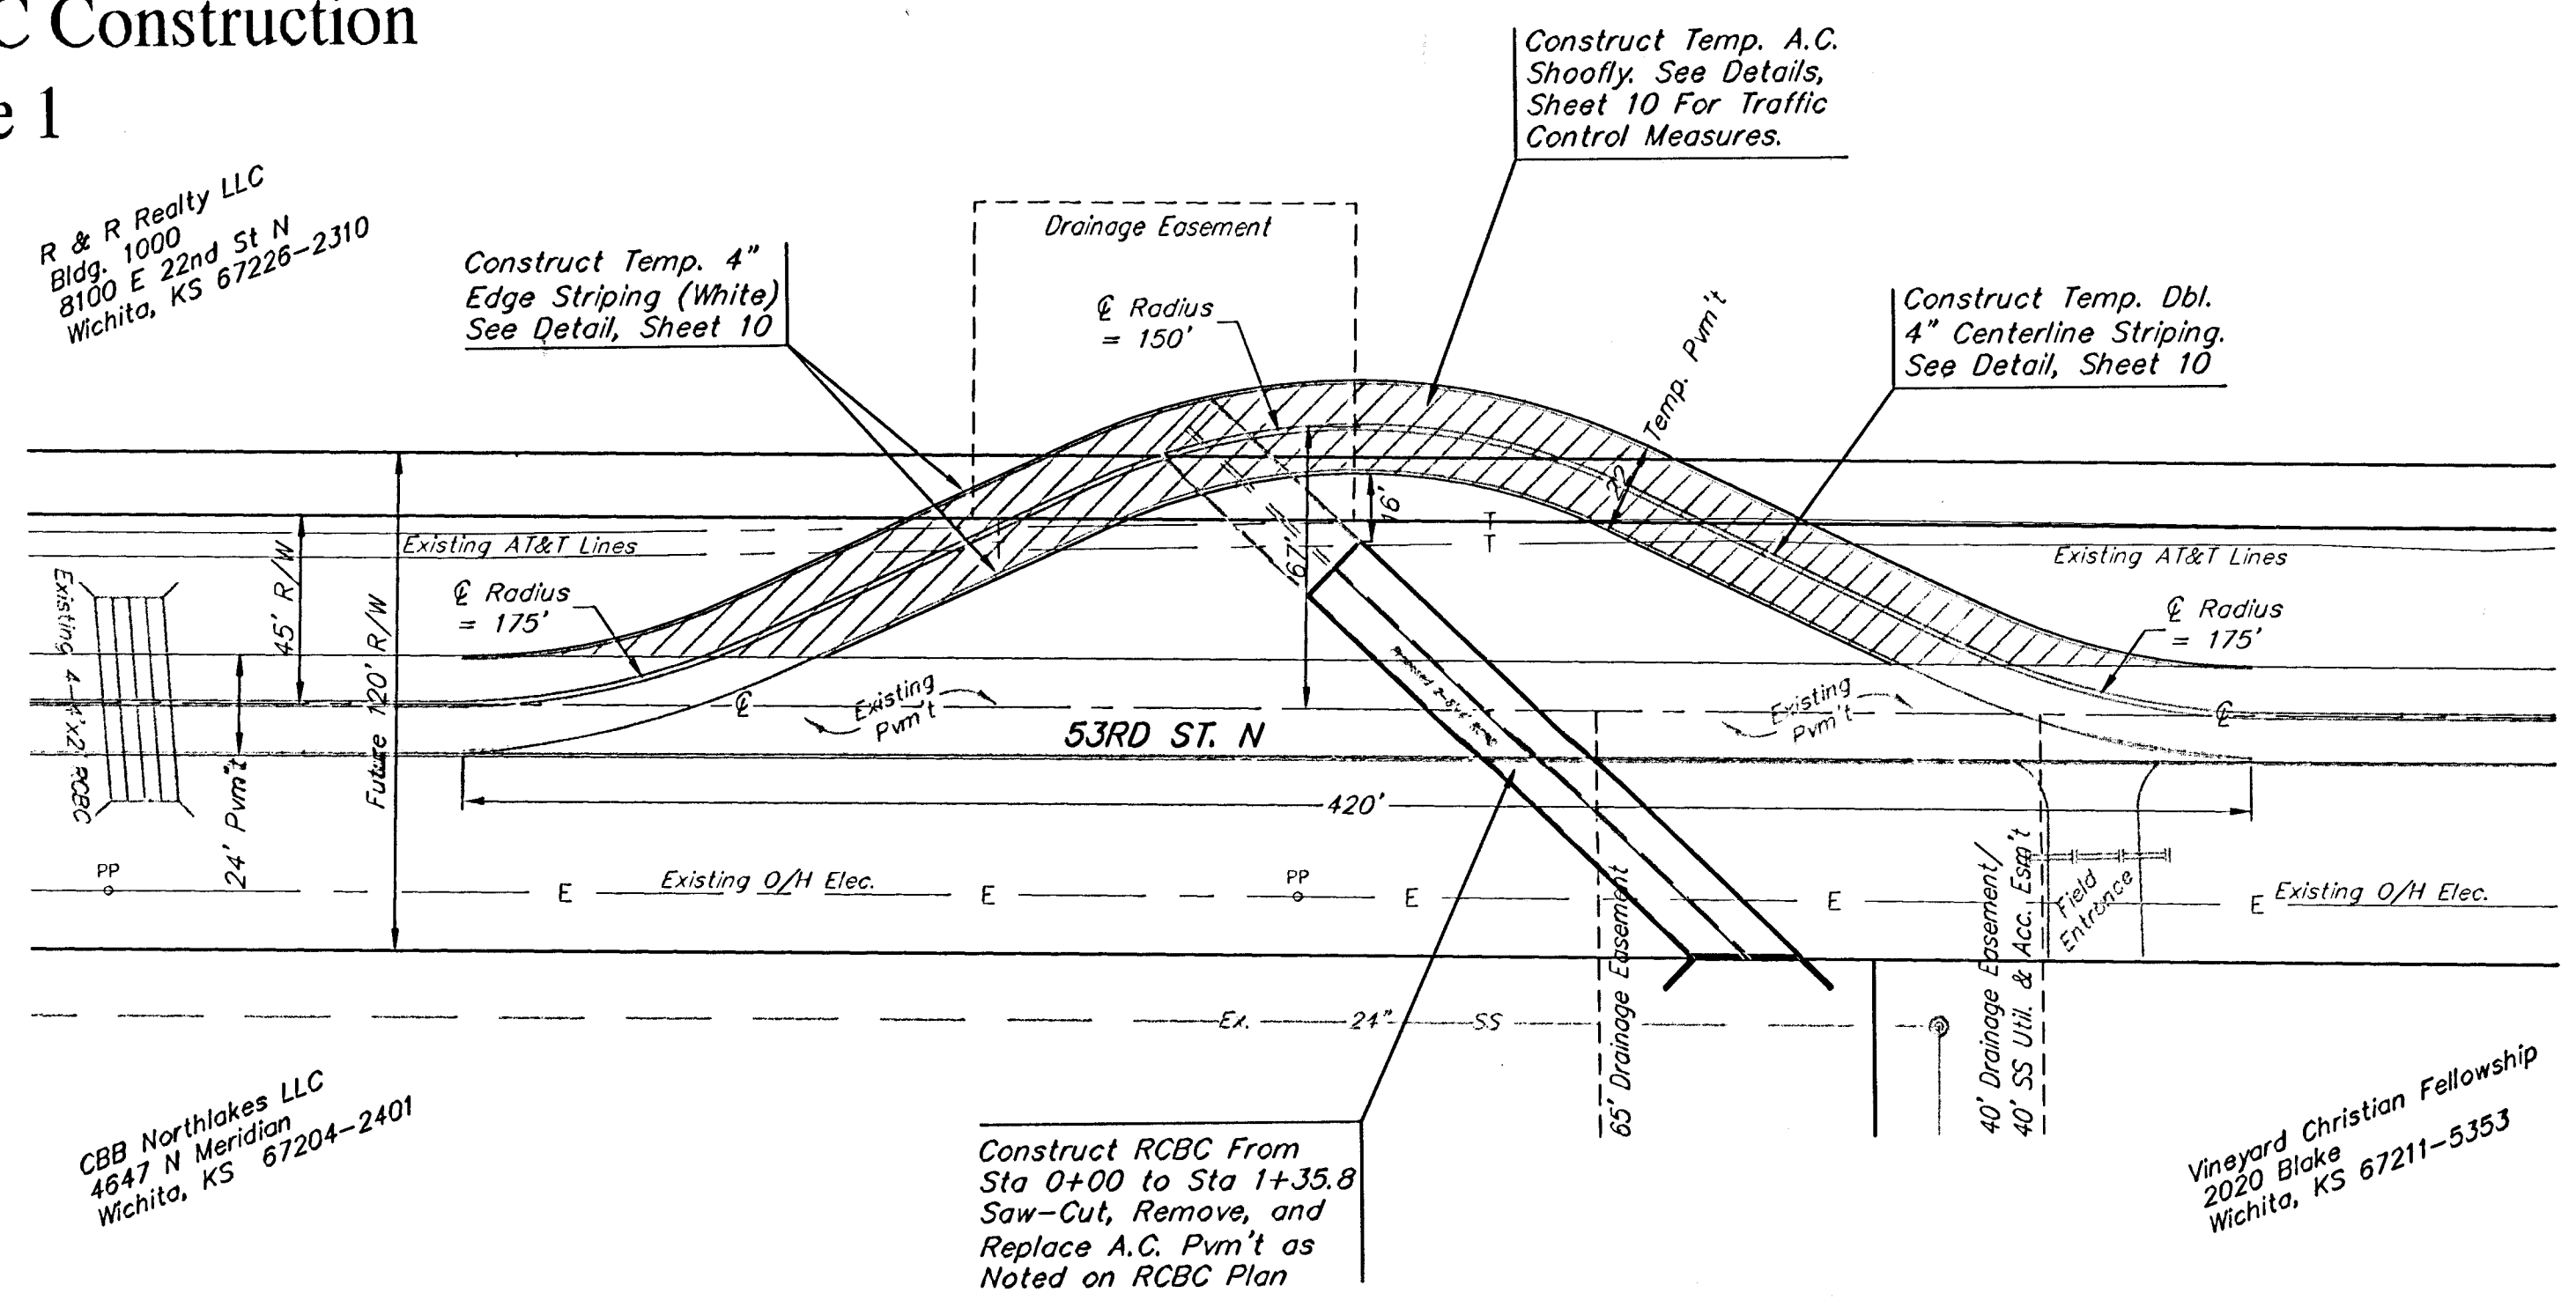

NOTES:

- All cost associated with Construction and Removal of Temporary A.C. Shoofly shall be included in the lump sum bid item "Temporary Shoofly." This includes, but is not limited to the construction and removal of: Compacted Earth Fill, Temporary A.C. Pavement, Temporary Pavement Striping.
- Contractor shall maintain the condition of temporary pavement and temporary striping until it is no longer needed.



QUANTITIES FOR TEMPORARY SHOOFLY (FOR INFORMATION ONLY)

ITEM	UNITS	QUANTITY
5" A.C. PAVEMENT	S.Y.	820
4" CENTERLINE STRIPING (YELLOW)	L.F.	1,500
4" EDGE LINE STRIPING (WHITE)	L.F.	900

RCBC Construction Phase 2

R & R Realty LLC
Bldg. 1000
8100 E 22nd St N
Wichita, KS 67226-2310

CBB Northlakes LLC
4647 N Meridian
Wichita, KS 67204-2401

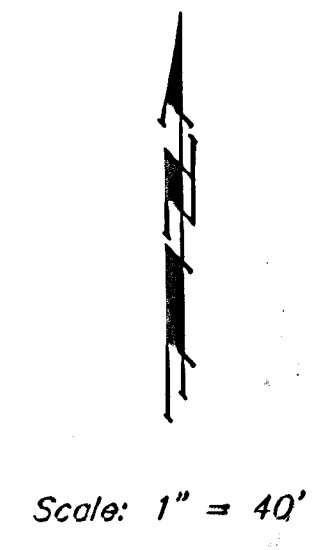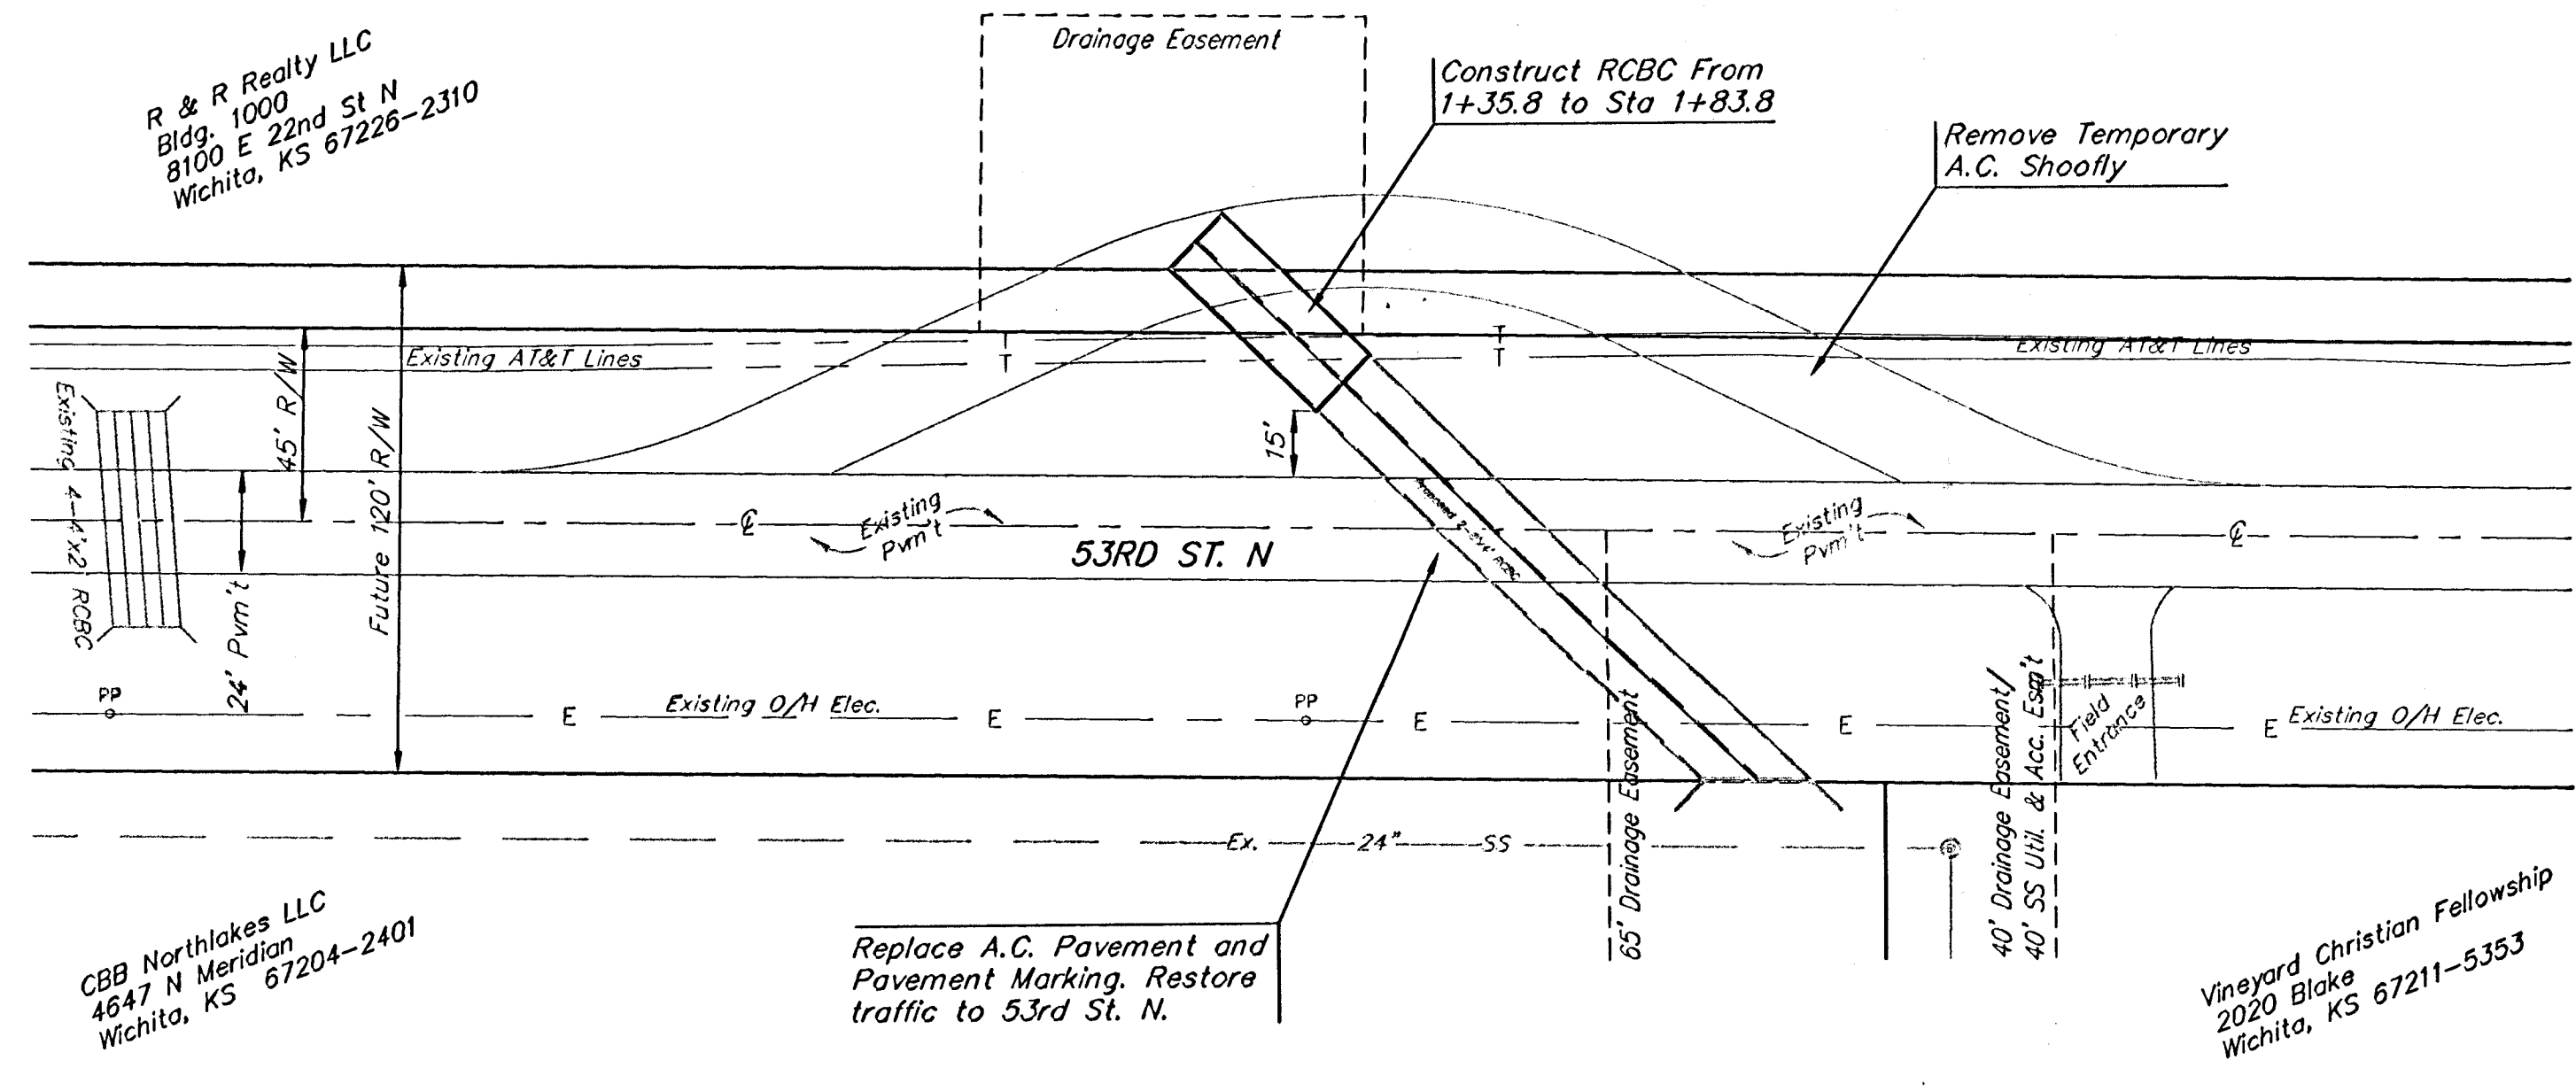

NOTES:

- All disturbed areas within 53rd Street R/W shall be regraded and restored to pre-construction conditions. All costs associated with regrading and restoring site shall be incidental to the lump sum bid item "Site Clearing and Restoration."
- Any Pavement or Striping which is damaged during construction shall be repaired as necessary at the Contractor's Expense, with no additional cost to the project.
- Pavement replacement shall meet Sedgwick County Standards for BM-2 Type pavement mix.
- Final Permanent Striping shall be "Thermoplastic" Type and meet Sedgwick County Standards.

PROJECT BENCHMARKS:

COW Benchmark at the Intersection of Meridian and 53rd St N, NE Corner, Top of Concrete Headwall.
44' North of Centerline
37' East of Centerline
50.90' NE of Section Corner
9' NE of and radial to curb
26' East of Section Line
Elev. = 1,331.37 NGVD29



COW Benchmark at the intersection of Meridian and Keywest, NW Corner,
59' West of Centerline
32.3' North of Centerline
11.8' North of N curb line of Keywest
4.8' NW of center of Power Pole
Elev. = 1,329.36 NGVD29

Baughman Northgate Offsite Drainage
Construction Phasing & Temporary Shoofly
Storm Water Drain #307

Baughman Company, P.A. 315 Ellis St. Wichita, KS 67211 P:3162637211 F:3162620149
ENGINEERING | SURVEYING | PLANNING | LANDSCAPE ARCHITECTURE

PROJECT NUMBER 468-24253	DESIGN RDM/AEG	DRAWN RDM
REVISIONS	APPROVED AEG	DATE 3-14-07
	SCALE Noted	SHEET 9 OF 22


No Scale




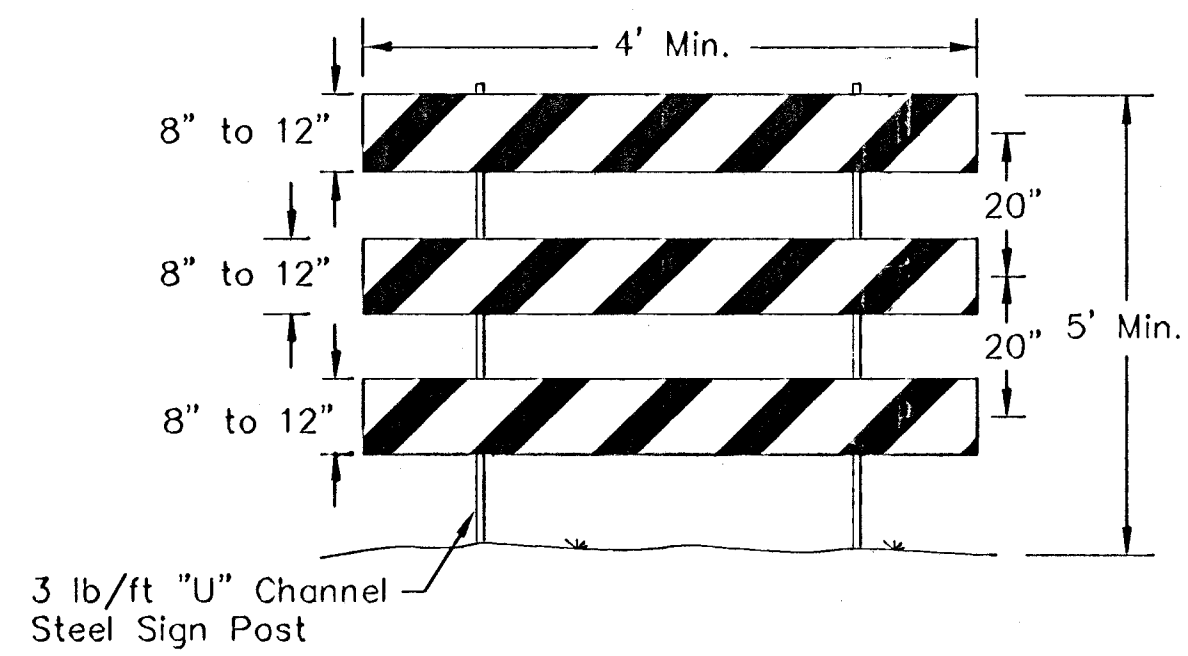
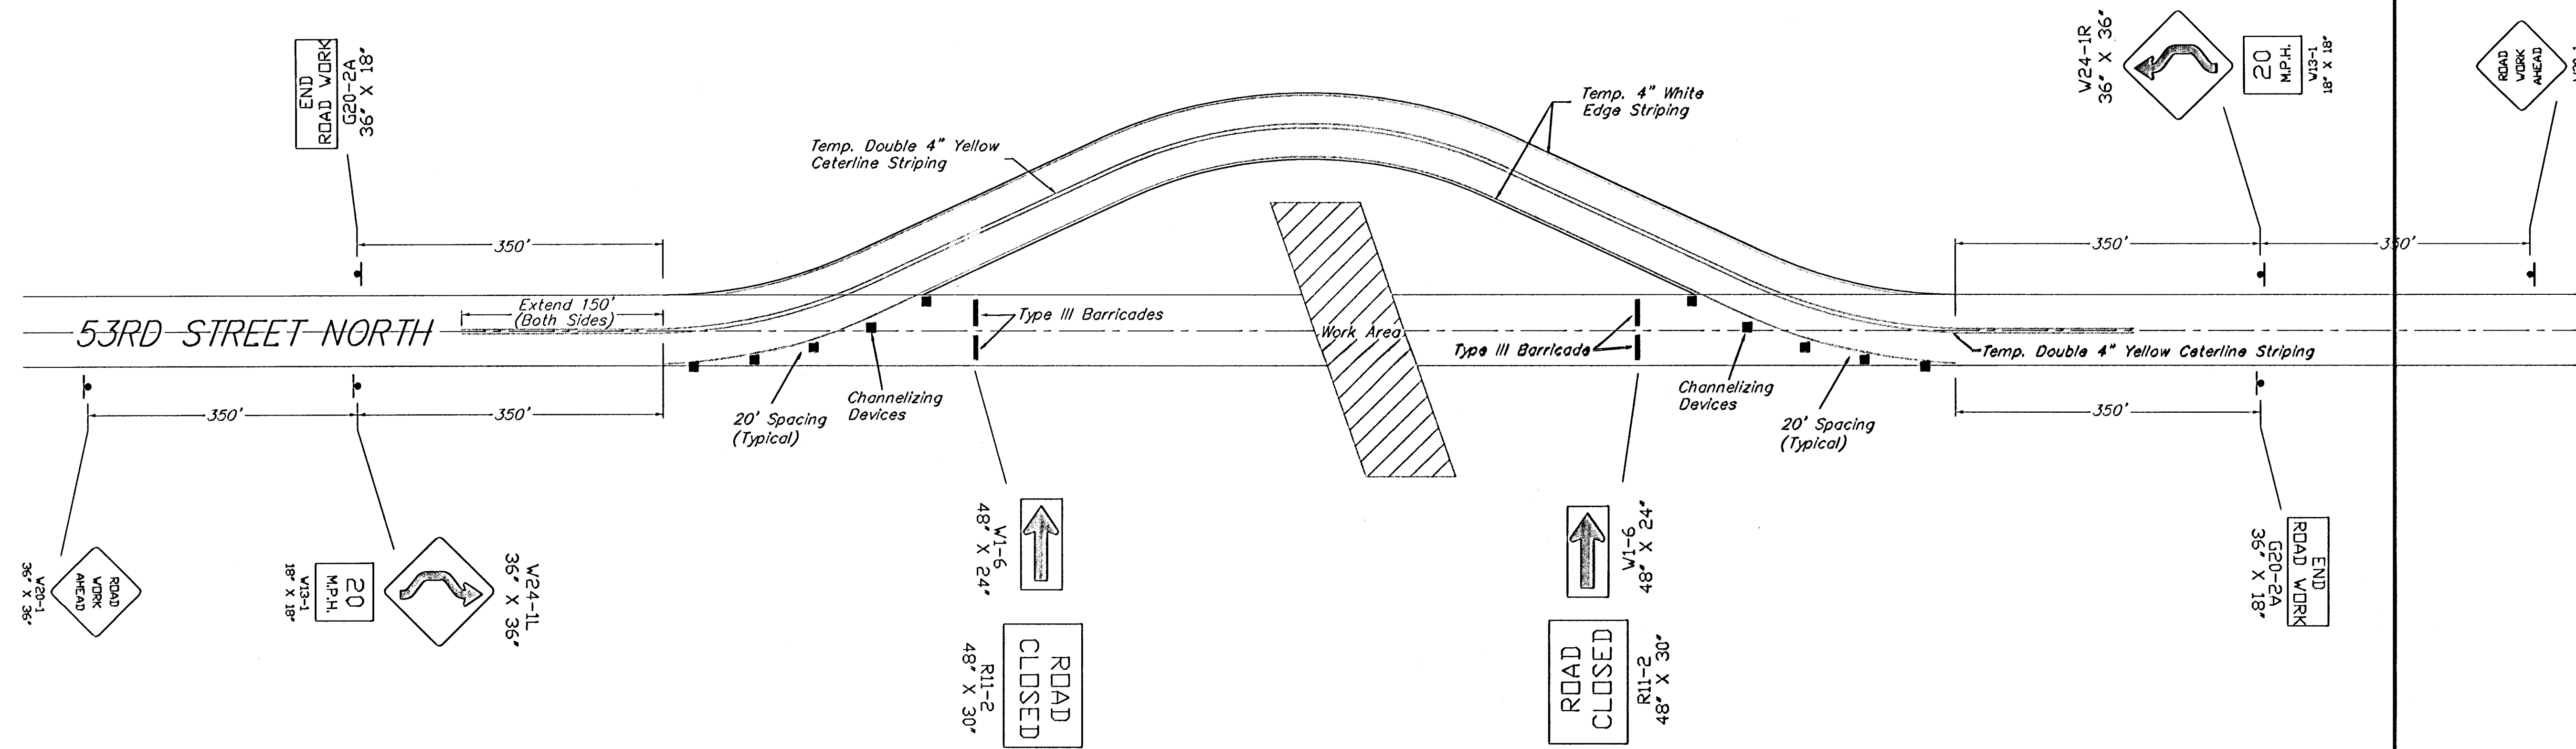


TYPE III BARRICADE

NOTES:

1. The Contractor shall protect traffic by use of proper and necessary flags, lights, signals, barricades or other warning devices as needed, all in accordance with the latest edition of the Manual On Uniform Traffic Control Devices (MUTCD).
2. Channelizing Devices shall be either "Reflectorized Drum" type at least 36" tall, or "Tubular Markers" at least 28" tall with retroreflectorized bands.
3. All cost associated with the Installation, Maintenance, and Removal of Traffic Control Devices shall be included in Lump Sum Bid Item "Traffic Control."

	Northgate Offsite Drainage Traffic Control & Sign Details Storm Water Drain #307	
	<small>Baughman Company, P.A. 315 Ellis St. Wilkes Barre, PA 18262-7111 P 316-262-7111 F 316-262-0149 ENGINEERING SURVEYING PLANNING LANDSCAPE ARCHITECTURE</small>	
PROJECT NUMBER 468-84253	DESIGN RDM/AEG	DRAWN RDM
REVISIONS:	APPROVED AEG	DATE 3-14-07
SCALE No Scale		SHEET 10 OF 22

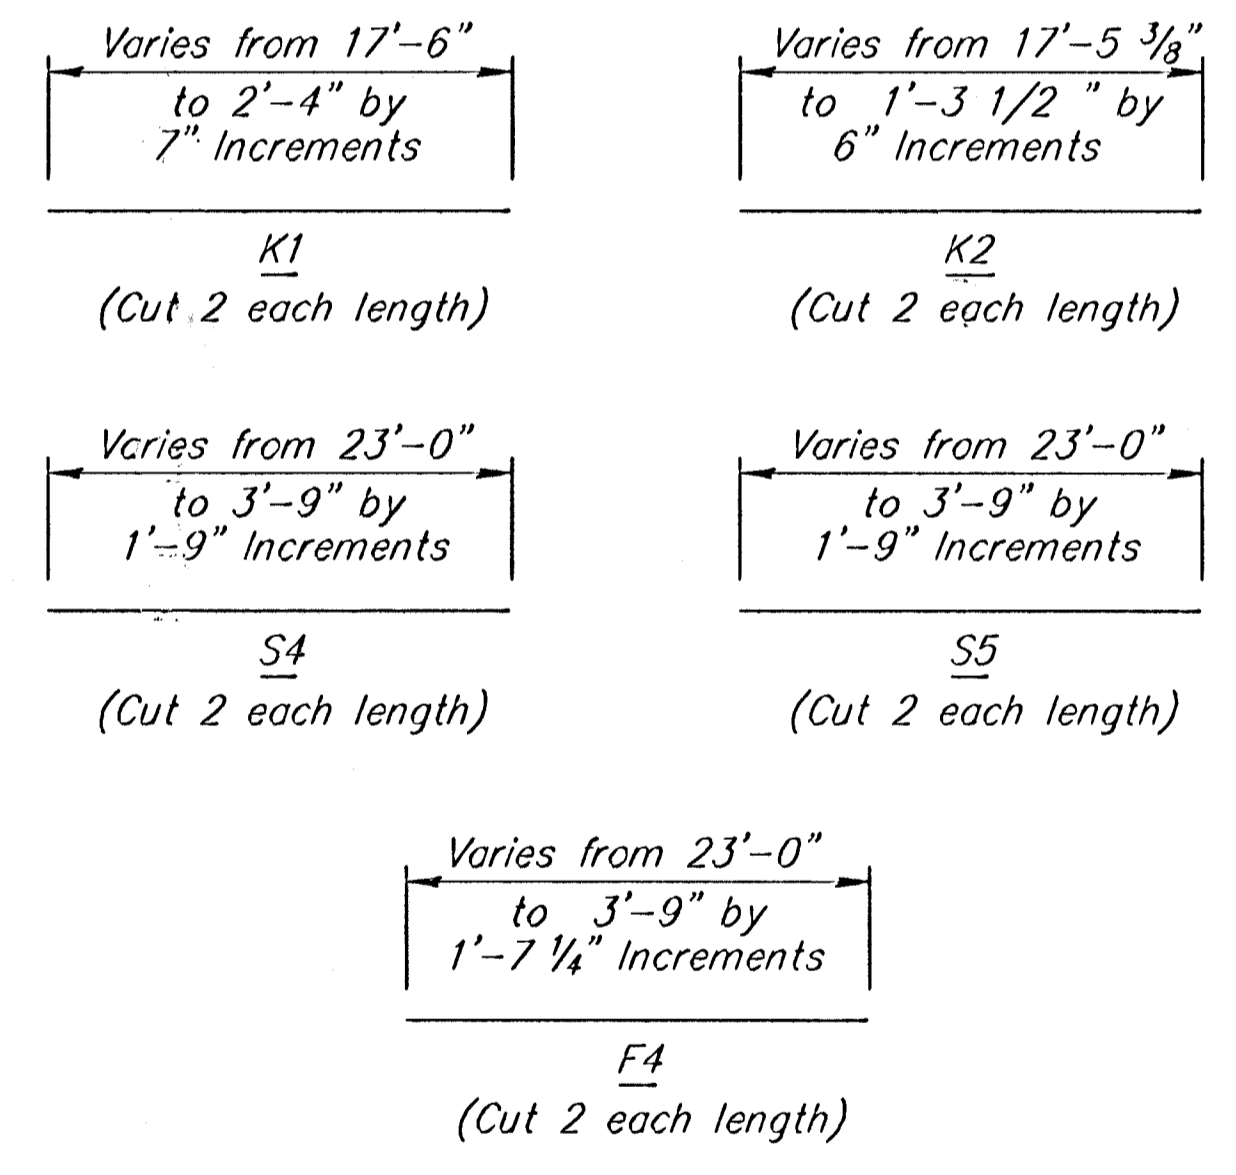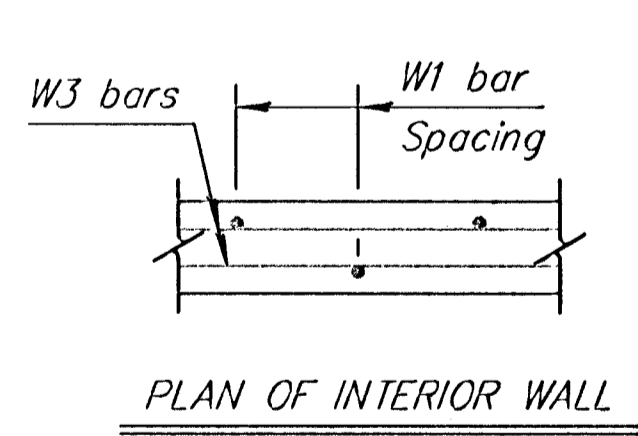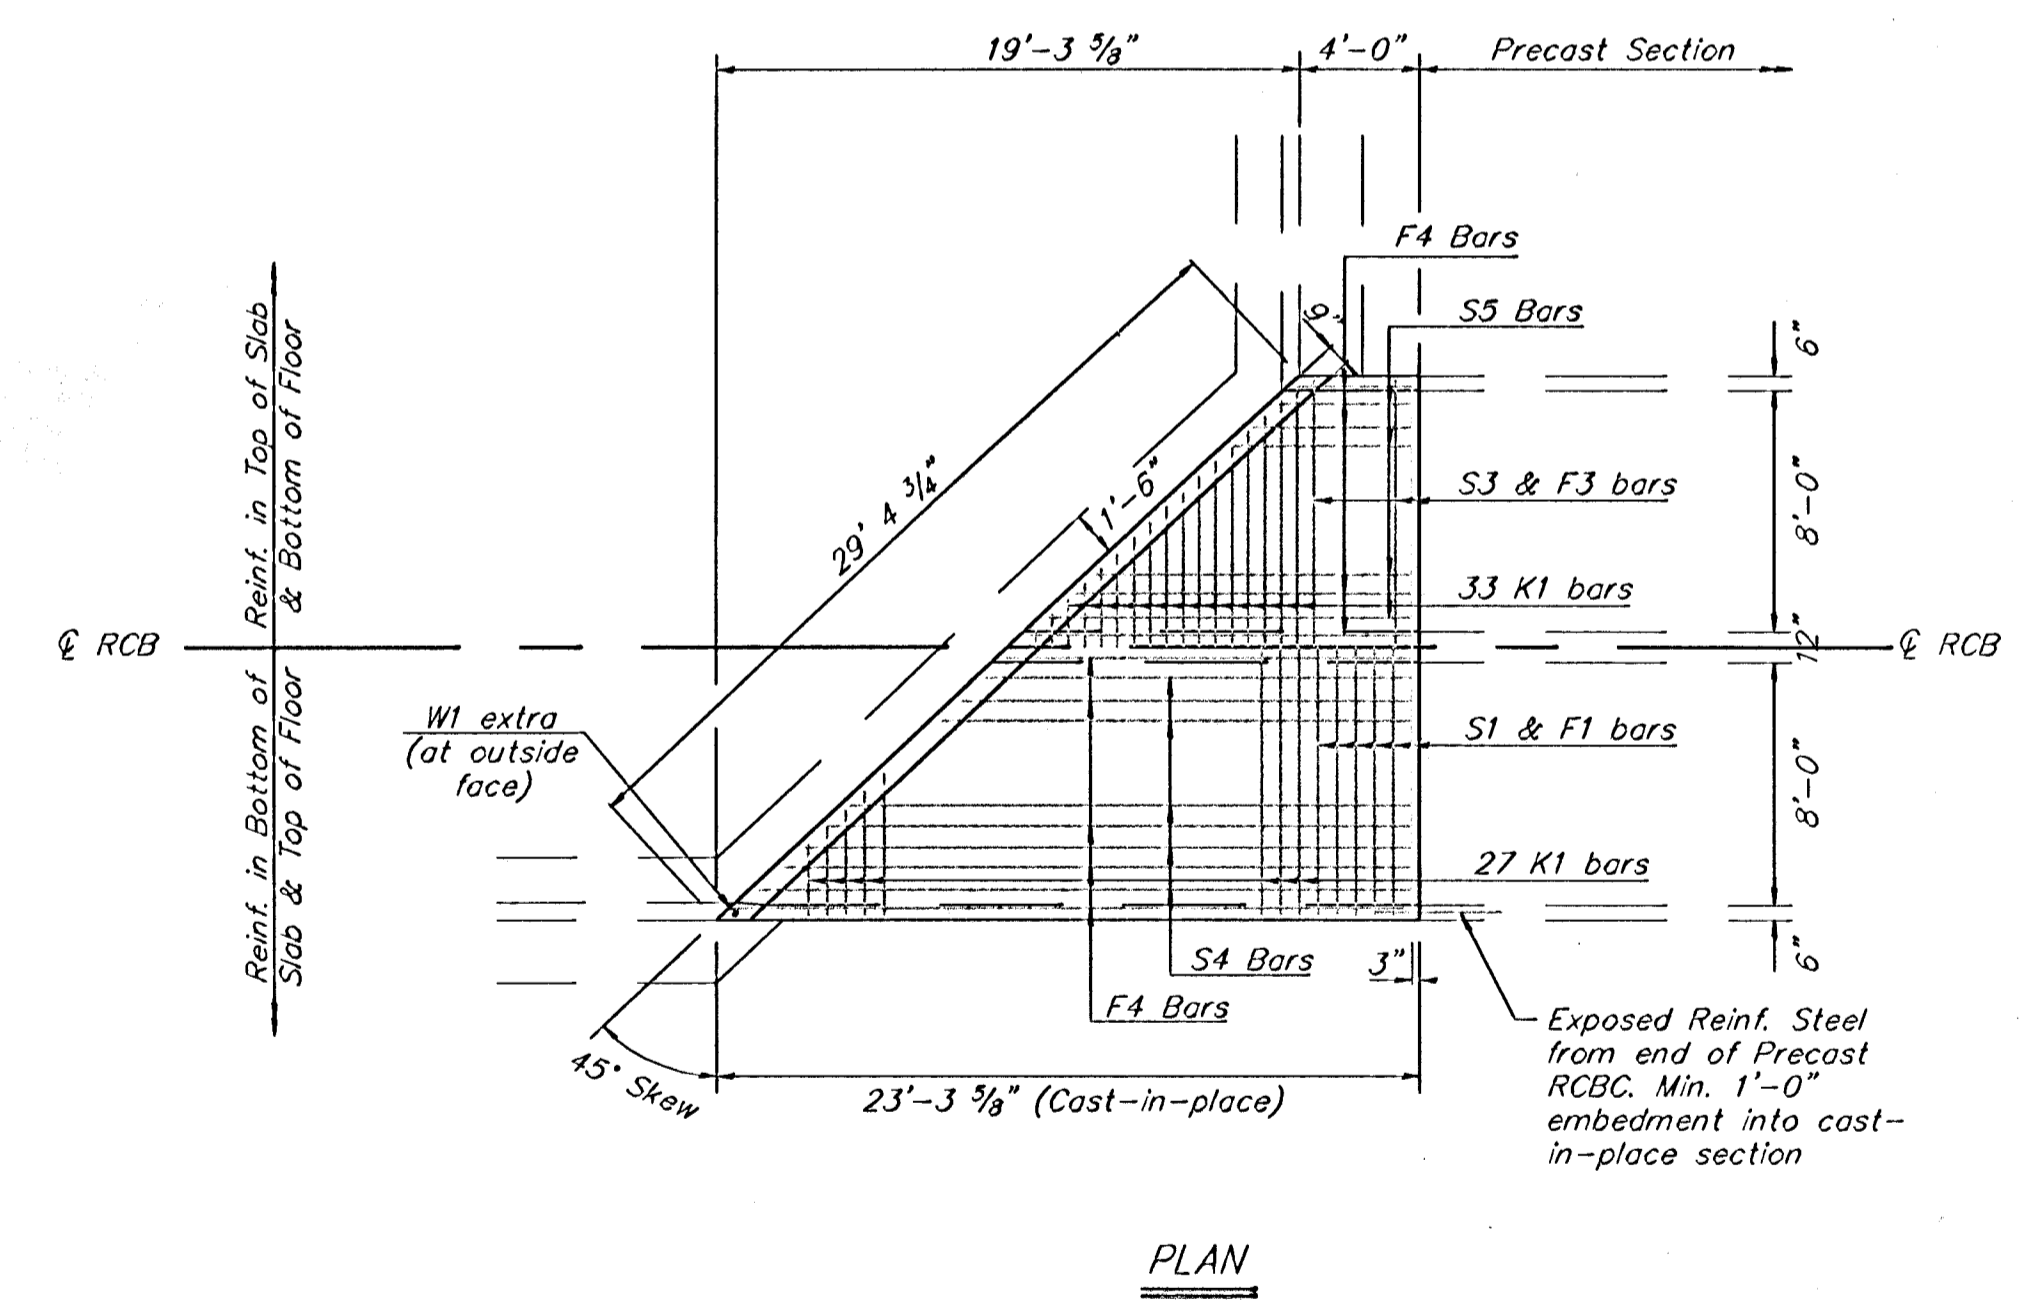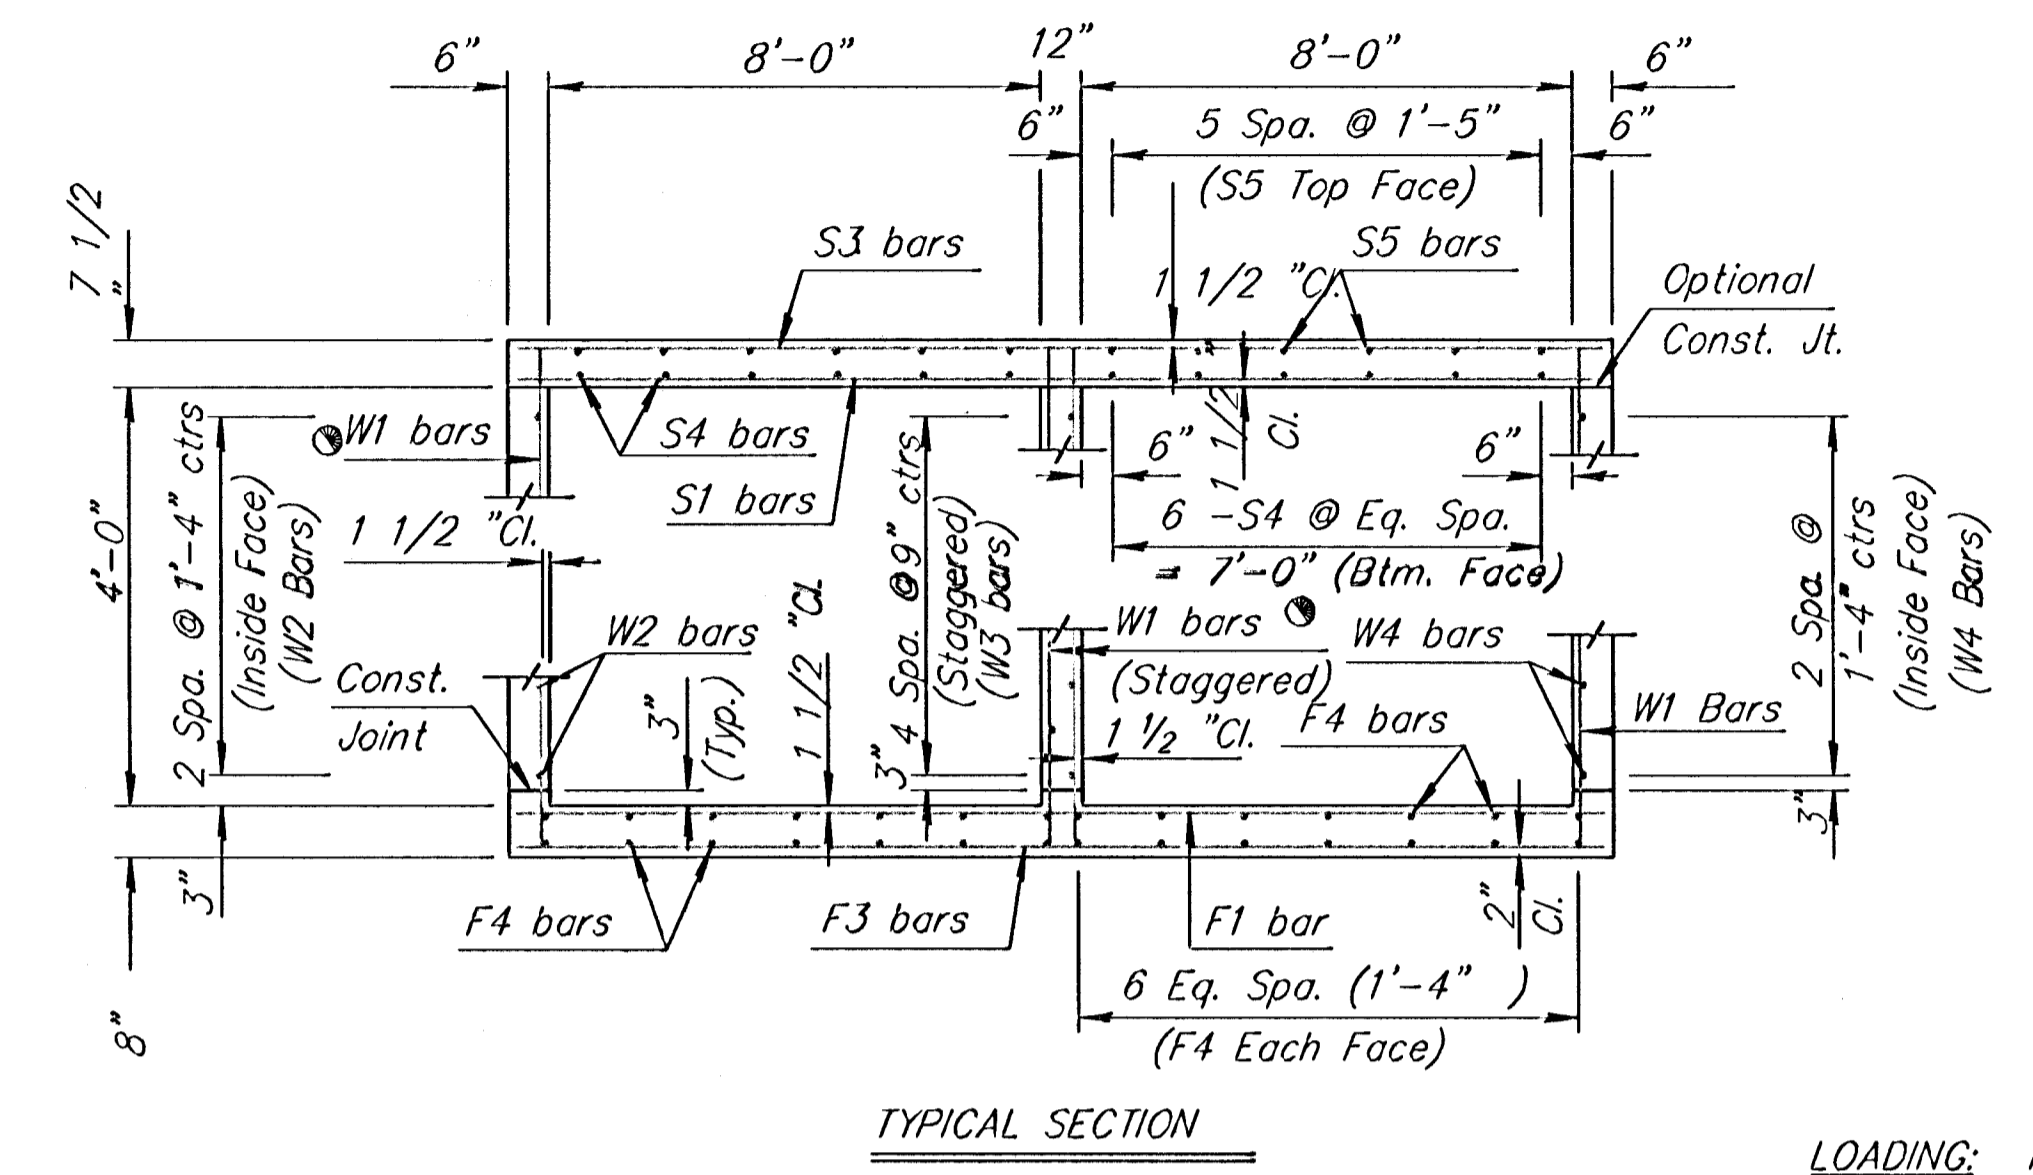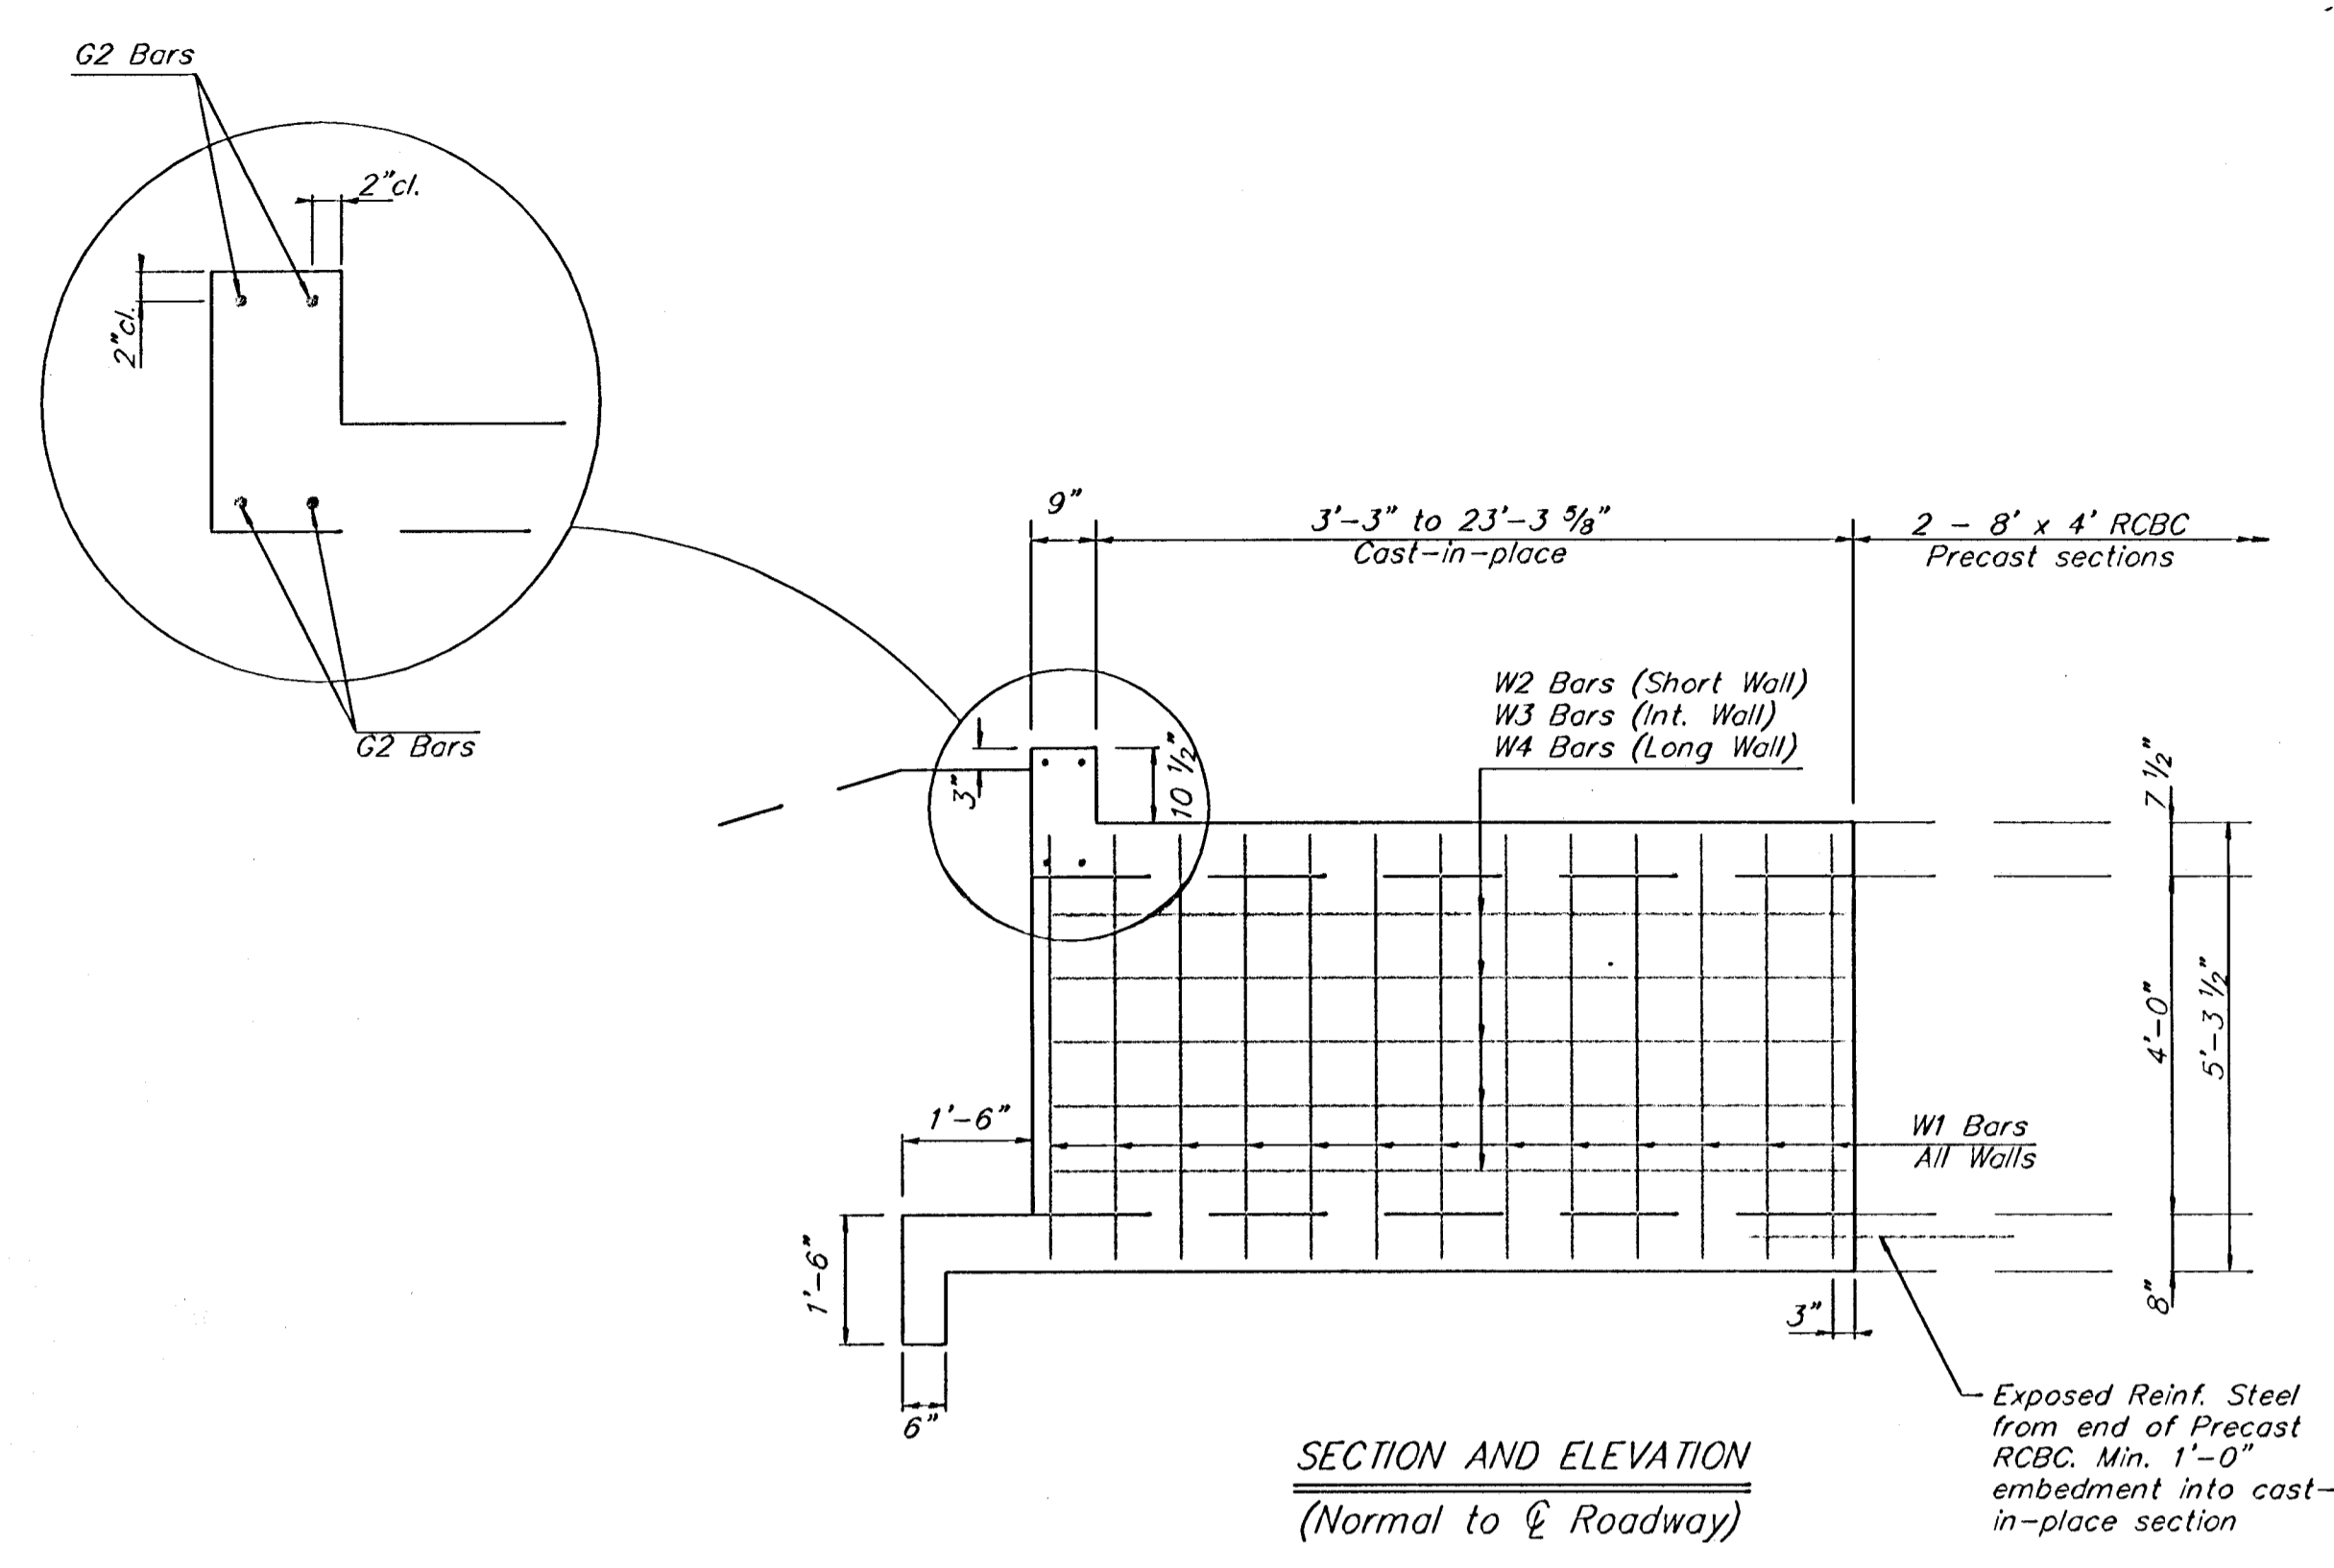

GENERAL NOTES

LOADING: HS20-44 AASHTO Specifications, 1983 Edition.

UNIT STRESSES: Grade 4.0 Concrete; $f_c = 4,000$ p.s.i. Reinforcing Steel; $f_y = 60,000$ p.s.i.

FILL HEIGHT: Unless otherwise noted, the Design Fill Height is measured from the riding surface at the culvert and shall include the surfacing.

CONCRETE: Grade 4.0 Concrete shall be used throughout. Bevel all exposed edges with a 3/4 inch triangular moulding. Where Grade 4.0 Concrete (AE) is specified, it shall be placed in the top slab above the Construction Joint.

REINFORCING: All reinforcing shall conform to ASTM A615, Grade 60. All dimensions relative to reinforcing steel shall be to centerline of bar unless otherwise noted.

EXCAVATION: Excavation for culverts less than bridge length shall not be paid for directly but shall be subsidiary to Grade 4.0 Concrete. Excavation for RCB Bridges shall be paid for as Class III Excavation.

SEAL COURSE: A Seal Course may be required by the Engineer. The Seal Course shall be unreinforced Concrete (Commercial Grade) to a minimum depth of 3 inches or as determined by the Engineer. Concrete for the seal course shall be paid for at the unit price set for Concrete for Seal Course.

FOUNDATION STABILIZATION: Foundation Stabilization may be required as directed by the Engineer. The depth of Foundation Stabilization shall be determined by the Engineer. Foundation Stabilization shall be paid for at the determined Unit Price set for Foundation Stabilization. See Auxiliary Details.

QUANTITIES: The quantities shown in the Culvert Summary include apron and/or silt saver quantities when their construction is required by the plans. Payment for additional quantities that result from including seal course and/or floating apron, as a change in original plans, shall be made at the Unit Price bid for the various items involved.

GRANULAR BACKFILL (WINGWALLS): Special backfill procedures may be required at the direction of the engineer. See Auxiliary Details Sheet.

STRIKE LINE: Wingwalls and that portion of the RCB outside the Strike Line shall be constructed level. Footing for wingwalls shall be constructed with the culvert floor. See wingwall detail sheet.

Plotted by: narseni
 File: I:\FD\MS\proj\468\84253\84.dgn
 Plot Date: 01/2/2006

BAR SCHEDULE																																			
F1				F3				F4				Δ S1				Δ S3				Δ S4				Δ S5											
Size	Spa.	No.	Length	Size	Spa.	No.	Length	Size	Spa.	No.	Length	Size	Spa.	No.	Length	Size	Spa.	No.	Length	Size	Spa.	No.	Length	Size	Spa.	No.	Length								
5	7 1/2"	6	17'-8"	N/A	N/A	N/A	N/A	5	6 1/2"	7	17'-8"	4	28	*	5	7 1/2"	6	17'-8"	N/A	N/A	N/A	N/A	5	6 1/2"	7	17'-8"	4	12	*	4	12	*			
Δ K1				Δ K2				W1				W2				W3				W4				Δ G1				Δ G2							
Size	Spa.	No.	Length	Size	Spa.	No.	Length	Size	Spa.	No.	Length	Size	Spa.	No.	Length	Size	Spa.	No.	Length	Size	Spa.	No.	Length	Size	Spa.	No.	Length	Size	Spa.	No.	Length	Size	Spa.	No.	Length
5	7 1/2"	56	*	5	6 1/2"	66	*	4	9"	56	5'-0"	4	N/A	3	3'-9"	4	5	13'-4"	4	N/A	3	23'-0"	N/A	N/A	N/A	N/A	7	4	26'-0"	N/A	N/A	N/A	N/A		

Minimum Splice Length	
#4	1'-4"
#5	1'-8"
#6	2'-0"















Minimum Splice Length	
Concrete (Grade 4.0)	11.7 C.Y.
Concrete (Grade 4.0) (AE)	6.3 C.Y.
Reinf. Steel (Gr. 60)	812 Lbs.
Reinf. Steel (Epoxy Coated)	1,244 Lbs.
Class III Excavation	C.Y.
Foundation Stabilization (Set)	1 C.Y.
Concrete for Seal Course (Set)	1 C.Y.
Granular Backfill (Wingwalls) (Set)	1 C.Y.

NO.	DATE	REVISIONS	BY	APP'D

DOUBLE 8 ft x 4 ft RCB
(47' SKEW LT.)

BR 2.8.4 P Sedgwick Co.

DESIGN	DETAIL	QUANTITIES	TRACE

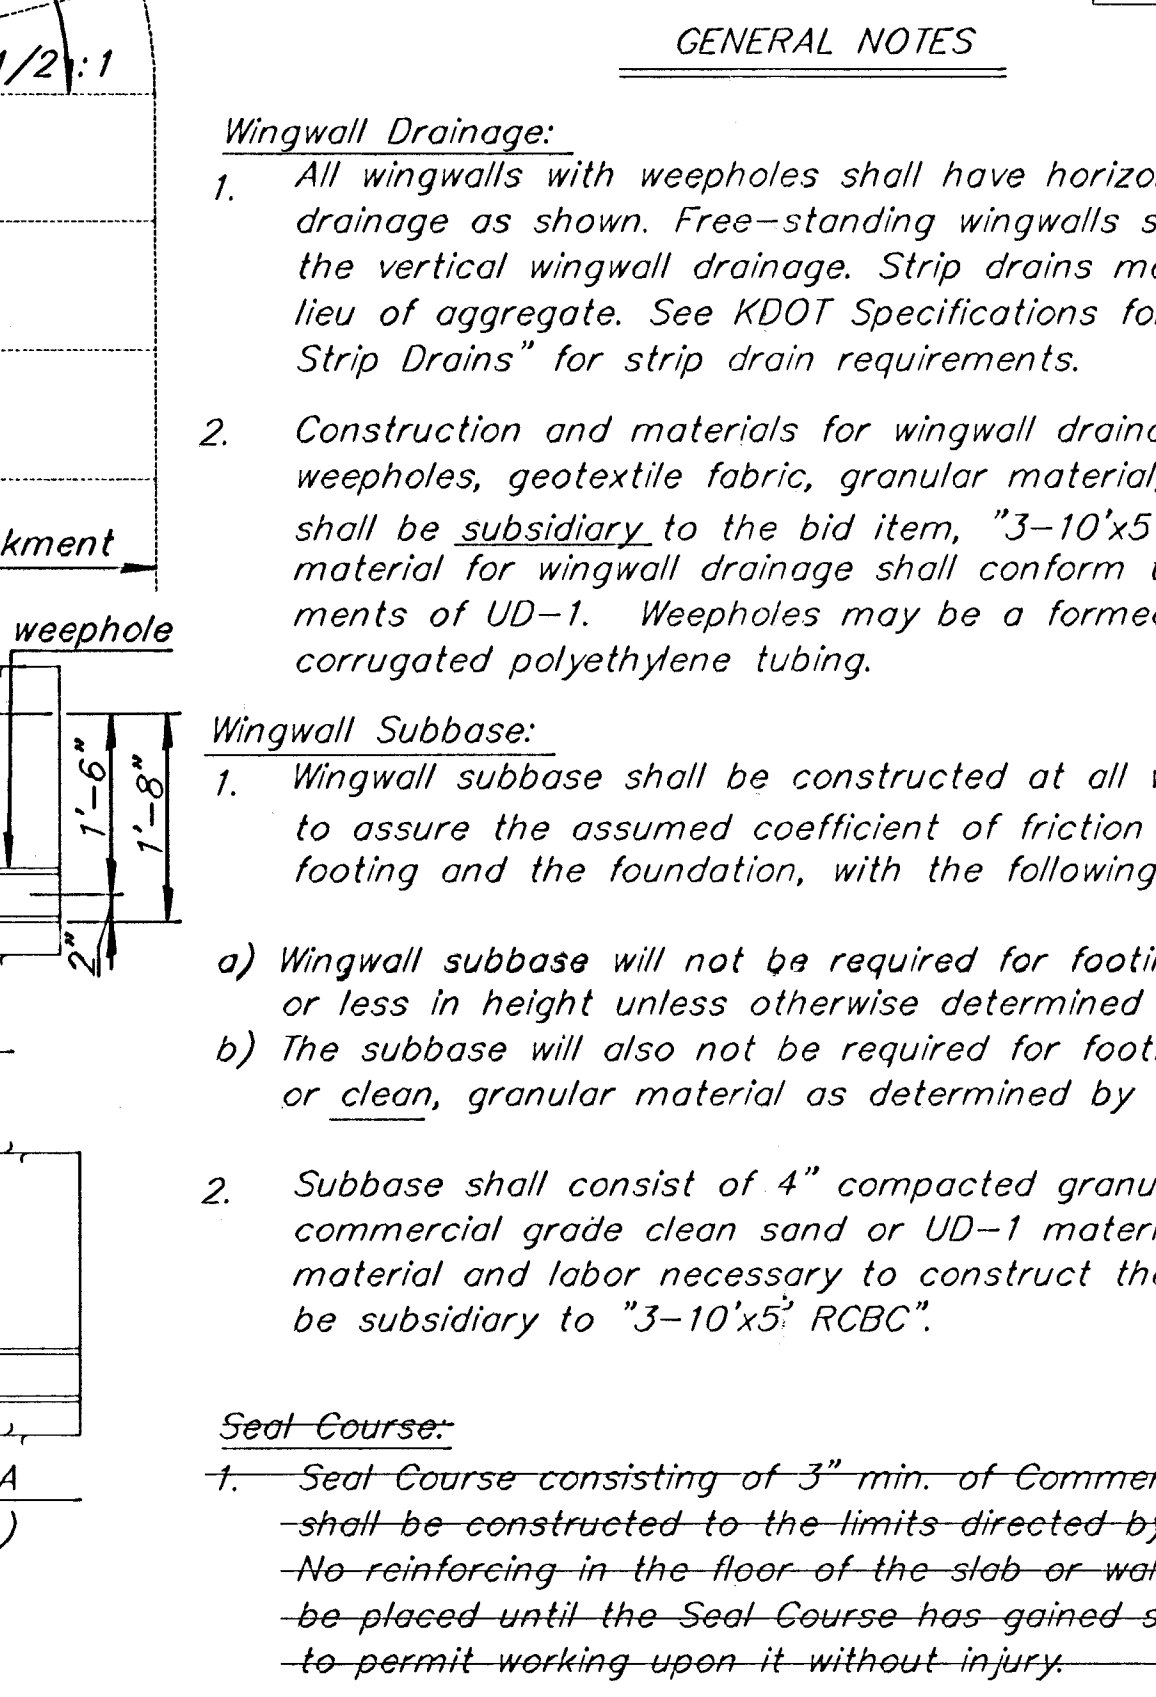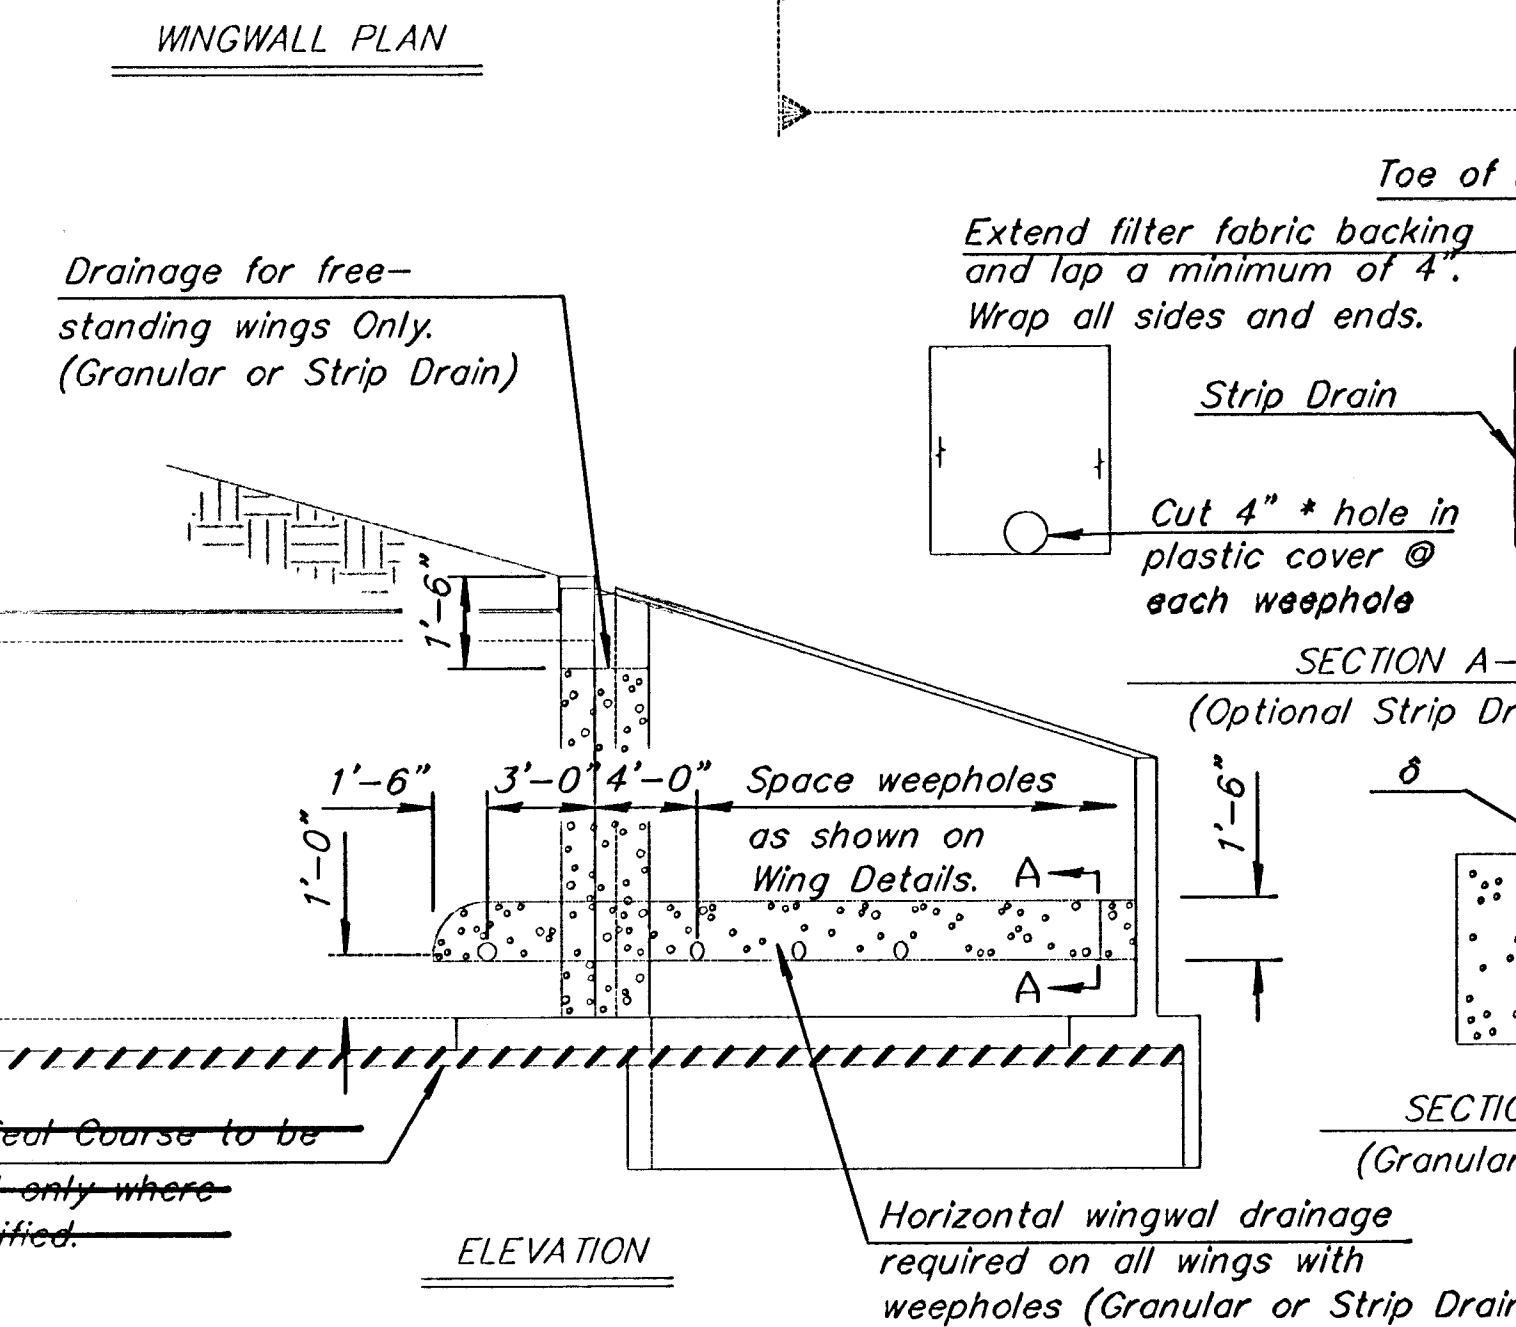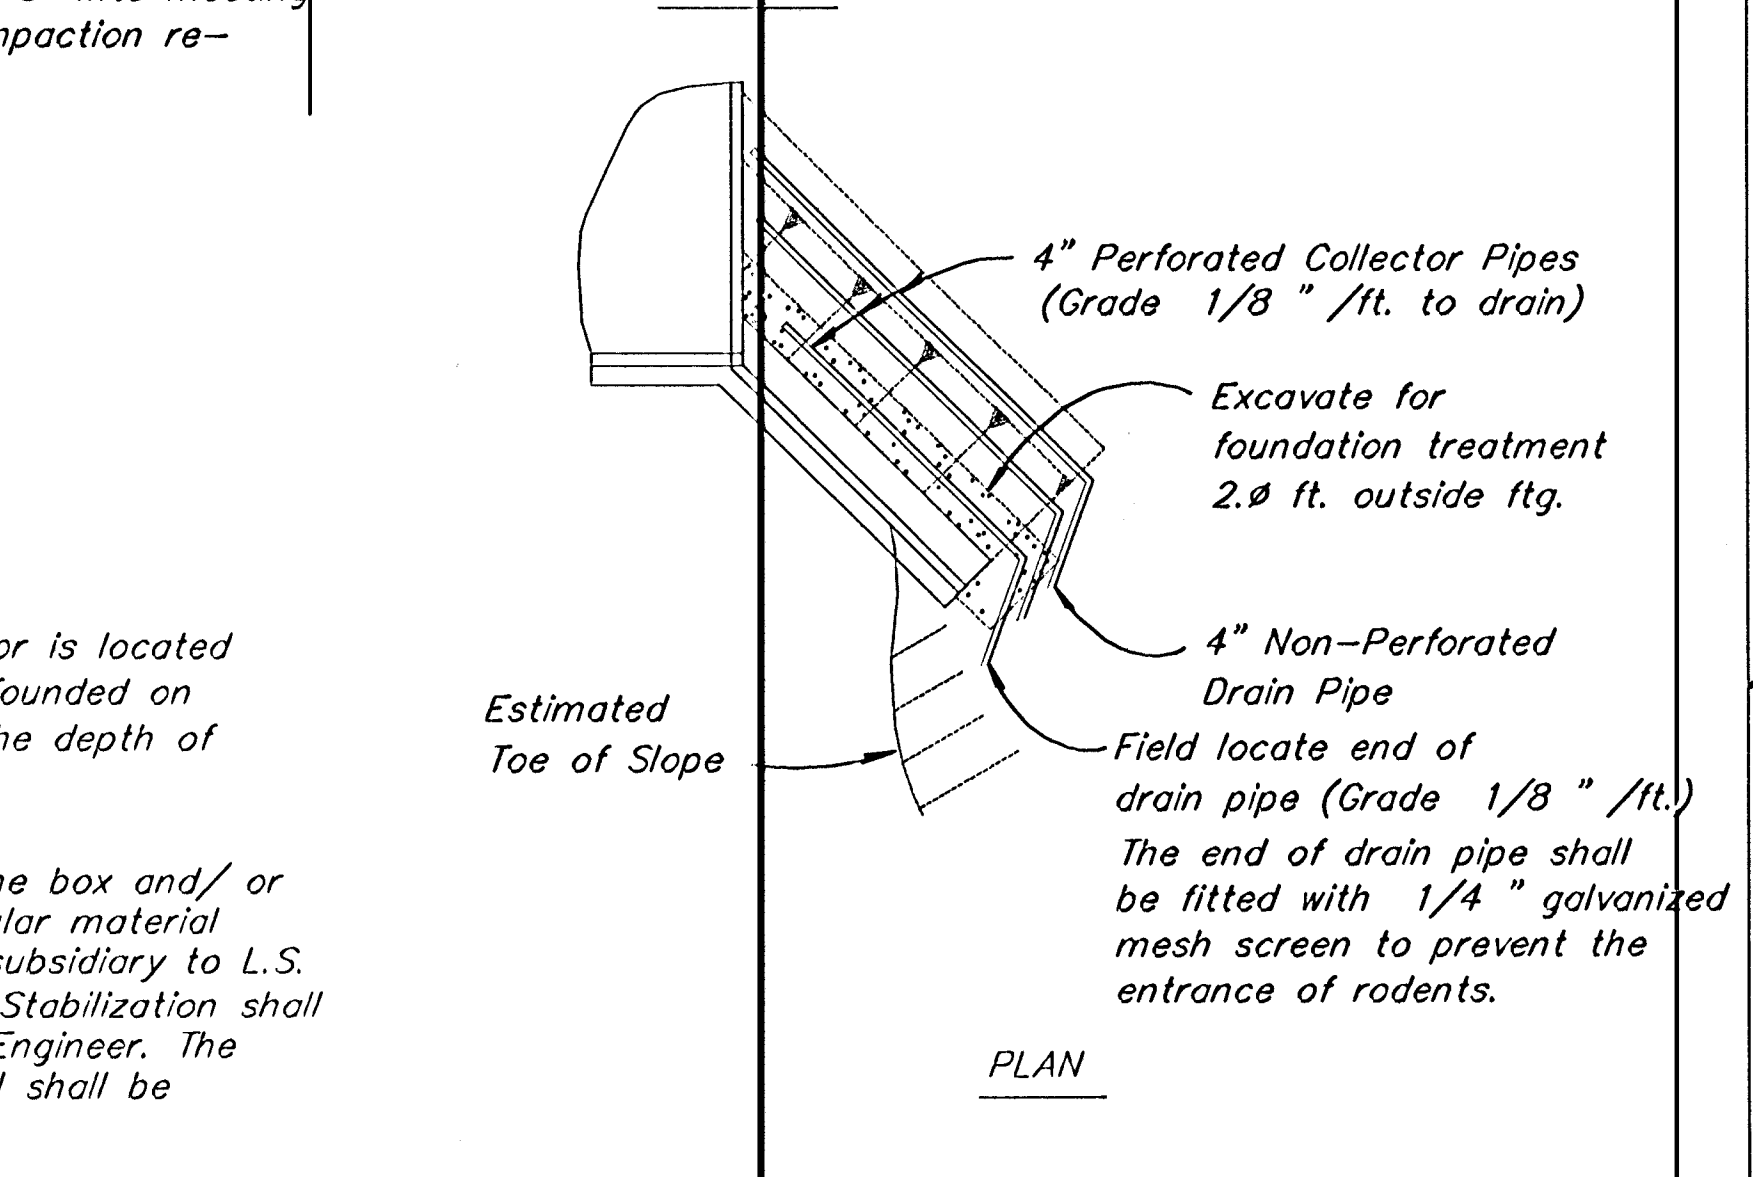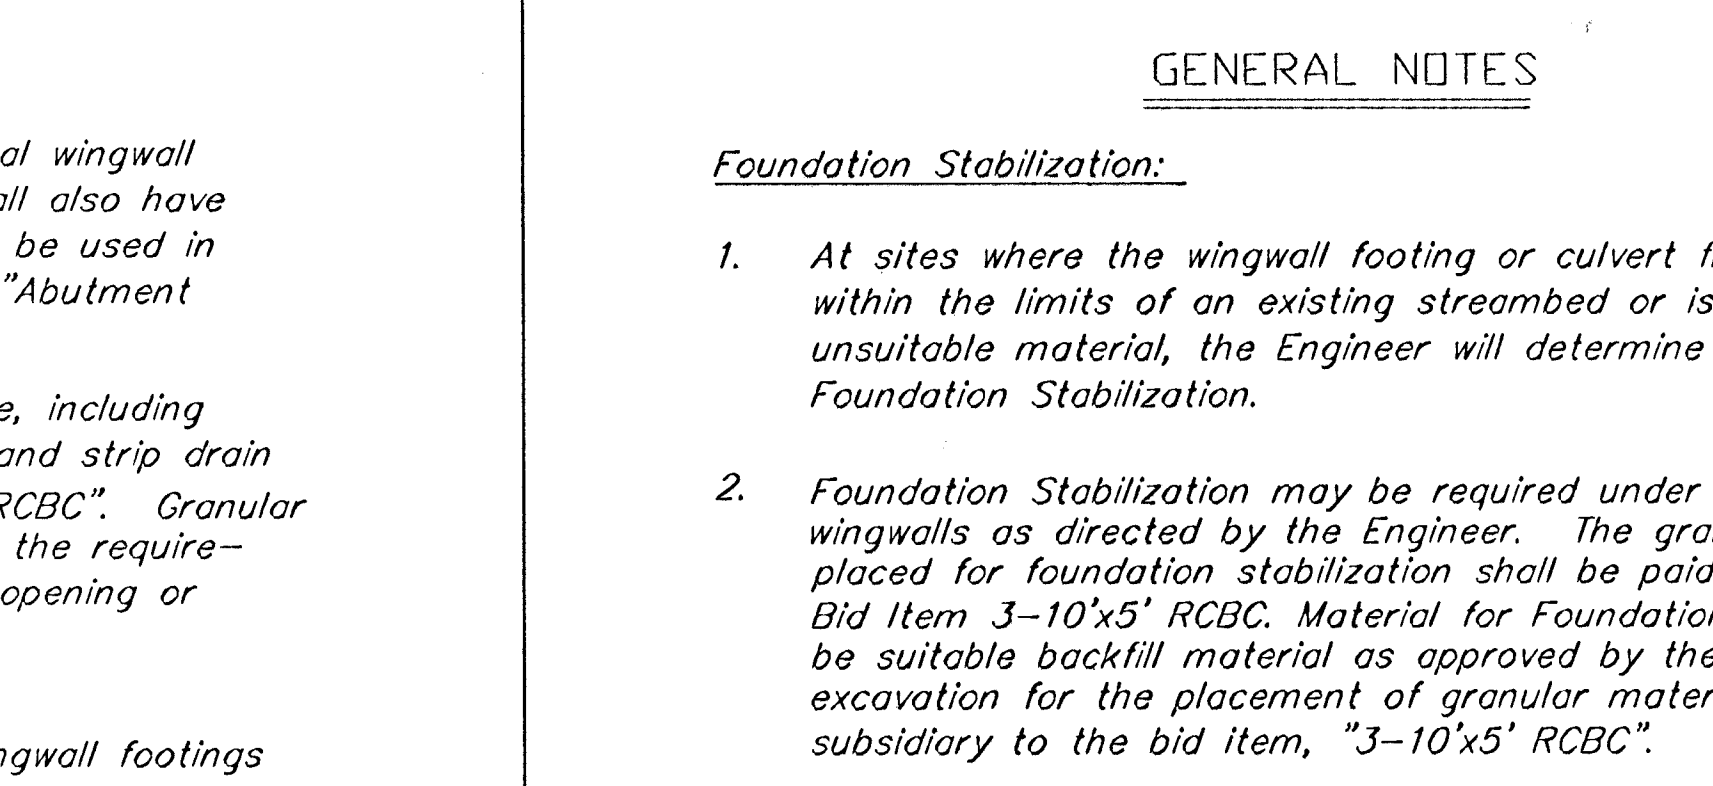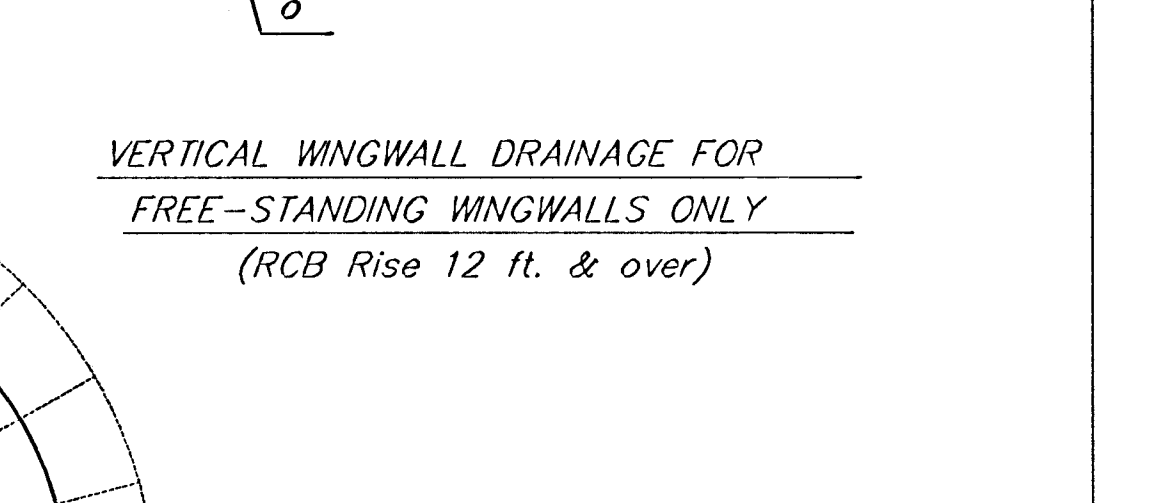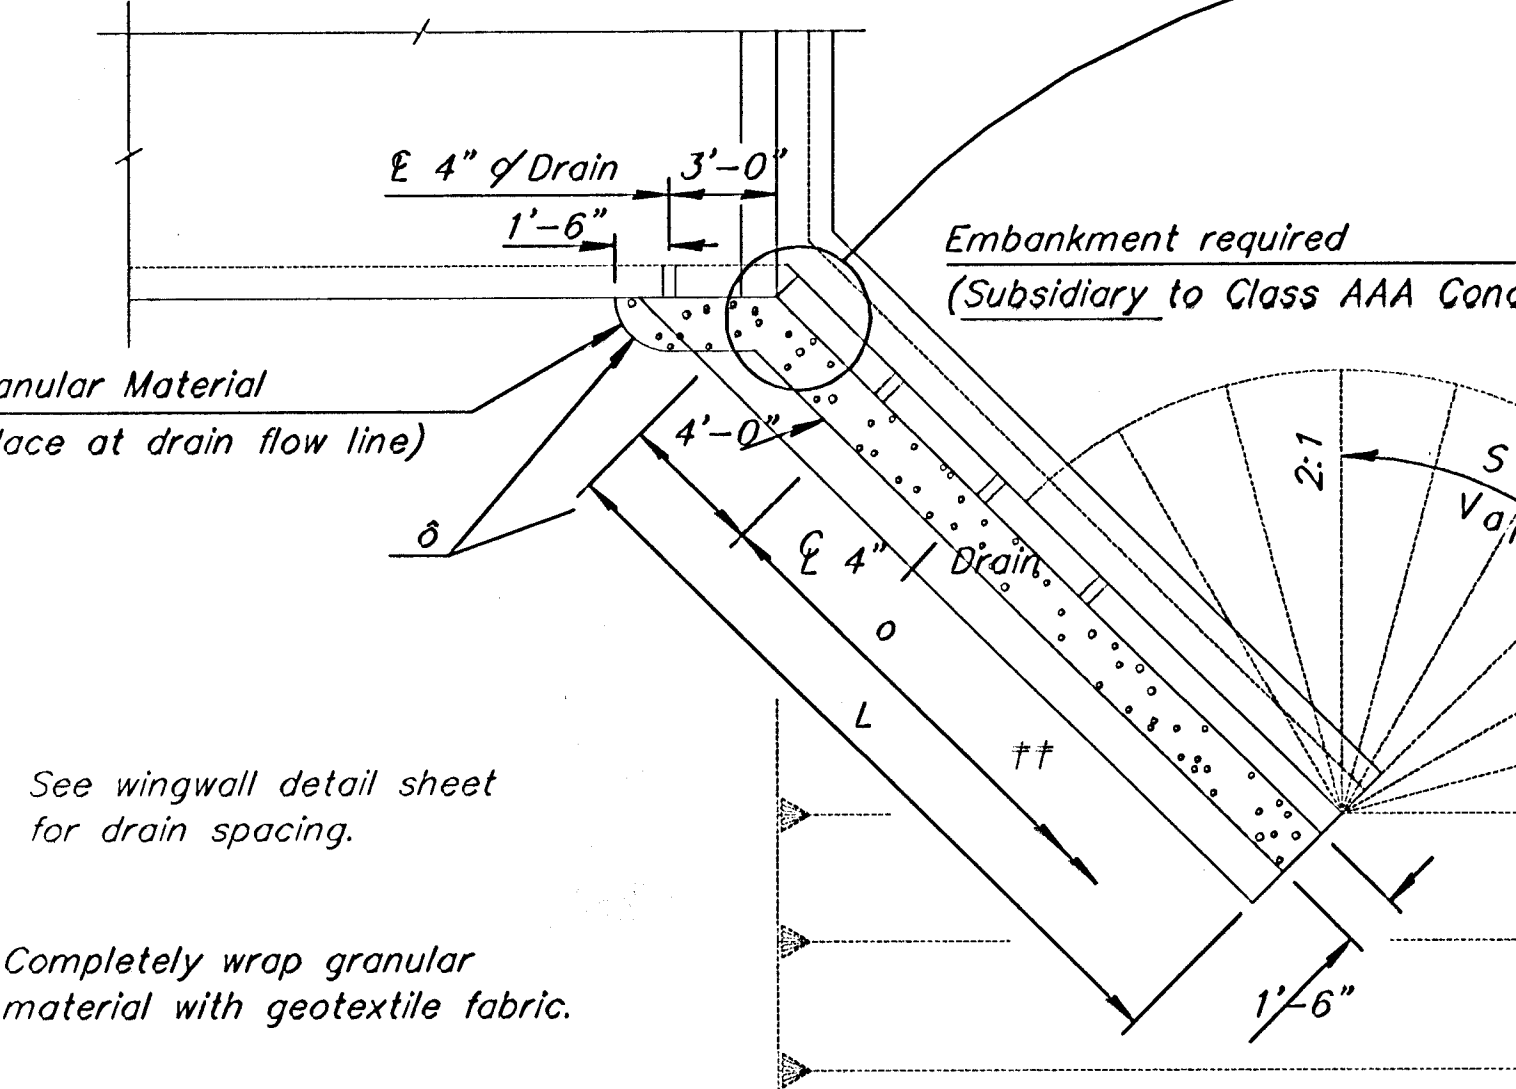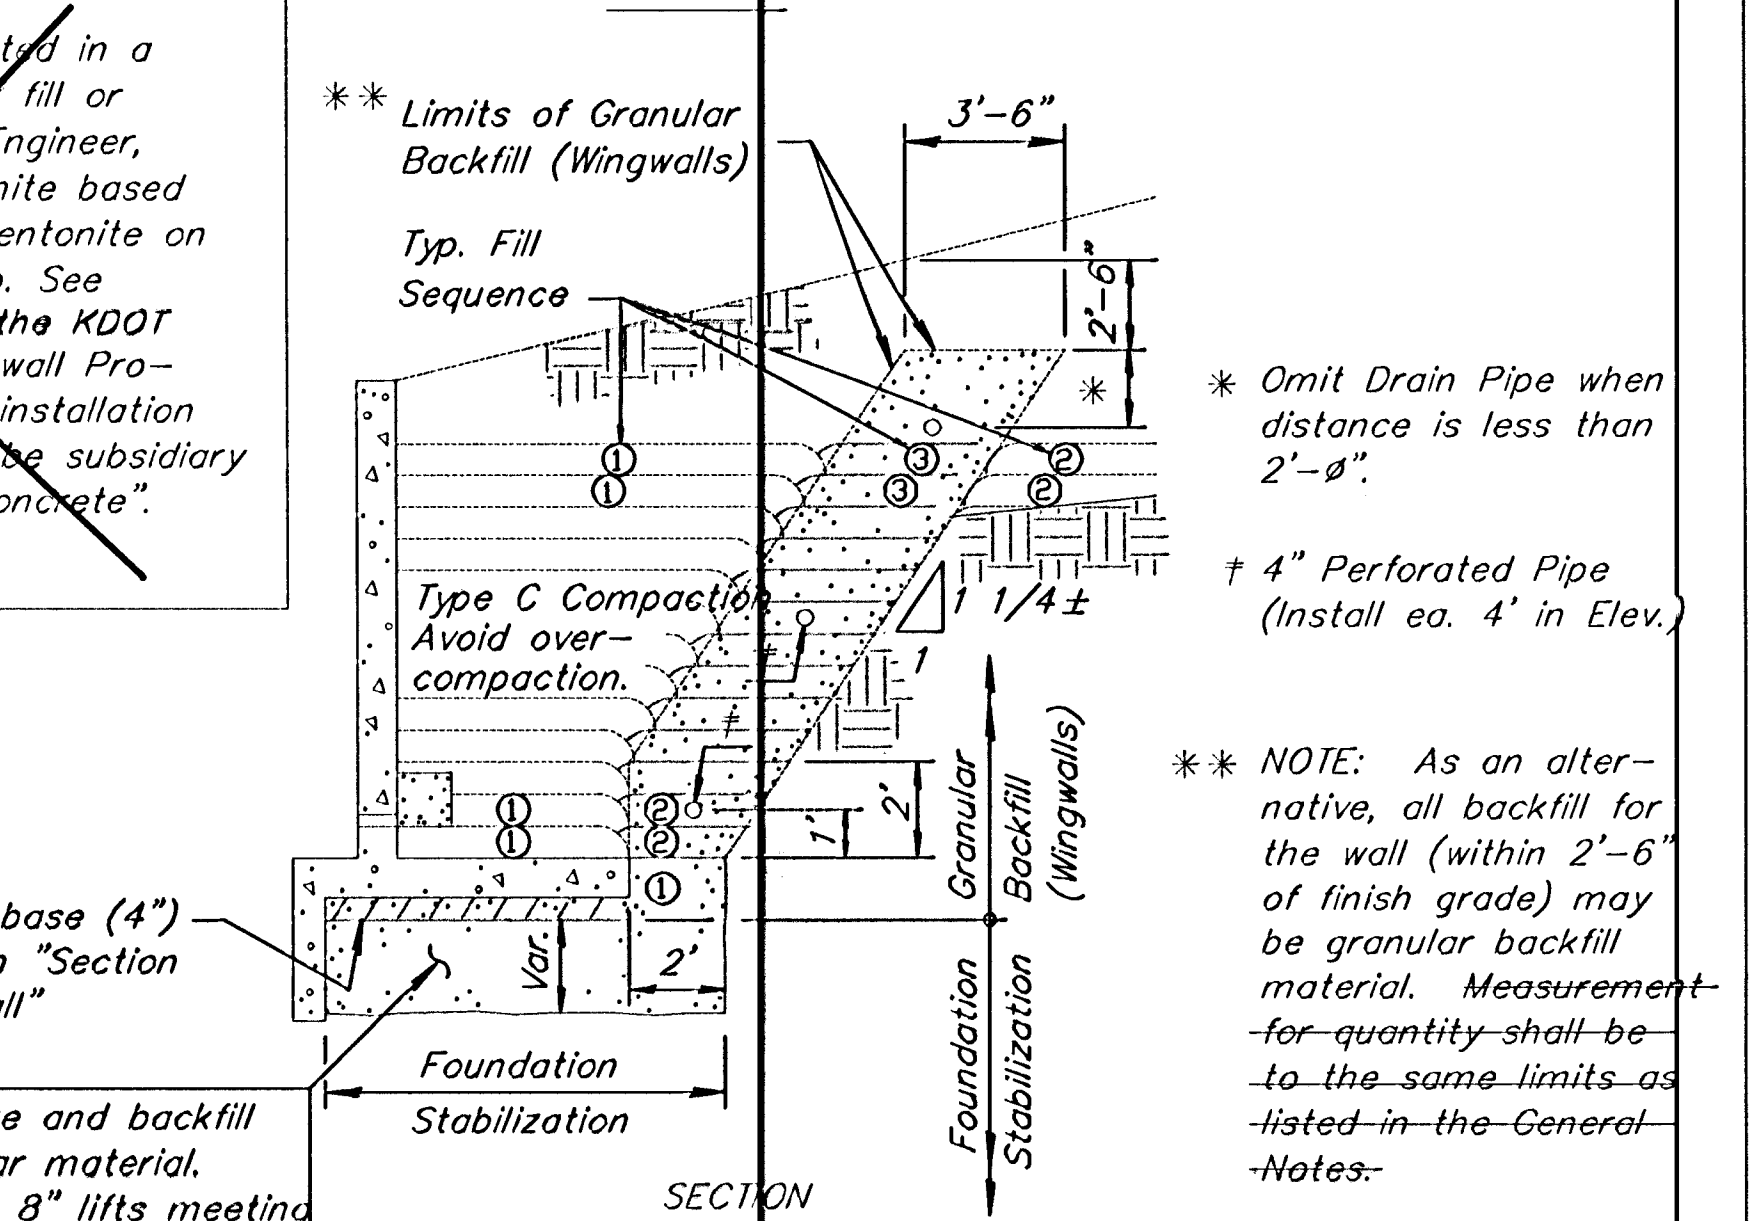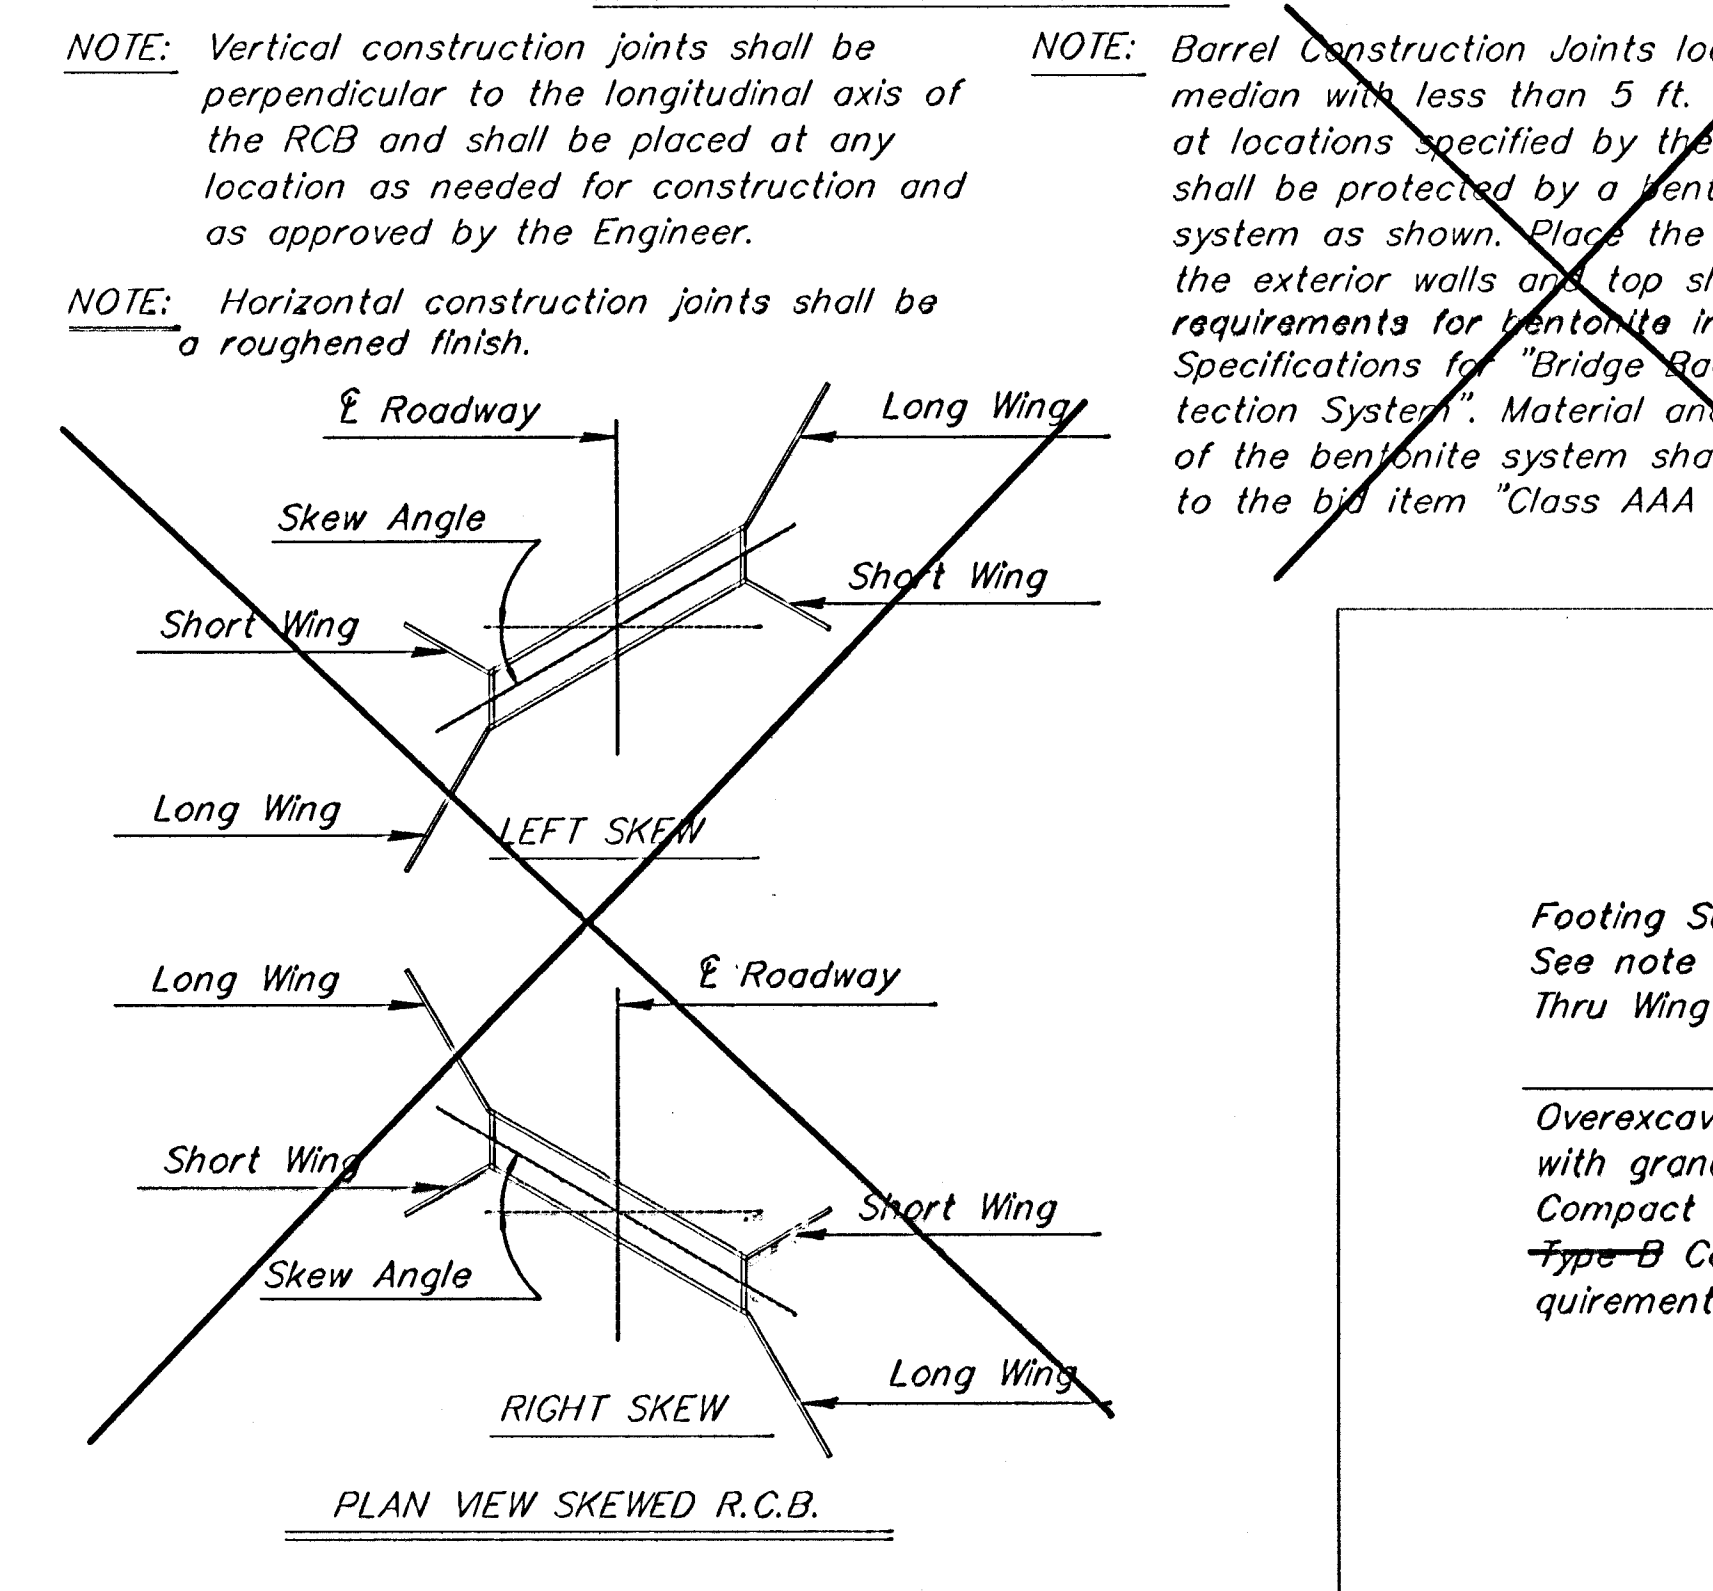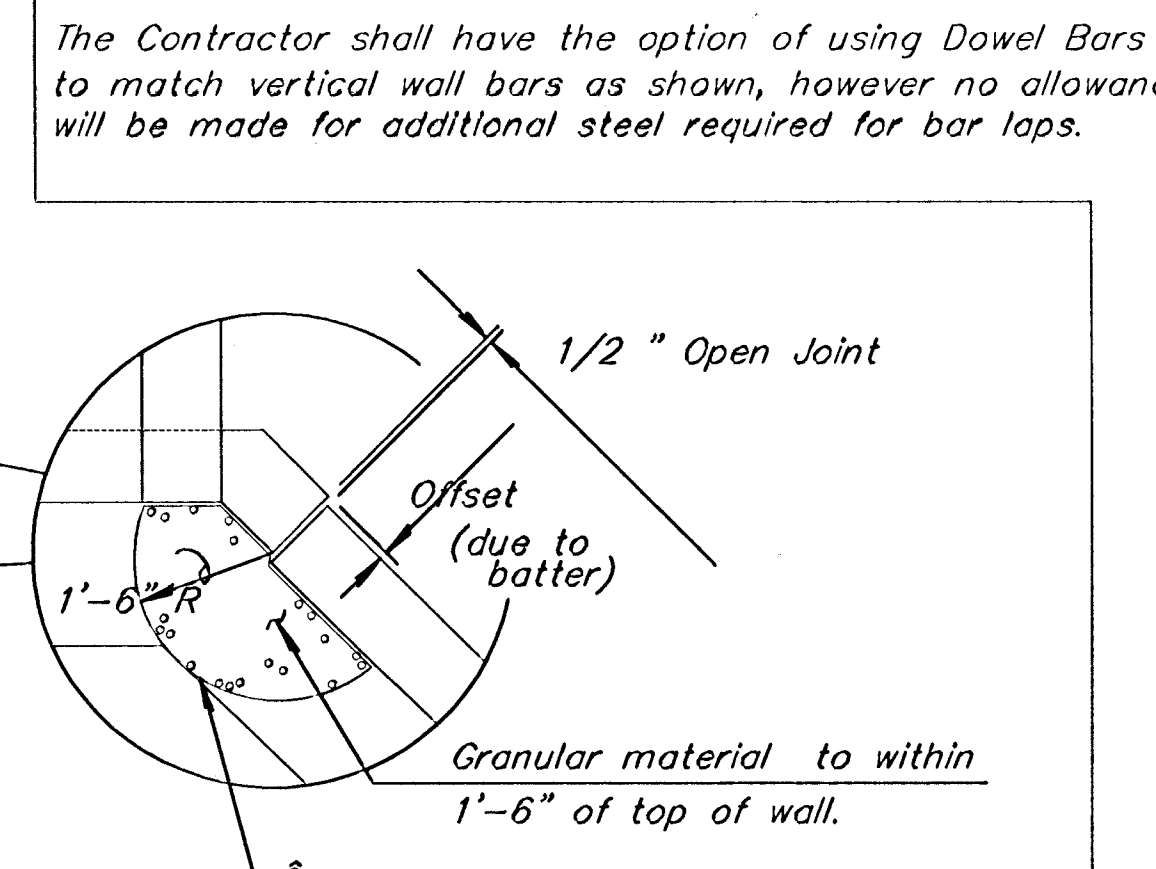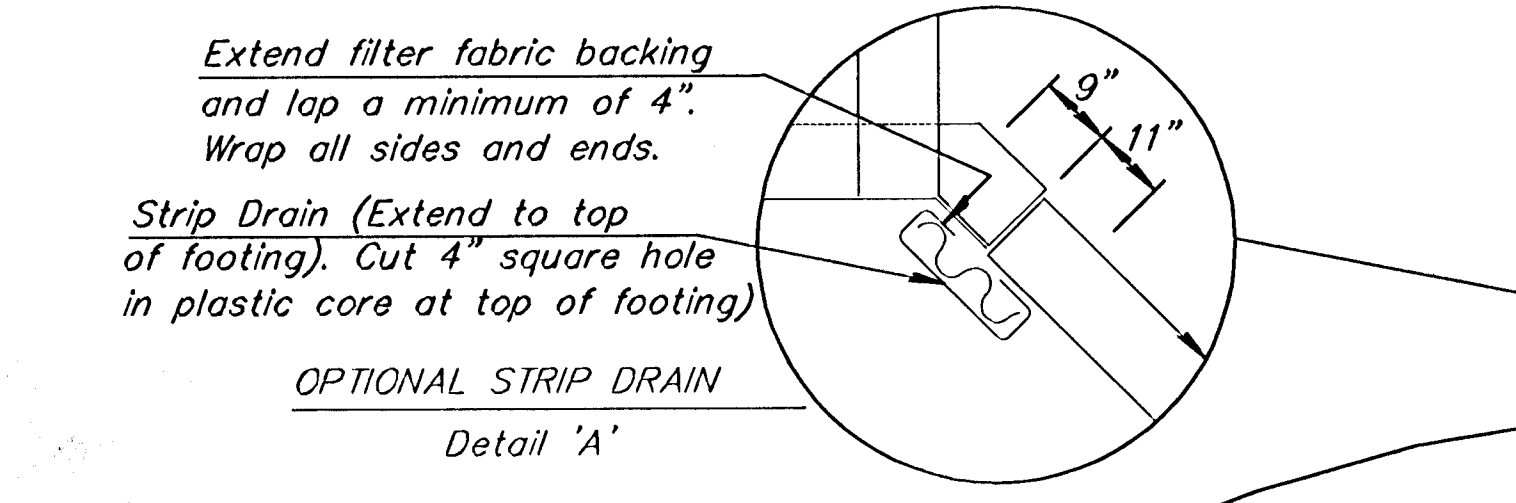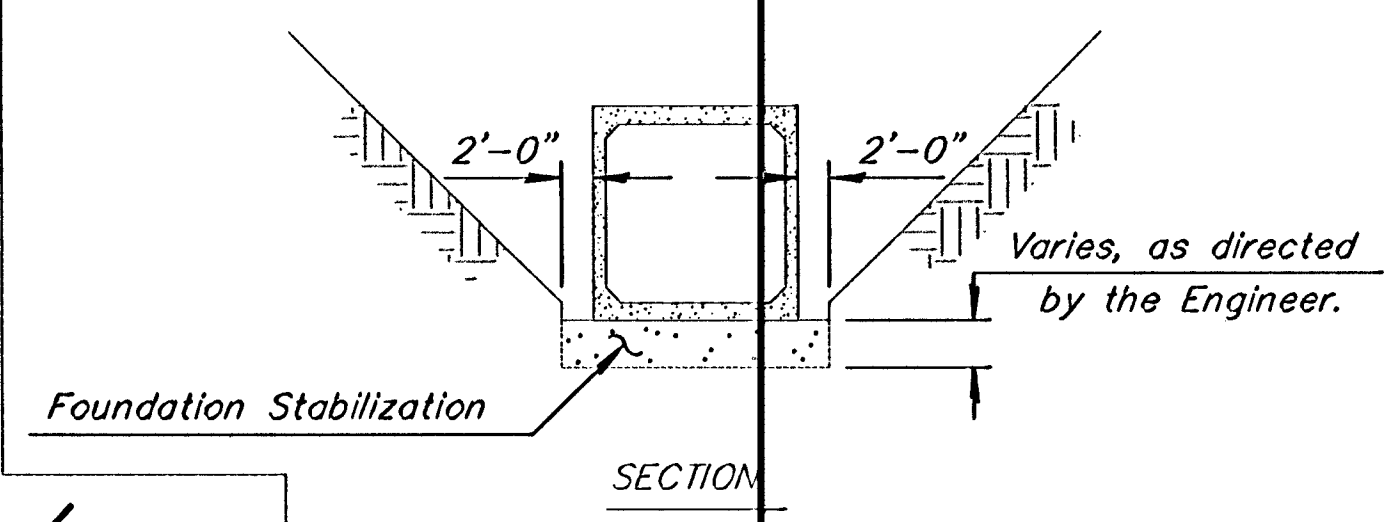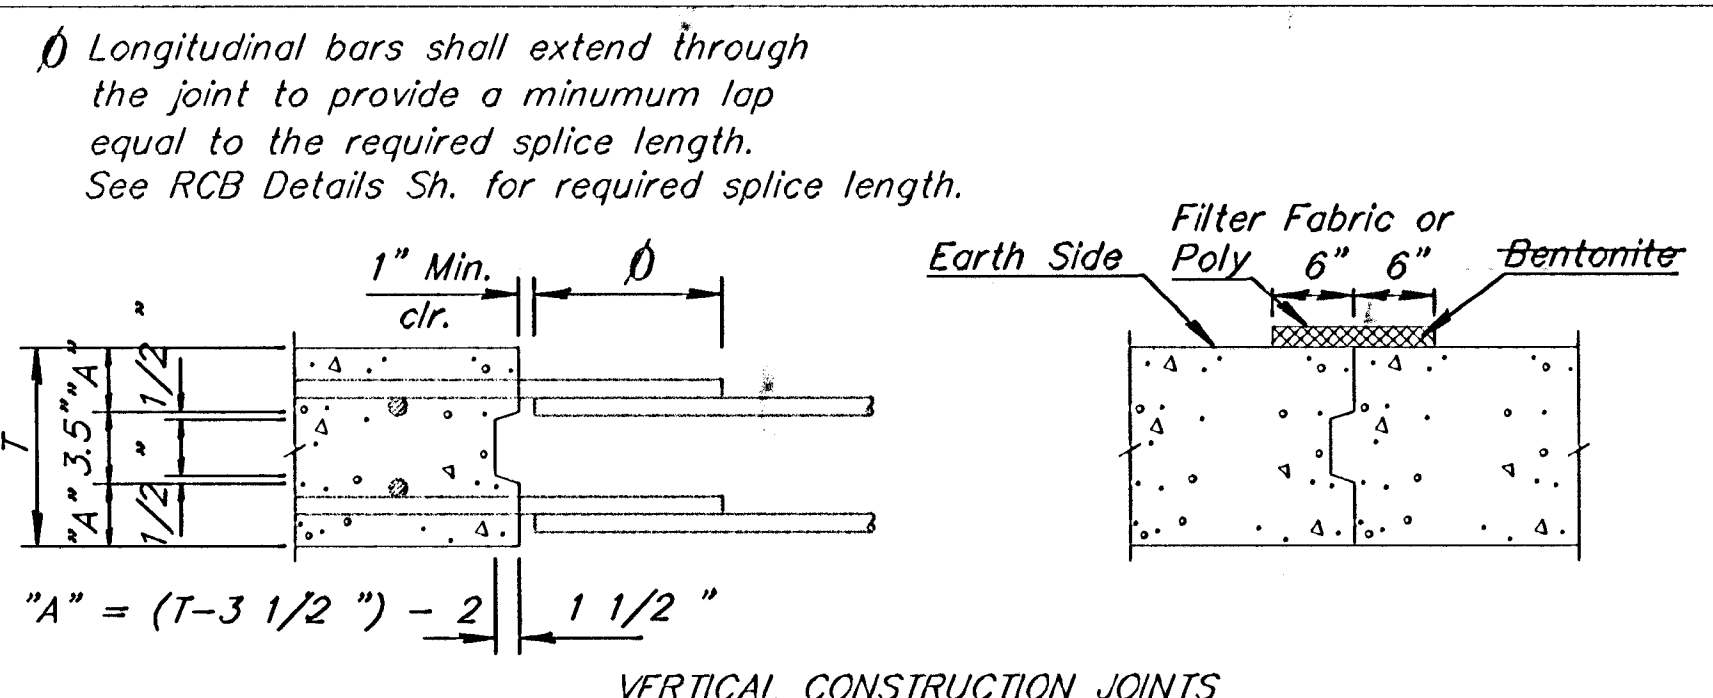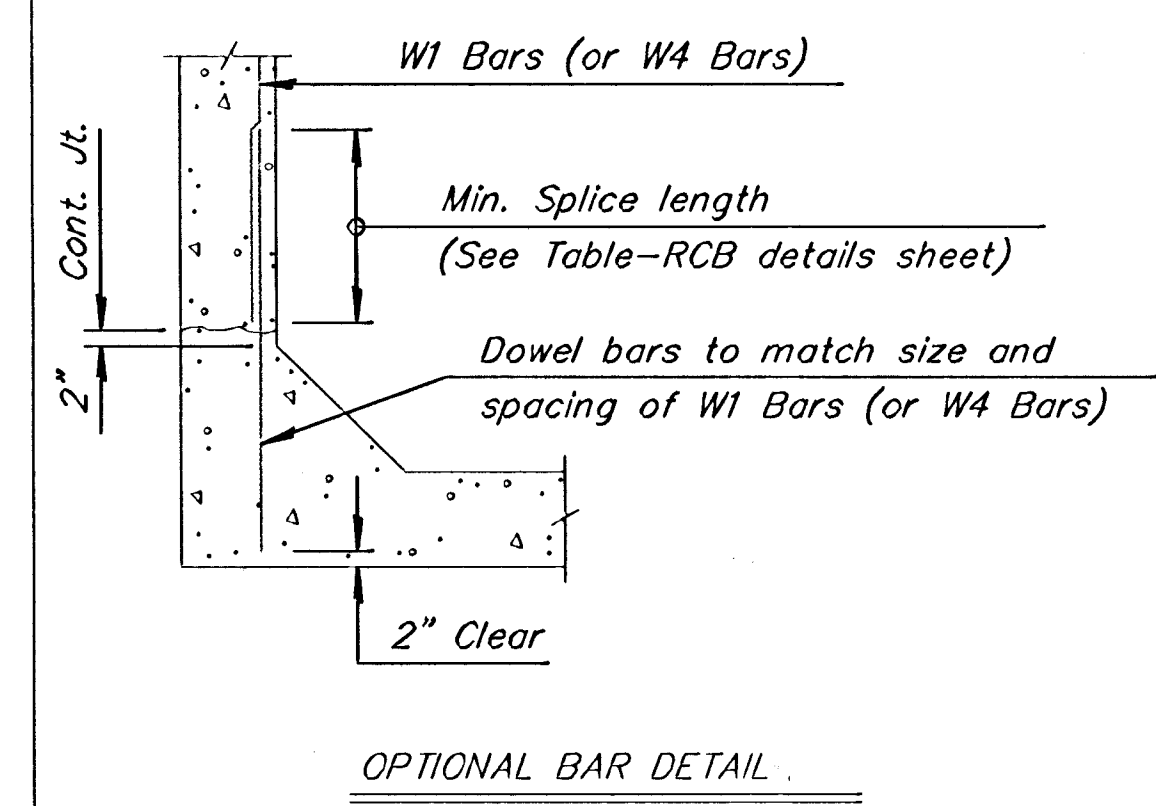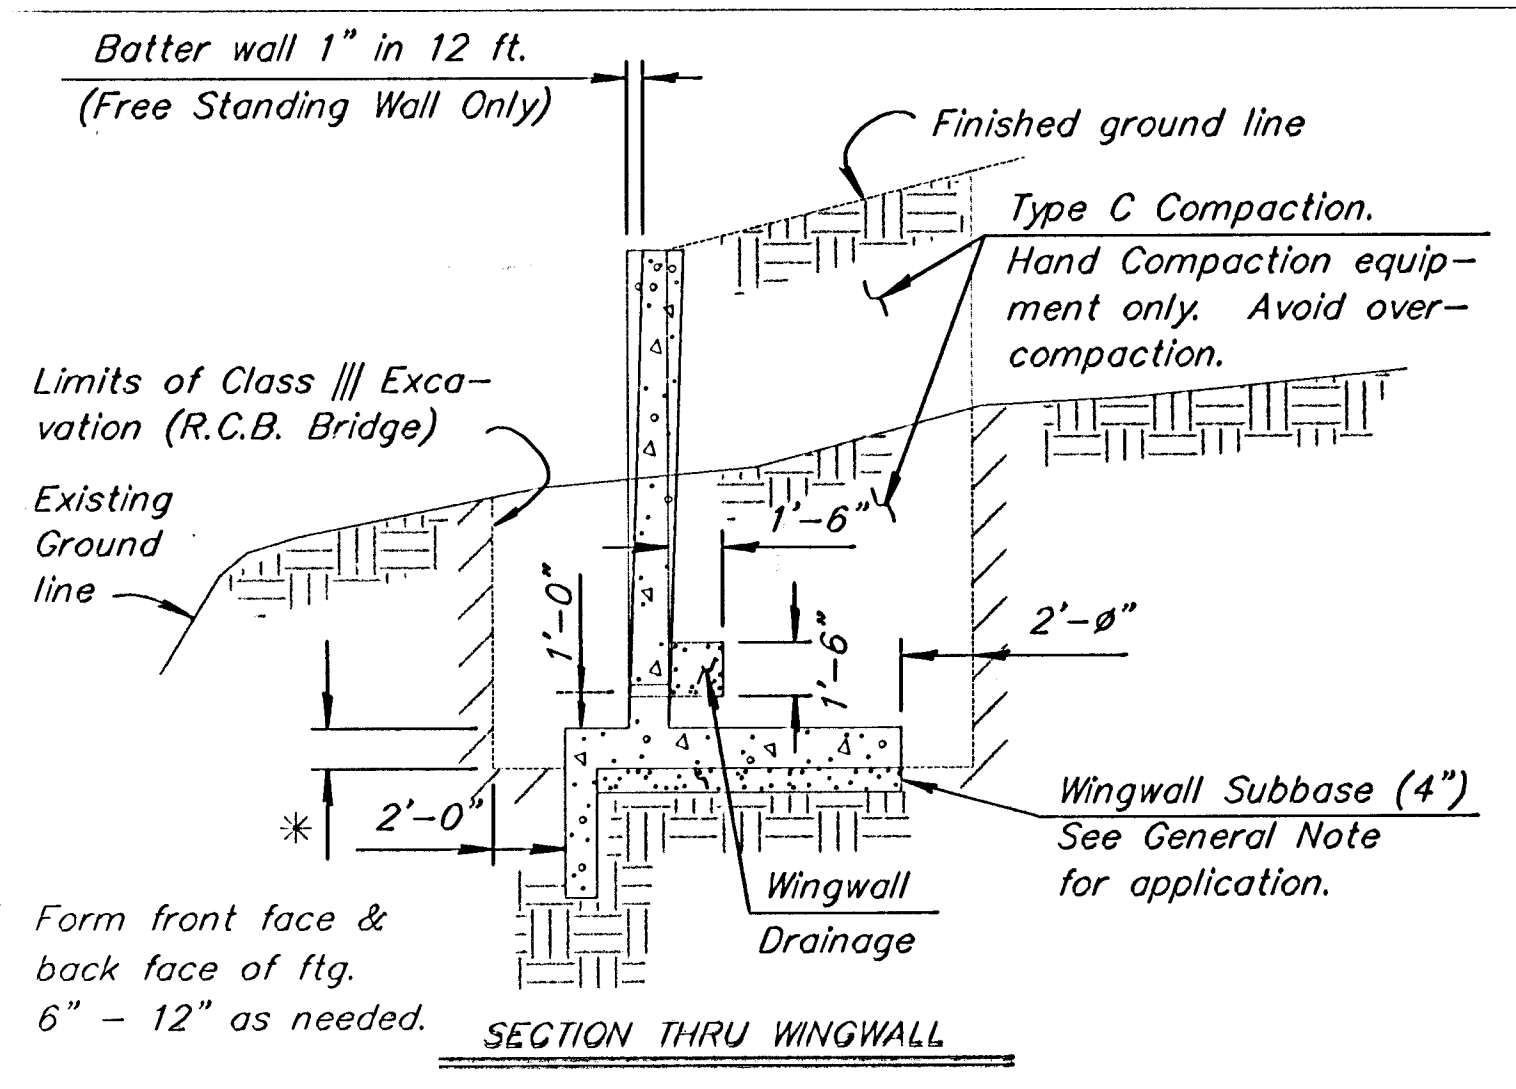

NO.	DATE	REVISIONS	BY	APP'D
3	3-28-97	Wrap granular drains	RAM	KFH
2	9-24-96	Strip drain & bentonite at joint	RAM	KFH
1	12-2-91	Change drainage details	RAM	KFH


KANSAS DEPARTMENT OF TRANSPORTATION

RCB AUXILIARY DETAILS

BR#24


FWH APPROVAL	3-31-97 APP'D	KENNETH F. HURST
DESIGN	RAM DE TAILLED	TRACED
DESIGN	RRR DETAIL CK.	RRR QUAN CK.

STATE	PROJECT NO.	YEAR	SHEET NO.	TOTAL SHEETS
KS	468-84253	2006	14	22

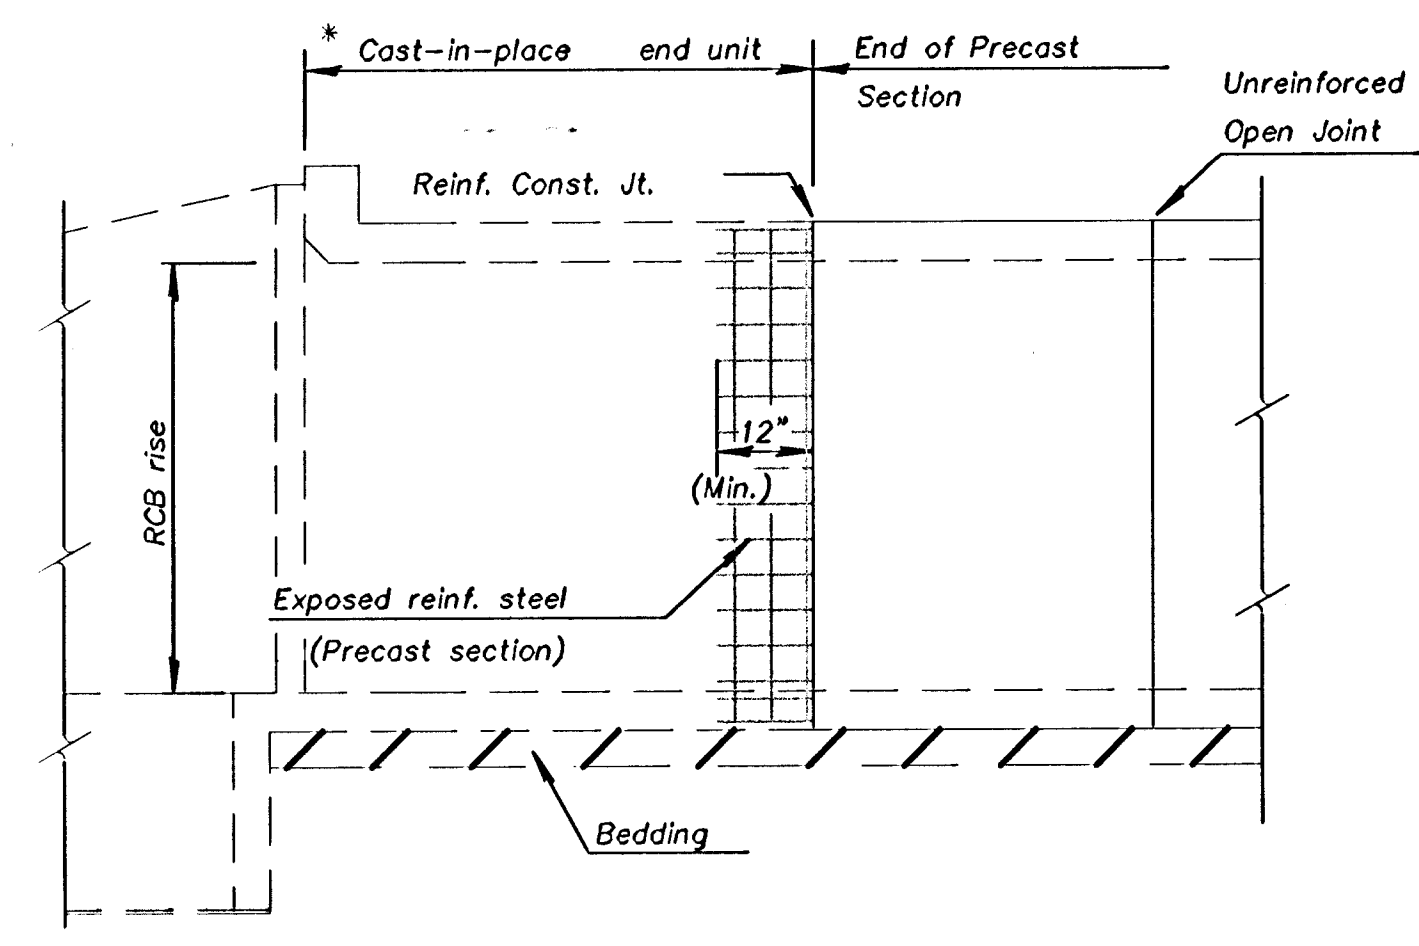


ELEVATION AT HEADWALL

* Minimum barrel length of cast-in-place end unit shall equal the RCB rise or 8'-0", whichever is less. This length can be used when the joint between the cast-in-place end unit and the precast section is reinforced as shown.

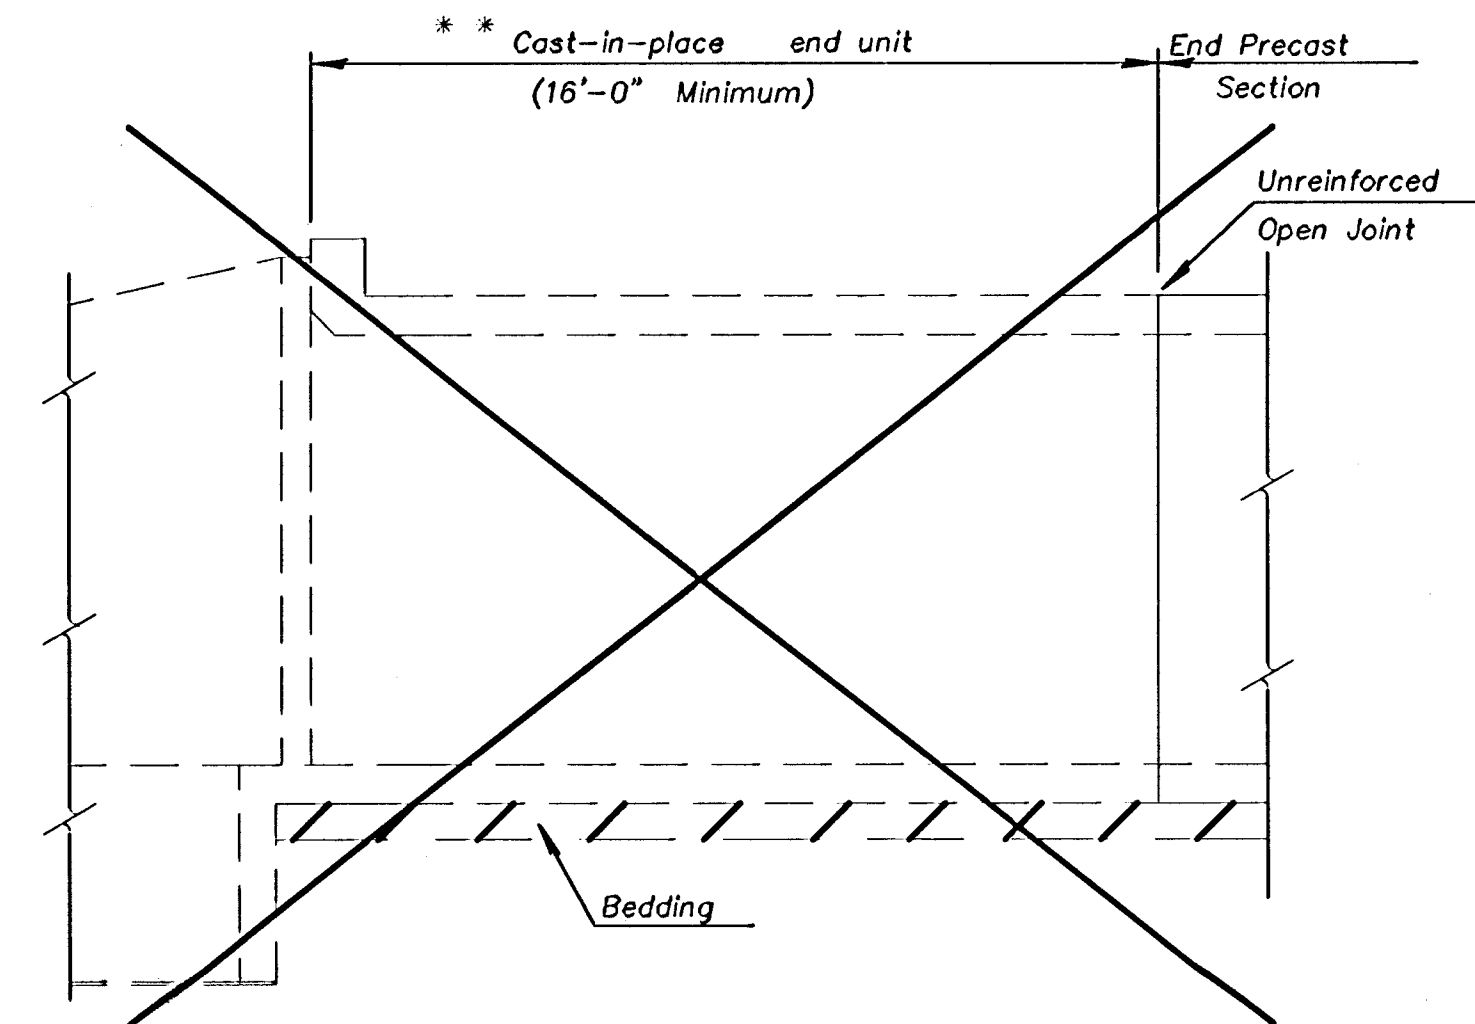

ELEVATION AT HEADWALL

** Minimum barrel length of cast-in-place end unit shall be 16'-0" when using an unreinforced open joint at the end of the precast section.

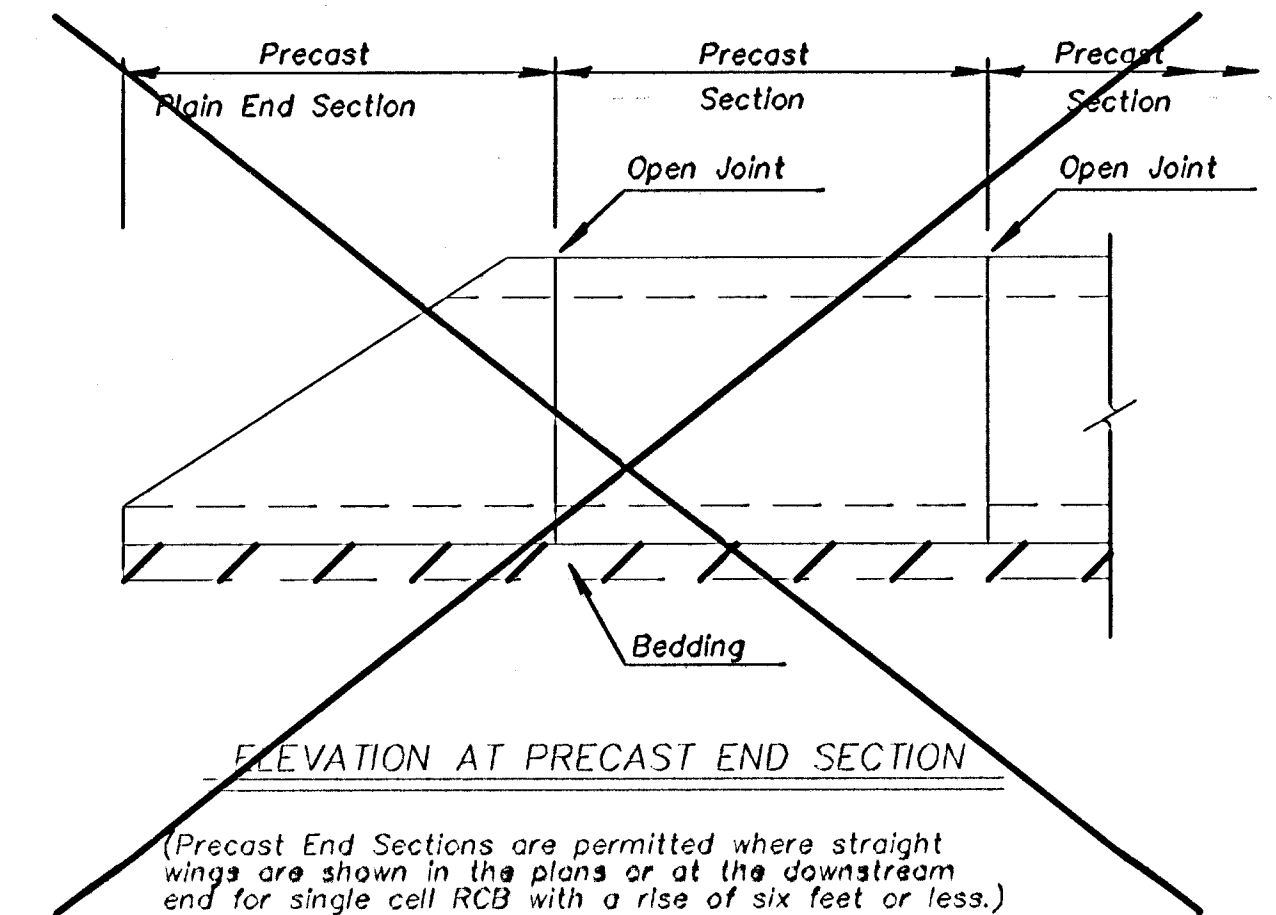

ELEVATION AT PRECAST END SECTION

(Precast End Sections are permitted where straight wings are shown in the plans or at the downstream end for single cell RCB with a rise of six feet or less.)


GENERAL NOTES

PRECAST BOX CULVERTS: If precast boxes are specified, construct them at the locations shown in the plans and according to the requirement shown on this sheet. When approved by the Engineer, precast box culverts may be used in lieu of cast-in-place box culverts. If the Contractor chooses the precast option, use the cast-in-place quantities as the cost basis. This cost includes all labor, equipment, material and incidentals necessary to complete the installation.


Cast-in-place concrete work shall conform to the requirements of the KDOT Specifications and KDOT's Guidelines for Structural Design and Detail of Reinforced Concrete Box Culverts. Use Class AAA concrete and Grade 60 reinforcing steel conforming to ASTM A615M for cast-in-place construction.

SPECIFICATIONS: Single-cell Precast Concrete Box Culverts shall conform to the requirements of the following specifications except as noted in the KDOT Specifications. Design multiple-cell precast boxes in accordance with the criteria used to develop the single-cell precast boxes. (See Appendix of ASTM Specification C 1433, Table 2 and the latest AASHTO Specifications.)

DISTRIBUTION SLAB: Fill heights less than 2 feet require a distribution slab. Precast distribution slabs may be used for fill heights over 1 foot, otherwise use cast-in-place.

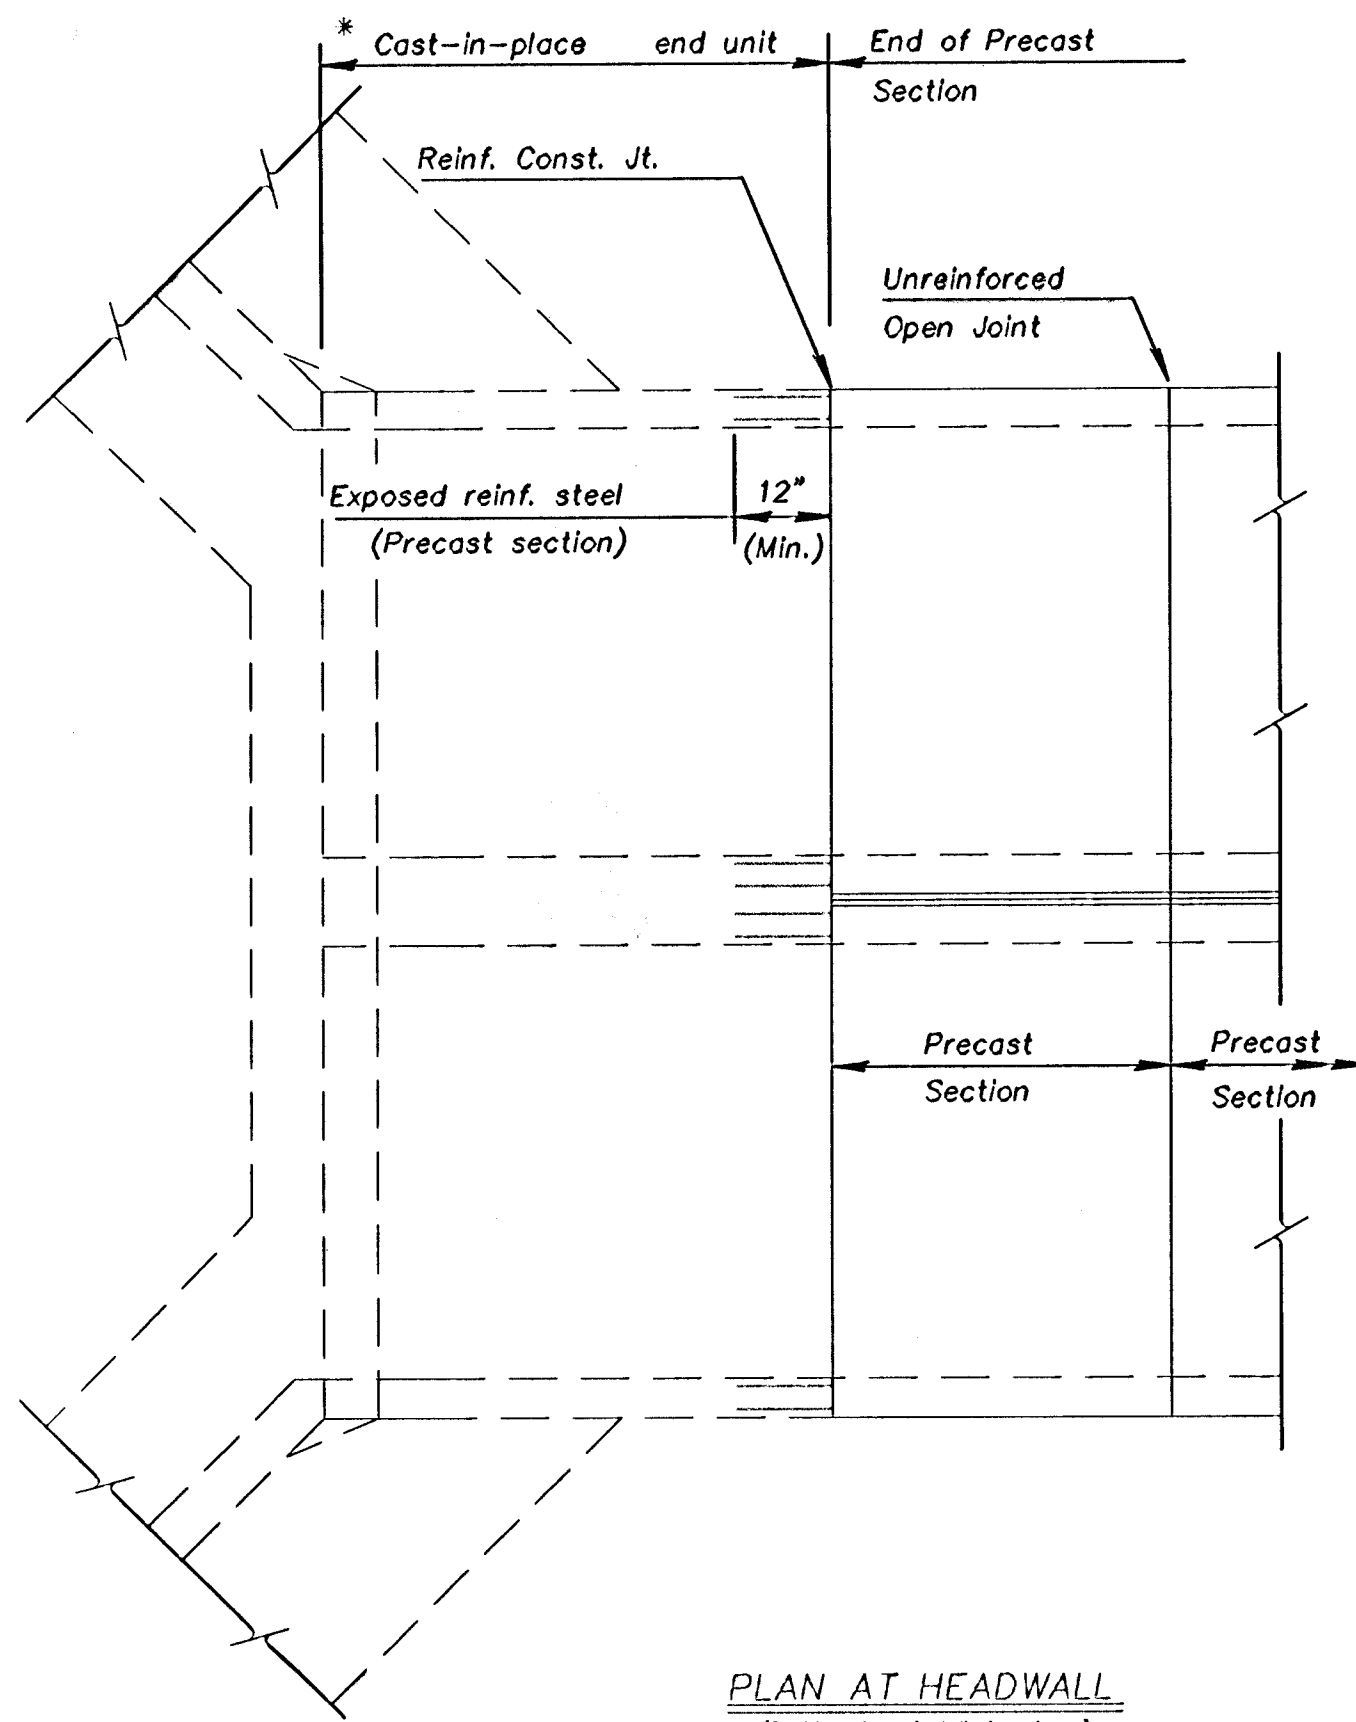


PLAN AT HEADWALL
(Double culvert installation shown)

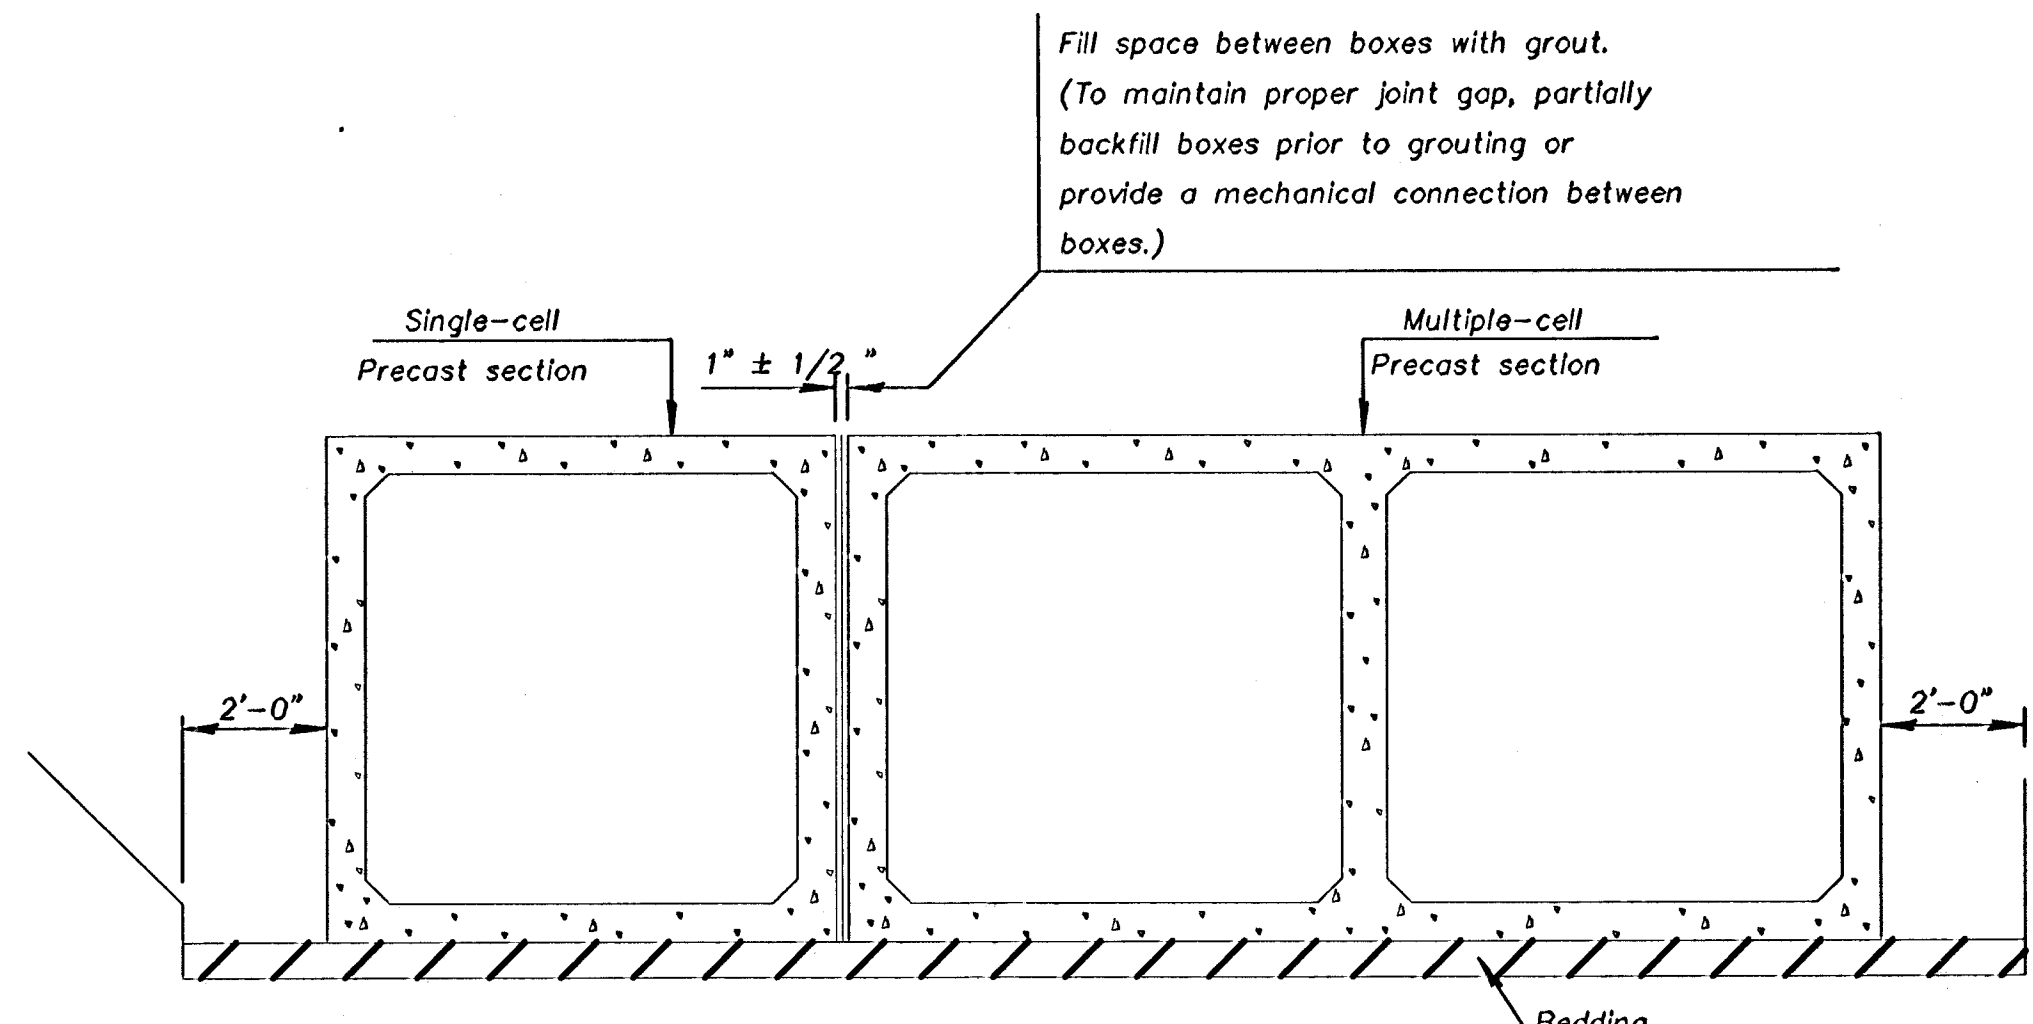

TYPICAL INSTALLATION DETAILS


Fill space between boxes with grout. (To maintain proper joint gap, partially backfill boxes prior to grouting or provide a mechanical connection between boxes.)

NOTE: Minimum length of precast section shall be 4'-0".

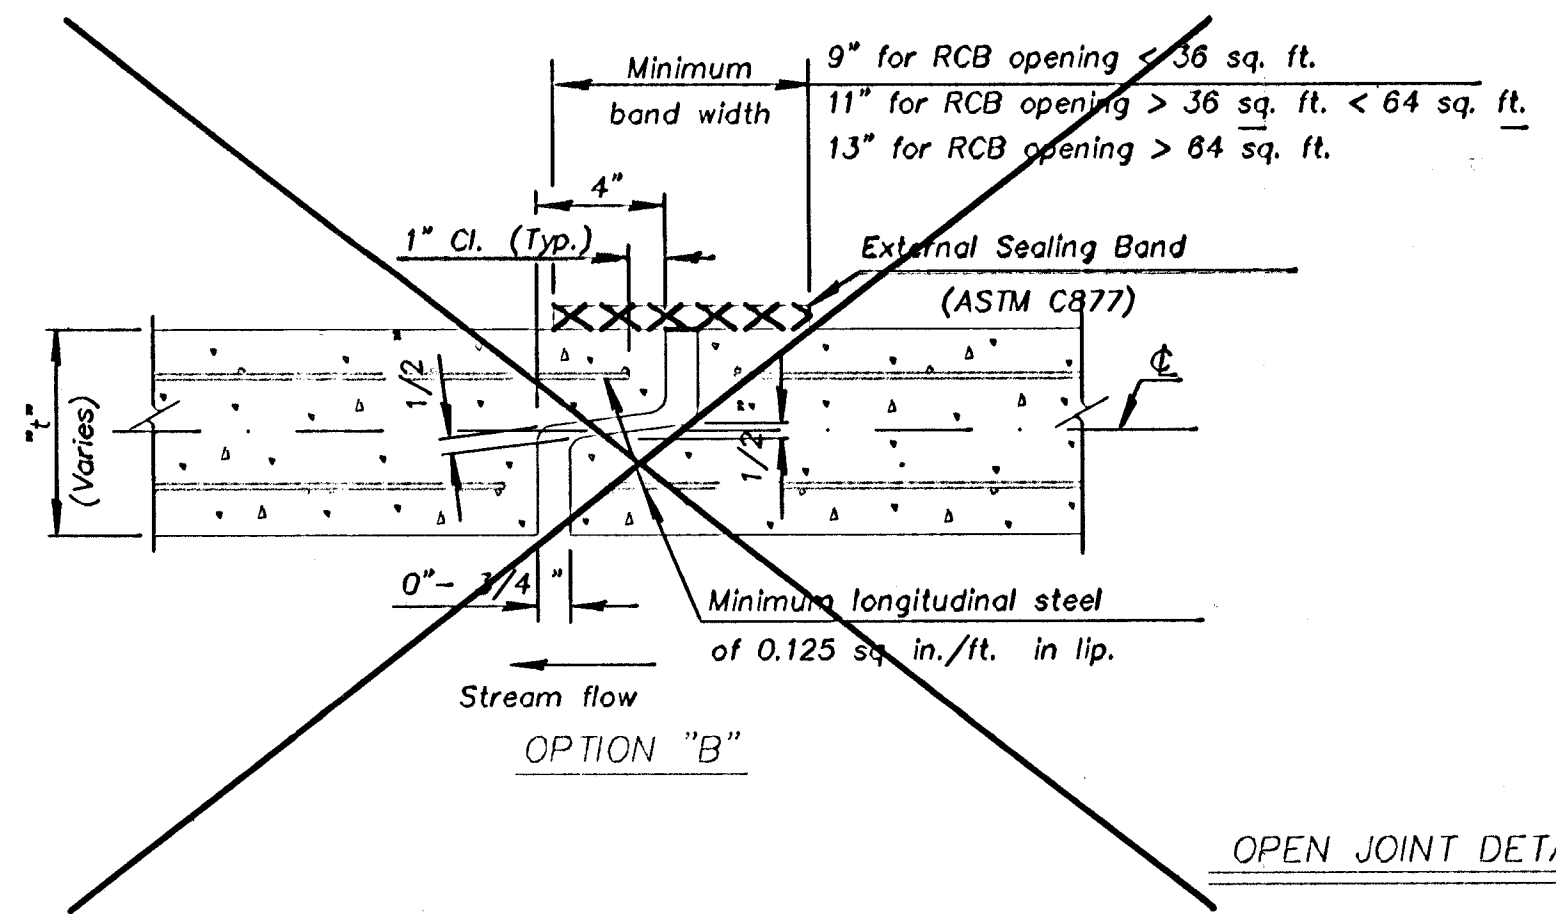


OPTION "B"

OPEN JOINT DETAIL

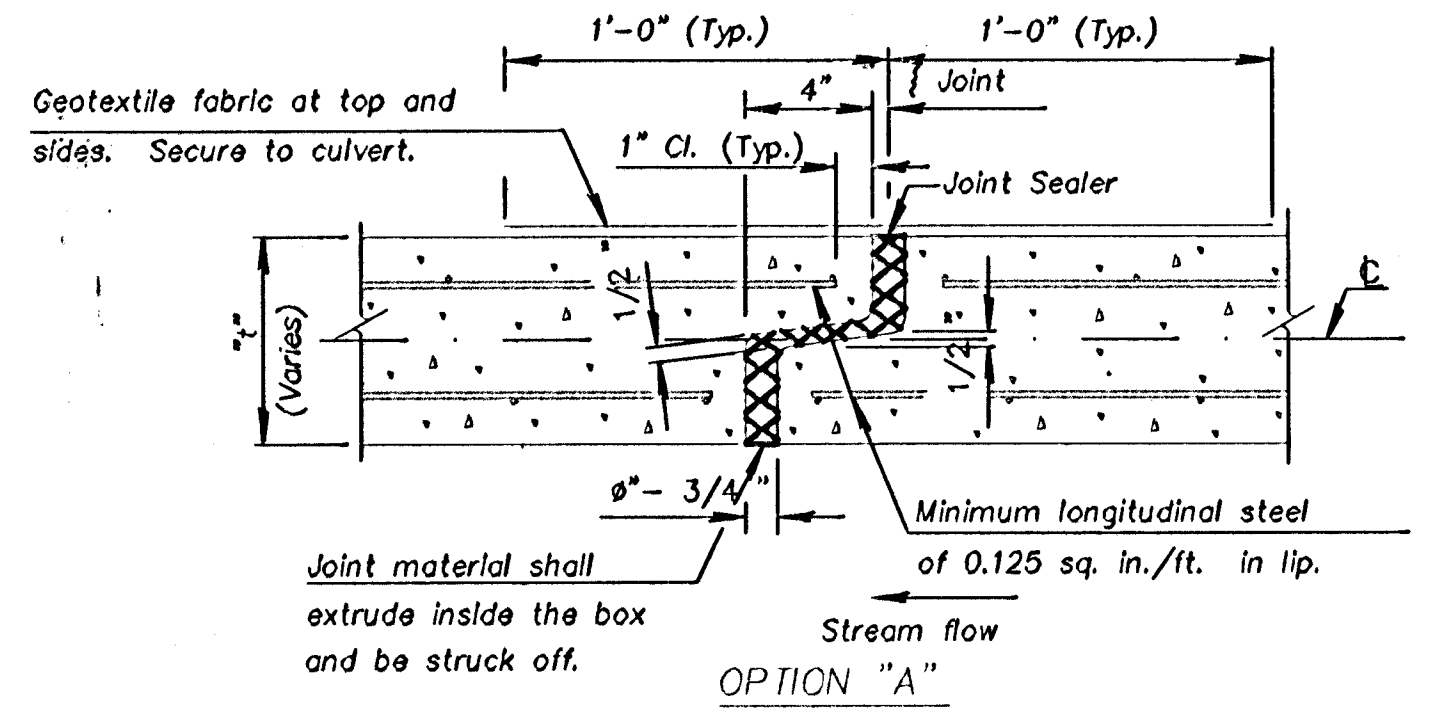

OPTION "A"

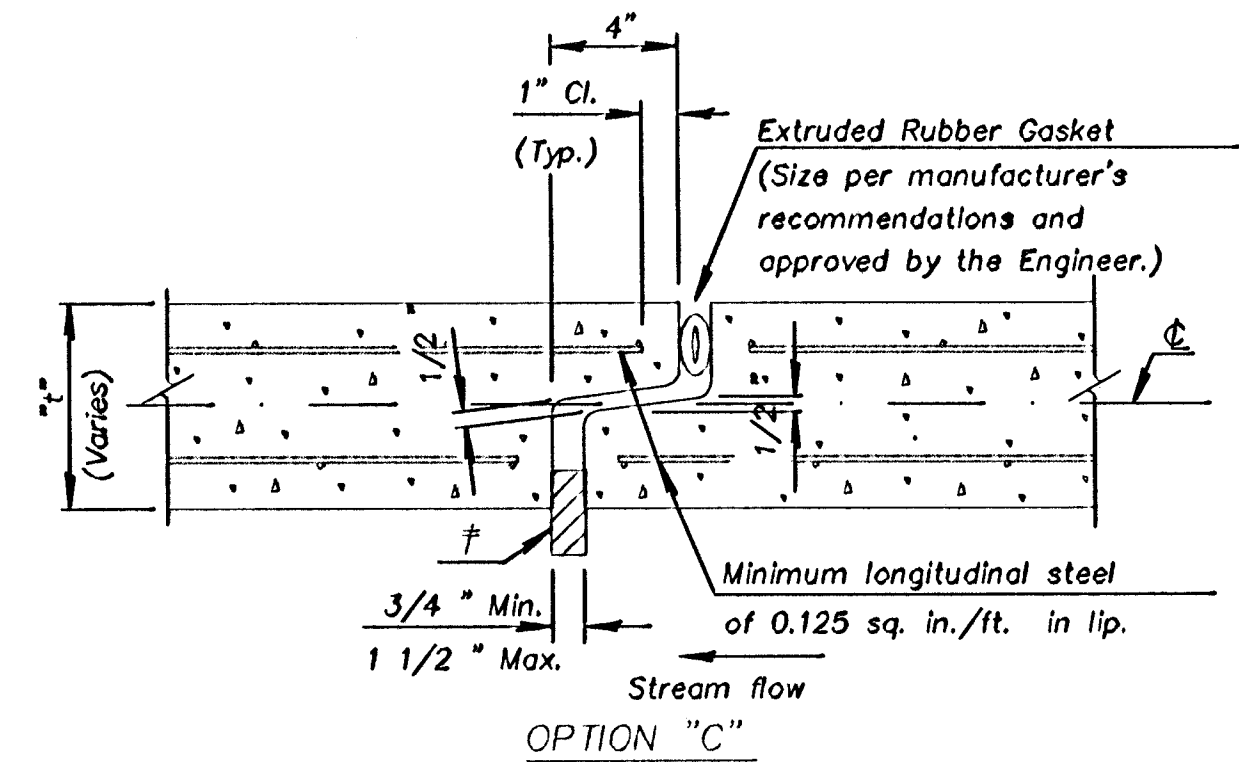

OPTION "C"

† Insert temporary, 3/4" x 1" wide, hardwood wedges to prevent over-compressing gasket.


REVISED 10/09/01

4	11-03-00	Revised ASTM / Added Note	RAM	KFH
3	12-20-96	Revised CIP end unit details.	RAM	KFH
2	1-17-95	Revised general notes	LRR	KFH
1	6-22-94	Added option 'C' & revised notes	RAM	KFH
ND.	DATE	REVISIONS	BY	APP'D


KANSAS DEPARTMENT OF TRANSPORTATION

PRECAST CONCRETE BOX CULVERT DETAILS

BR 031	11-27-00	APP'D	KENNETH F. HURS
DESIGN APPROVAL	DESIGNED	QUANTITIES	CADD
DESIGN CK.	DETAIL CK.	RAMUAN CK.	CADD CK.

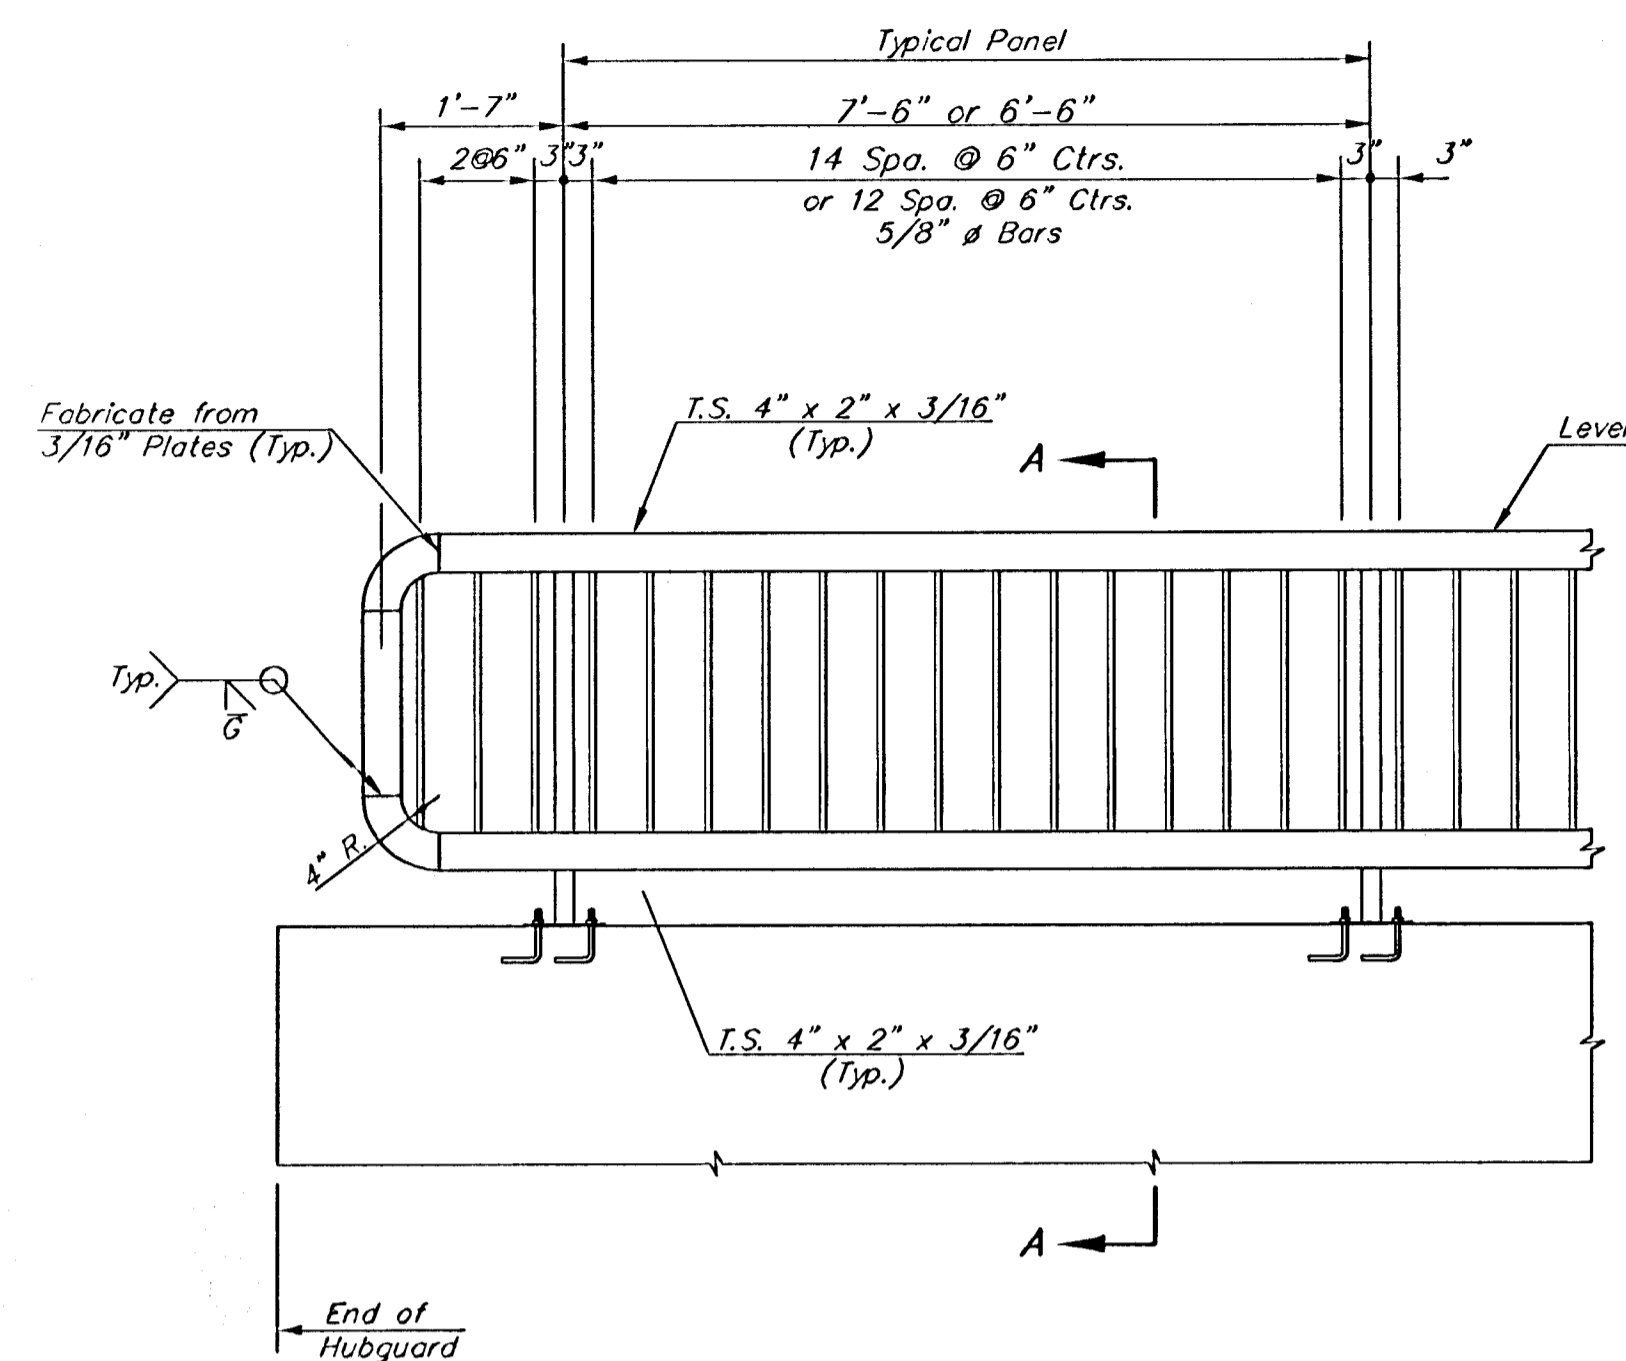


HANDRAIL ELEVATION

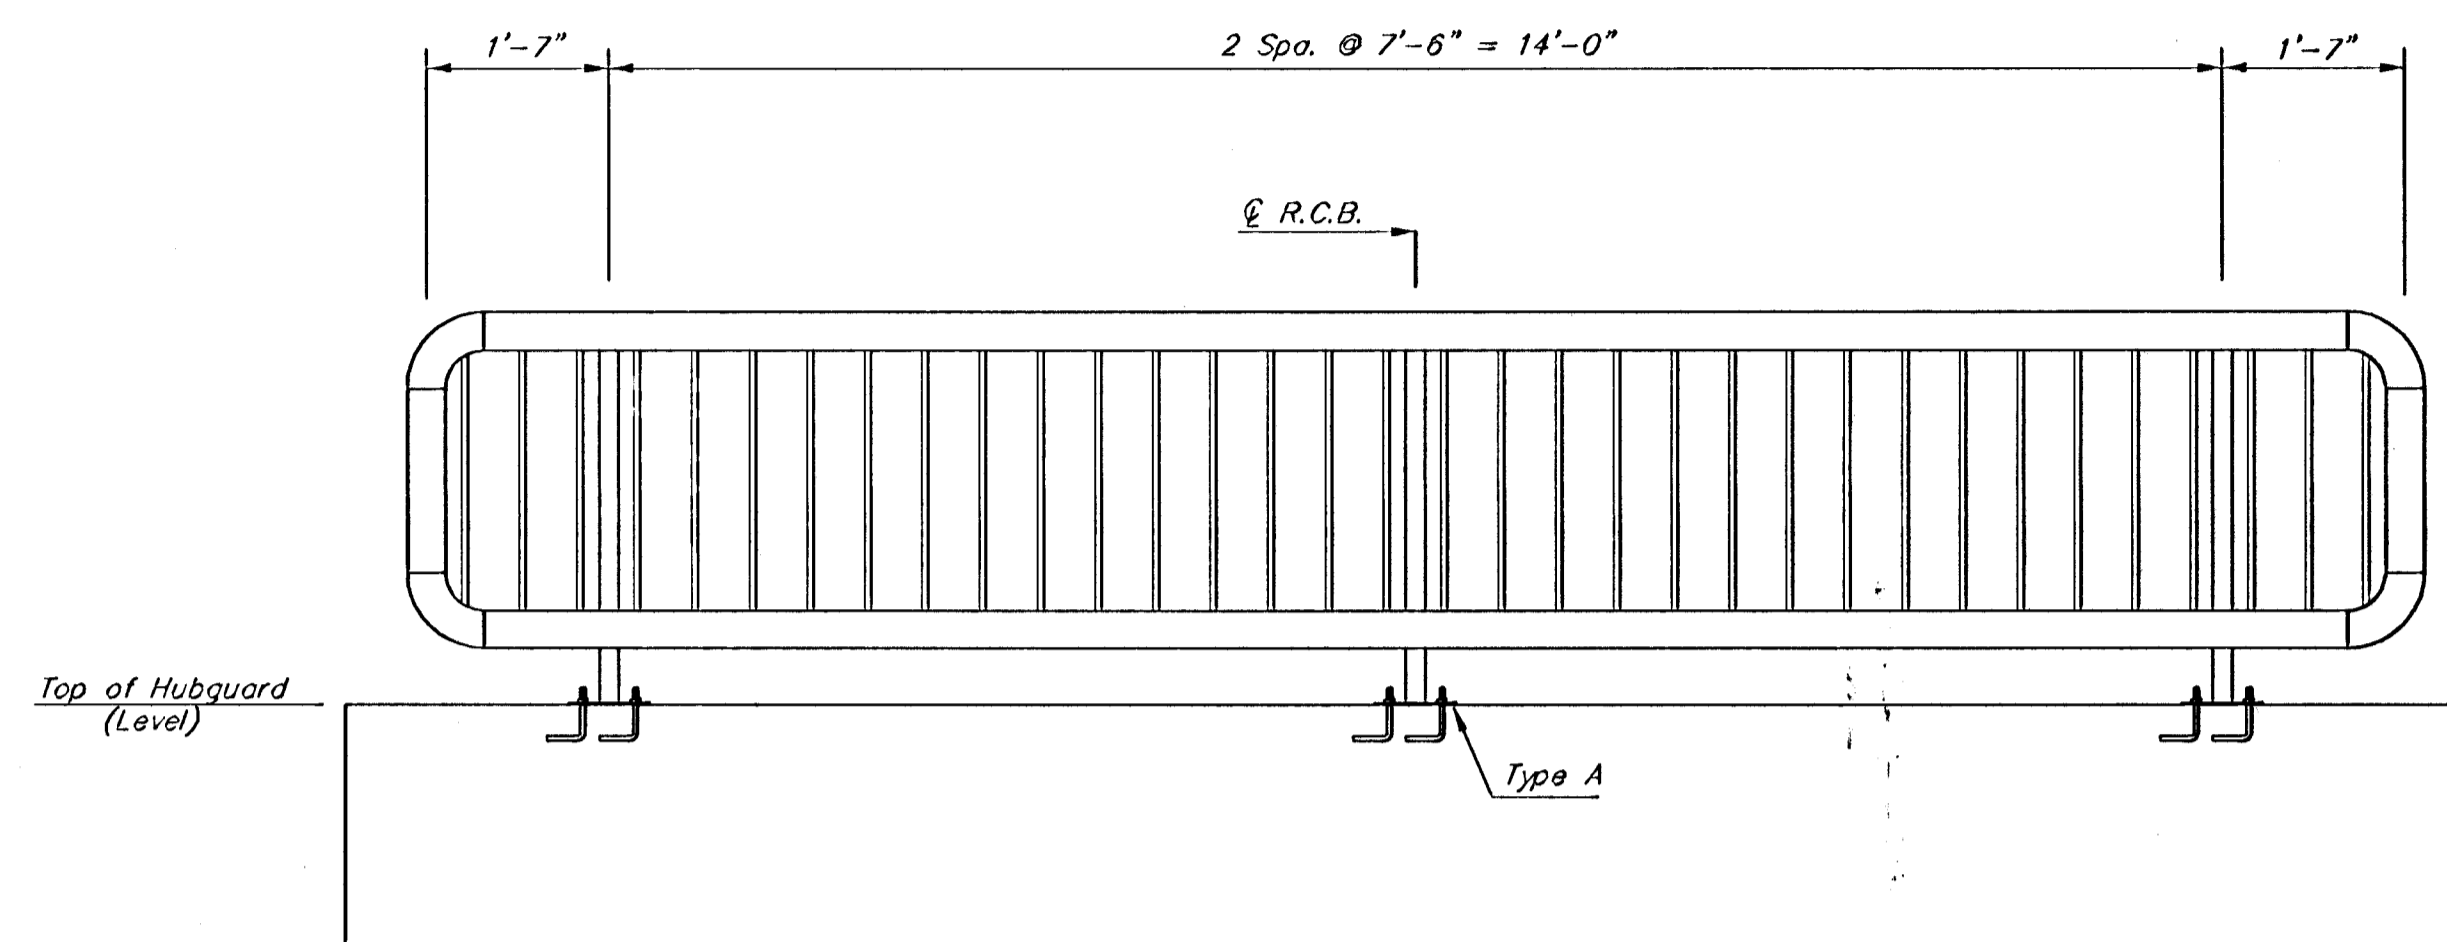


HUBGUARD SECTION

(2 Required)

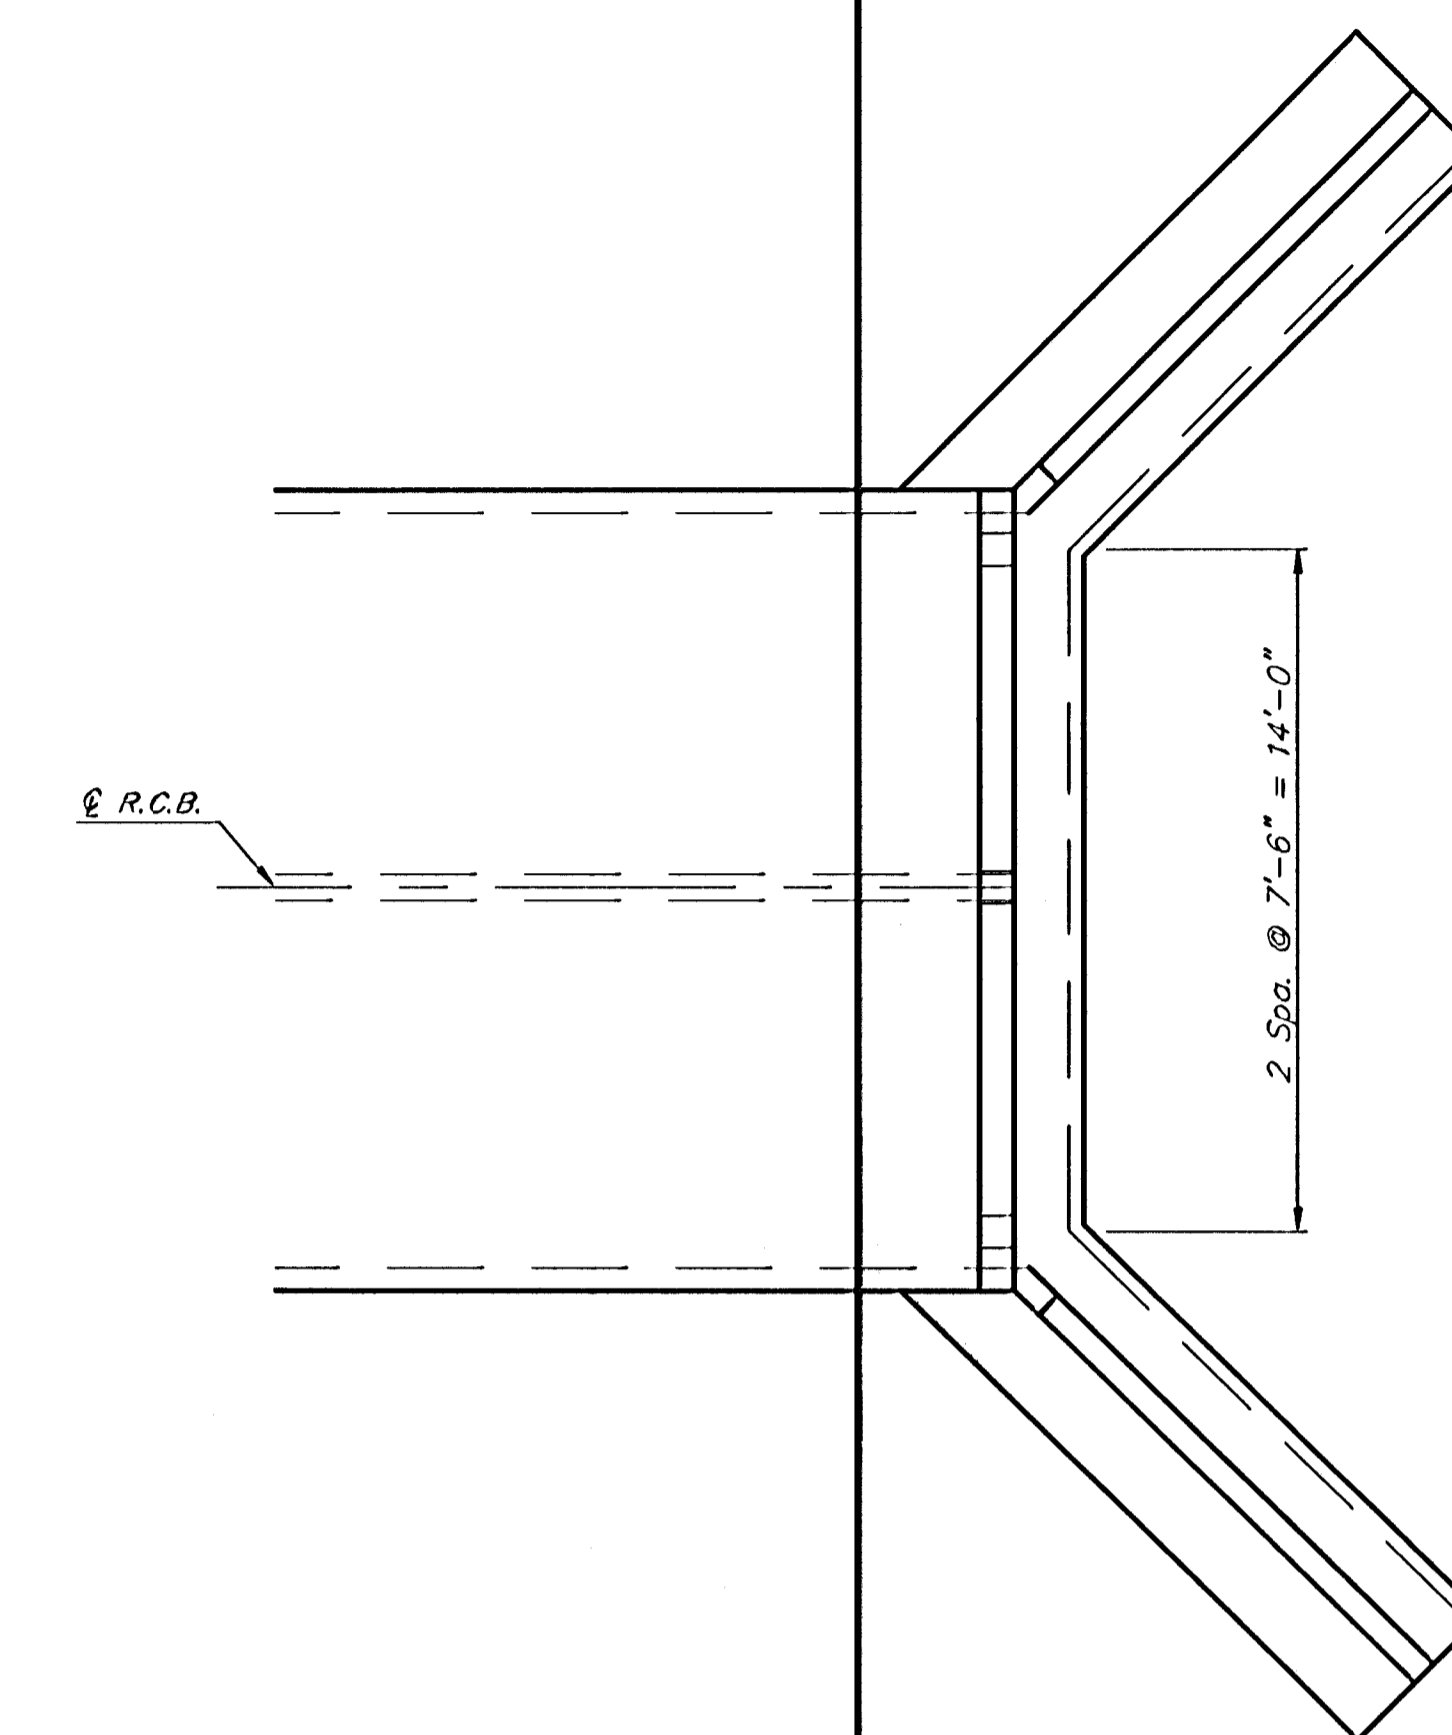


RAIL LOCATION PLAN

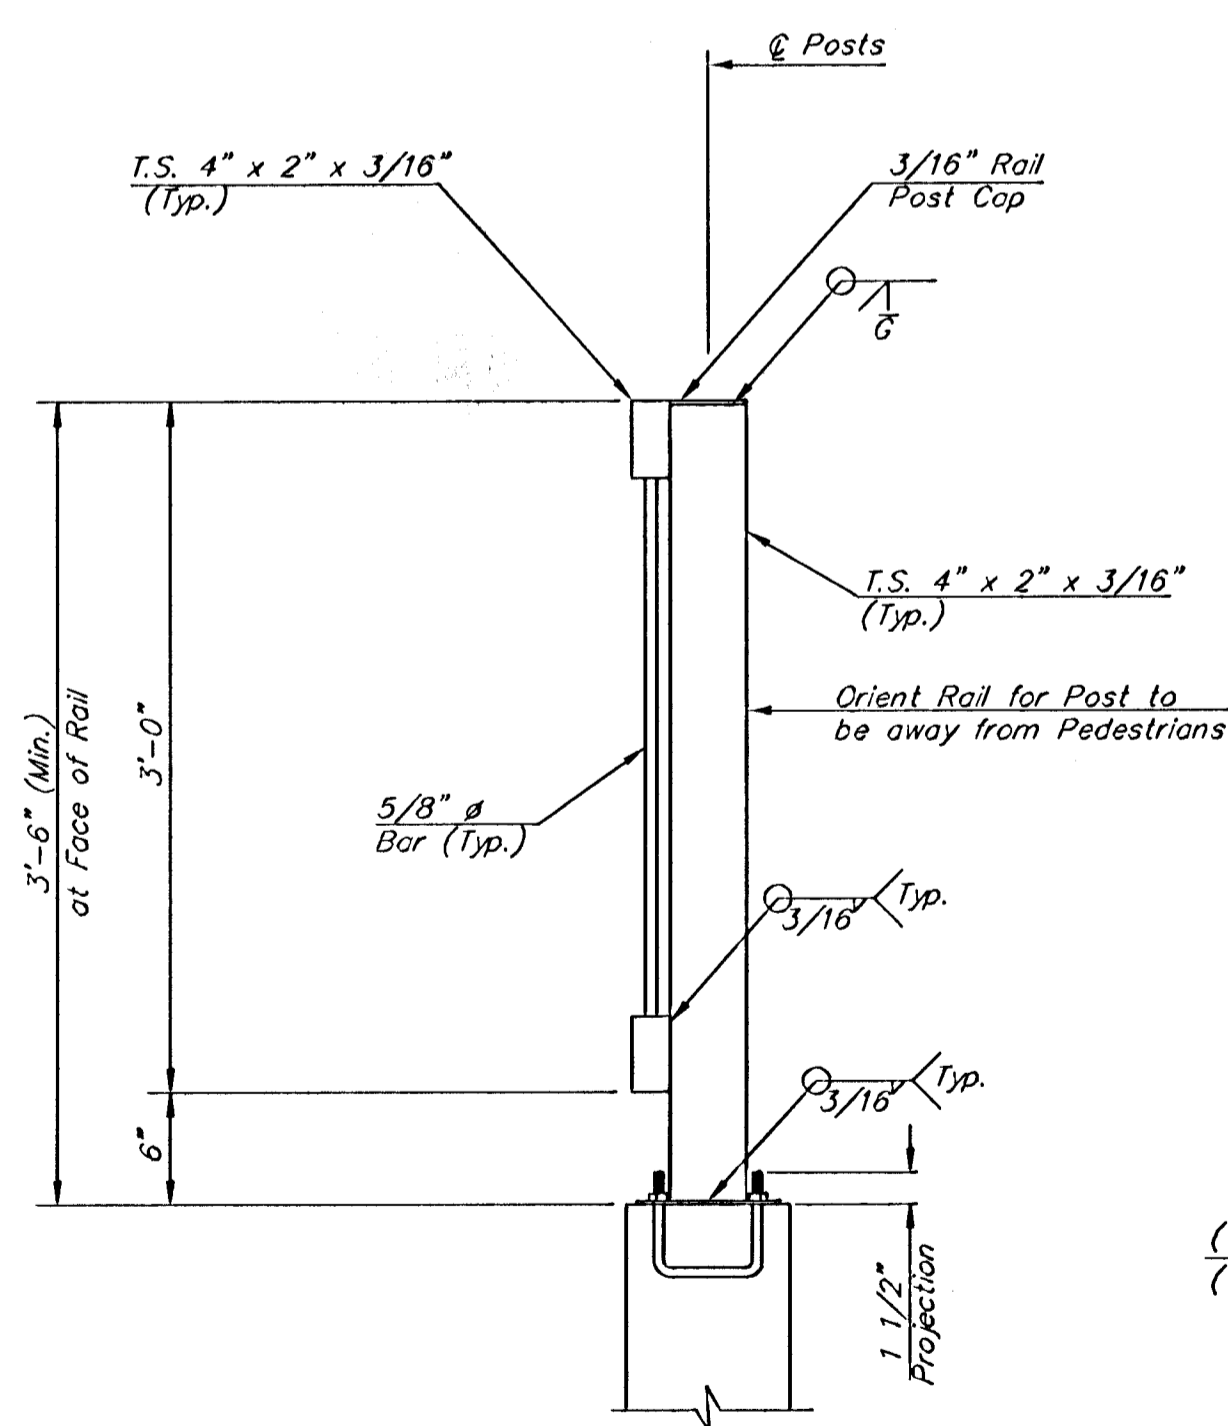


SECTION A-A

Note:
Rail Post on Hubguard shown,
Rail Posts on Wingwalls not shown
but similar controlling criteria.

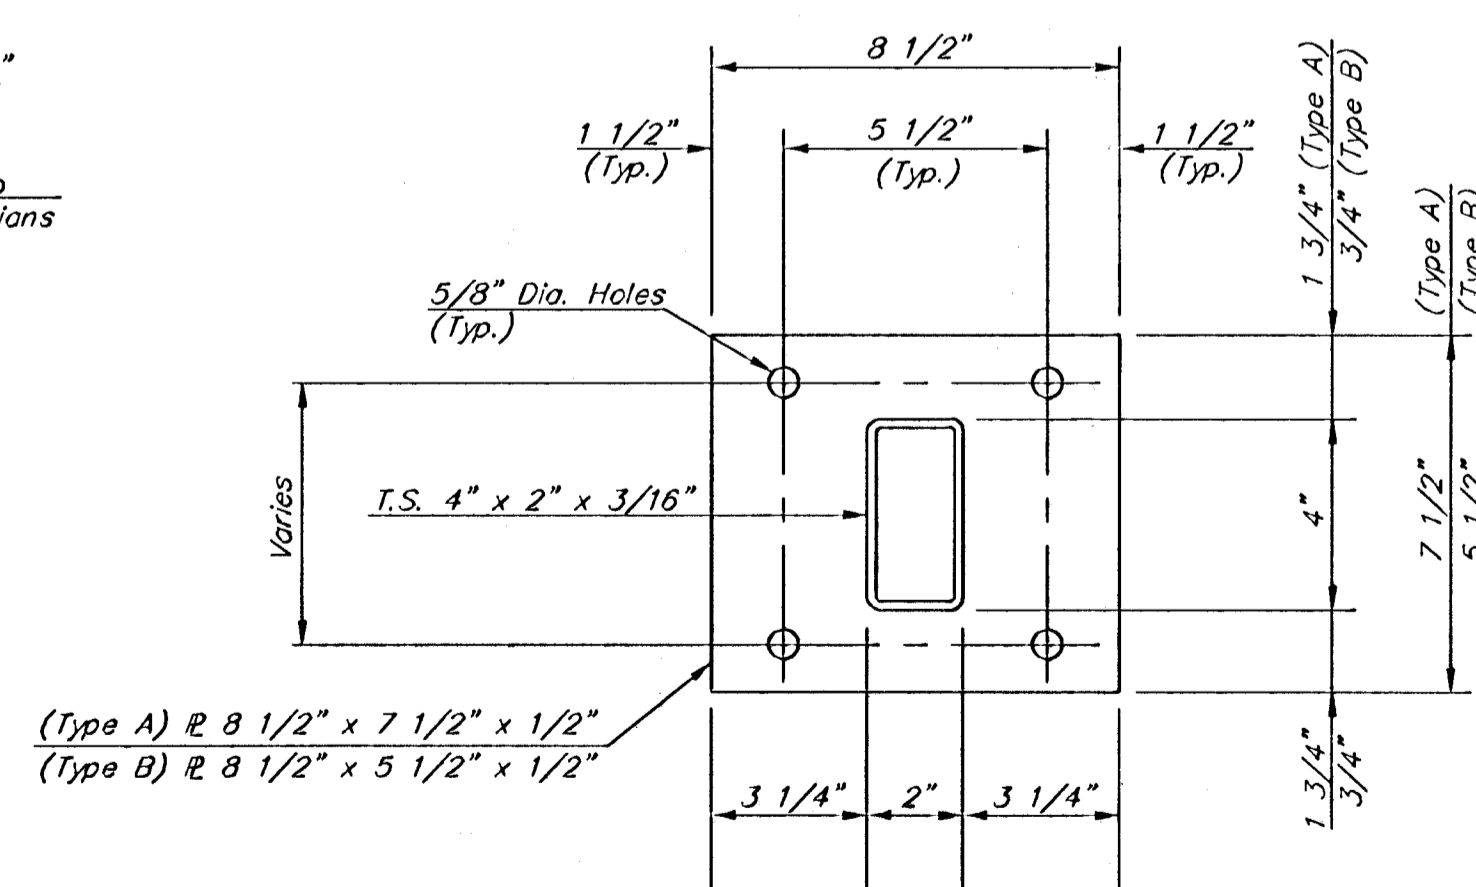

BASE PLATE

5 Required (Type A)
8 Required (Type B)

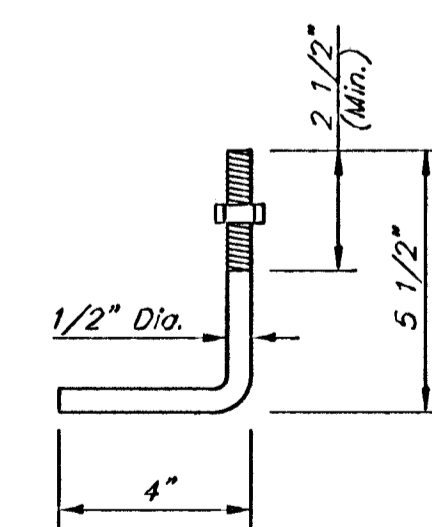

ANCHOR BOLT

Galvanized (ATSM A153)
(May Substitute expandable anchor bolts
when approved by the Engineer)

Orient to provide min. 2\"/>

BASIS OF PAYMENT

All labor, Materials, Anchor Bolts, Fabrication, Installation, and Ect. Necessary to Place the Handrails as shown shall be incidental to Lump Sum Bid Item "RCBC."

GENERAL NOTES

The horizontal members of the rail and posts shall be hollow structural tubing. All structural steel and tubing shall comply to A.S.T.M. Designation A36 or A500 Grade B respectively.

Rail shall be fabricated in lengths as shown.

Posts and bars shall be set vertical and shimmed if required.

The paint system shall be provided by Carboline: 350 Hanley Industrial Ct., St. Louis, MO. The application will be in accordance with the manufacturers recommendations. The paint procedure is as follows:

1. Abrasive blast to commercial finish SSPC-SP6 to obtain a surface profile of 1-1/2 mils.
2. Apply 2 coats of Carboline GP 818 Primer (2 to 4 mils per coat).
3. Apply one topcoat of Subsil 30 HS (2 to 3 Mil) (Color: Carboline C900). An approved substitution of the total paint system will be allowed with the approval of the Engineer.


Material and construction shall conform to the Structural Welding Code A.W.S. D1.1-00.

Shop details must be submitted and approved by the Engineer.

The Handrail Shall be Painted Black & a Test Piece Shall Be Supplied To the Engineer Prior To Cons. For Its Approval.

		Northgate Offsite Drainage	
		Handrail Details	
Baughman Company, P.A. 315 Ellis St. Wichita, KS 67111 P316262-7711 F316262-0149 ENGINEERING SURVEYING PLANNING LANDSCAPE ARCHITECTURE		DESIGN	DRAWN
PROJECT NUMBER	468-84253	AEG	RDM
REVISIONS		APPROVED	DATE
		AEG	3-14-07
		SCALE	None
		SHEET	15 OF 22

NOTE: Point A must be higher than Point B so that water flows over the bales and not around them.

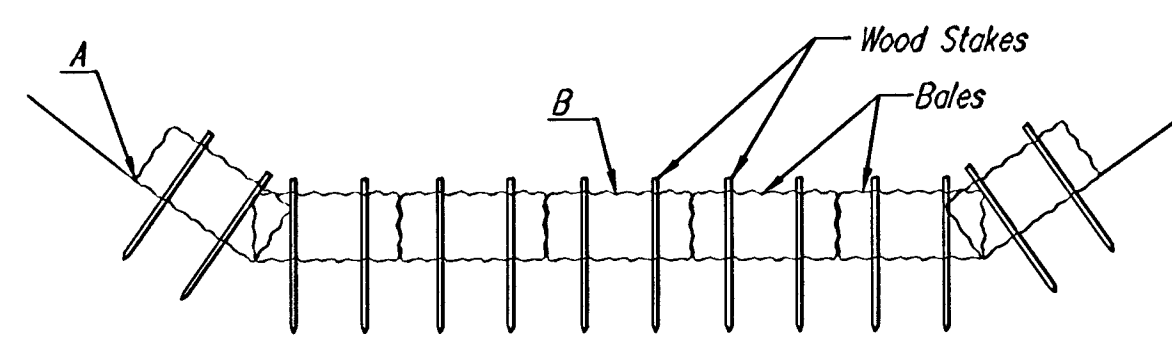

STRAW BALE DITCH CHECKS

Material Specification:

Bale ditch checks may be constructed of wheat straw, oat straw, prairie hay, or bromegrass hay that is free of weeds declared noxious by the Kansas State Board of Agriculture. The stakes used to anchor the bales should be a hardwood material with the following minimum dimensions: 2" square (nominal) by 4' long. Optional: The downstream scour apron should be constructed of a double-netted straw erosion-control blanket at least 6' wide. Optional: The metal landscape staples used to anchor the erosion-control blanket should be at least 8" long.

Placement:

Bale ditch checks should be placed perpendicular to the flowline of the ditch. The ditch check should extend far enough so that the ground level at the ends of the check is higher than the top of the lowest center bale. This prevents water from flowing around the check. Straw bale ditch checks should not be placed in ditches where high flows are expected. Rock checks should be used instead. Bales should be placed in ditches with slopes of 6% or less. For slopes steeper than 6%, rock checks should be used. The following table provides check spacing for a given ditch grade:

Ditch grade (%)	Ditch Check Spacing (feet)
0.5	200
1.0	200
2.0	100
3.0	65
4.0	50
5.0	40
6.0	30

Proper installation method:

Excavate a trench perpendicular to the ditch flowline that is 4" deep and a bale's width wide. Extend the trench in a straight line along the entire length of the proposed ditch check. Place the soil on the upstream side of the trench—it will be used later. Optional: On the downstream side of the trench, roll out a length of erosion-control blanket (scour apron) equal to the length of the trench. Place the upstream edge of the erosion-control blanket along the bottom upstream edge of the trench. The erosion control blanket should be anchored in the trench with one row of 8" landscape staples placed on 18" centers. The remainder of the erosion-control blanket (the portion that is not lying in the trench) will serve as the downstream scour apron. This section of the blanket should be anchored to the ground with 8" landscape staples placed around the perimeter of the blanket on 18" centers. The remainder of the blanket should be anchored using two evenly spaced rows of 8" landscape staples on 18" centers placed perpendicular to the flowline of the ditch. Place the bales in the trench, making sure that they are butted tightly. Two stakes should be driven through each bale along the centerline of the ditch check, approximately 6" to 8" in from the bale ends. Stakes should be driven at least 12" into the ground. Once all the bales have been installed and anchored, place the excavated soil against the upstream side of the check and compact it. The compacted soil should be no more than 3" to 4" deep and extend upstream no more than 24".


List of common placement/installation mistakes to avoid:

- Do not place a bale ditch check directly in front of a culvert outlet. It will not stand up to the concentrated flow.
- Do not place bale ditch checks in ditches that will likely experience high flows. They will not stand up to concentrated flow.
- Follow prescribed ditch-check spacing guidelines. If spacing guidelines are exceeded, erosion will occur between the ditch checks.
- Do not allow water to flow around the ditch check. Make sure that the ditch check is long enough so that the ground level at the ends of the check is higher than the top of the lowest center bale.
- Do not place bale ditch checks in channels with shallow soils underlain by rock. If the check is not anchored sufficiently, it will wash out.
- Bale ditch checks must be dug into the ground. Bales at ground level do not work because they allow water to flow under the check.


Inspection and Maintenance:

Bale ditch checks should be inspected every 7 days and within 24 hours of a rainfall of 1/2" or more. The following is a list of questions that should be addressed during each inspection:

- Does water flow around the ditch check?
- Does water flow under the ditch check?
- Does water flow through spaces between abutting bales?
- Are any bales and/or scour aprons (optional) dislodged?
- Are bales decomposing due to age and/or water damage?
- Does sediment need to be removed from behind the ditch check?

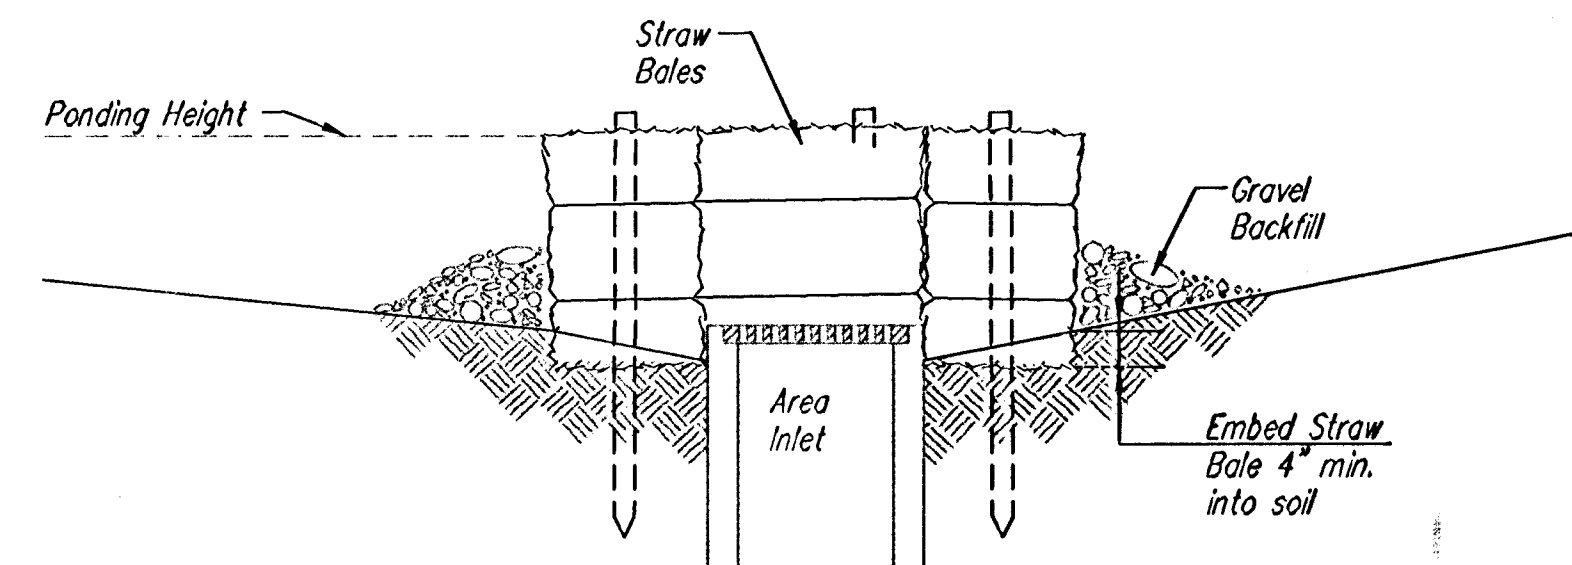

SECTION A-A

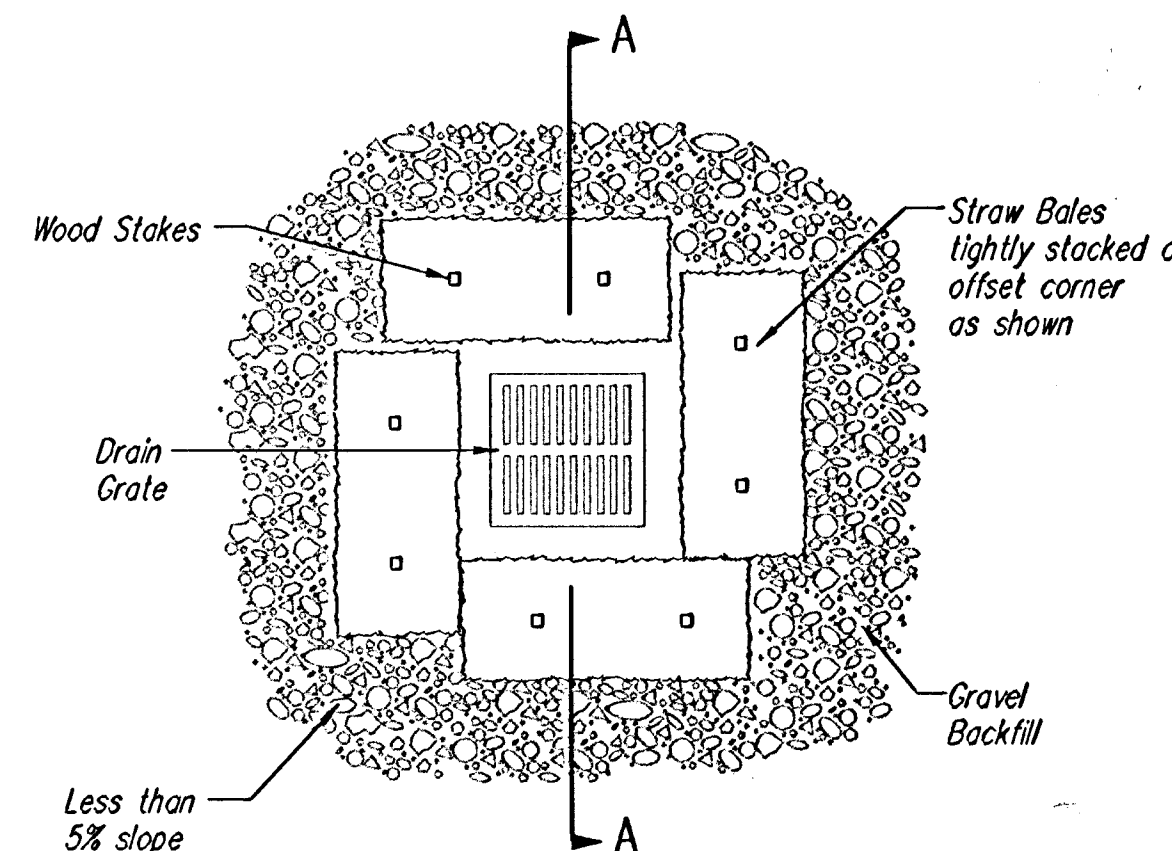

STRAW BALE BARRIERS FOR AREA INLETS (INLET PROTECTION)

Material Specification:

Bale area inlet barriers should be constructed of wheat straw, oat straw, prairie hay, or bromegrass hay that is free of weeds declared noxious by the Kansas State Board of Agriculture. The stakes used to anchor the bales should be a hardwood material with the following minimum dimensions: 2" square (nominal) by 4' long. Twine should be used to bind bales. The use of wire binding is prohibited because it does not biodegrade readily.

Placement:

Bale area inlet barriers should be placed directly around the perimeter of a drop inlet. When a bale area inlet barrier is located near an inlet that has steep approach slopes, the storage capacity behind the barrier is drastically reduced. Timely removal of sediment must occur for a barrier to operate properly in this location.

Proper Installation Method:

Excavate a trench around the perimeter of the area inlet that is at least 4" deep by a bale's width wide. Place the bales in the trench, making sure that they are butted tightly. Some bales may need to be shortened to fit into the trench around the area inlet. Two stakes should be driven through each bale, approximately 6" to 8" in from the bale ends. Stakes should be driven at least 12" into the ground. Once all the bales have been installed and anchored, place the excavated soil against the receiving side of the barrier and compact it. The compacted soil should be no more than 3" to 4" deep. Note: When a bale area inlet barrier is placed in a shallow median ditch, make sure that the top of the barrier is not higher than the paved road. In this configuration, water may spread onto the roadway causing a hazardous condition.


List of common placement/installation mistakes to avoid:

- Bales should be placed directly against the perimeter of the area inlet. This allows overtopping water to flow directly into the inlet instead of onto nearby soil causing scour.
- Bale area inlet barriers must be dug into the ground. Bales at ground level do not work because they allow water to flow under the barrier.

Inspection and Maintenance:

Bale area inlet barriers should be inspected every 7 days and within 24 hours of a rainfall of 1/2" or more. The following is a list of questions that should be addressed during each inspection:

- Does water flow under the area inlet barrier?
- Does water flow through spaces between abutting bales?
- Are any bales dislodged?
- Are bales decomposing due to age and/or water damage?
- Does sediment need to be removed from behind the area inlet barrier?

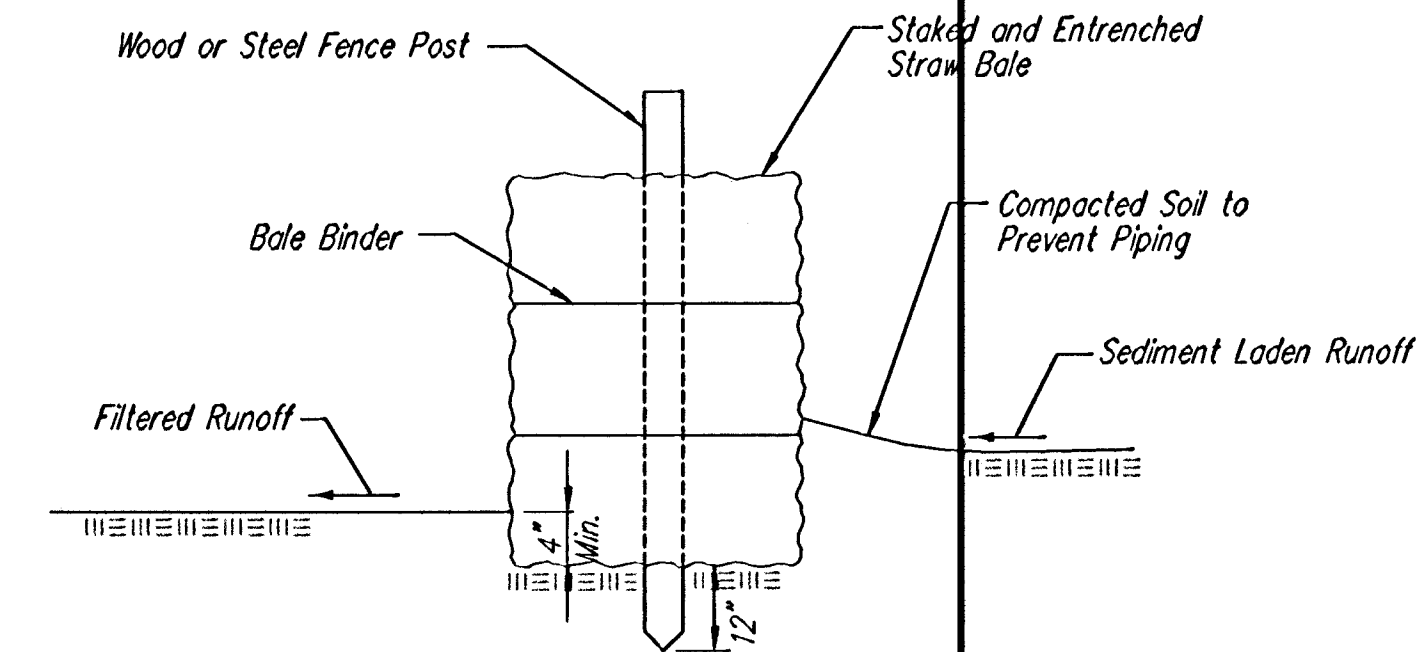

STRAW BALE BARRIERS

Material Specification:

Bale slope barriers may be constructed of wheat straw, oat straw, prairie hay, or bromegrass hay that is free of weeds declared noxious by the Kansas State Board of Agriculture. The stakes used to anchor the bales should be a hardwood material with the following minimum dimensions: 2" square (nominal) by 4' long. Twine should be used to bind bales. The use of wire binding is prohibited because it does not biodegrade readily.

Placement:

A slope barrier should be used at the toe of a slope when a ditch does not exist. The slope barrier should be placed on nearly level ground 5' to 10' away from the toe of a slope. The barrier is placed away from the toe of the slope to provide adequate storage for settling out sediment. When practicable, bale slope barriers should be placed along contours to avoid a concentration of flow. Bale slope barriers can also be placed along right-of-way fence lines to keep sediment from crossing onto adjacent property. When placed in this manner, the slope barrier will not likely follow contours.

Proper installation method:

Excavate a trench the length of the planned slope barrier that is 4" deep and a bale's width wide. Make sure that the trench is excavated along a single contour. When practicable, slope barriers should be placed along contours to avoid a concentration of flow. Place the soil on the upslope side of the trench for later use. Place the bales in the trench, making sure that they are butted tightly. Two stakes should be driven through each bale along the centerline of the ditch check, approximately 6" to 8" in from the bale ends. Stakes should be driven at least 12" into the ground. Once all the bales have been installed and anchored, place the excavated soil against the upslope side of the check and compact it. The compacted soil should be no more than 3" to 4" deep.

List of common placement/installation mistakes to avoid:

- When practical, do not place bale slope barriers across contours. Slope barriers should be placed along contours to avoid a concentration of flow. Concentrated flow over a slope barrier creates a scour hole on the downslope side of the barrier. The scour hole eventually undermines the bales and the barrier fails.
- Do not place bale slope barriers in areas with shallow soils underlain by rock. If the barrier is not anchored sufficiently, it will wash out.
- Bale slope barriers must be dug into the ground. Bales at ground level do not work because they allow water to flow under the barrier.

Inspection and Maintenance:

Bale slope barriers should be inspected every 7 days and within 24 hours of a rainfall of 1/2" or more. The following is a list of questions that should be addressed during each inspection:


- Are there any points along the slope barrier where water is concentrating?
- Does water flow under the slope barrier?
- Does water flow through spaces between abutting bales?
- Are any bales dislodged?
- Are bales decomposing due to age and/or water damage?
- Does sediment need to be removed from behind the slope barrier?

SOIL EROSION BMPs

STRAW BALE DITCH CHECK AND BARRIER DETAILS

JIM ARMOUR, P.E.
CITY ENGINEER

PROJECT NUMBER 488-84253	OCA NO. 751445
DATE 3-14-07	

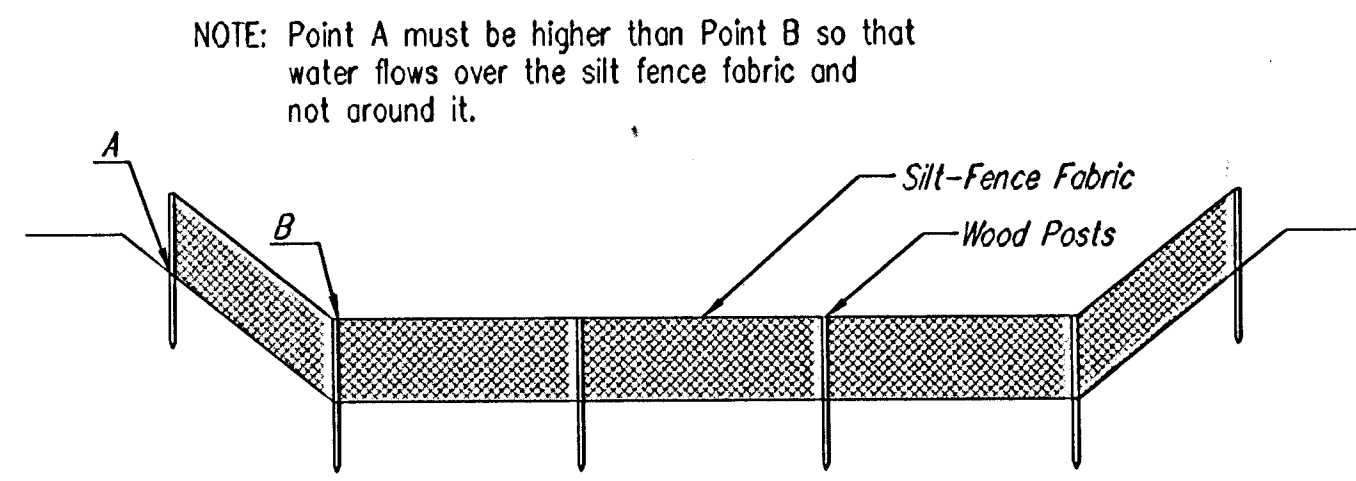

ELEVATION
SILT FENCE DITCH CHECKS
(STREAM PROTECTION)

Material Specification:

Silt fence fabric should conform to the AASHTO M288 96 silt fence specification. The posts used to support the silt fence fabric should be a hardwood material with the following minimum dimensions: 2" square (nominal) by 4' long. Silt fence fabric should be attached to the wooden posts with staples, wire, zip ties, or nails.

Placement:

Place silt fence in ditches where it is unlikely that it will be overtopped. Water should flow through a silt fence ditch check, not over it. Silt fence ditch checks often fail when overtopped. Silt fence ditch checks should be placed perpendicular to the flowline of the ditch. The silt fence should extend far enough so that the ground level at the ends of the fence is higher than the top of the low point of the fence. This prevents water from flowing around the check. Silt fence ditch checks should not be placed in ditches where high flows are expected. Rock checks should be used instead. Silt fence should be placed in ditches with slopes of 6% or less. For slopes steeper than 6%, rock checks should be used.

The following table provides check spacing for a given ditch grade:

Ditch Check Ditch grade (%)	Spacing Check Spacing (feet)
0.5	200
1.0	200
2.0	100
3.0	65
4.0	50
5.0	40
6.0	30

Proper installation method:

Excavate a trench perpendicular to the ditch flowline that is at least 12" deep by 6" wide. Extend the trench in a straight line along the entire length of the proposed ditch check. Place the soil on the upstream side of the trench for later use. Roll out a continuous length of silt fence fabric on the downstream side of the trench. Place the edge of the fabric in the trench starting at the top upstream edge of the trench. Line two sides of the trench with the fabric as shown in detail. Backfill over the fabric in the trench with the excavated soil and compact. After filling the trench, approximately 24" to 36" of silt fence fabric should remain exposed. Lay the exposed silt fence on the upstream side of the trench to clear an area for driving in the posts. Just downstream of the trench, drive posts into the ground to a depth of at least 24". Place posts no more than 4' apart. Attach the silt fence to the anchored post with staples, wire, zip ties, or nails.


List of common placement/installation mistakes to avoid:

Water should flow through a silt fence ditch check—not over it. Place silt fence in ditches where it is unlikely that it will be overtopped. Silt fence installations quickly deteriorate when water overtops them. Do not place silt fence posts on the upstream side of the silt fence fabric. In this configuration, the force of the water is not restricted by the posts, but only by the staples (wire, zip ties, nails, etc.). The silt fence will rip and fail. Do not place a silt fence ditch check directly in front of a culvert outlet. It will not stand up to the concentrated flow. Do not place silt fence ditch checks in ditches that will likely experience high flows. They will not stand up to concentrated flow. Follow prescribed ditch check spacing guidelines. If spacing guidelines are exceeded, erosion will occur between the ditch checks. Do not allow water to flow around the ditch check. Make sure that the ditch check is long enough so that the ground level at the ends of the fence is higher than the low point on the top of the fence. Do not place silt fence ditch checks in channels with shallow soils underlain by rock. If the check is not anchored sufficiently, it will wash out.


Inspection and Maintenance:

Silt fence ditch checks should be inspected every 7 days and within 24 hours of a rainfall of 1/2" or more. The following is a list of questions that should be addressed during each inspection:

- Does water flow around the ditch check?
- Does water flow under the ditch check?
- Does the silt fence sag excessively?
- Has the silt fence torn or become detached from the posts?
- Does sediment need to be removed from behind the ditch check?

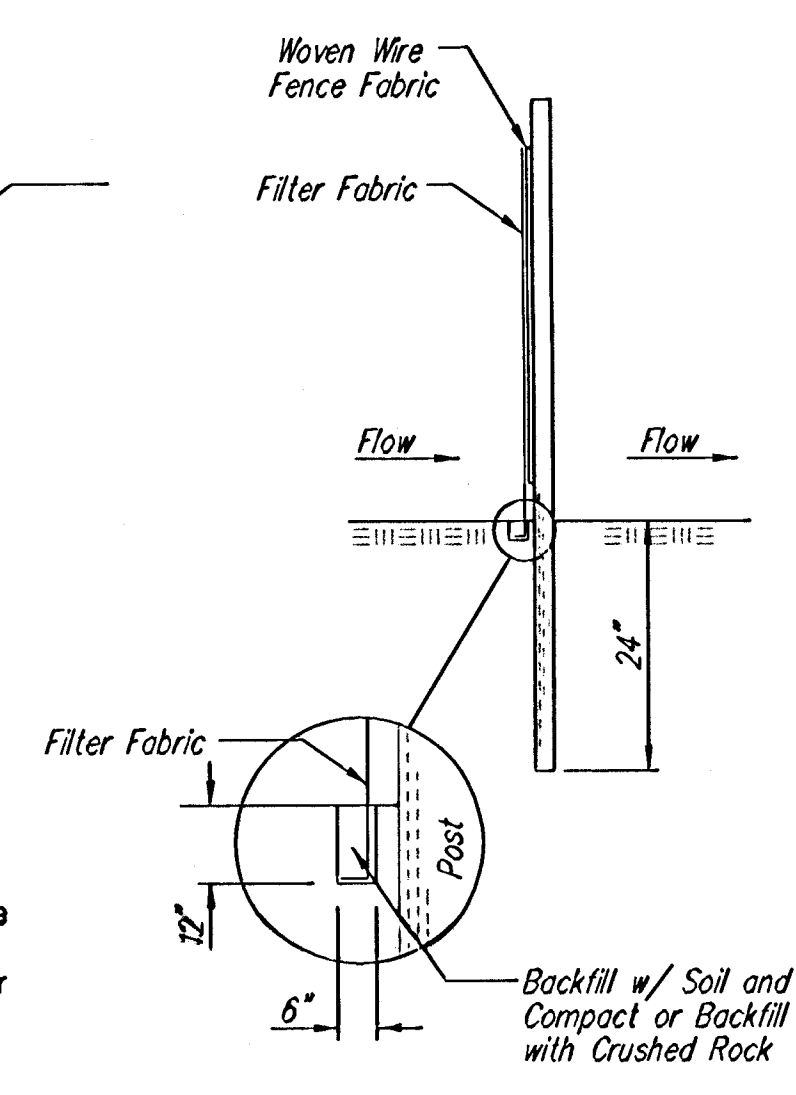

ANCHOR TRENCH DETAIL

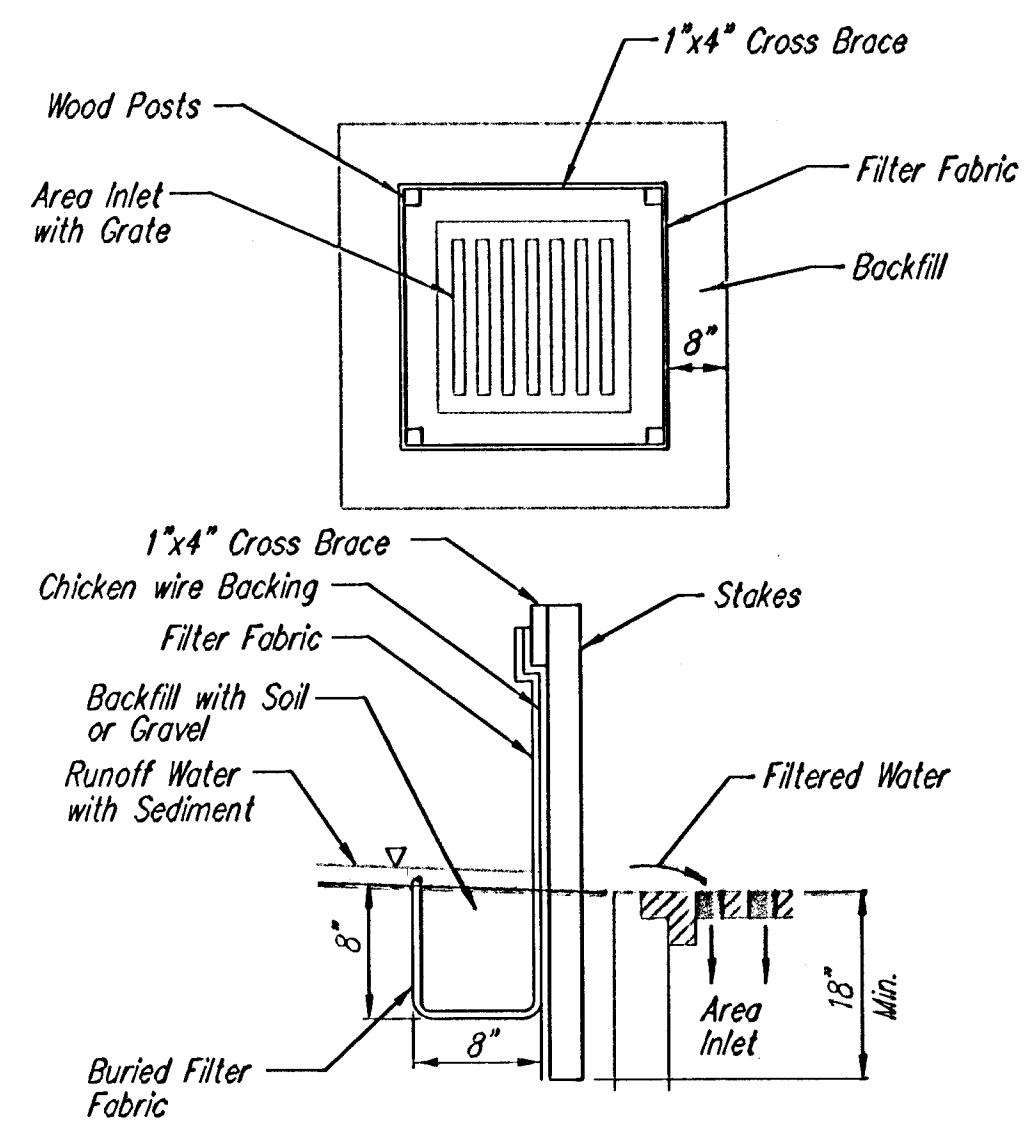

SILT FENCE BARRIERS FOR AREA INLETS
(INLET PROTECTION)

Material Specification:

Silt fence fabric should conform to the AASHTO M288 96 silt fence specification. The wire or polymeric mesh backing used to help support the silt fence fabric should conform to the AASHTO M288 96 silt fence specification. The posts used to support the silt fence fabric should be a hardwood material with the following minimum dimensions: 2" square (nominal) by 4' long. The material used to frame the tops of the posts should be 1" by 4" boards. Silt fence fabric and support backing should be attached to the wooden posts and frame with staples, wire, zip ties, or nails.

Placement:

Place a silt fence drop inlet barrier in a location where it is unlikely to be overtopped. Water should flow through silt fence, not over it. Silt fence barriers for area inlets often fail when repeatedly overtopped. When used as a barrier for area inlets, silt fence fabric and posts must be supported at the top by a wooden frame. When a silt fence barrier for area inlets is located near an inlet that has steep approach slopes, the storage capacity behind the barrier is drastically reduced. Timely removal of sediment must occur for a barrier to operate properly in this location.

Proper installation method:

Excavate a trench around the perimeter of the area inlet that is at least 8" deep by 8" wide. Drive posts to a depth of at least 18" around the perimeter of the area inlet. The distance between posts should be 4' or less. If the distance between two adjacent corner posts is more than 4', add another post(s) between them. Connect the tops of all the posts with a wooden frame made of 1" by 4" boards. Use nails or screws for fastening. Attach the wire or polymeric-mesh backing to the outside of the post/frame structure with staples, wire, zip ties, or nails. Roll out a continuous length of silt fence fabric long enough to wrap around the perimeter of the area inlet. Add more length for overlapping the fabric joint. Place the edge of the fabric in the trench, starting at the outside edge of the trench. Line all three sides of the trench with the fabric. Backfill over the fabric in the trench with the excavated soil and compact. After filling the trench, approximately 24" to 36" of silt fence fabric should remain exposed. Attach the silt fence to the outside of the post/frame structure with staples, wire, zip ties, or nails. The joint should be overlapped to the next post.

Note: When a silt fence barrier for area inlet is placed in a shallow median ditch, make sure that the top of the barrier is not higher than the paved road. In this configuration, water may spread onto the roadway causing a hazardous condition.


List of common placement/installation mistakes to avoid:

Water should flow through a silt fence barrier for area inlet—not over it. Place a silt fence barrier for area inlet in a location where it is unlikely to be overtopped. Silt fence barrier for area inlets often fail when repeatedly overtopped. Do not place posts on the outside of the silt fence barrier for area inlet. In this configuration, the force of the water is not resisted by the posts, but only by the staples (wire, zip ties, nails, etc.). The silt fence will rip and fail. Do not install silt fence barrier for area inlets without framing the top of the posts. The corner posts around area inlets are stressed in two directions whereas a normal silt fence is only stressed in one direction. This added stress requires more support.

Inspection and Maintenance:

Silt fence barrier for area inlets should be inspected every 7 days and within 24 hours of a rainfall of 1/2" or more. The following is a list of questions that should be addressed during each inspection:

- Does water flow under the silt fence?
- Does the silt fence sag excessively?
- Has the silt fence torn or become detached from the posts?
- Does sediment need to be removed from behind the area inlet barrier?

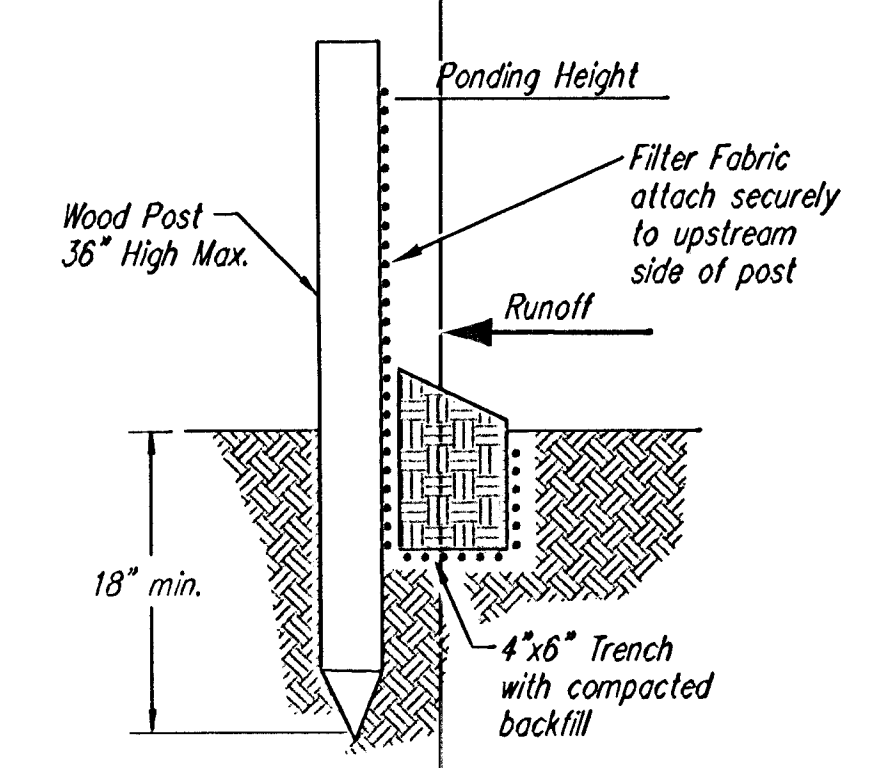

SILT FENCE BARRIERS

Material Specification:

Silt fence fabric should conform to the AASHTO M288 96 silt fence specification. The posts used to support the silt fence fabric should be a hardwood material with the following minimum dimensions: 2" square (nominal) by 4' long. Silt fence fabric should be attached to the wooden posts with staples, wire, zip ties, or nails.

Placement:

A slope barrier should be used at the toe of a slope when a ditch does not exist. The slope barrier should be placed on nearly level ground 5' to 10' away from the toe of a slope. The barrier is placed away from the toe of the slope to provide adequate storage for settling out sediment. When practicable, silt fence slope barriers should be placed along contours to avoid a concentration of flow. Silt fence slope barriers can also be placed along right-of-way fence lines to keep sediment from crossing onto adjacent property. When placed in this manner, the slope barrier will not likely follow contours.

Proper installation method:

Excavate a trench the length of the planned slope barrier that is 6" deep by 4" wide. Make sure that the trench is excavated along a single contour. When practicable, slope barriers should be placed along contours to avoid a concentration of flow. Place the soil on the upslope side of the trench for later use. Roll out a continuous length of silt fence fabric on the downslope side of the trench. Place the edge of the fabric in the trench starting at the top upslope edge. Line all three sides of the trench with the fabric. Backfill over the fabric in the trench with the excavated soil and compact. After filling the trench, approximately 24" to 36" of silt-fence fabric should remain exposed. Lay the exposed silt fence upslope of the trench to clear an area for driving in the posts. Just downslope of the trench, drive posts into the ground to a depth of at least 18". Place posts no more than 4' apart. Attach the silt fence to the anchored post with staples, wire, zip ties, or nails.

List of common placement/installation mistakes to avoid:

When practicable, do not place silt fence slope barriers across contours. Slope barriers should be placed along contours to avoid a concentration of flow. When the flow concentrates, it overtops the barrier and the silt fence slope barrier quickly deteriorates. Do not place silt-fence posts on the upslope side of the silt fence fabric. In this configuration, the force of the water is not restricted by the posts, but only by the staples (wire, zip ties, nails, etc.). The silt fence will rip and fail. Do not place silt fence slope barriers in areas with shallow soils underlain by rock. If the barrier is not sufficiently anchored, it will wash out. Silt fence slope barriers must be dug into the ground—silt fence at ground level does not work because water will flow underneath.


Inspection and Maintenance:

Silt fence slope barriers should be inspected every 7 days and within 24 hours of a rainfall of 1/2" or more. The following is a list of questions that should be addressed during each inspection:


- Are there any points along the slope barrier where water is concentrating?
- Does water flow under the slope barrier?
- Do the silt fences sag excessively?
- Has the silt fence torn or become detached from the posts?
- Does sediment need to be removed from behind the slope barrier?



SOIL EROSION BMPs	
SILT FENCE DITCH CHECK AND BARRIER DETAILS	
JIM ARMOUR, P.E. CITY ENGINEER	
PROJECT NUMBER 468-84253	OCA NO. 751445
DATE 5-14-07	SHEET 18 OF 22

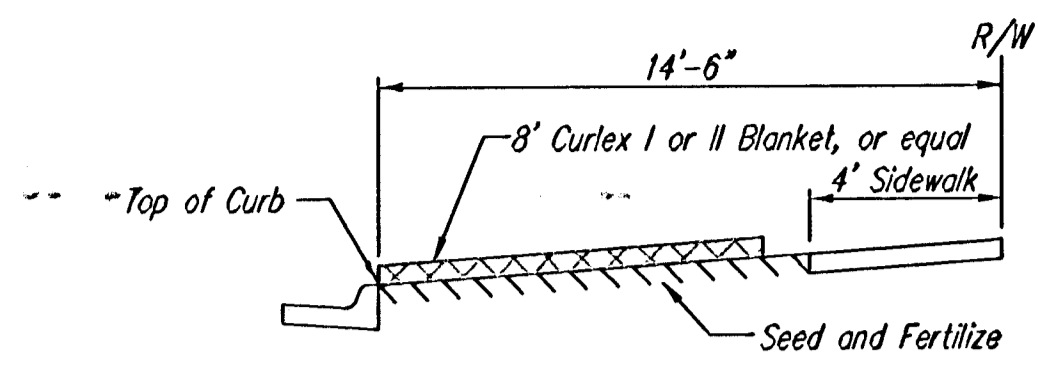


SECTION B-B

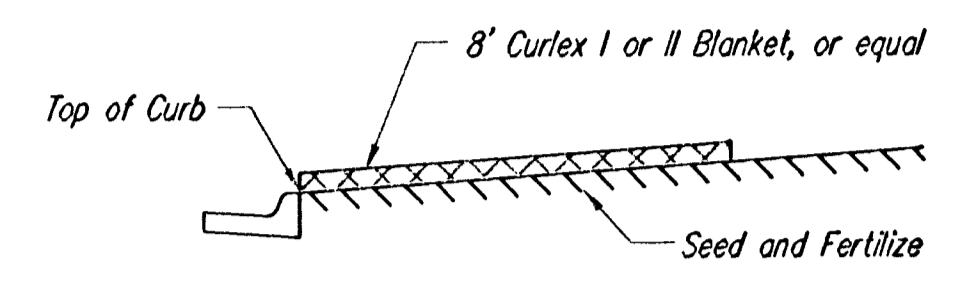


SECTION A-A

Install 8' wide Curlex I or II Excelsior Blanket, or equal, on prepared surface back of curb. Edge of blanket will be at back of curb. Install per manufacturer's recommendation, including staples. (See detail)

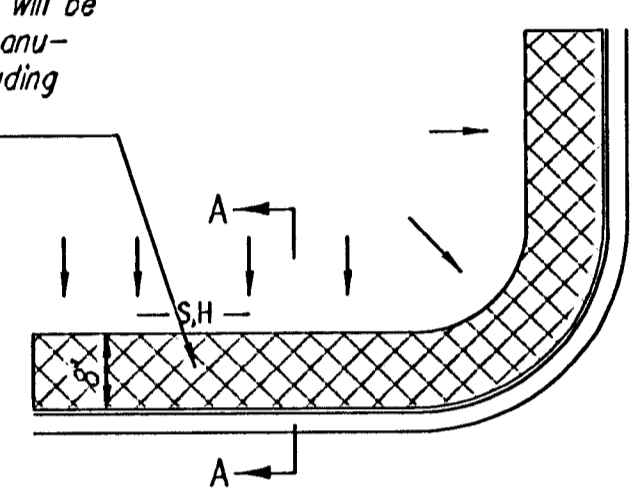


SOUTH STREET

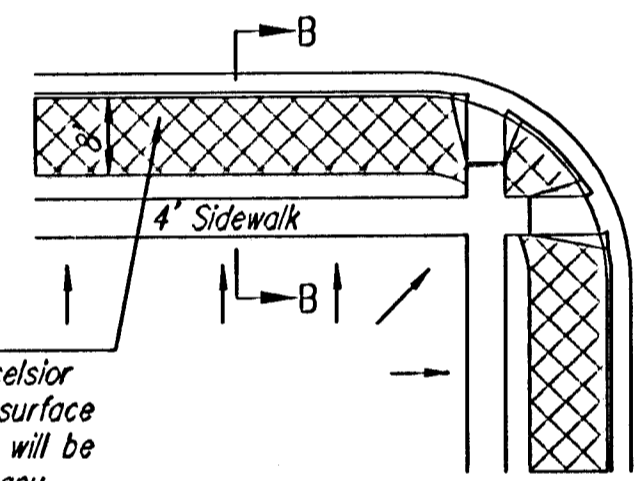

Install 8' wide Curlex I or II Excelsior Blanket, or equal, on prepared surface back of curb. Edge of blanket will be at back of curb. Install per manufacturer's recommendation, including staples. (See detail)


- NOTES:
1. EXCELSIOR MAT TO BE INSTALLED WHEN SOD IS NOT SPECIFIED ON PROJECT.
 2. EXCELSIOR BLANKET TO BE INSTALLED OVER SEED AND FERTILIZER, AS SPECIFIED IN THE PROJECT SPECIFICATIONS.
 3. AFTER INSTALLATION OF EXCELSIOR BLANKET, AT LOCATIONS WHERE CONCENTRATED FLOW CARRIES SEDIMENT OVER THE CURB AND INTO THE GUTTER, SUPPLEMENTAL EROSION CONTROL DEVICES WILL BE INSTALLED BY THE CONTRACTOR AS NEEDED, TO FIX THE PROBLEM.

BACK OF CURB PROTECTION DETAIL

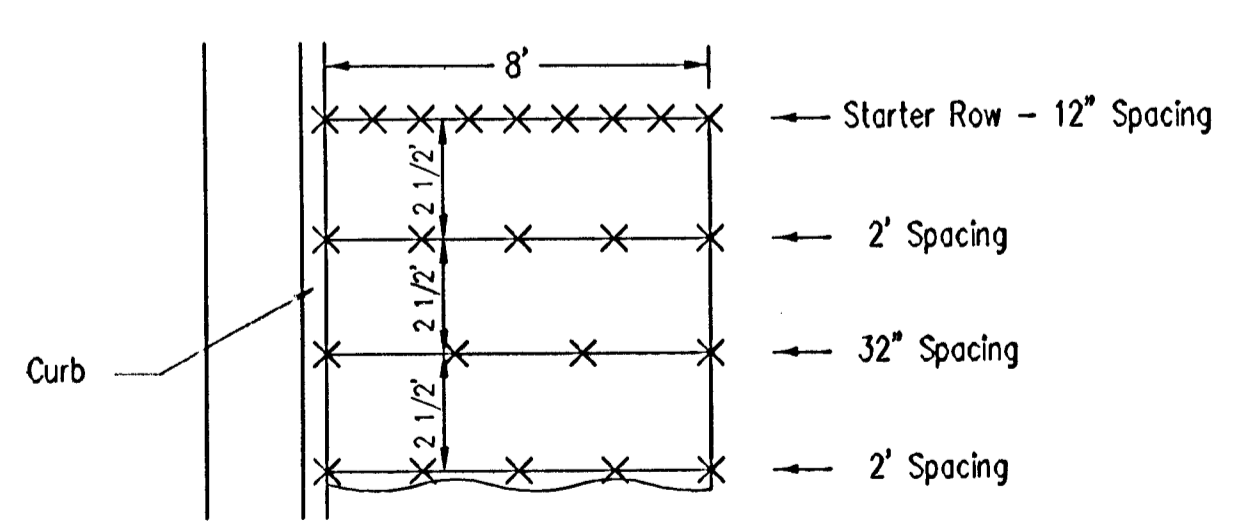


STAPLE PATTERN
NOTES: Use 6" seam overlap

DETAILS FOR CURLEX I OR II BLANKETS

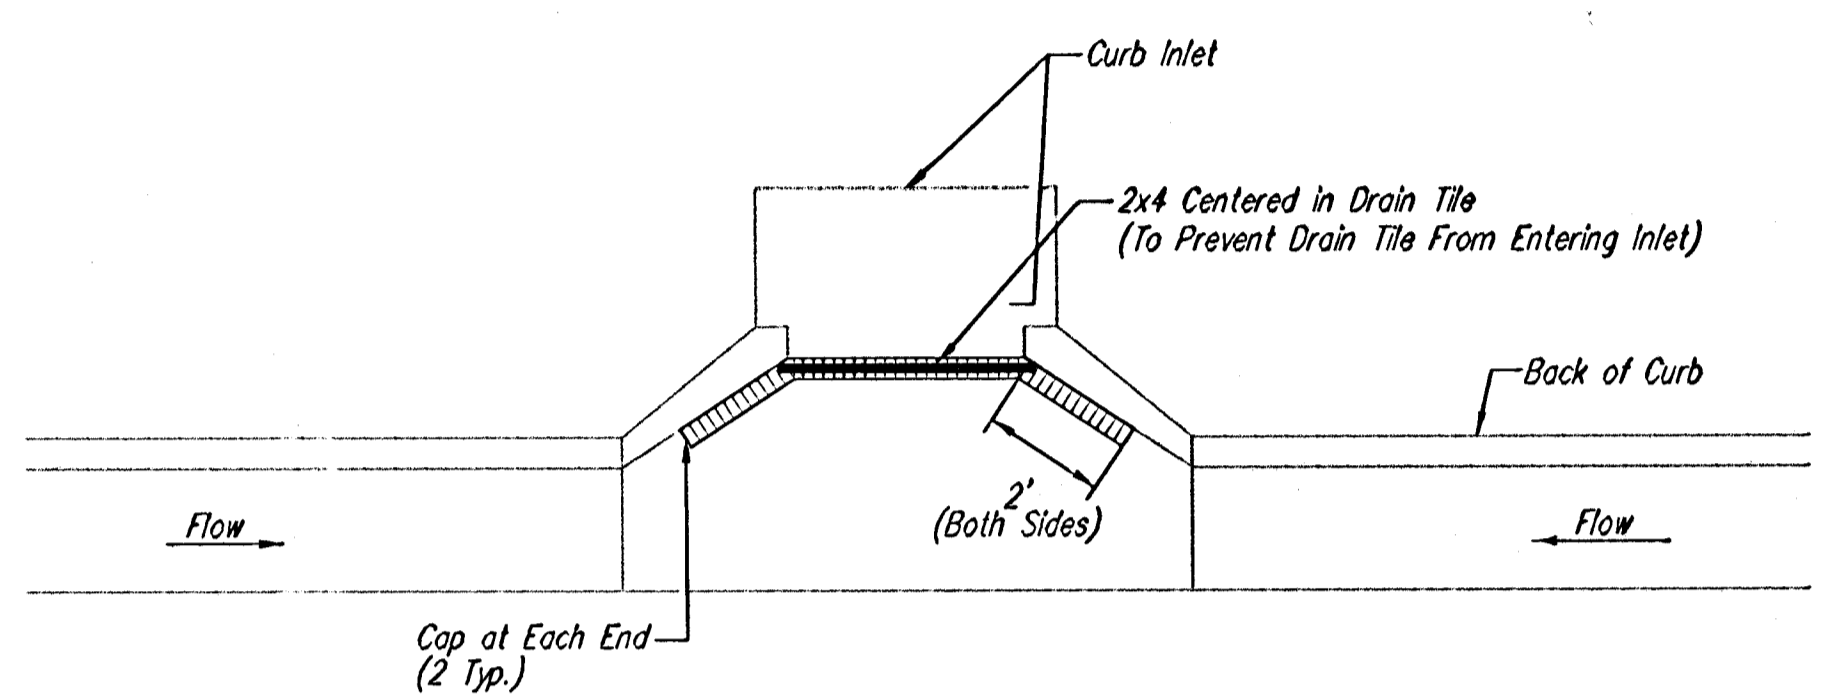


Note: Place 4" perforated PVC pipe, filled with 1/2"-1" dia. gravel, in front of curb inlet as shown.

2x4 LENGTH	INLET TYPE	INLET OPENING
5'-6"	1-A	5'-0"
10'-6"	1-A	10'-0"
15'-6"	1-A	15'-0"

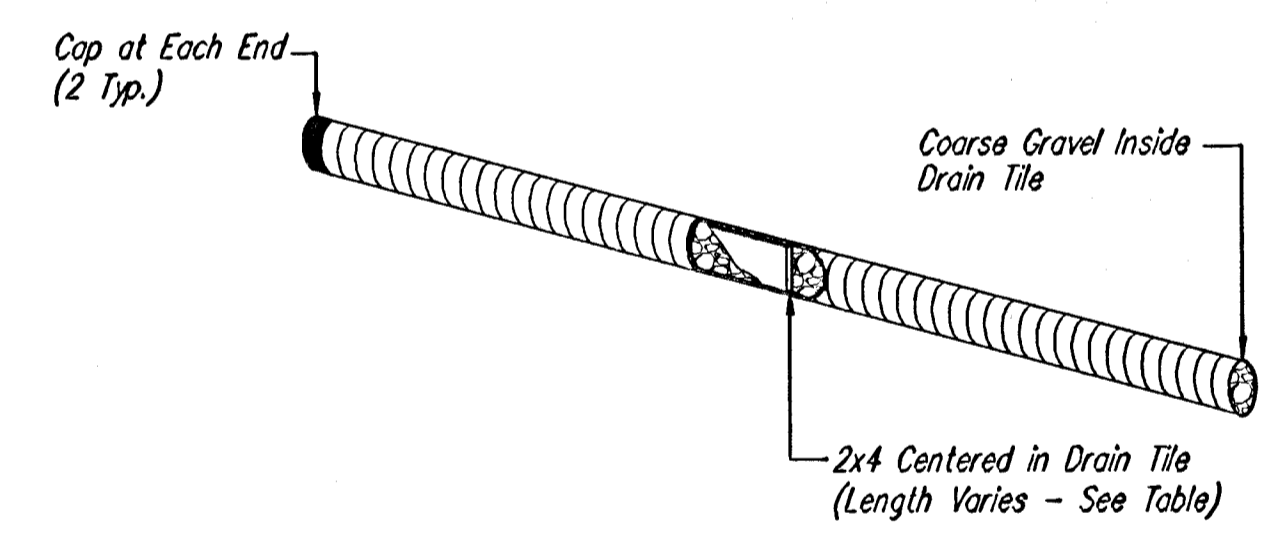

CURB INLET PROTECTION
4" PERFORATED PIPE W/ GRAVEL

































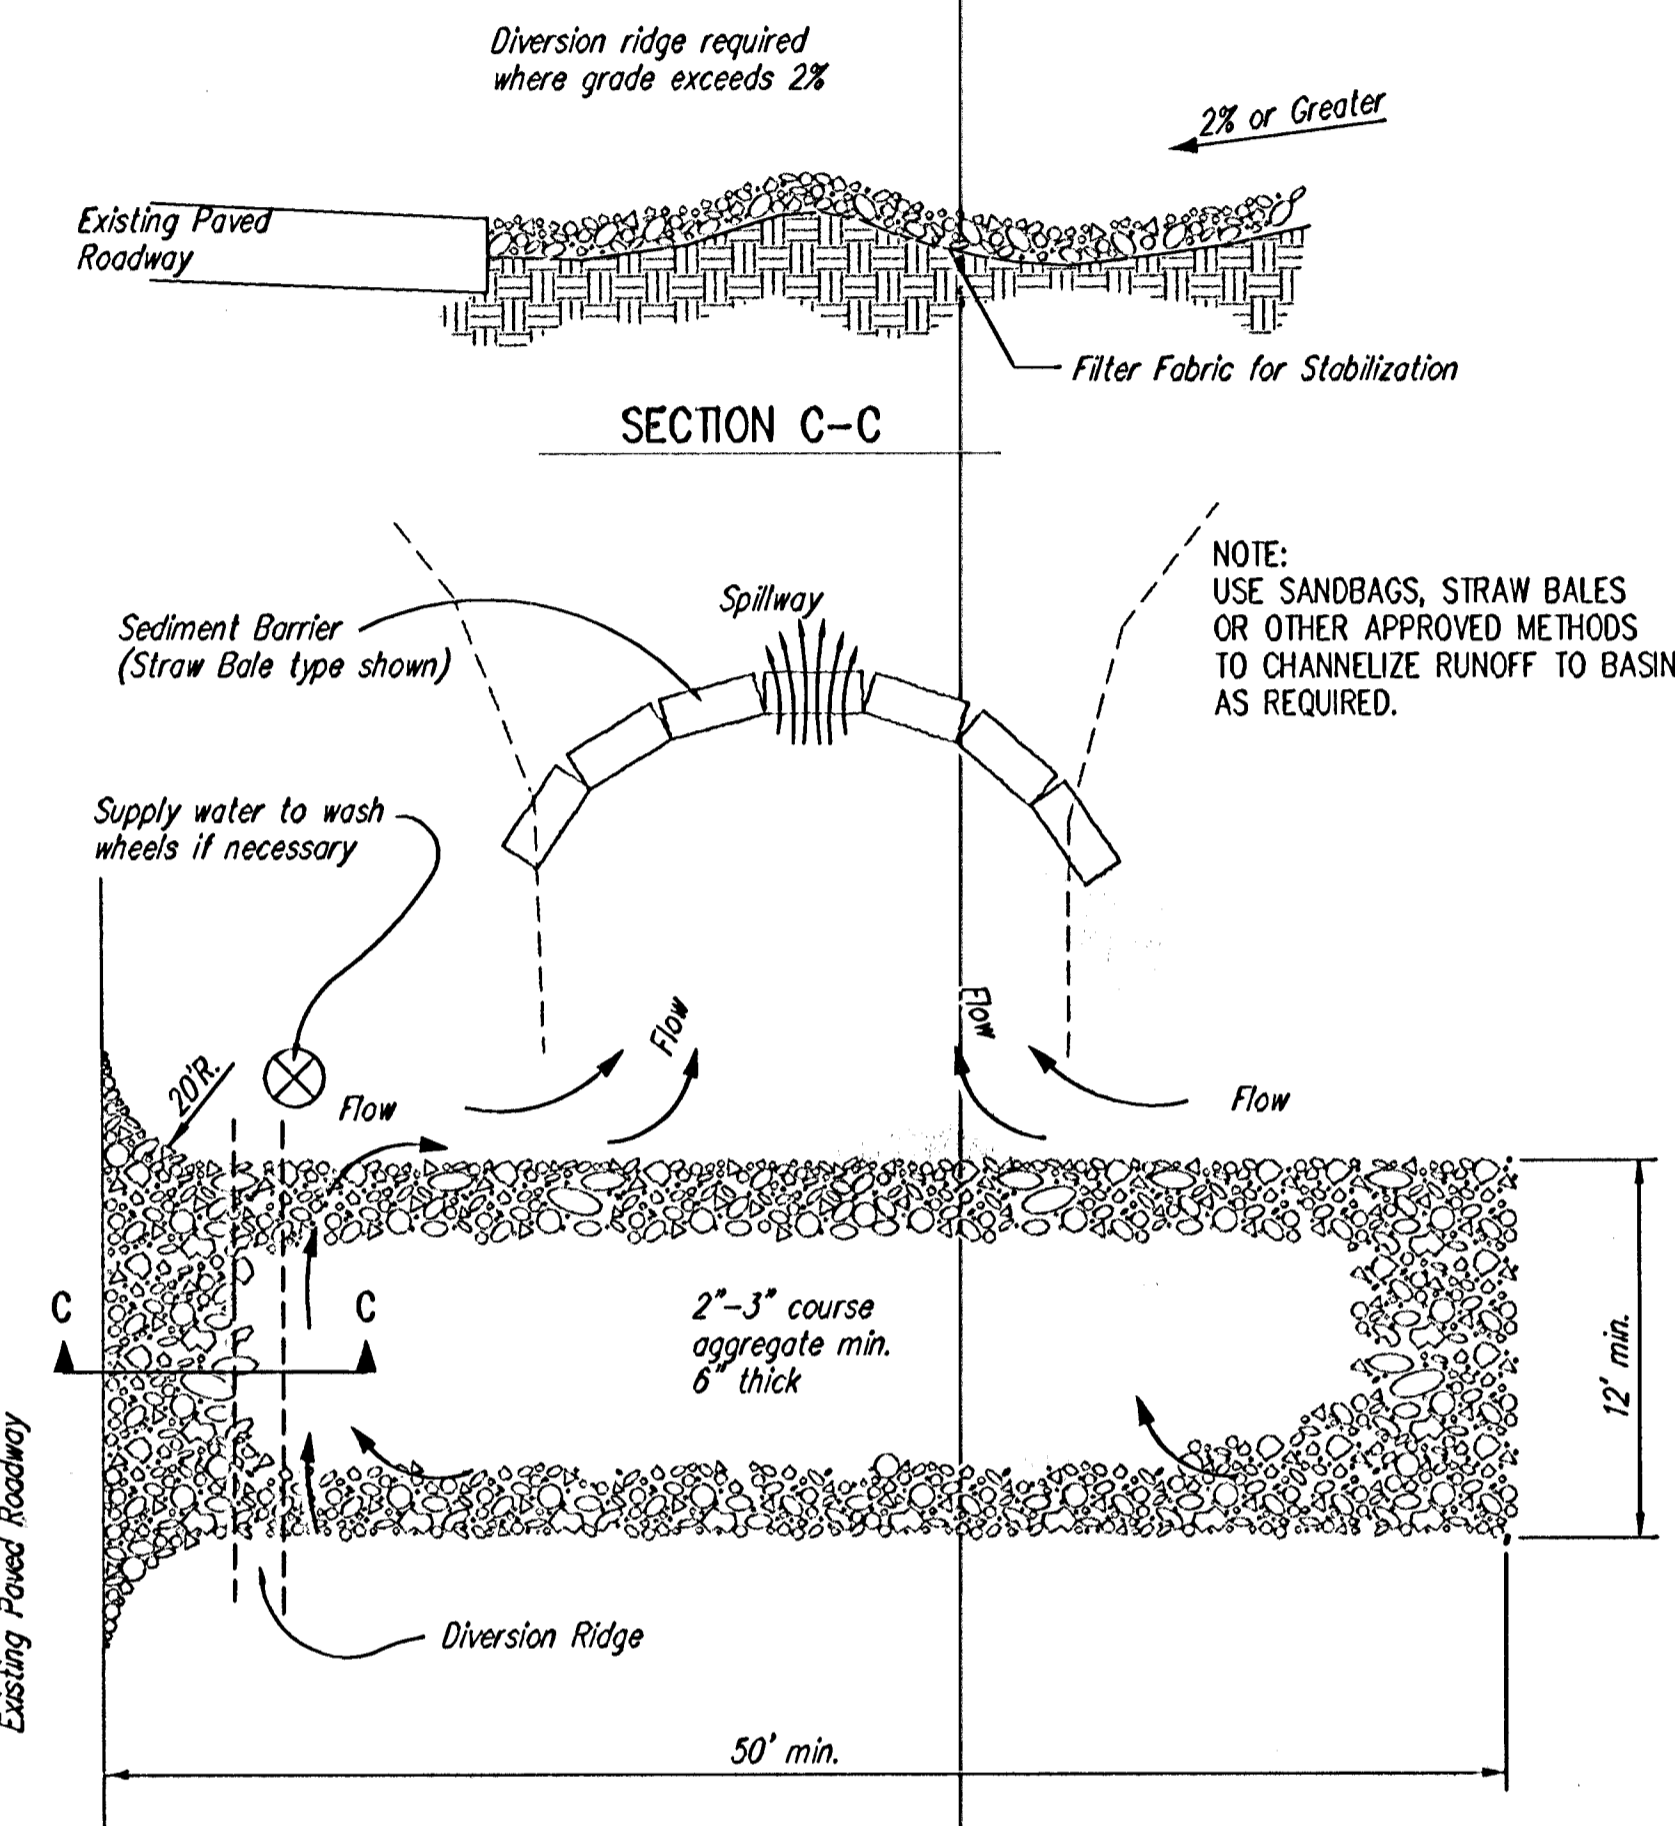
























STABILIZED CONSTRUCTION ENTRANCE

- NOTES:
1. THE ENTRANCE SHALL BE MAINTAINED IN A CONDITION THAT WILL PREVENT TRACKING OR FLOWING OF SEDIMENT ONTO PUBLIC RIGHTS-OF-WAY. THIS MAY REQUIRE TOP DRESSING, REPAIR AND/OR CLEANOUT OF ANY MEASURES USED TO TRAP SEDIMENT.
 2. WHEN NECESSARY, WHEELS SHALL BE CLEANED PRIOR TO ENTRANCE ONTO PUBLIC RIGHT-OF-WAY.
 3. WHEN WASHING IS REQUIRED, IT SHALL BE DONE ON AN AREA STABILIZED WITH CRUSHED STONE THAT DRAINS INTO AN APPROVED SEDIMENT TRAP OR SEDIMENT BASIN, AS SHOWN ABOVE.
 4. DRIVE ENTRANCES ONTO RESIDENTIAL LOTS WILL NOT BE REQUIRED TO HAVE THE SEDIMENT BARRIER SHOWN, BUT WHEEL WASHING MAY BE REQUIRED IF STABILIZED ENTRANCE IS NOT SUFFICIENT TO KEEP MUD FROM BEING TRACKED ONTO ADJACENT STREET. ENTRANCE SHALL EXTEND FROM BACK OF CURB TO DWELLING.



SOIL EROSION BMPs	
BACK OF CURB PROTECTION, CURB INLET PROTECTION AND CONSTRUCTION ENTRANCE	
JIM ARMOUR, P.E. CITY ENGINEER	
PROJECT NUMBER 488-84253	OCA NO. 751445
DATE 3-14-07	SHEET 19 OF 22

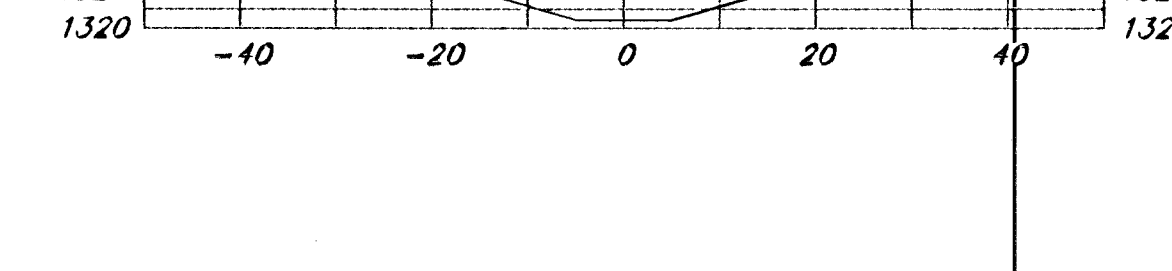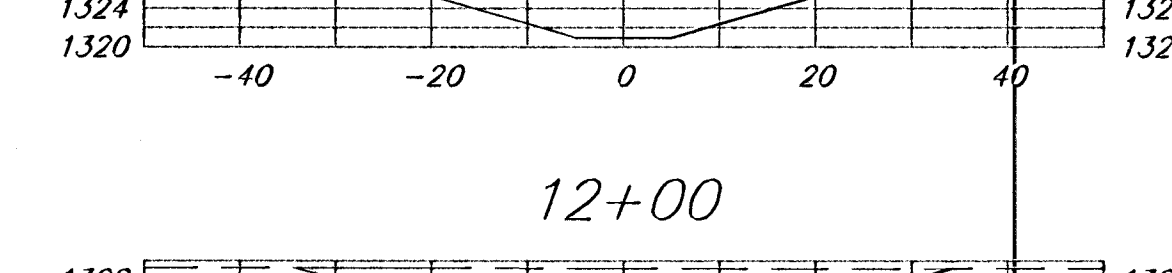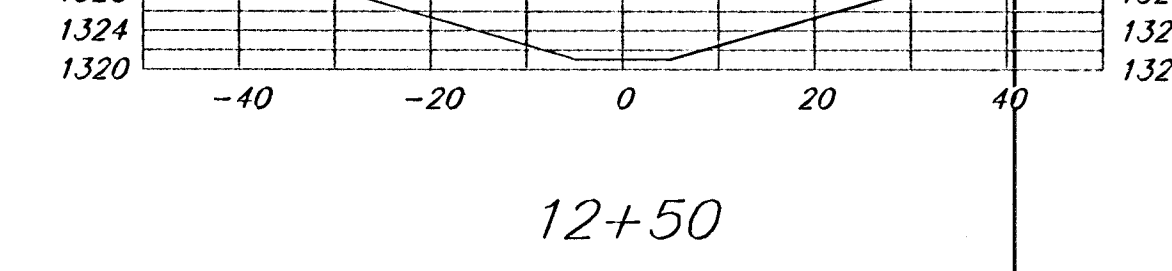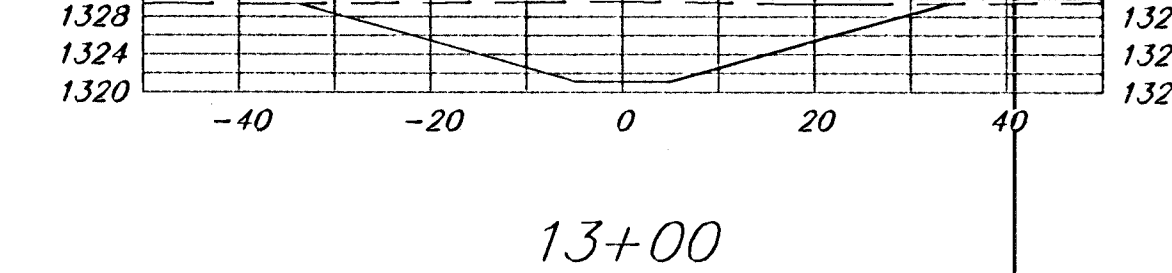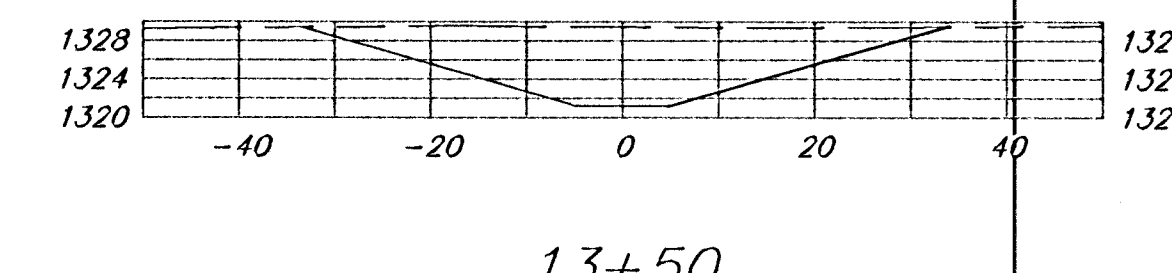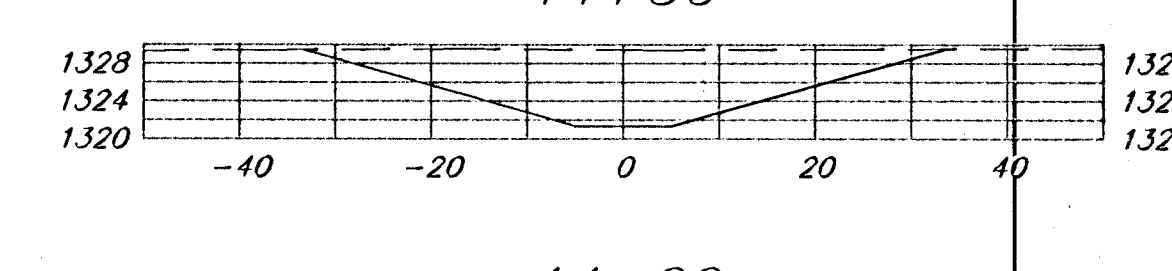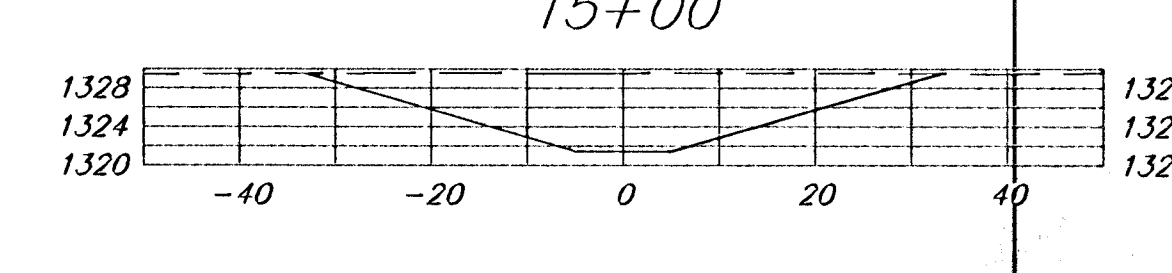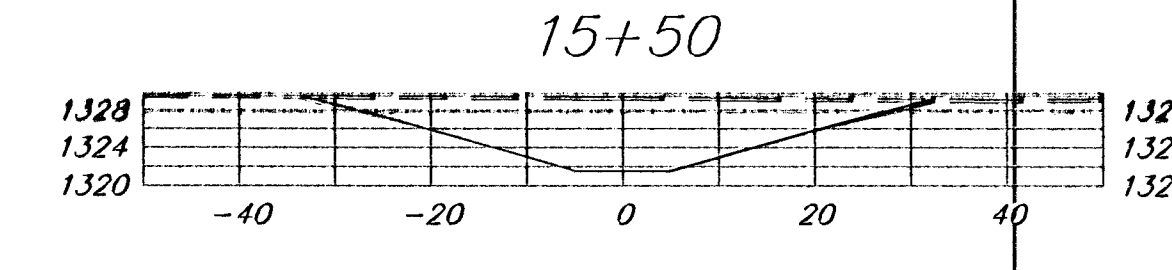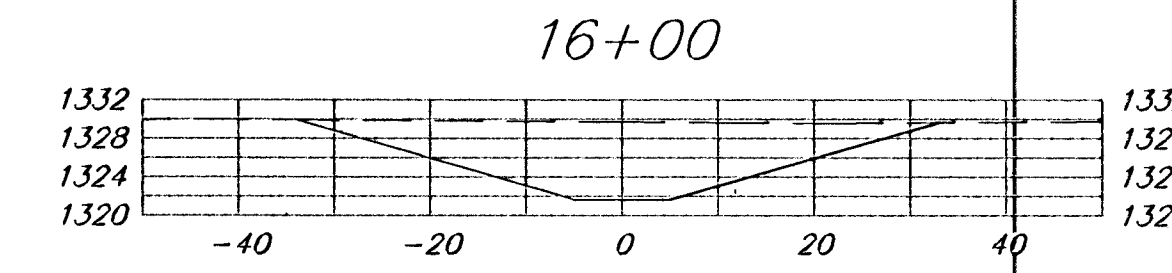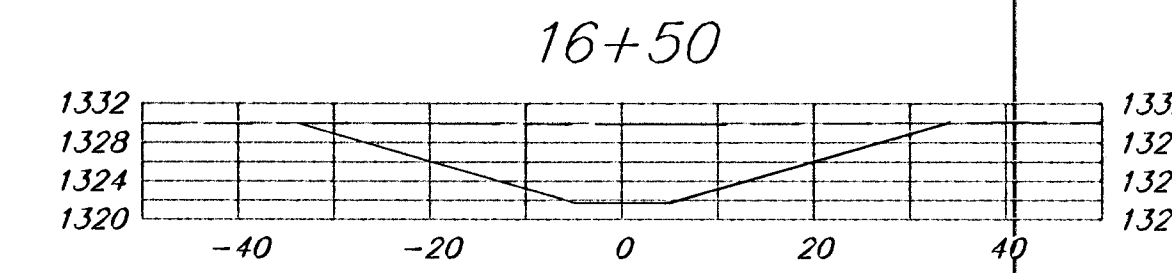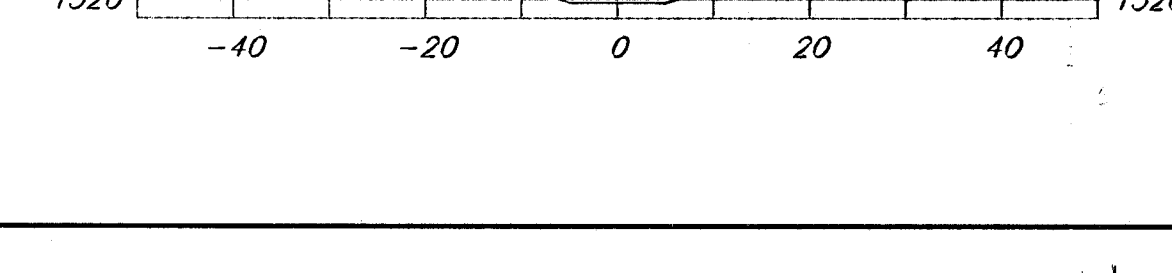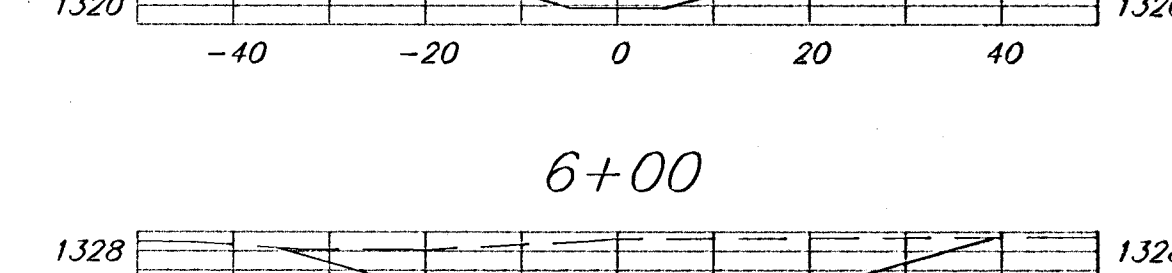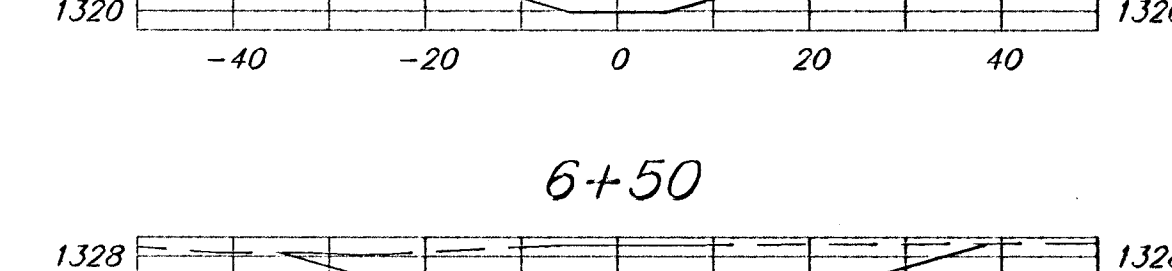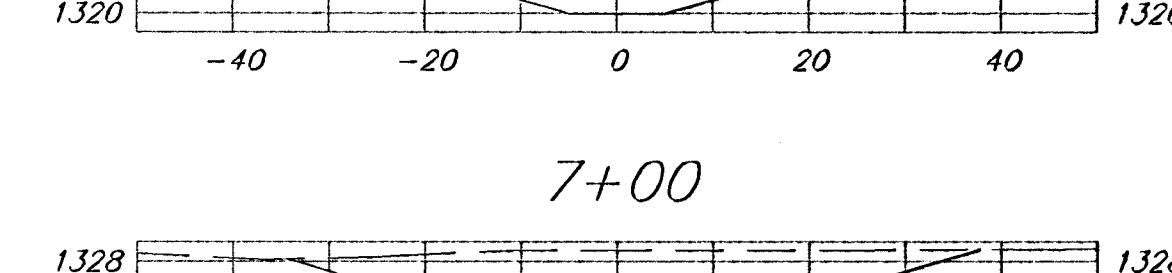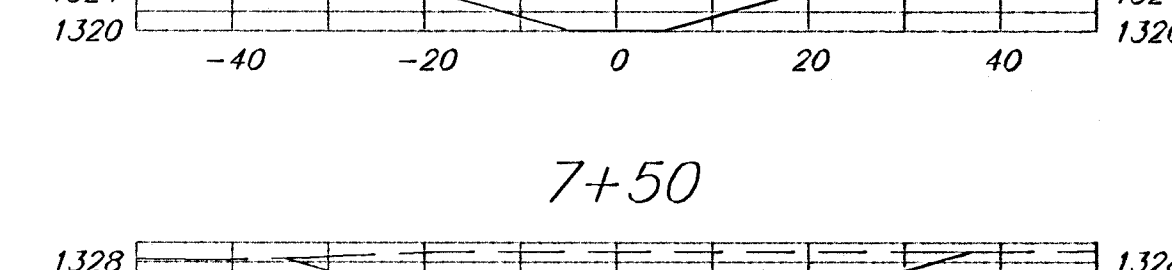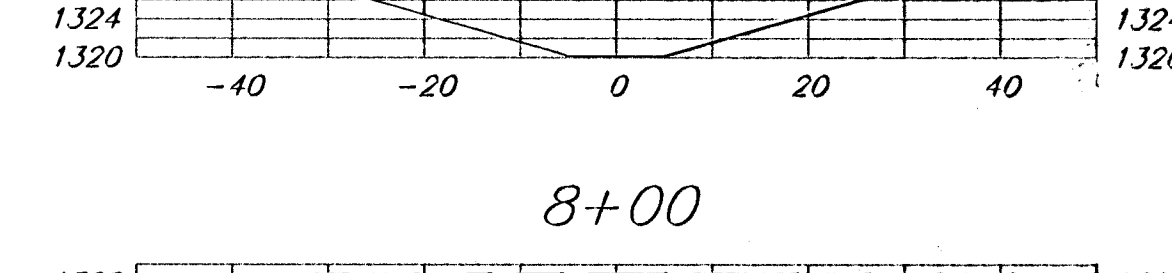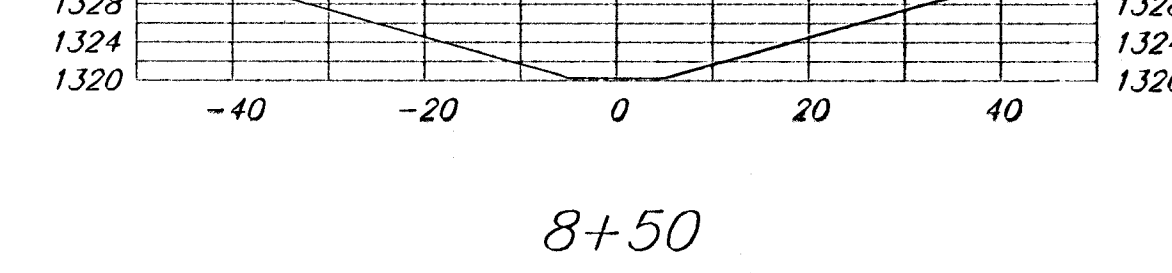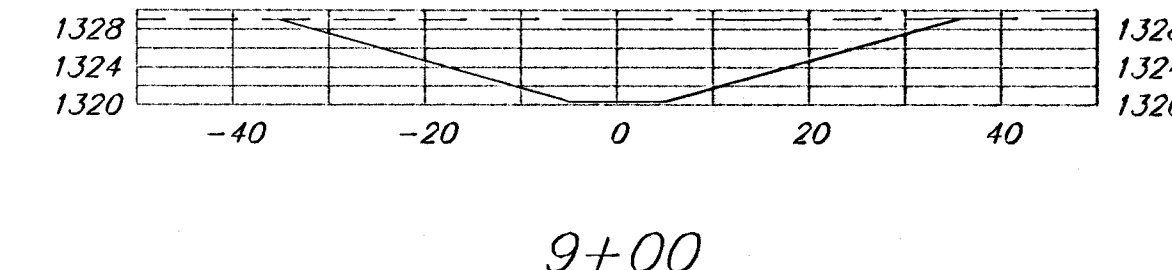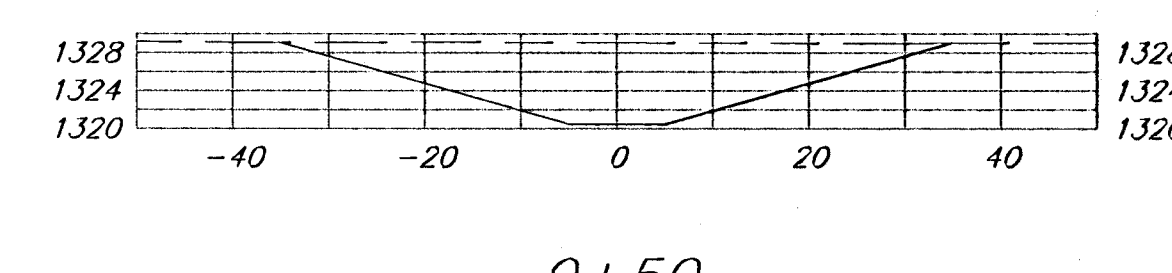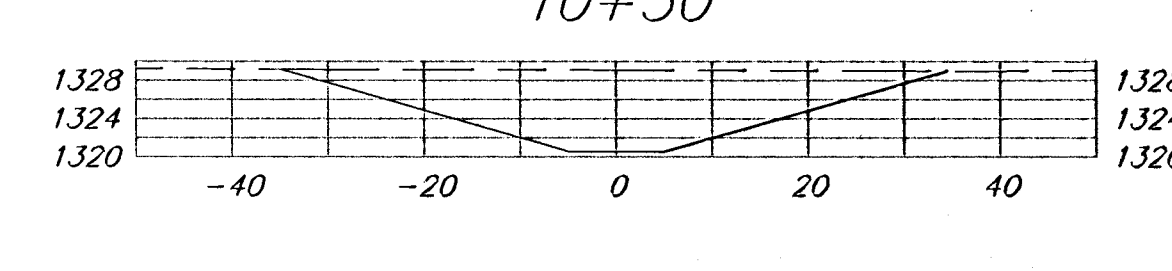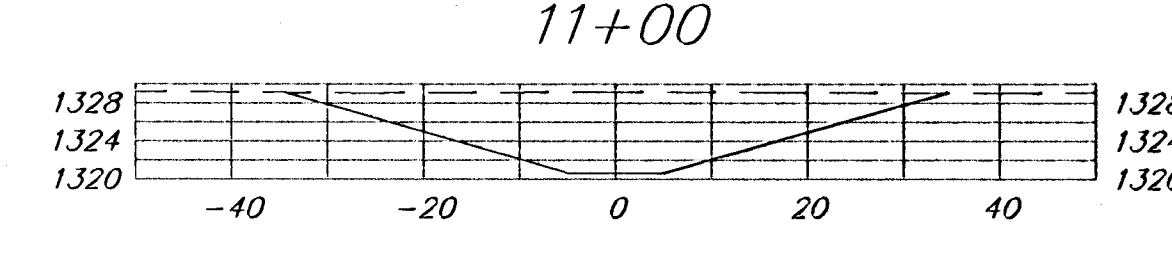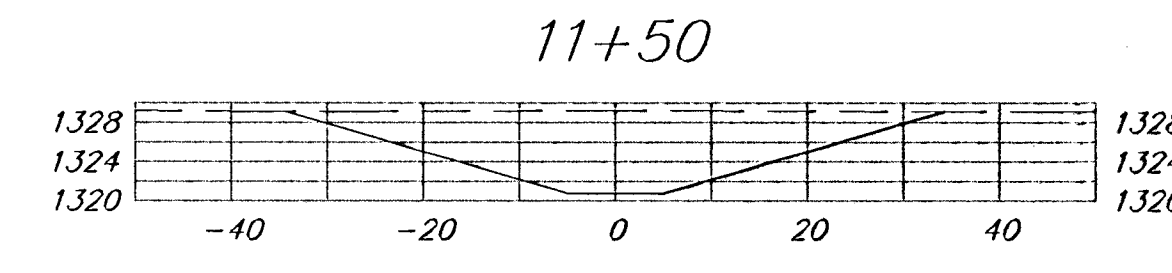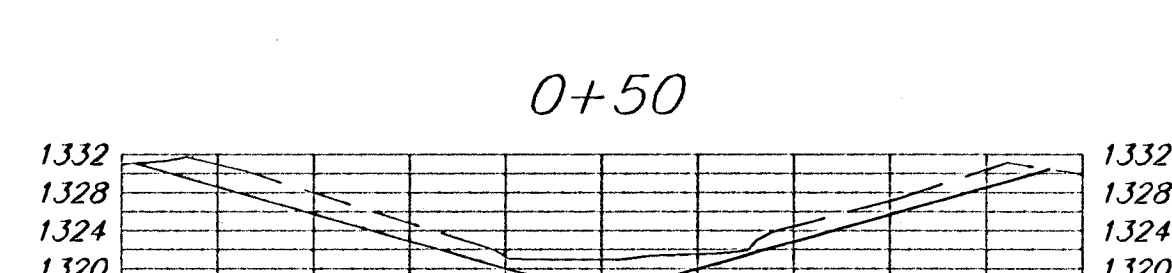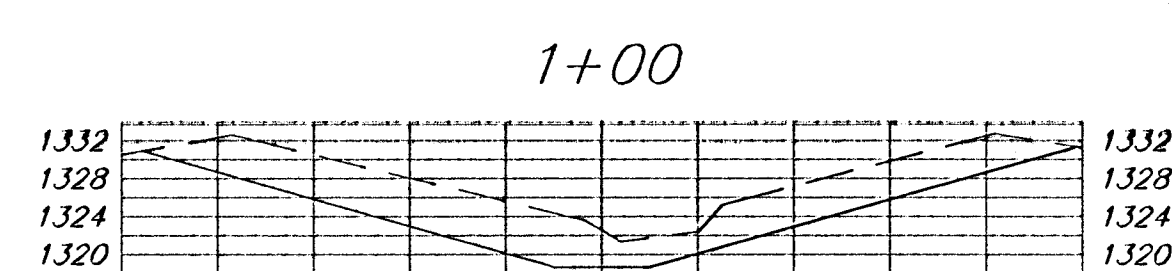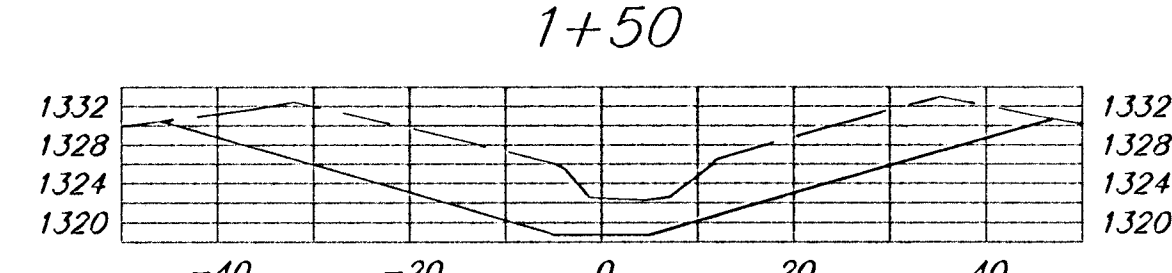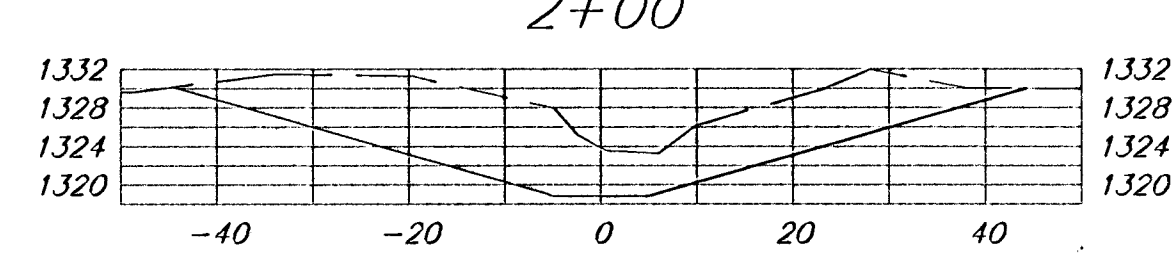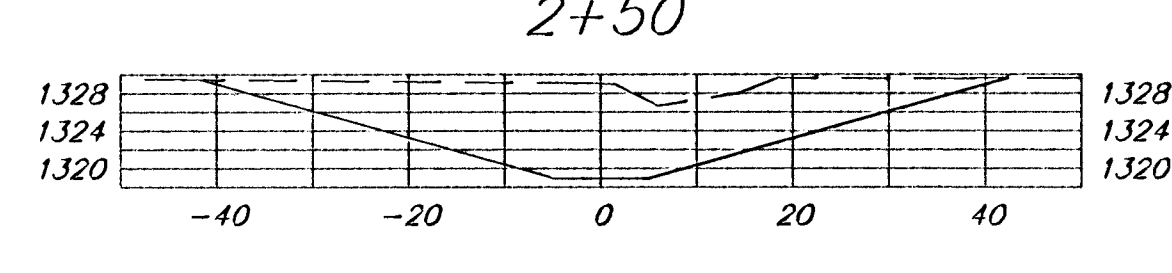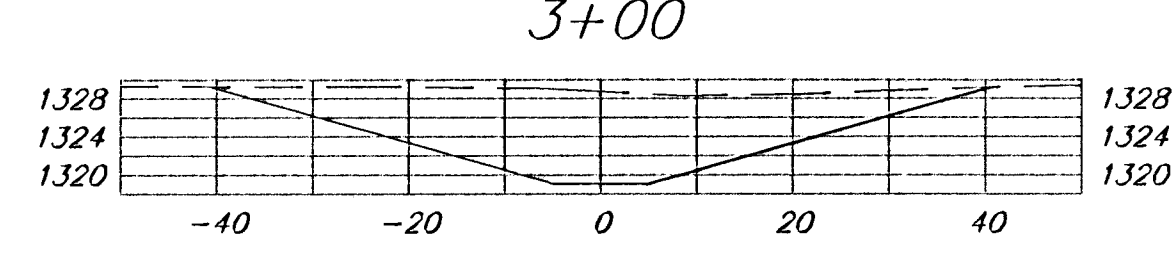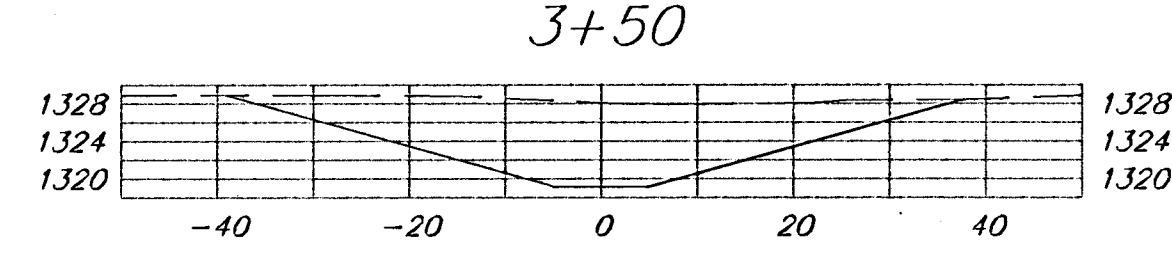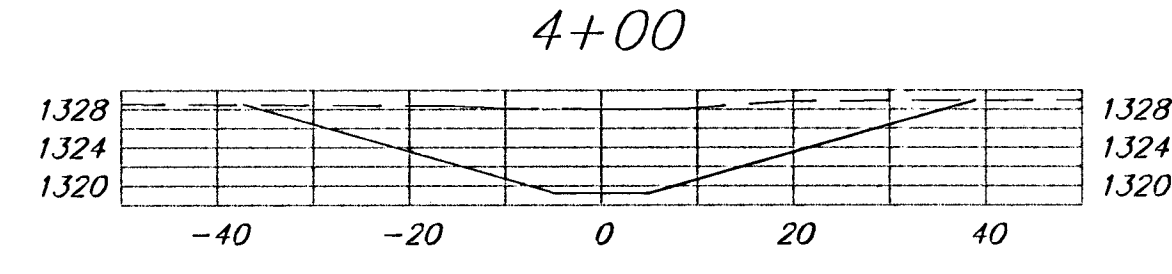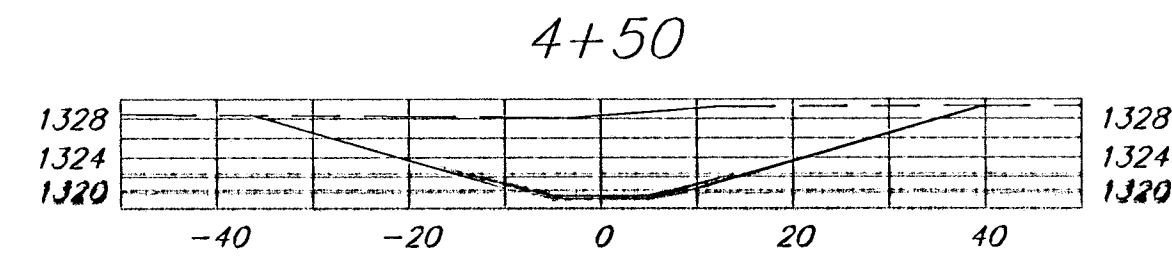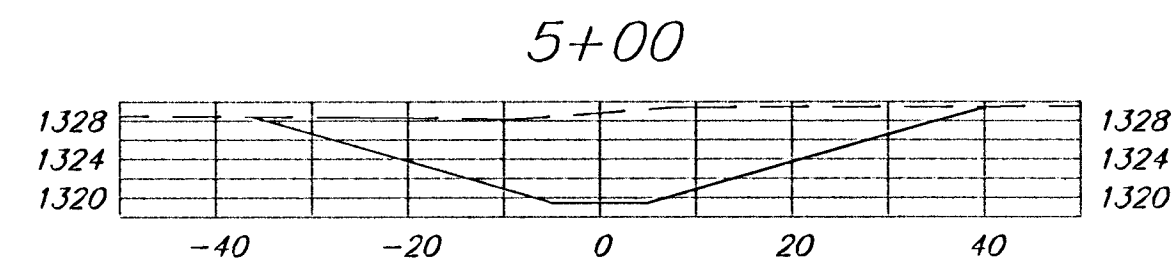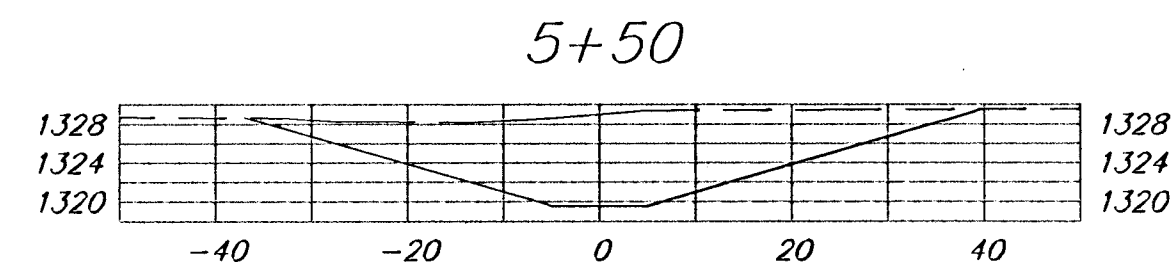

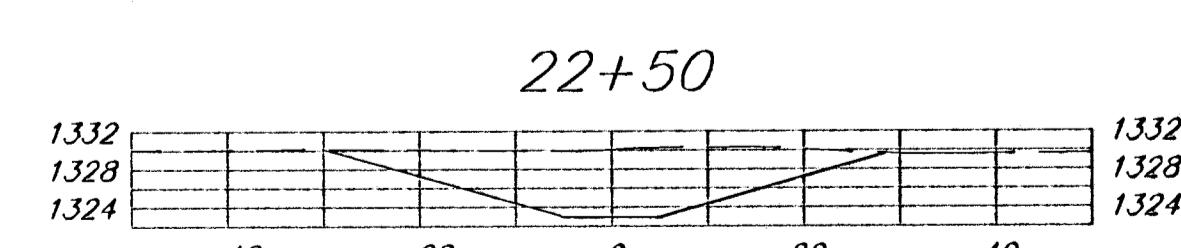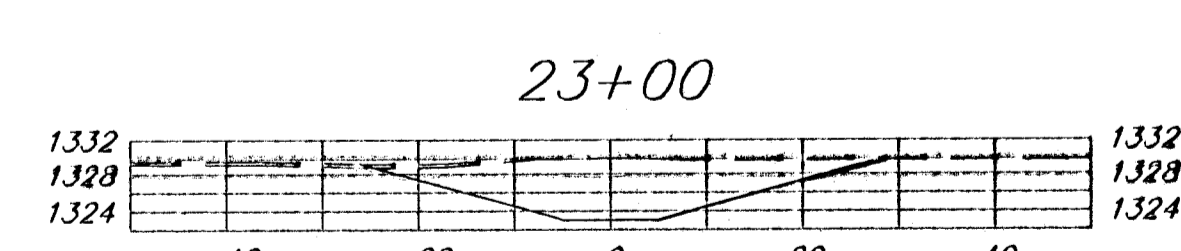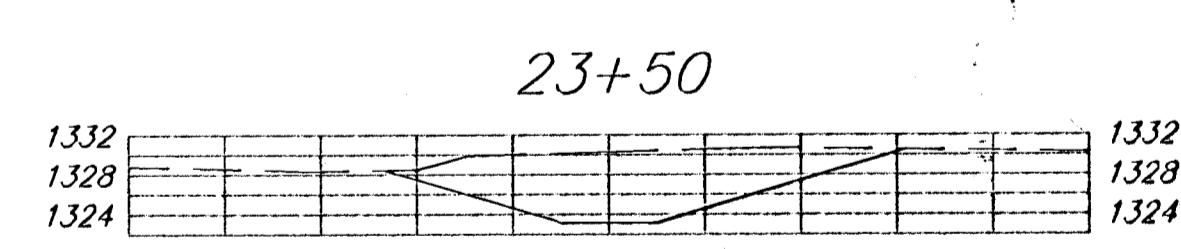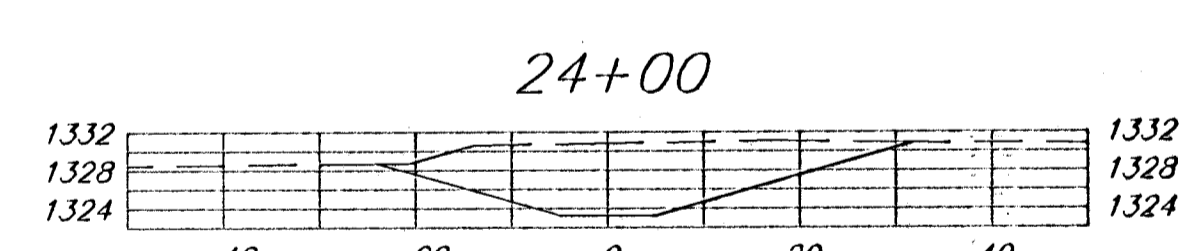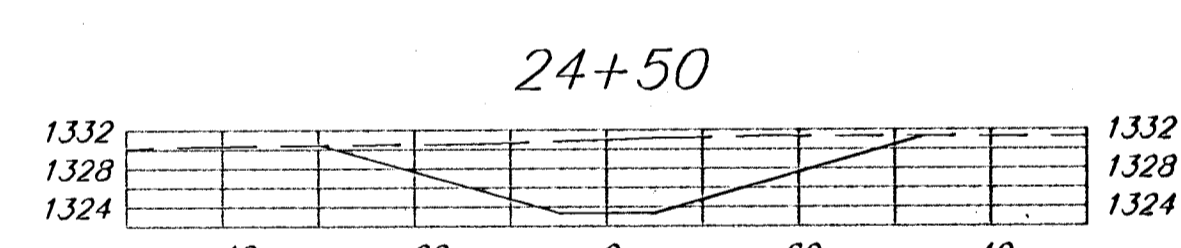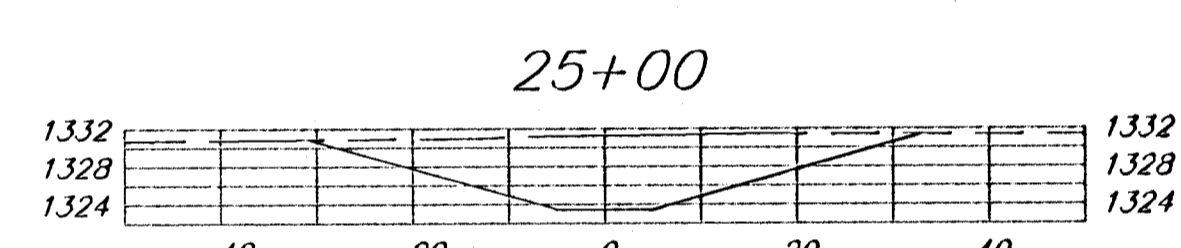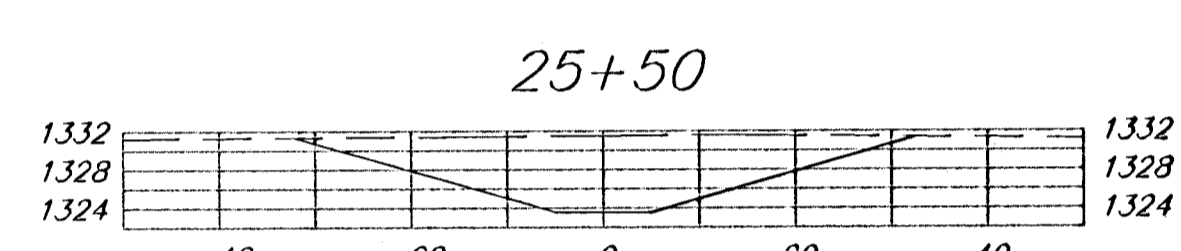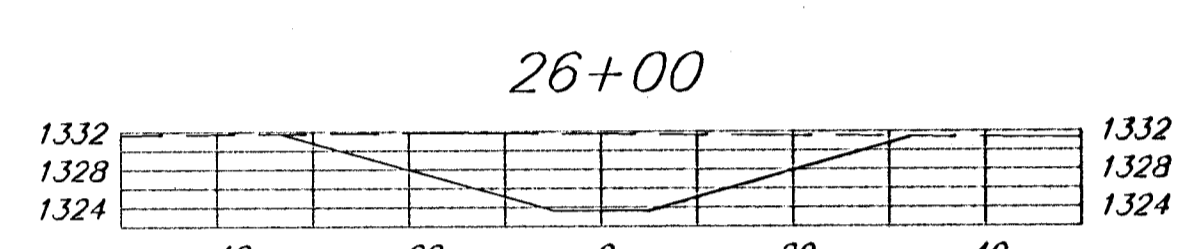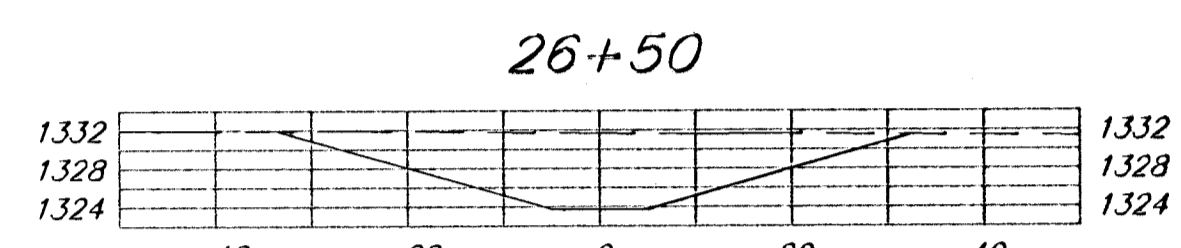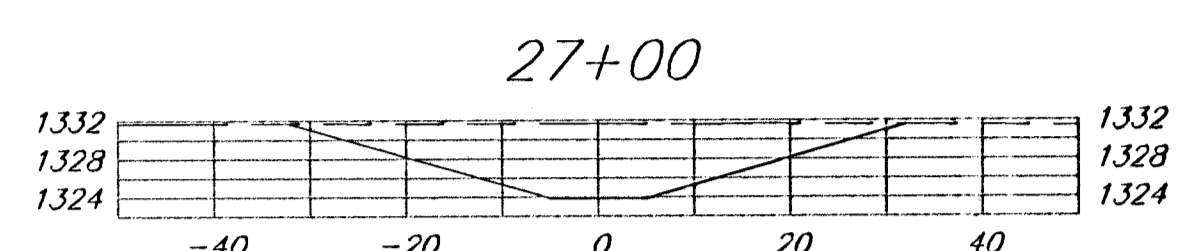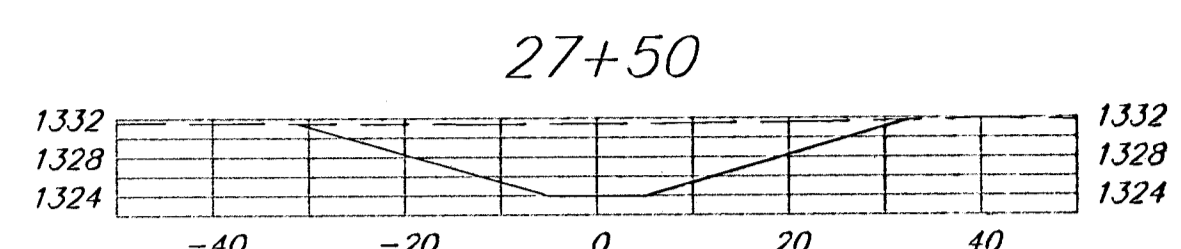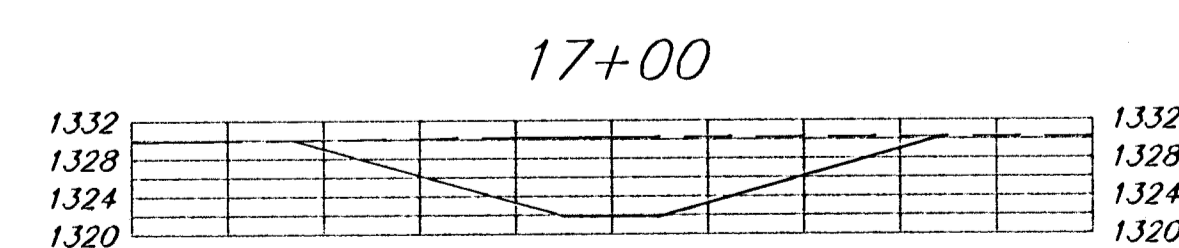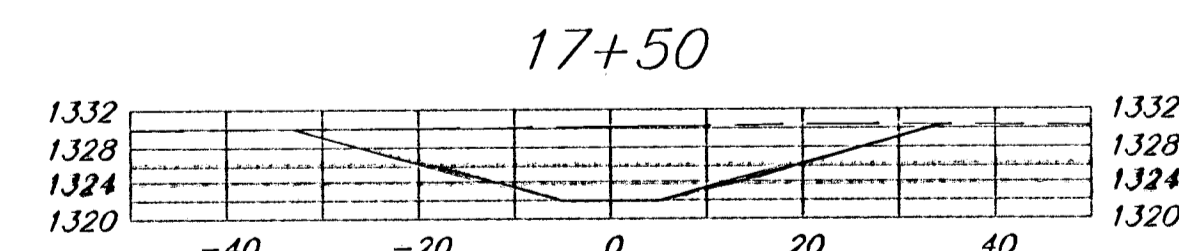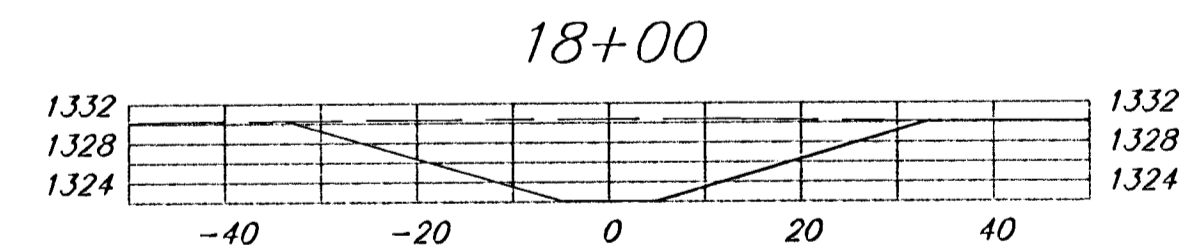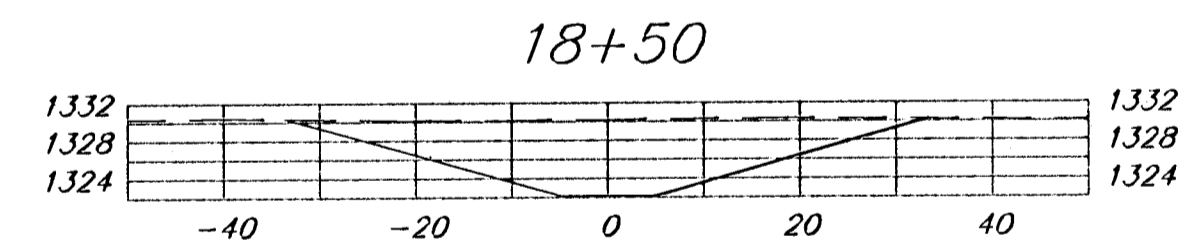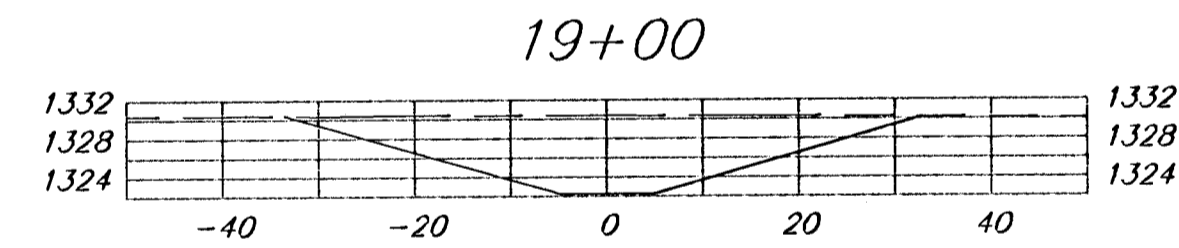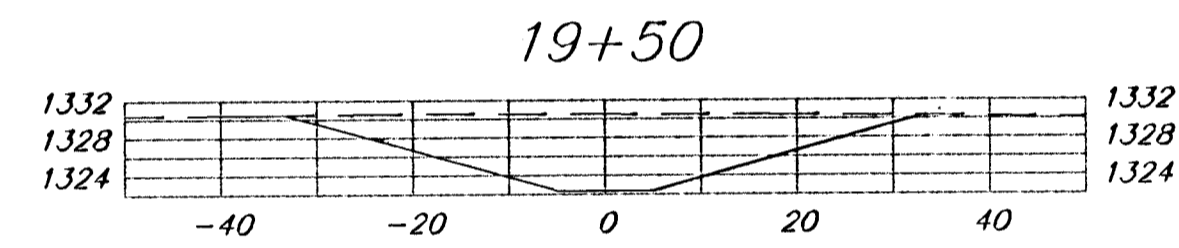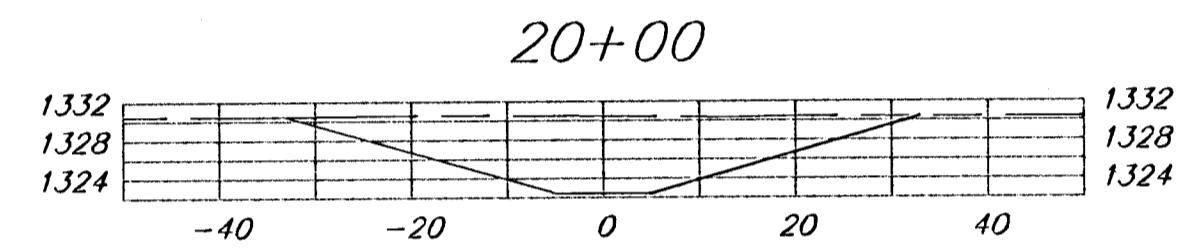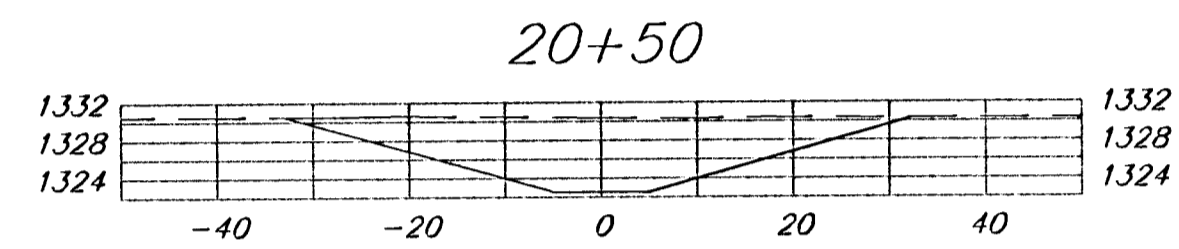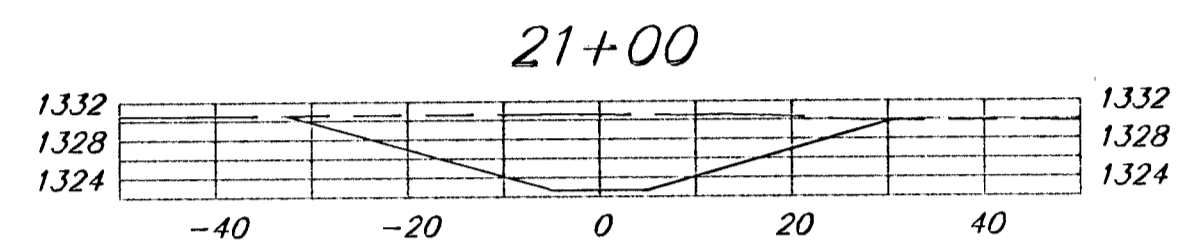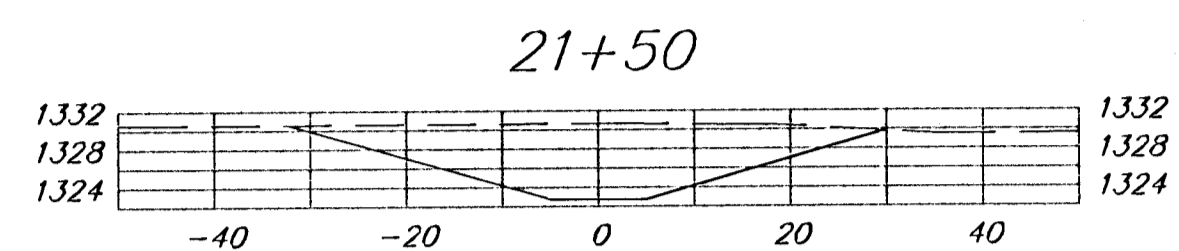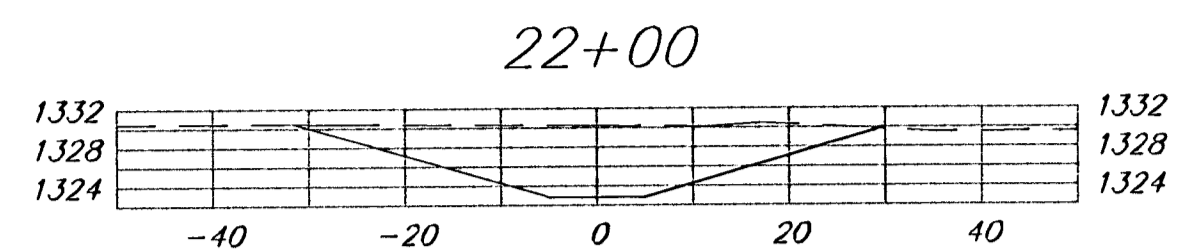

STATION	AREAS Square Feet		VOLUMES Cubic Yards		CUMULATIVE VOLUMES Cubic Yards	
	CUT	FILL	CUT	FILL	CUT	FILL
0+20	256.8193	0.0000				
0+50	174.7785	0.0000	239.7765	0.0000	239.7765	0.0000
1+00	386.0155	0.0000	519.2537	0.0000	759.0302	0.0000
1+50	463.2230	0.0000	786.3319	0.0000	1545.3621	0.0000
2+00	479.2184	0.0000	872.6309	0.0000	2417.9930	0.0000
2+50	481.6604	0.0000	871.1841	0.0000	3289.1770	0.0000
3+00	439.4564	0.0000	834.3675	0.0000	4123.5445	0.0000
3+50	398.7447	0.0000	776.1121	0.0000	4899.6566	0.0000
4+00	387.7545	0.0000	728.2399	0.0000	5627.8966	0.0000
4+50	398.2522	0.0000	727.7840	0.0000	6355.6805	0.0000
5+00	407.3201	0.0000	745.9003	0.0000	7101.5809	0.0000
5+50	403.2999	0.0000	750.5741	0.0000	7852.1549	0.0000
6+00	395.6267	0.0000	739.7468	0.0000	8591.9017	0.0000
6+50	391.1585	0.0000	728.5048	0.0000	9320.4065	0.0000
7+00	384.1276	0.0000	717.8575	0.0000	10038.2640	0.0000
7+50	379.5766	0.0000	707.1335	0.0000	10745.3975	0.0000
8+00	373.5933	0.0000	697.3795	0.0000	11442.7770	0.0000
8+50	366.3183	0.0000	685.1034	0.0000	12127.8804	0.0000
9+00	360.7267	0.0000	673.1898	0.0000	12801.0703	0.0000
9+50	352.9834	0.0000	660.8426	0.0000	13461.9129	0.0000
10+00	345.0165	0.0000	646.2961	0.0000	14108.2090	0.0000
10+50	340.7001	0.0000	634.9228	0.0000	14743.1318	0.0000
11+00	337.7147	0.0000	628.1619	0.0000	15371.2936	0.0000
11+50	334.0614	0.0000	622.0149	0.0000	15993.3085	0.0000
12+00	330.5916	0.0000	615.4194	0.0000	16608.7279	0.0000
12+50	330.0749	0.0000	611.7282	0.0000	17220.4561	0.0000
13+00	336.3284	0.0000	617.0401	0.0000	17837.4962	0.0000
13+50	327.5723	0.0000	614.7229	0.0000	18452.2190	0.0000
14+00	319.6001	0.0000	599.2337	0.0000	19051.4527	0.0000
14+50	316.1178	0.0000	588.6277	0.0000	19640.0805	0.0000
15+00	313.0581	0.0000	582.5703	0.0000	20222.6507	0.0000
15+50	309.4011	0.0000	576.3511	0.0000	20799.0018	0.0000
16+00	311.5489	0.0000	574.9537	0.0000	21373.9554	0.0000
16+50	319.3182	0.0000	584.1361	0.0000	21958.0916	0.0000
17+00	328.5991	0.0000	599.9234	0.0000	22558.0150	0.0000
17+50	321.9723	0.0000	602.3809	0.0000	23160.3959	0.0000
18+00	323.6652	0.0000	597.8125	0.0000	23758.2084	0.0000
18+50	310.7102	0.0000	587.3846	0.0000	24345.5930	0.0000
19+00	311.8212	0.0000	576.4179	0.0000	24922.0110	0.0000
19+50	316.0336	0.0000	581.3470	0.0000	25503.3580	0.0000
20+00	308.5333	0.0000	578.3027	0.0000	26081.6606	0.0000
20+50	298.9438	0.0000	562.4788	0.0000	26644.1394	0.0000
21+00	294.2407	0.0000	549.2448	0.0000	27193.3842	0.0000
21+50	289.4264	0.0000	540.4324	0.0000	27733.8167	0.0000
22+00	267.5273	0.0000	515.6979	0.0000	28249.5145	0.0000
22+50	250.1654	0.0000	479.3451	0.0000	28728.8596	0.0000
23+00	222.7166	0.0000	437.8536	0.0000	29166.7133	0.0000
23+50	238.6463	0.0000	427.1879	0.0000	29593.9011	0.0000
24+00	258.0014	0.0000	459.8590	0.0000	30053.7601	0.0000
24+50	280.5964	0.0000	498.7017	0.0000	30552.4618	0.0000
25+00	290.9509	0.0000	529.2104	0.0000	31081.6722	0.0000
25+50	300.5414	0.0000	547.6780	0.0000	31629.3502	0.0000
26+00	311.1509	0.0000	566.3817	0.0000	32195.7320	0.0000
26+50	305.2979	0.0000	570.7860	0.0000	32766.5179	0.0000
27+00	291.6903	0.0000	582.7889	0.0000	33319.2818	0.0000
27+50	273.7629	0.0000	523.5678	0.0000	33842.8526	0.0000
27+74.75	273.7629	0.0000	250.9583	0.0000	34093.8109	0.0000
			0.0000	0.0000	34093.8109	0.0000

