

* PRIOR TO BEGINNING CONSTRUCTION, THE CONTRACTOR SHALL EXCAVATE THE EXISTING 8" WATERLINE AT STATION WL 1, 29+77.19 AND THE EXISTING 8" WATERLINE AT STATION WL 6, 0+00.00 TO VERIFY PIPE SIZE, TYPE, FITTINGS, AND HORIZONTAL AND VERTICAL LOCATION. THE CONTRACTOR SHALL REPORT HIS FINDINGS TO THE ENGINEER SO THAT ANY NECESSARY PLAN MODIFICATIONS CAN BE MADE. ANY ADDITIONAL LABOR OR MATERIALS NECESSARY TO COMPLETE THE CONNECTION SHALL BE CONSIDERED SUBSIDIARY TO THE PROJECT.


NOTE: FIRE DEPARTMENT CONNECTION BY MECHANICAL CONTRACTOR. FIRE SERVICE LINE IS THE RESPONSIBILITY OF THE UNDERGROUND WATERLINE CONTRACTOR TO THE BACKFLOW PREVENTOR INSIDE THE BUILDING.

3" DOMESTIC METER VAULT
See Sheet no. C-608
WL 5 Sta. 0+15 to WL 5 Sta. 0+23

N: 20,770.7905, E: 22,099.8023
WL 1, Sta. 20+26.51=
WL 4, Sta. 0+00.00 (FP)
1- 8" x 6" CI CL MJ Tee
1- 6" Anchored Valve Assembly (S)
(MJ Gate Valve)
Top Valve Box El.= 1427.0
8.04'-8" DI CL SJ Pipe (E)

N: 20,770.7905, E: 22,107.8439
WL 1, Sta. 20+34.55=
WL 5, Sta. 0+00.00
1- 8" x 4" CI CL MJ Tee
1- 4" Anchored Valve Assembly (S)
(MJ Gate Valve)
Top Valve Box El.= 1426.9

N: 20,770.7905, E: 22,153.4073
WL 1, Sta. 20+80.12
1- Fire Hydrant Assembly
L= 4'
Top Valve Box El.= 1426.6
FH Bury Line El.= 1426.6

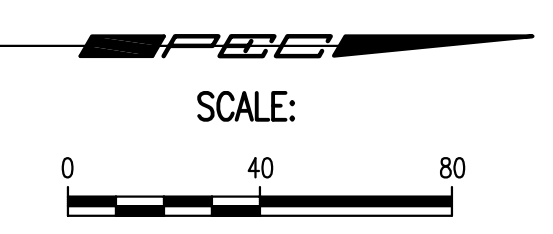

AS BUILT 4/15/2009

No.	Revision	By	Date

WATER DISTRIBUTION SYSTEM IMPROVEMENTS
EISENHOWER MIDDLE SCHOOL - USD 265
GODDARD, KANSAS

WATER LINE PLAN (EAST)
JAMES L. ARMOUR, P.E. - CITY ENGINEER
PRIVATE PROJECT NO. 1450 PFW (607853)

Professional Engineering Consultants, P.A.
303 S. TOPEKA • WICHITA, KANSAS 67202
316-262-2691 • FAX 316-262-3003

Designed by	RRY, MDK	Job No.	35-08430-259	Sht.	C605
Drawn by	TDS	Date	OCTOBER 2008		

Scaled 01-08-2009 3:13:16 PM by CSI
 Plot Scale 1:40 01-21-2009 1:19:17 PM by RWW
 C:\2009\08430\CHANGE ORDER\PPW\08430-C-605-WATER PLAN EAST