
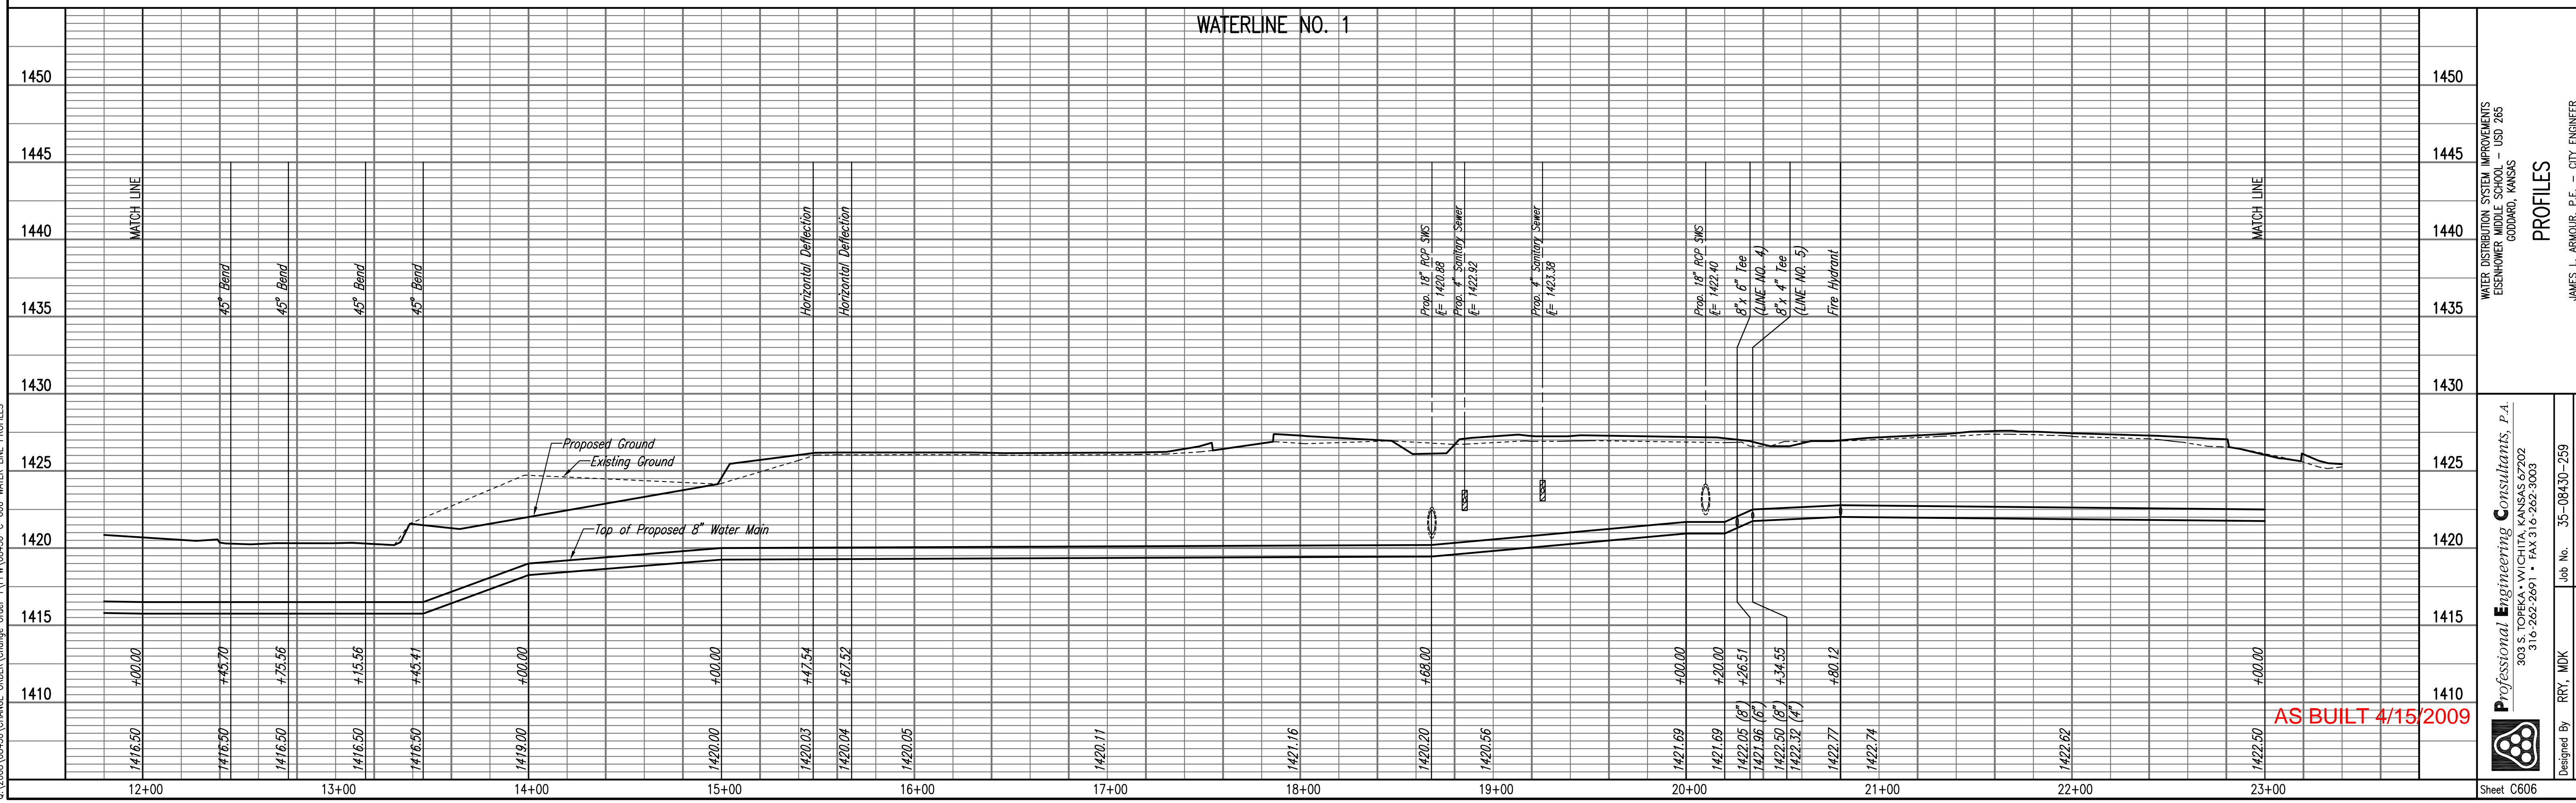


PROFILE CHECKED CHECKED
BY DATE

PROFILE CHECKED CHECKED
BY DATE

Drawn By: RRY, MDK
Date: OCTOBER 2008
Job No.: 35-08430-259
Professional Engineering Consultants, P.A.
303 S. TOPEKA AVENUE, KANSAS CITY, MO 64108
316.202.2091 • FAX 316.202.3003

Saved: 01-19-2009 1:57:10 PM by RYT
Plot Scale: 1"=40'
0:\2008\08430\CHANGE ORDER\1\PPM\08430-C-606-WATER LINE PROFILES

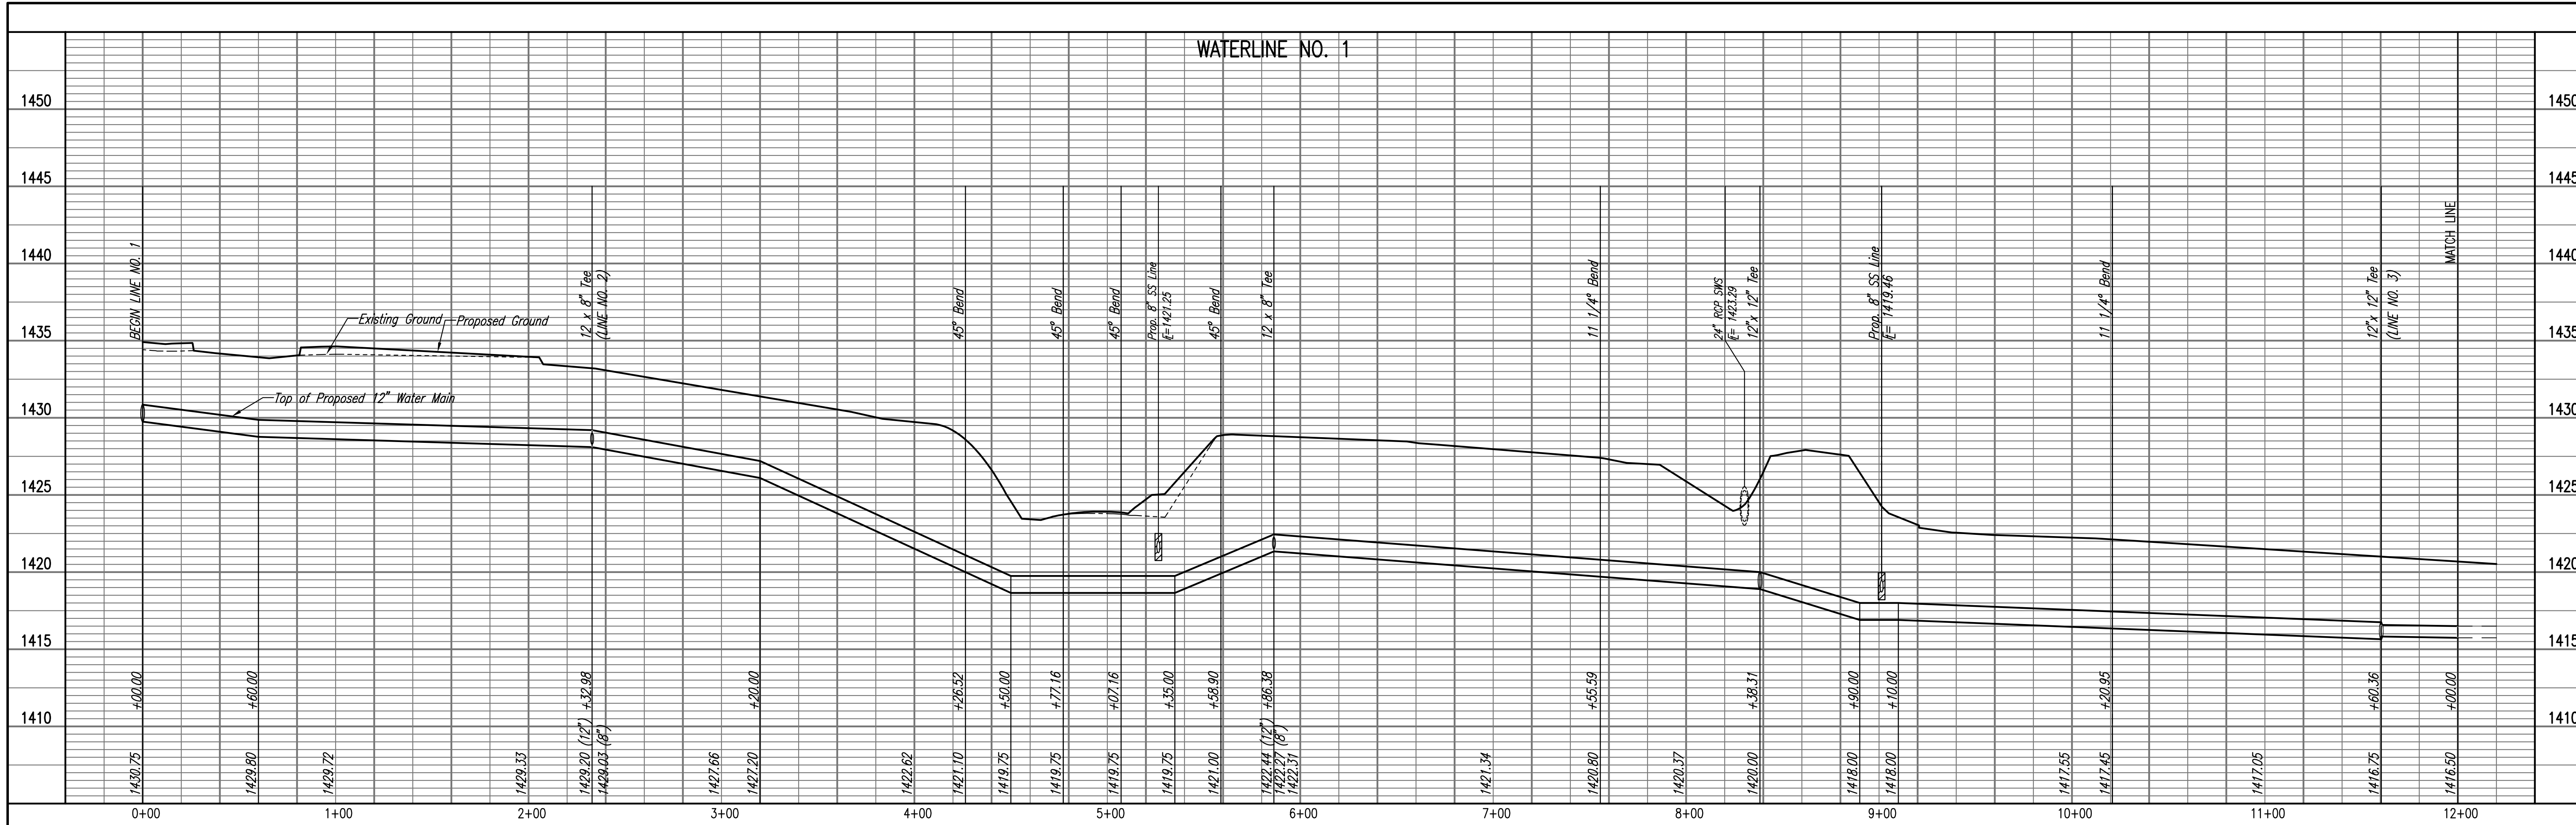

AS BUILT 4/15/2009