
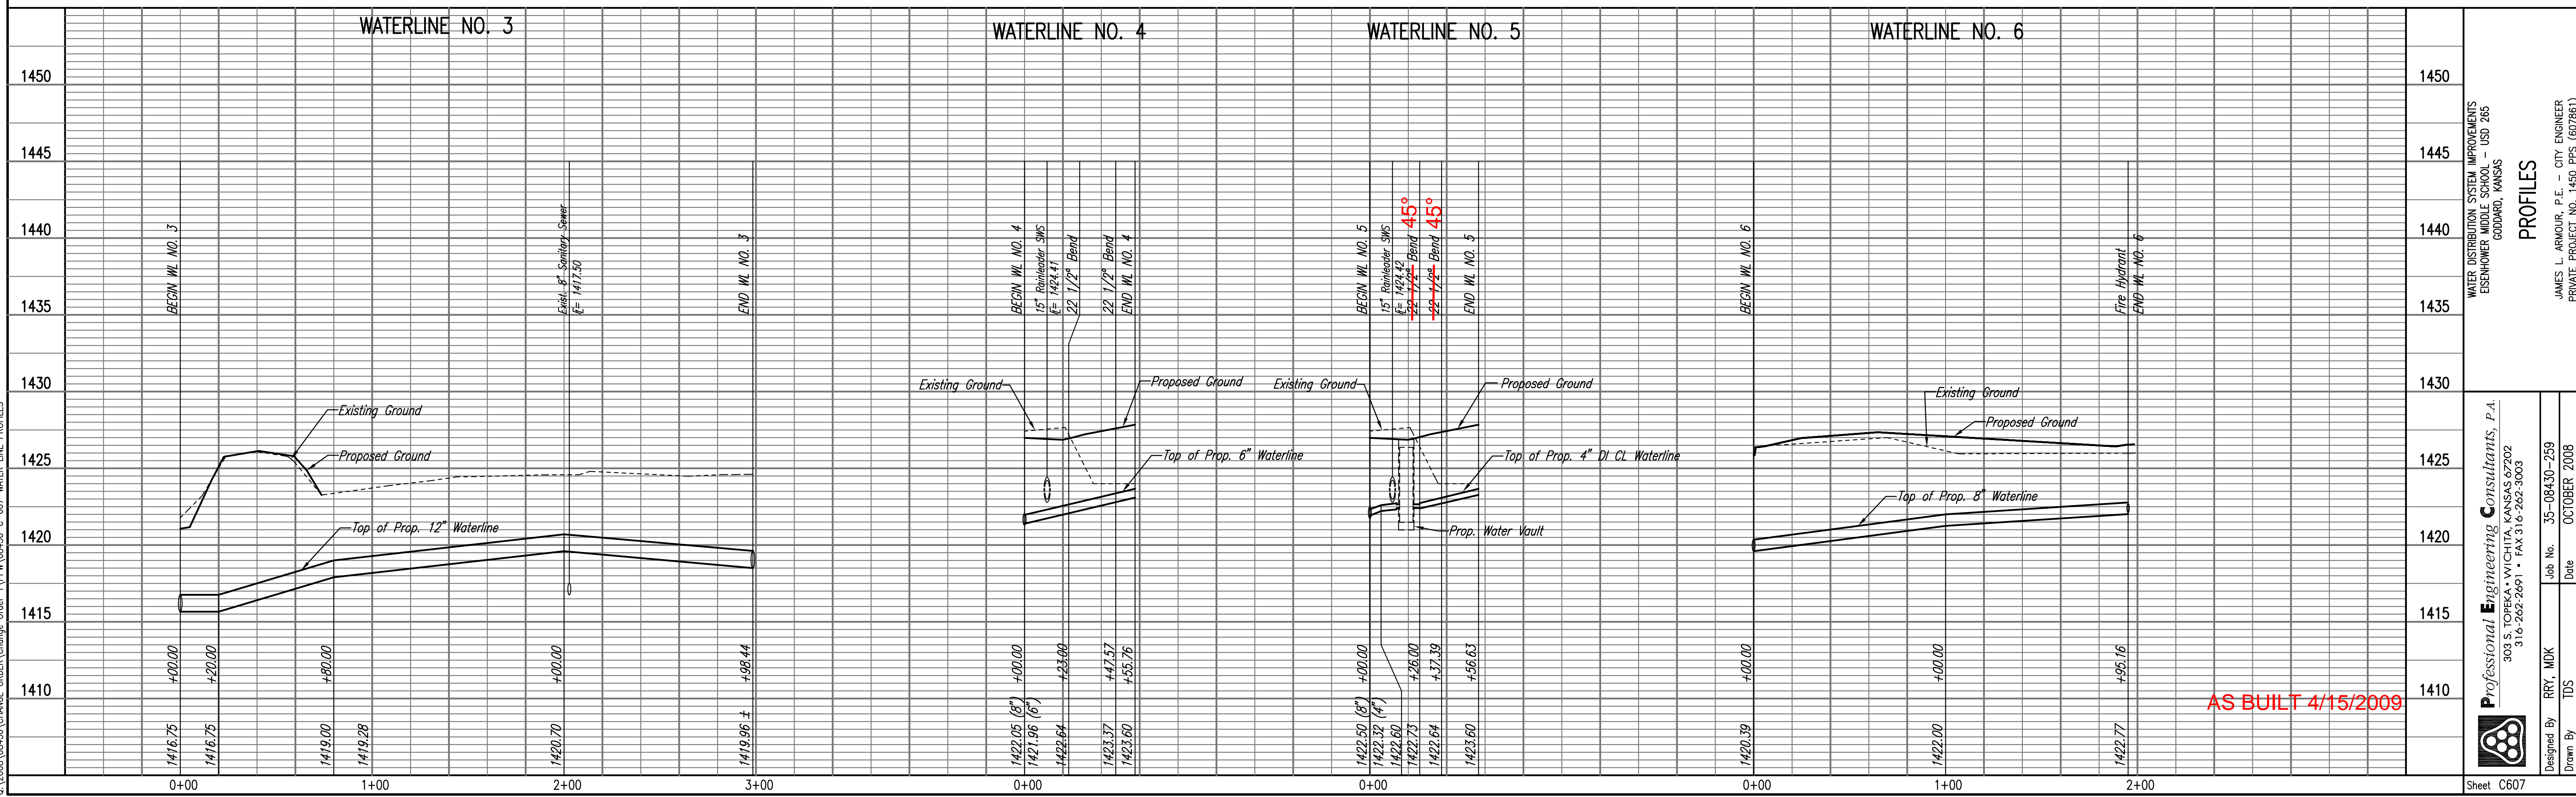


PROFILE
 CHECKED
 CHECKED
 BY
 DATE

PROFILE
 CHECKED
 CHECKED
 BY
 DATE

Saved: 01-06-2009 8:17:34 AM by R/W
 Plot Scale: 1"=40' 01-21-2009 1:18:38 PM
 Q:\2008\08430\CHANGE ORDER\1\PPM\08430-C-607-WATER LINE PROFILES

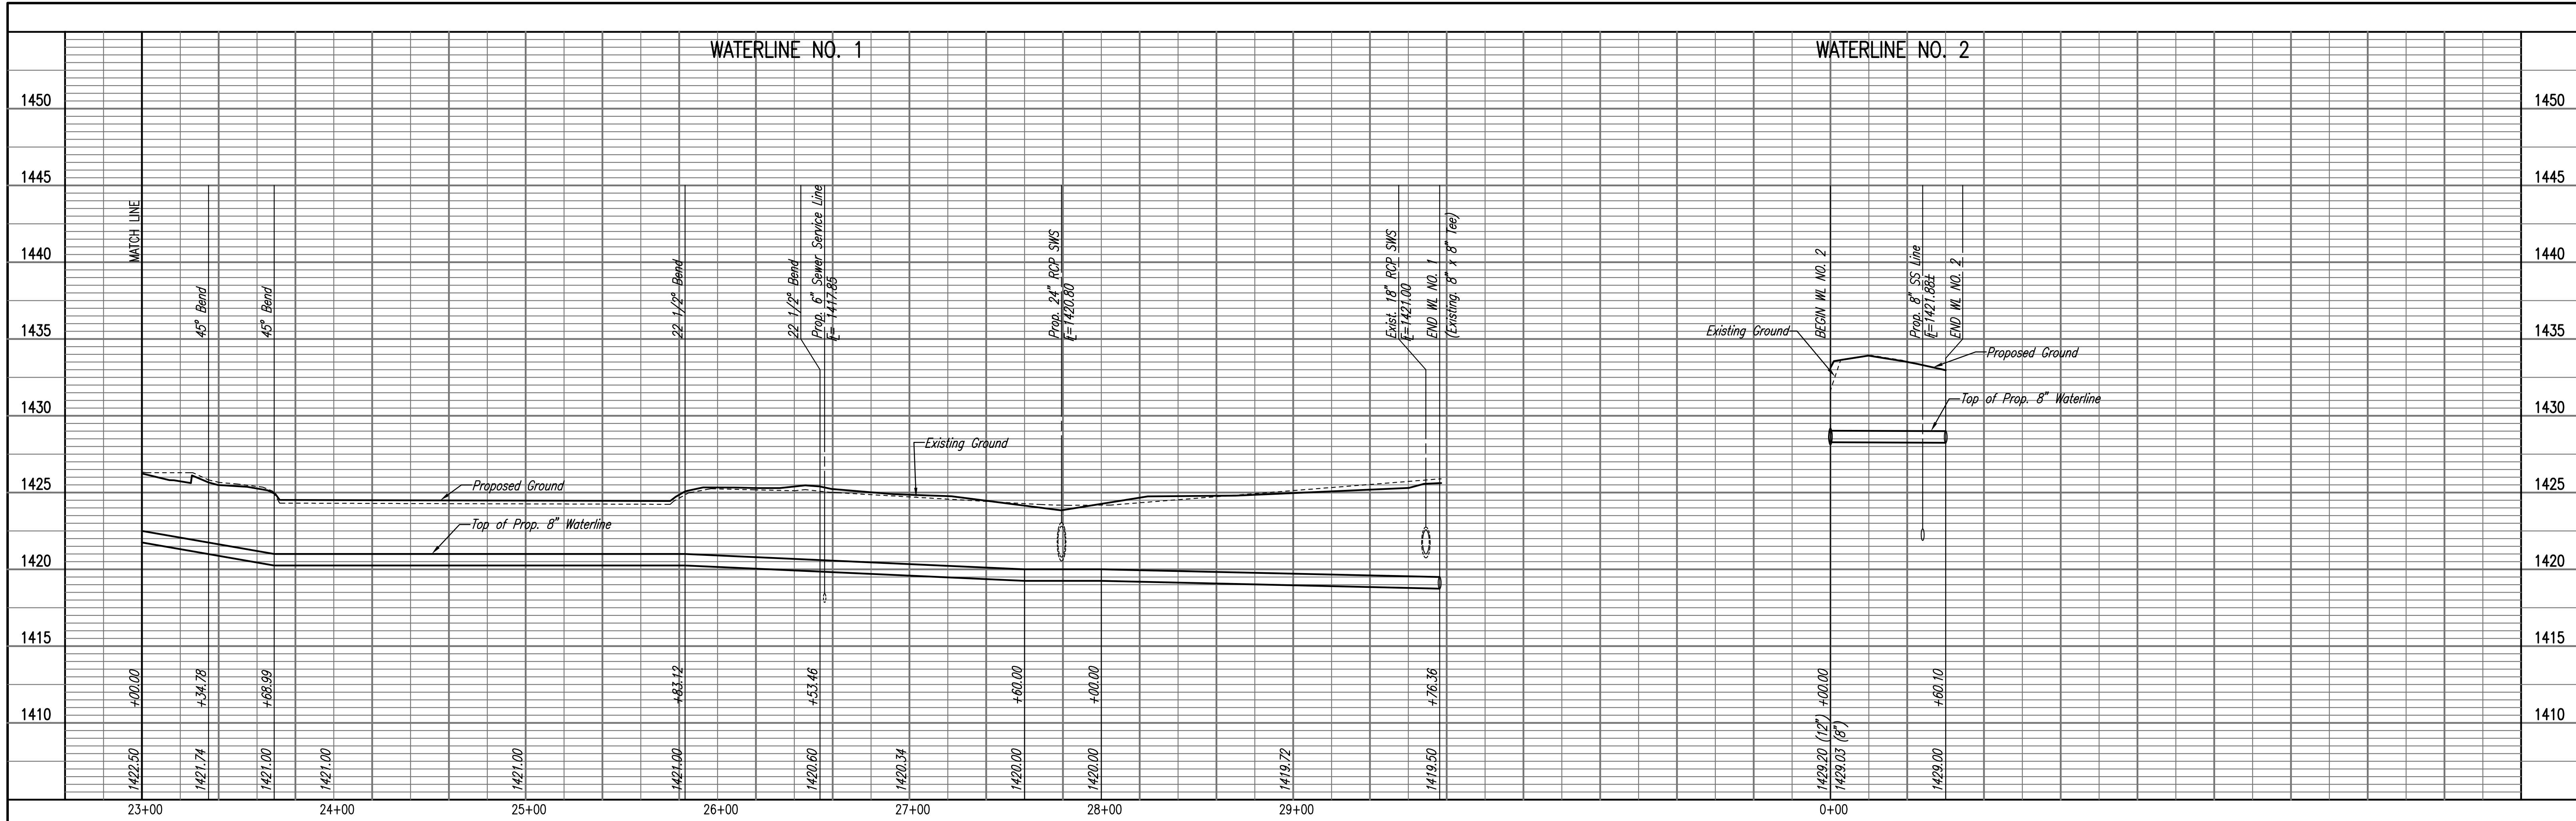

AS BUILT 4/15/2009