

ENGINEERING DEPARTMENT

CITY OF WICHITA

MISCELLANEOUS INFORMATION

Signed MEHOLANDER

Contractor CORNELL & SONS

Date 7 15 9

Project

EVERGREEN LANE to serve EVERGREEN ADDITION

Project Number

972-84647 / 766199 / 490217


PROJECT WAS COMPLETED PER SPECIFICATIONS

SEE SKETCHES ON REVERSE FOR CHANGES

Sketches, etc.

STA 18+20 CURB INLETS
LEFT CONCRETE FLUME 6'
RIGHT CONCRETE FLUME 14'

TAPERED "CURB" ADDED TO FLUMES
AS A RETAINING WALL
DOWELLED INTO CURB INLET AND
FLUME WITH RE BAR.

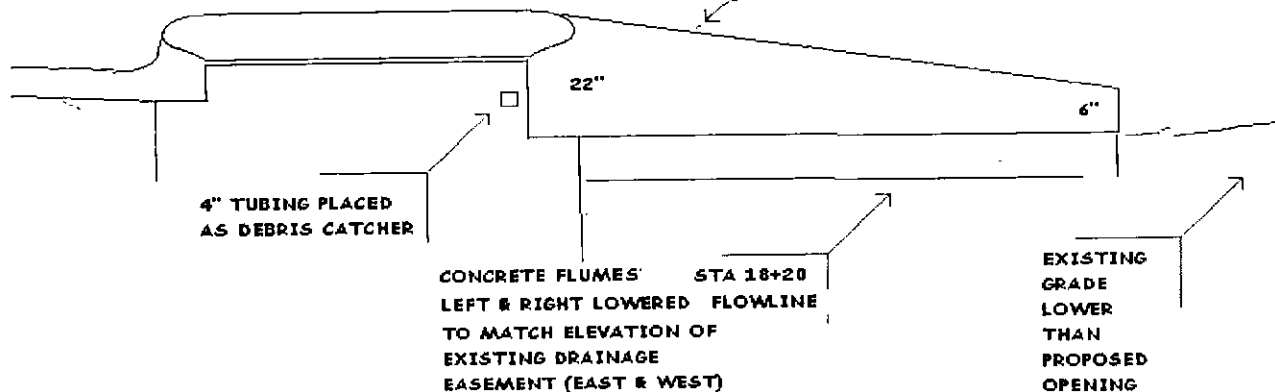

NOT TO SCALE