
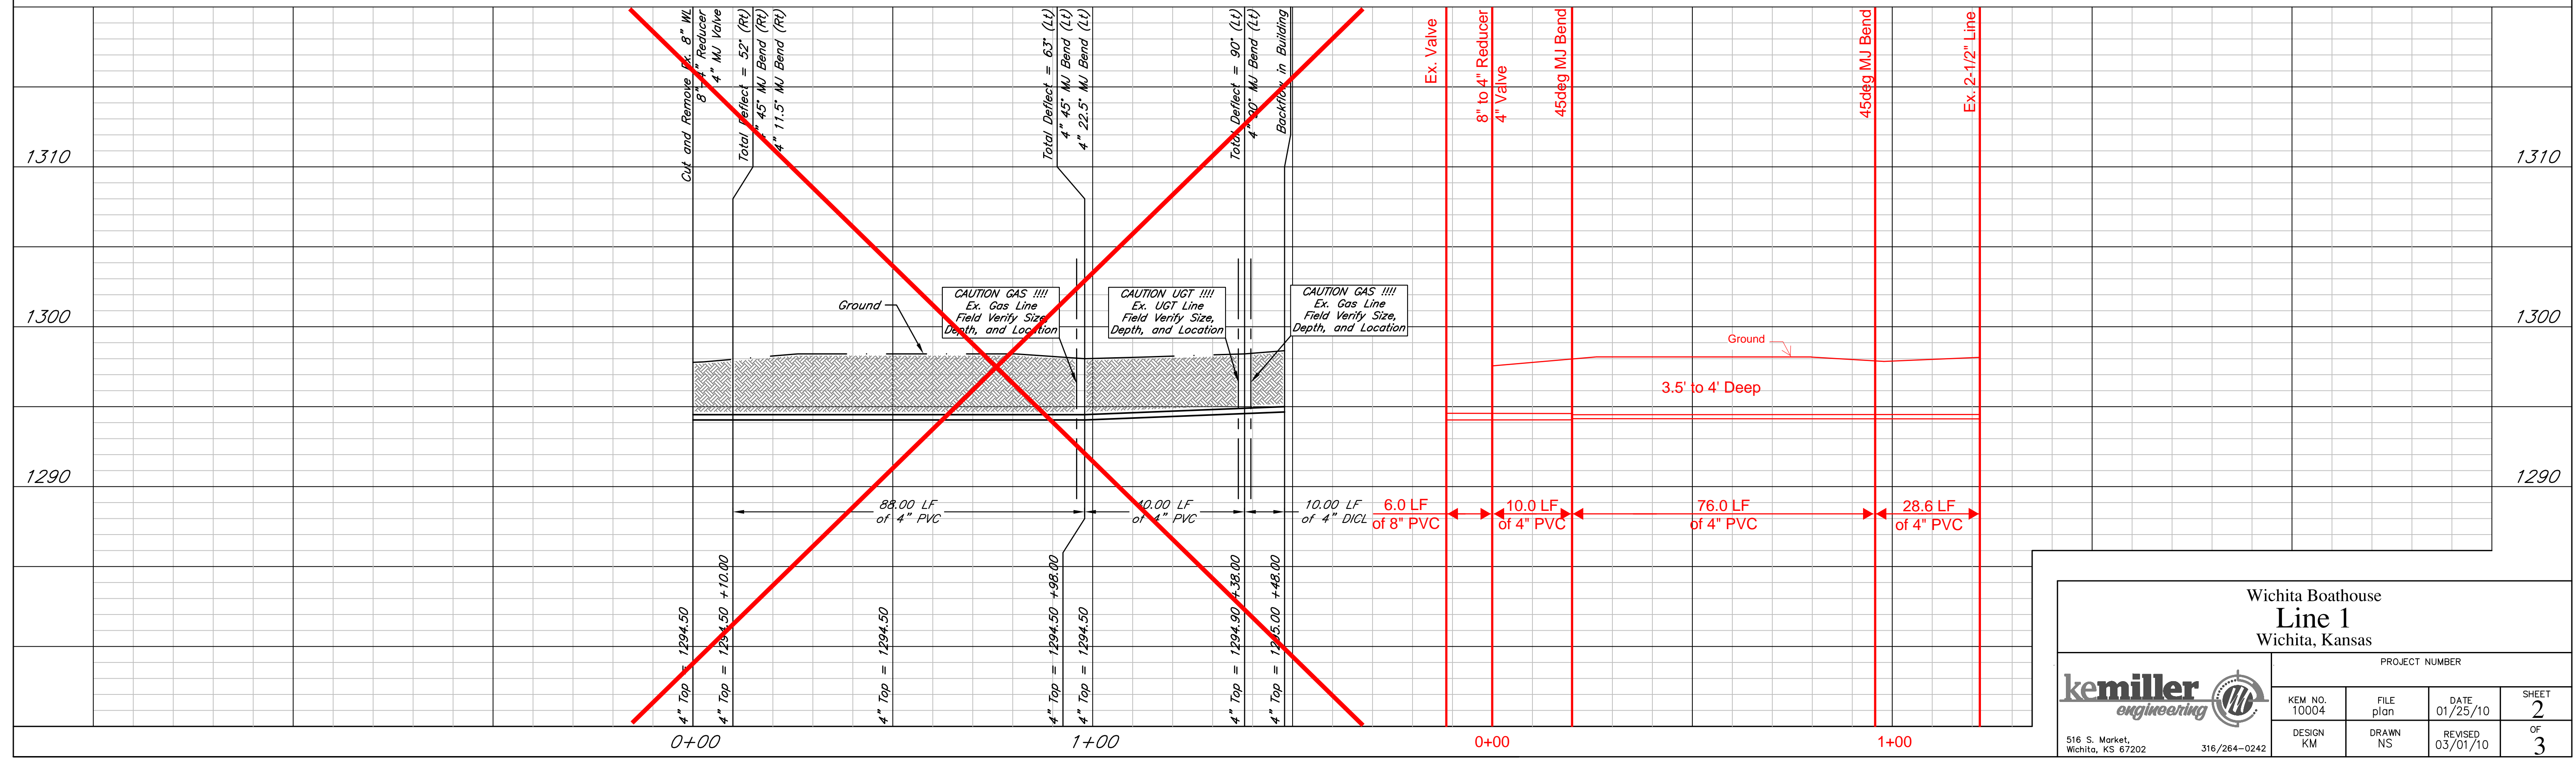


As Built
Details

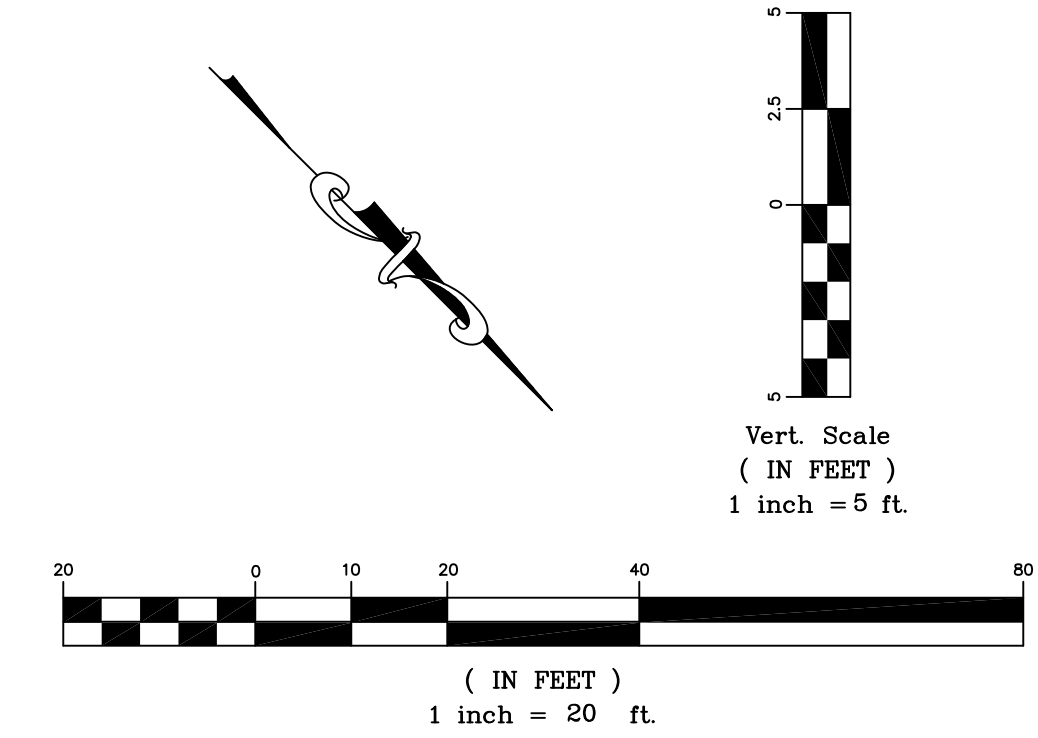

Wichita Boathouse
Line 1
Wichita, Kansas

PROJECT NUMBER			
	KEM NO. 10004	FILE plan	DATE 01/25/10
DESIGN KM	DRAWN NS	REVISED 03/01/10	SHEET 2 OF 3
516 S. Market, Wichita, KS 67202		316/264-0242	