

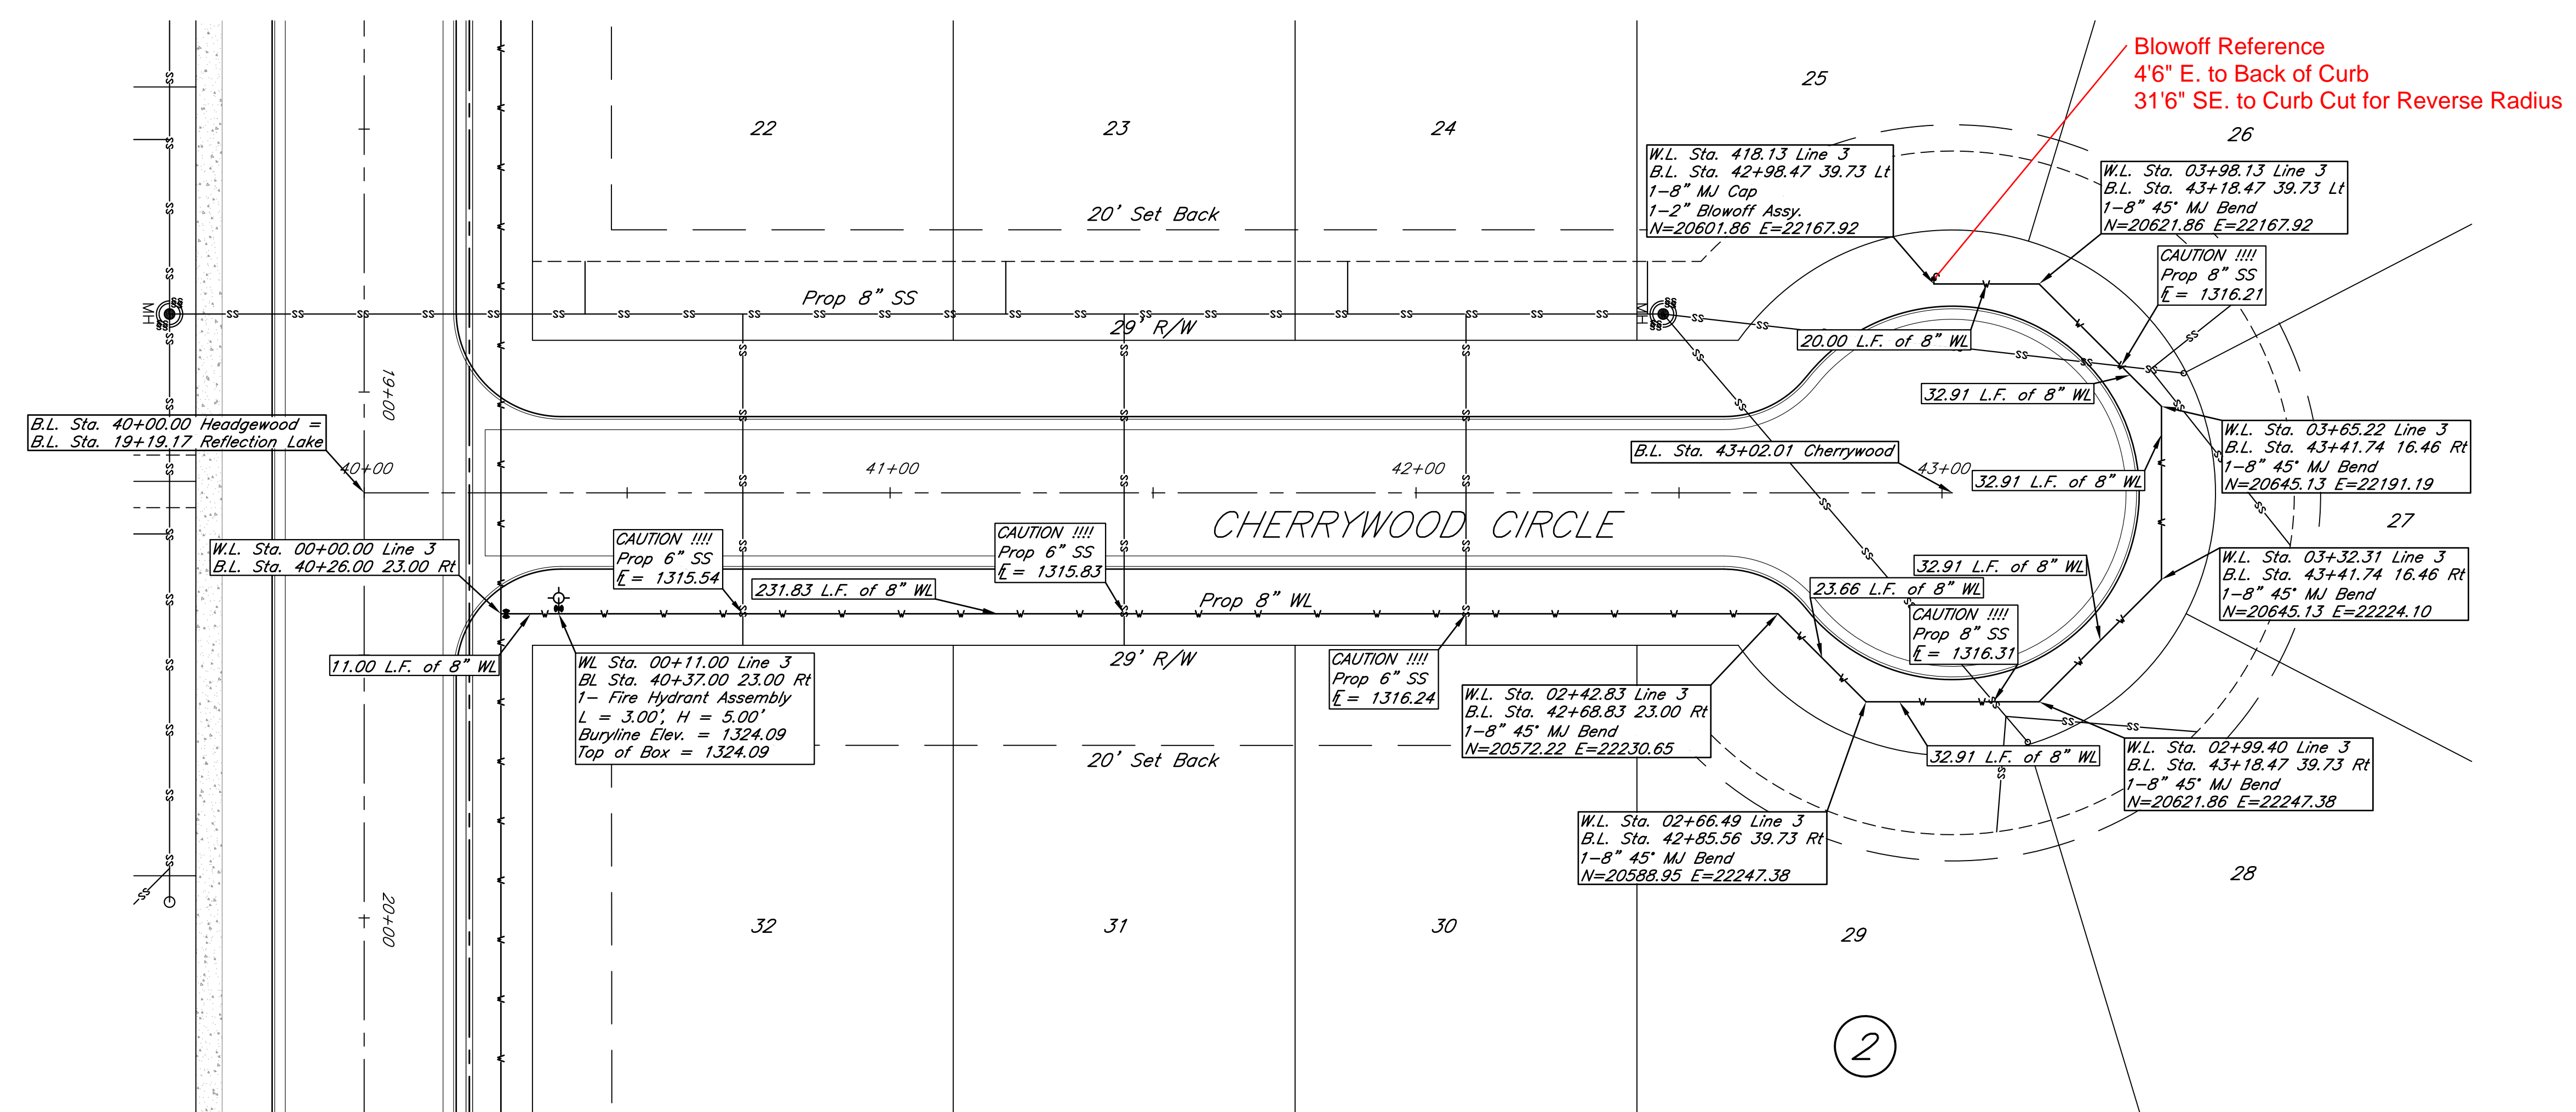


FHWA REG. NO.	STATE	PROJECT NO.:	YEAR	SHEET NUMBER	TOTAL SHEETS
	KANSAS				

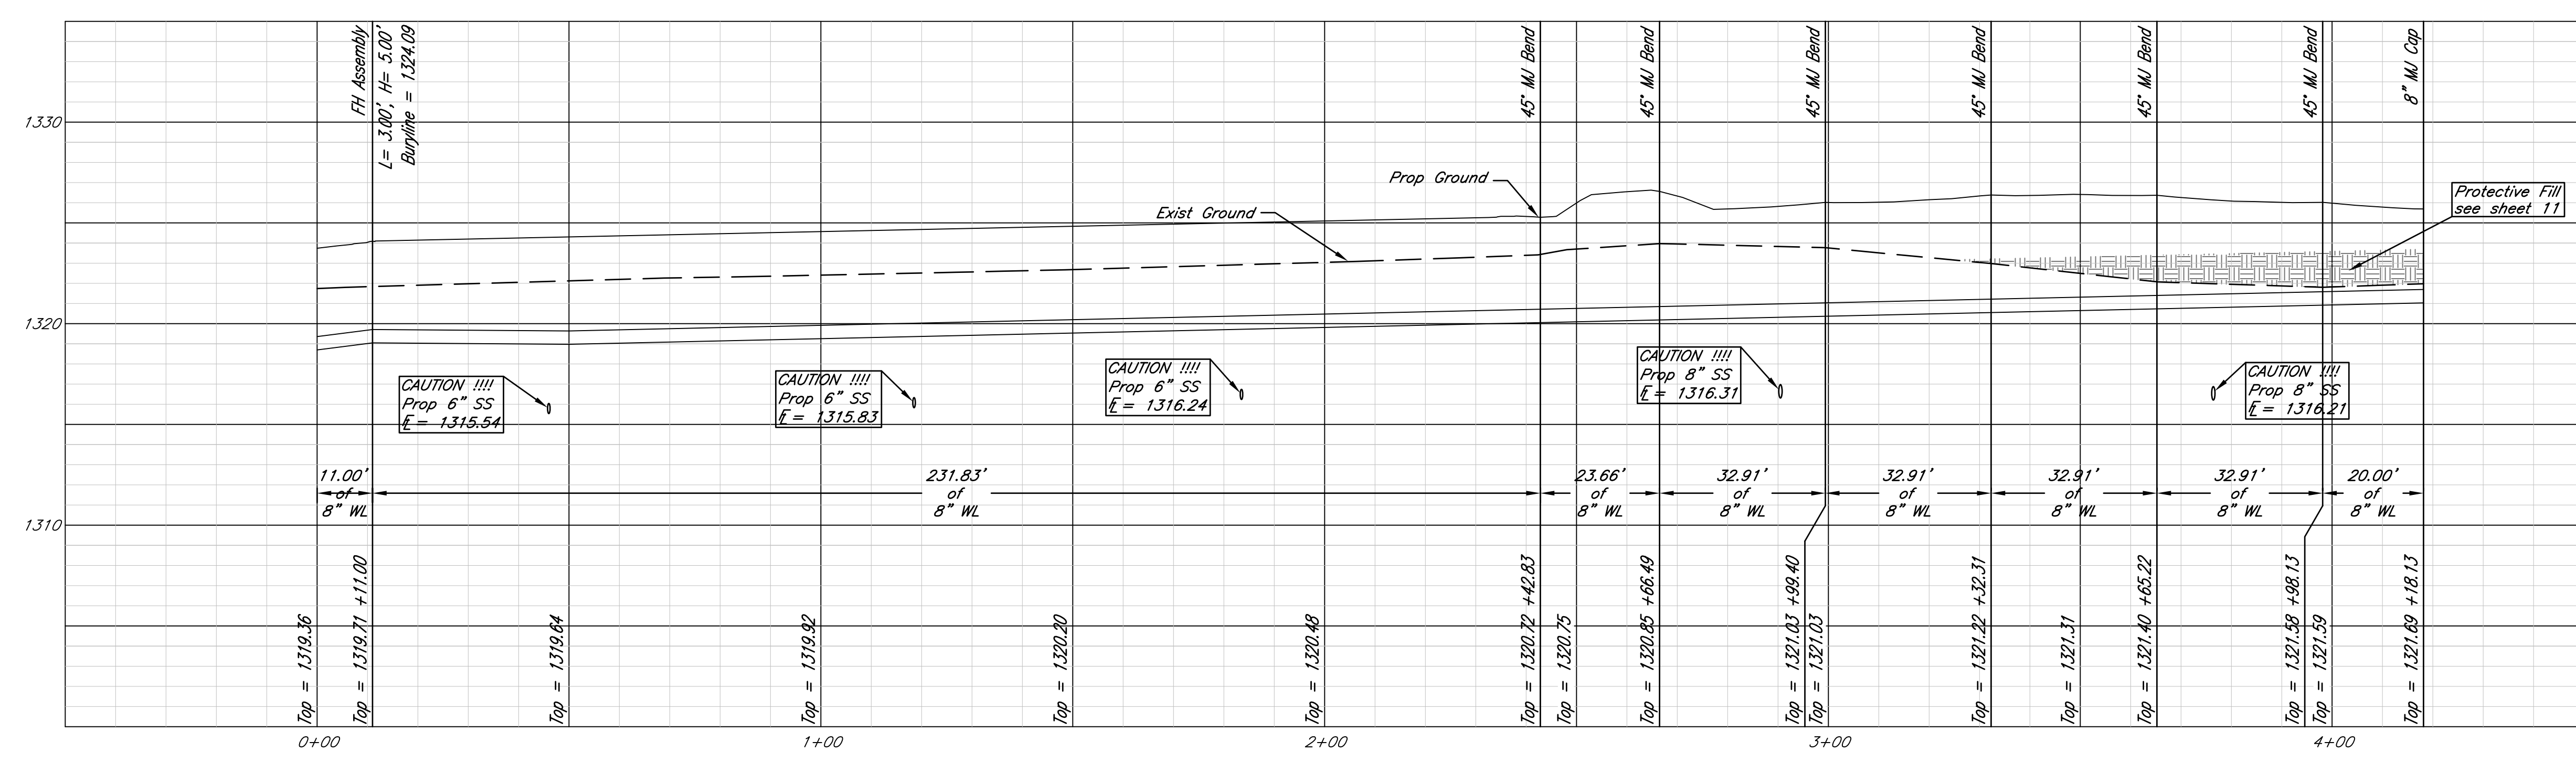

RECORD DRAWING
3-29-2010

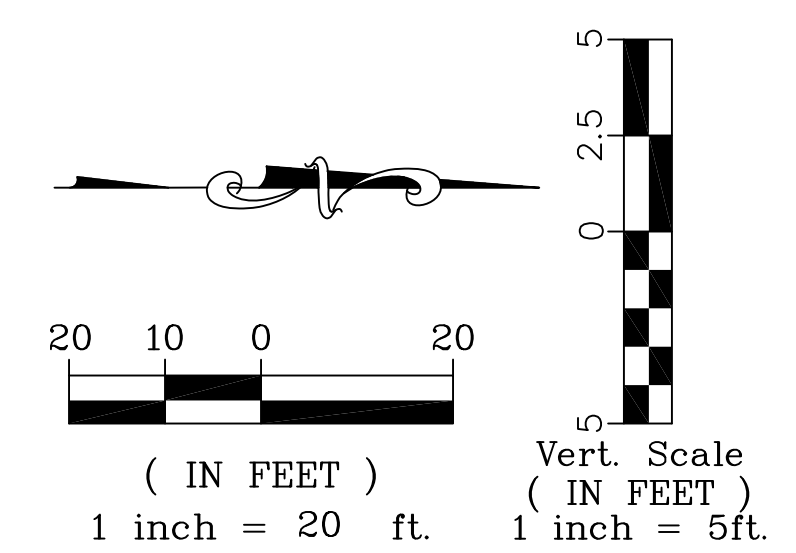

516 S. Main Street
Andover, MO 64802
316/264-0242

Reflection Lake 3rd Addition Line 3 00+00 - 04+19 Andover, Kansas	
KEM NO. 06128	FILE water
DESIGN KM	DRAWN NS
DATE 5/2008	REVISED 03/05/09
PROJECT NUMBER	
PROJECT NUMBER	
SHEET 6 OF 11	