




FHWA REG. NO.	STATE	PROJECT NO.:	YEAR	SHEET NUMBER	TOTAL SHEETS
	KANSAS			7	11

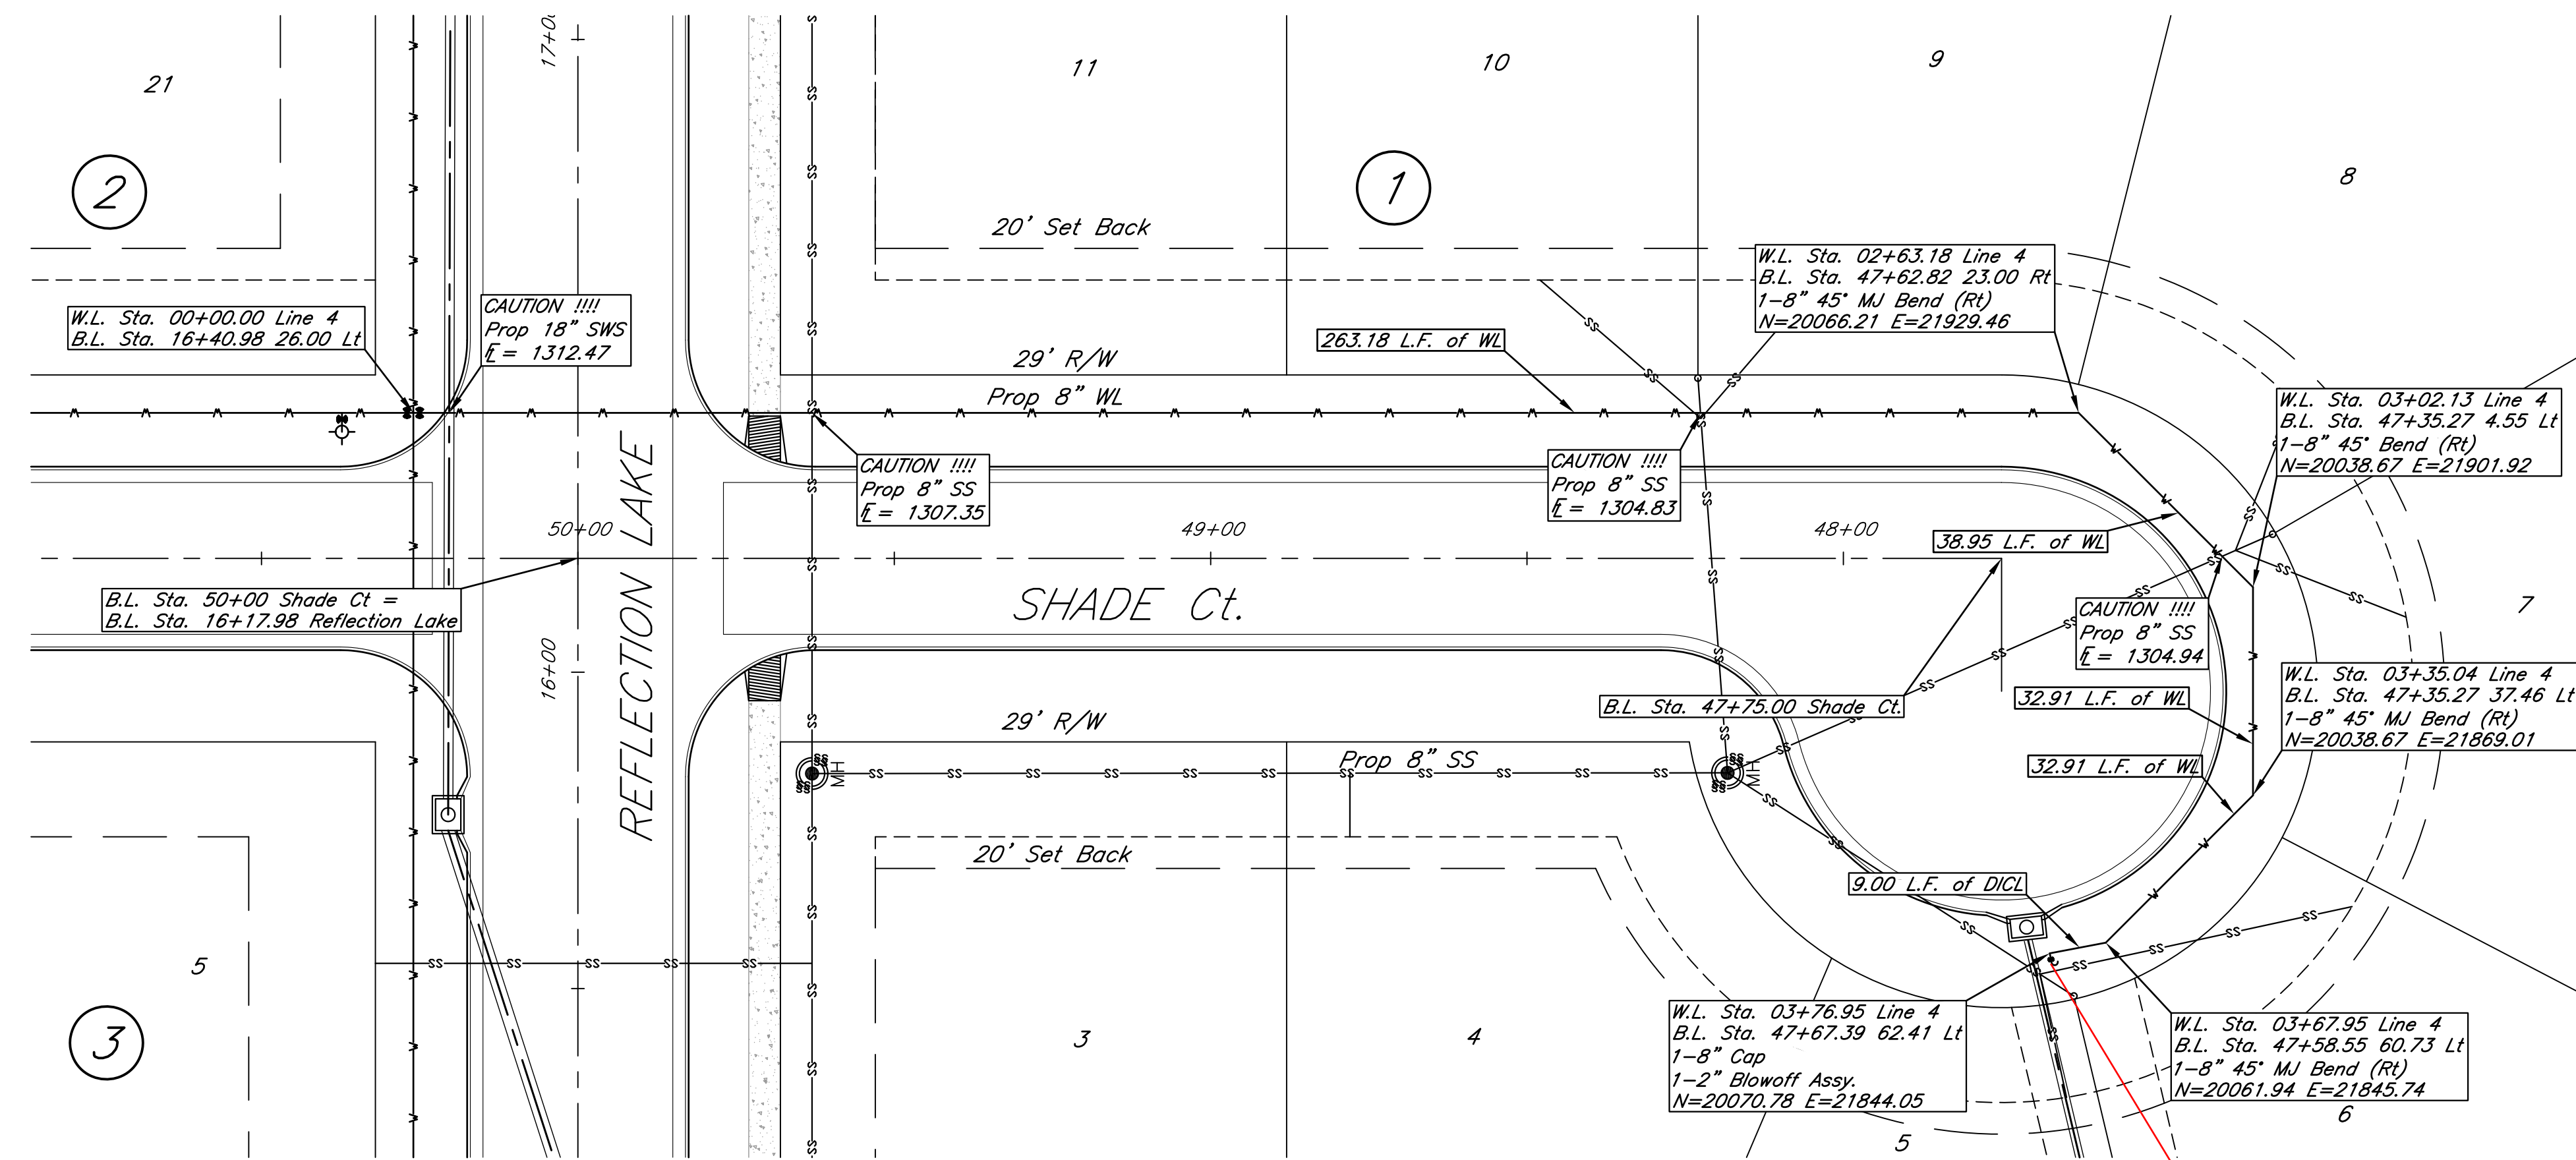


Blowoff Reference
7'8" E. to S. Curb Cut for Inlet
11'3" N. to N. Curb Cut for Inlet

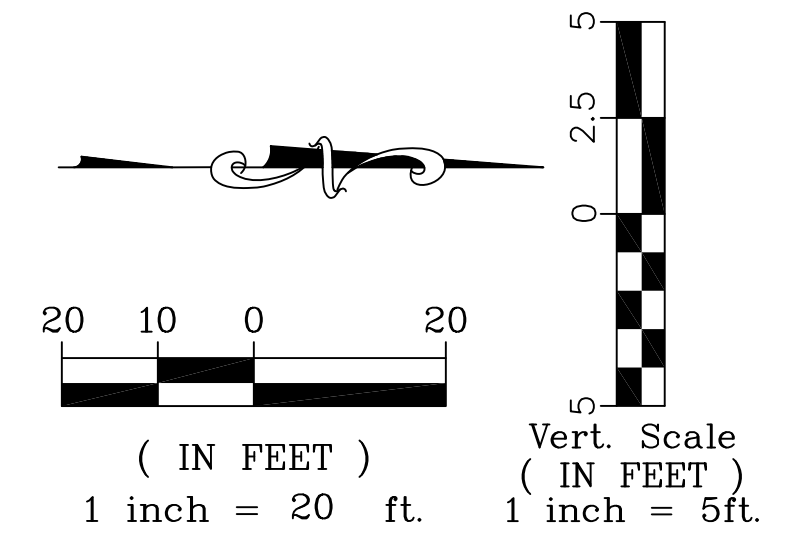

RECORD DRAWING
3-29-2010

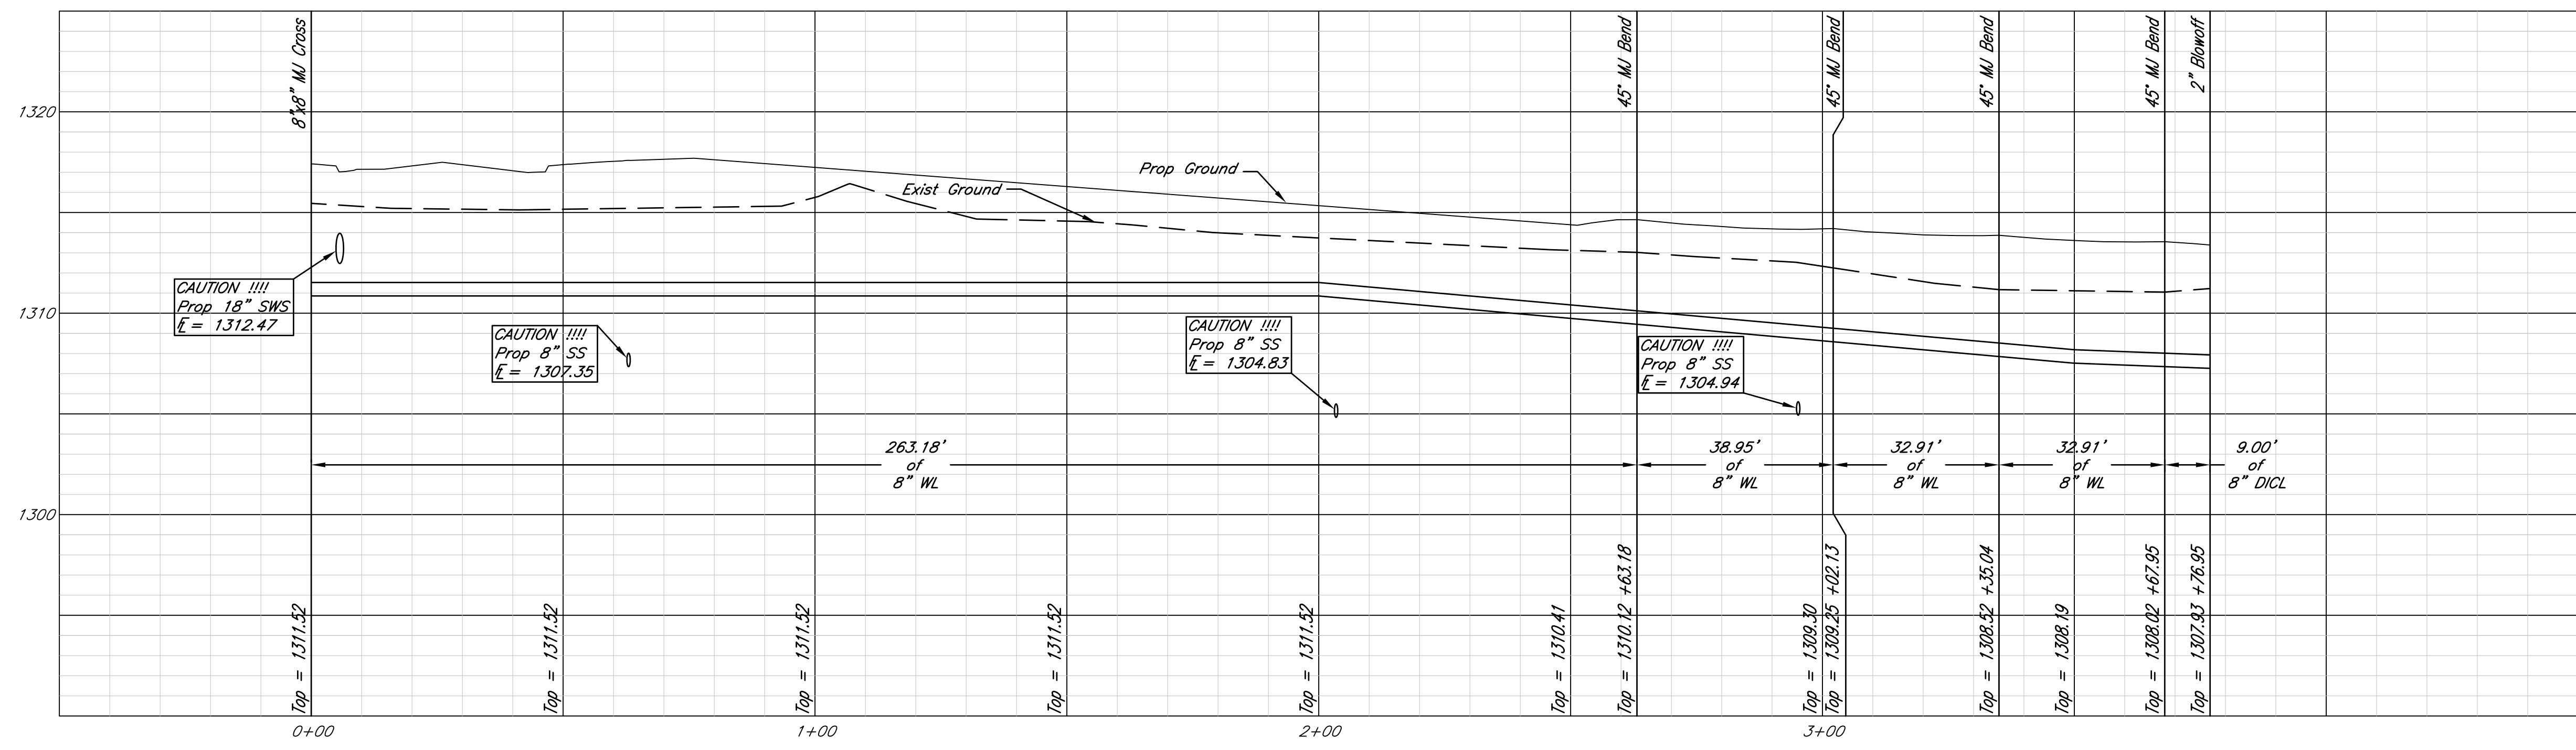


 516 S. Market,
 Wichita, KS 67202
 316/264-0242

Reflection Lake 3rd Addition
Line 4 00+00 - 03+88
 Andover, Kansas

KEM NO 06128	FILE water
DESIGN KM	DRAWN NS
DATE 5/2008	REVISED

PROJECT NUMBER
 SHEET
7
 OF
11