



FHWA REG. NO.	STATE	PROJECT NO.:	YEAR	SHEET NUMBER	TOTAL SHEETS
	KANSAS				




WL Sta. 00+13.00 Line 5
 BL Sta. 70+43.19 23.00 Lt
 1- Fire Hydrant Assembly
 L = 3.00', H = 7.00'
 Buryline Elev. = 1309.18
 Top of Box = 1309.18

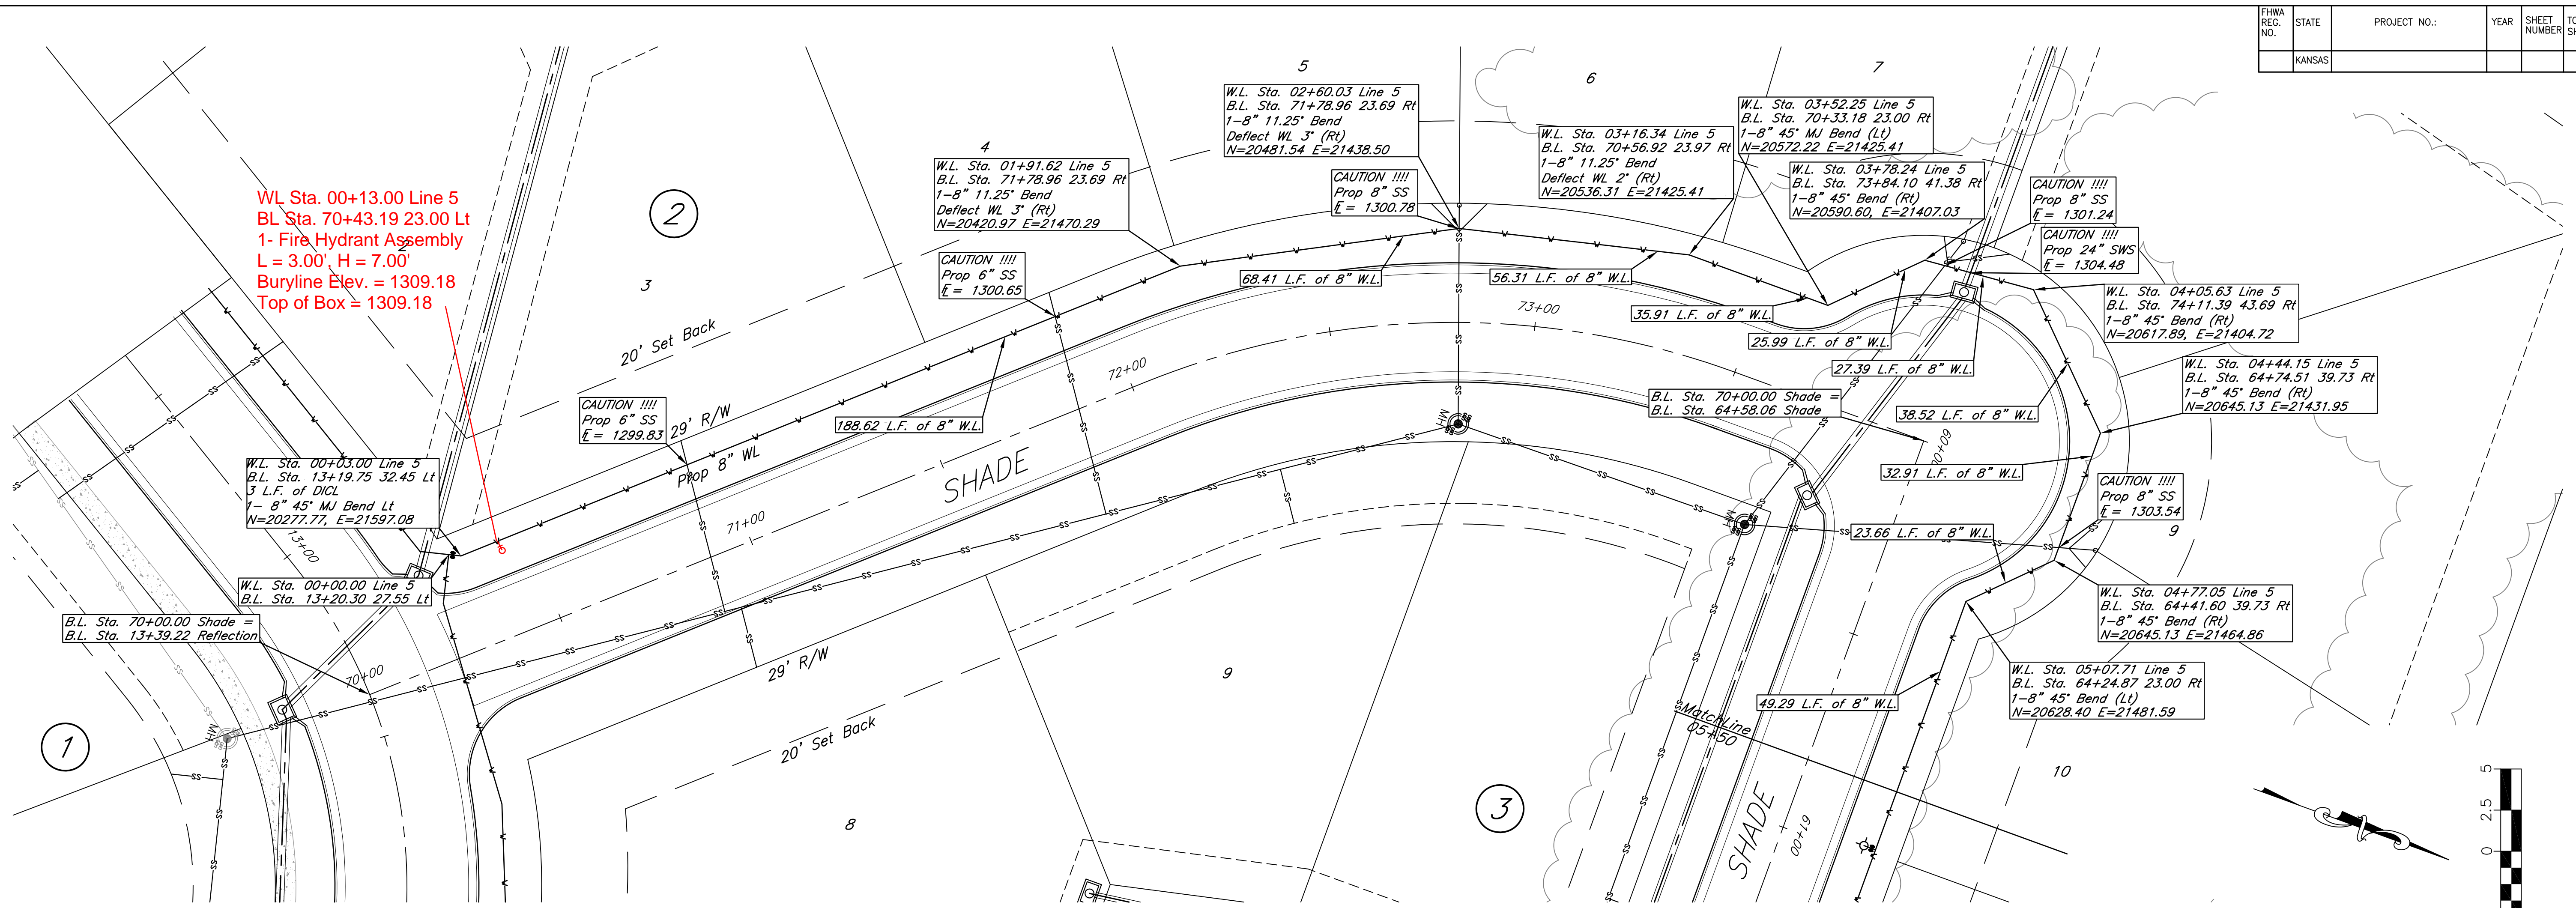

RECORD DRAWING
 3-29-2010

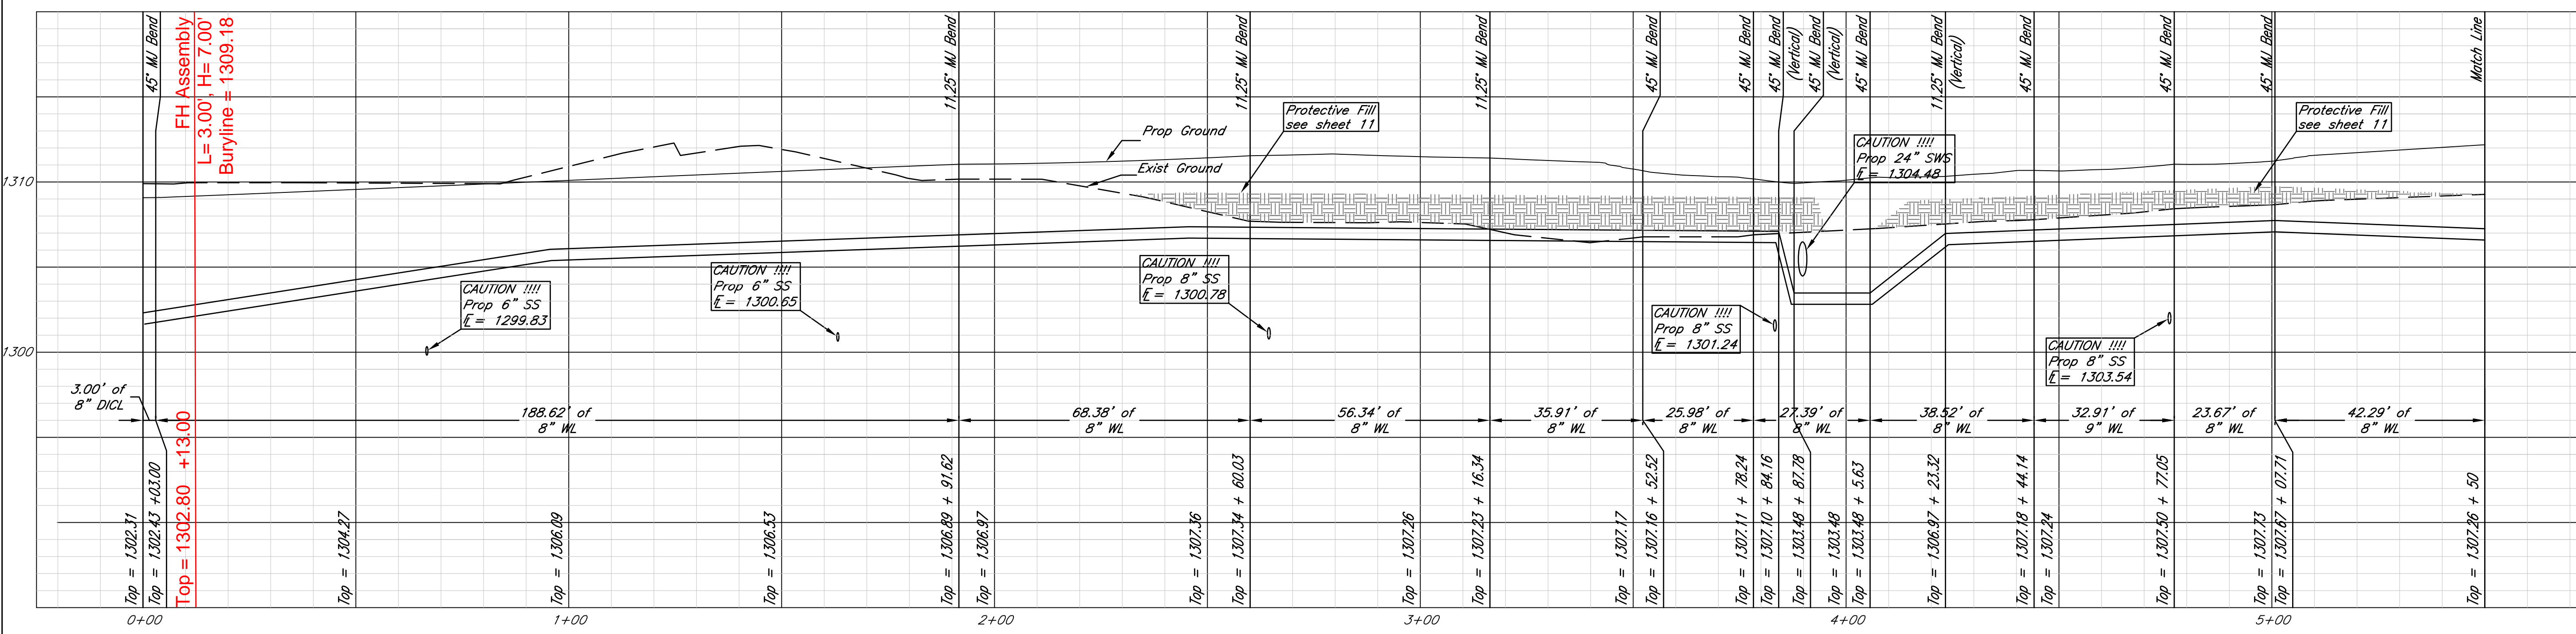


 316/284-0242
 515 S. Wichita
 Wichita, KS 67202

PROJECT NUMBER
 Reflection Lake 3rd Addition
 Line 5 00+00 - 05+50
 Andover, Kansas

KEM NS 06128	FILE water
DESIGN KM	DRAWN NS
DATE 5/2008	REVISED 03/13/09

SHEET
 8
 OF
 11