

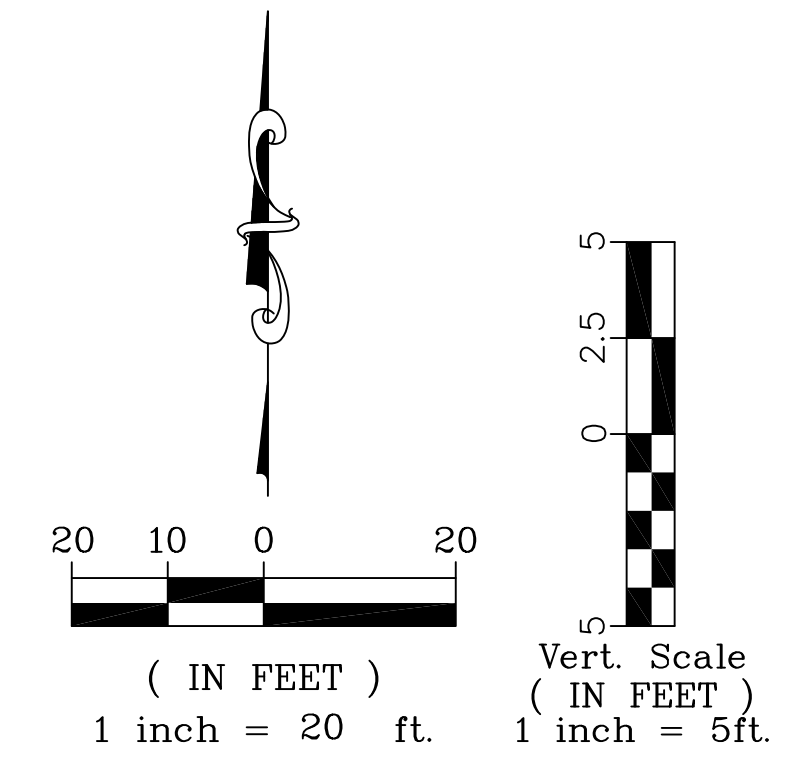


FHWA REG. NO.	STATE	PROJECT NO.:	YEAR	SHEET NUMBER	TOTAL SHEETS
	KANSAS			9	11

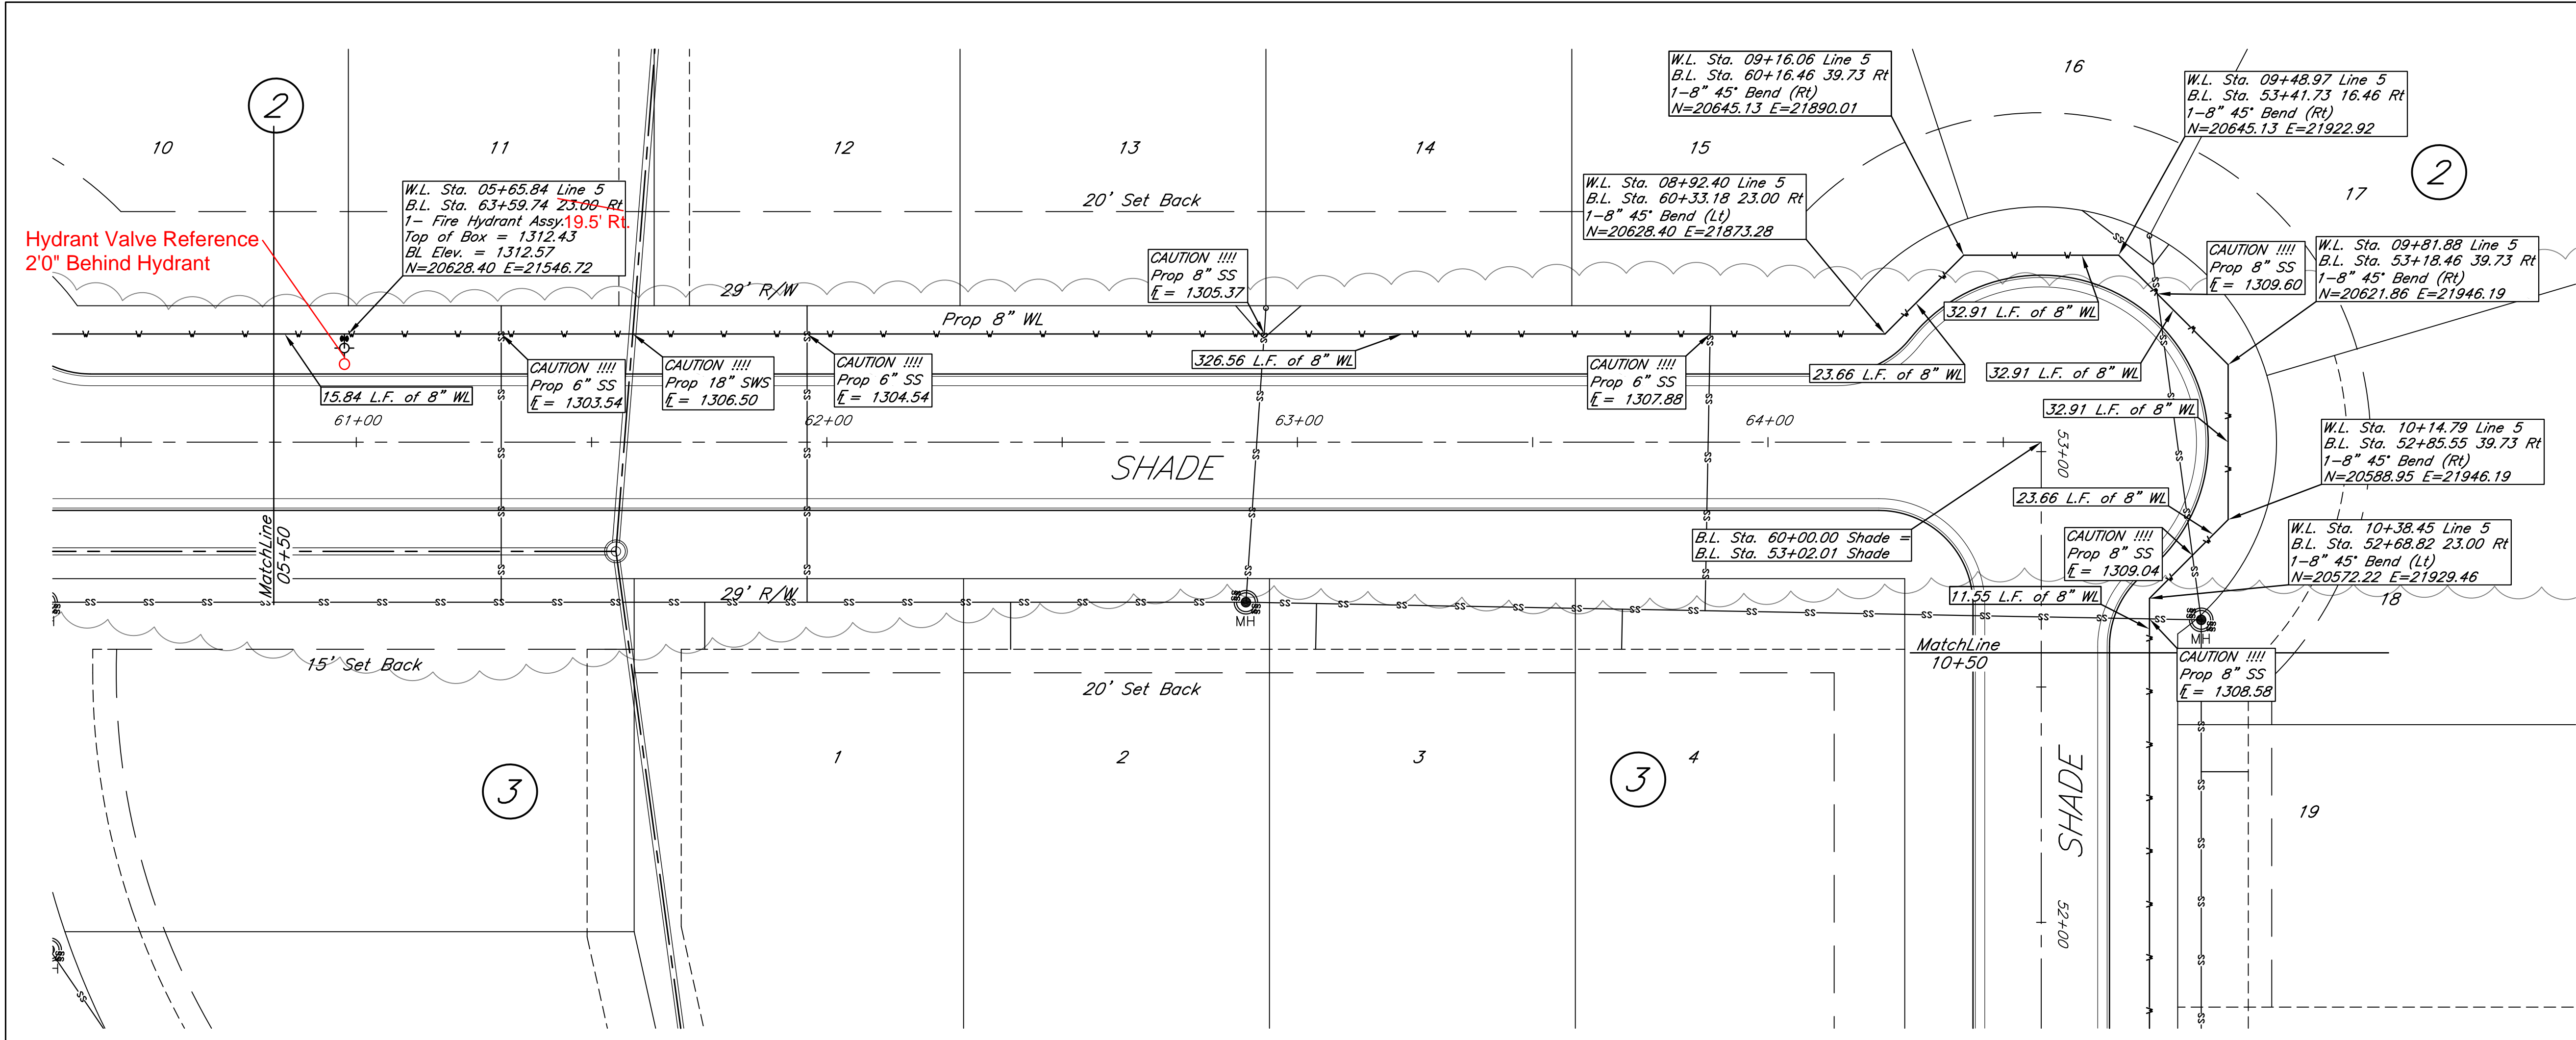

RECORD DRAWING
3-29-2010

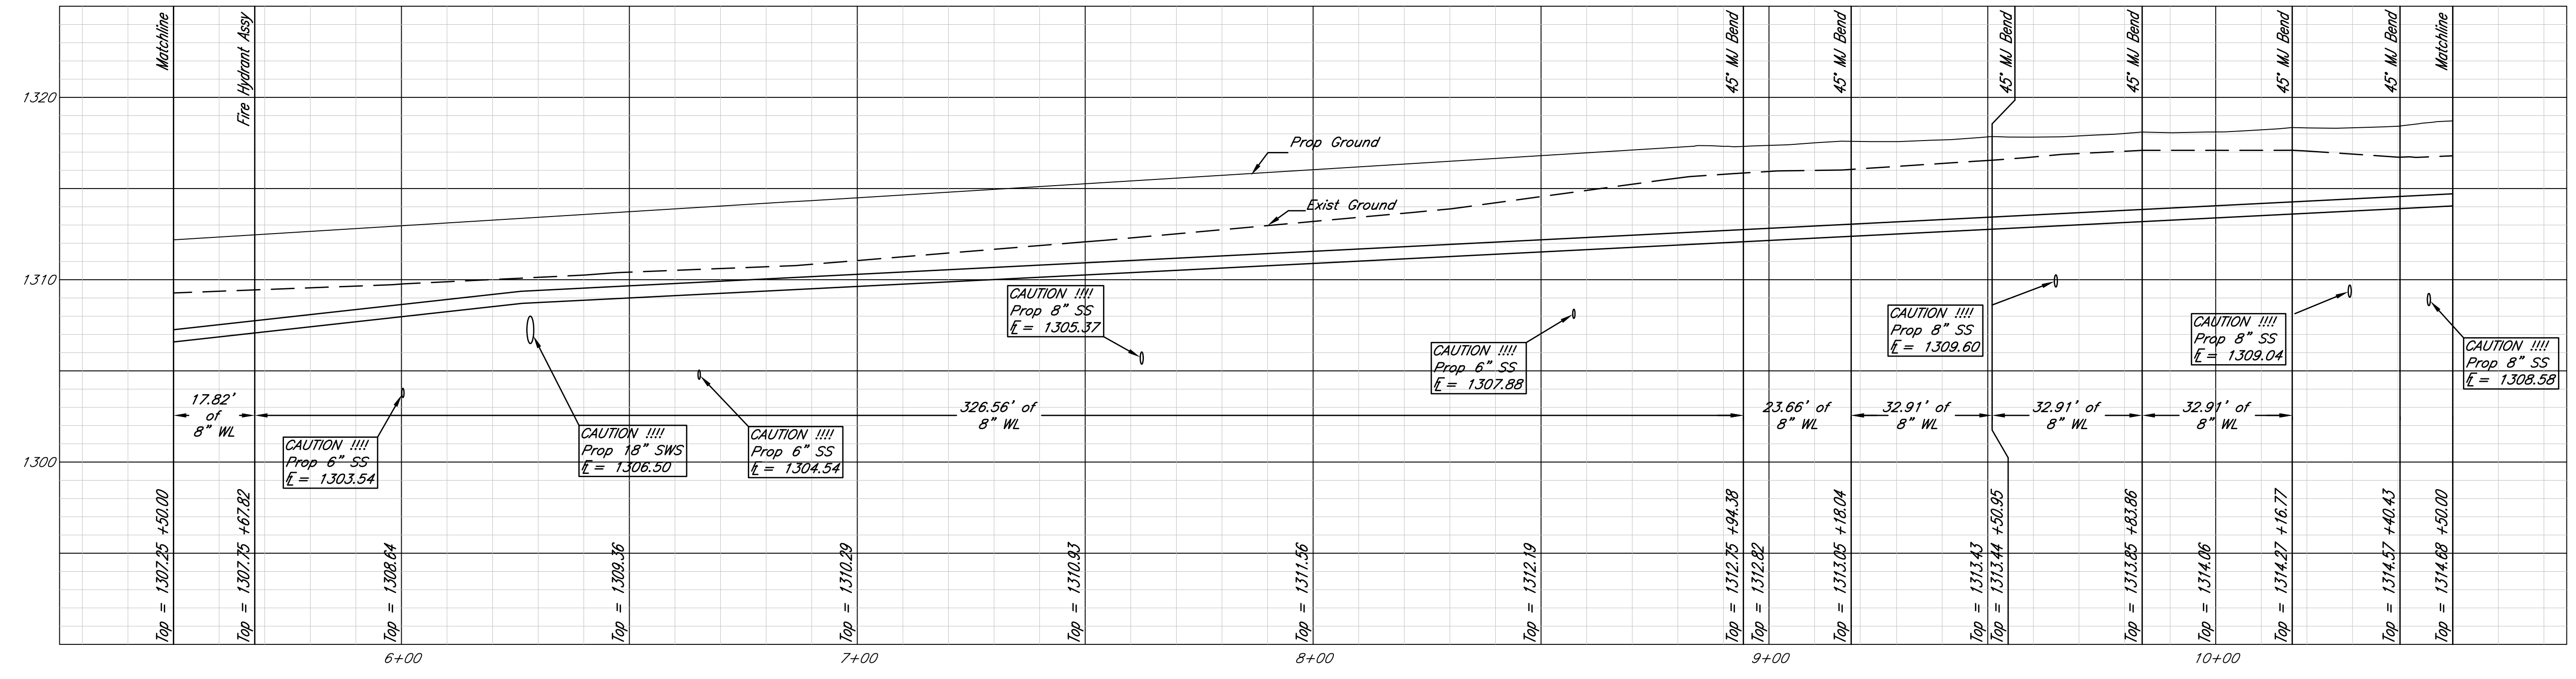

kemiller engineering
516 S. Market, Wichita, KS 67202
316/784-0242

Reflection Lake 3rd Addition
Line 5 05+50 - 10+50
Andover, Kansas

KEM NO. 06128	FILE water
DESIGN KM	DRAWN NS
DATE 5/2008	REVISED

PROJECT NUMBER: _____
SHEET 9 OF 11