

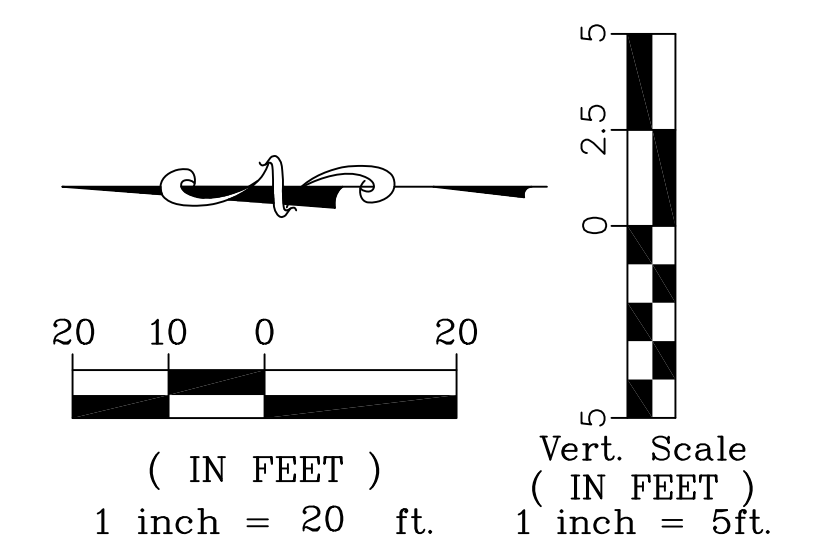


FWHA REG. NO.	STATE	PROJECT NO.:	YEAR	SHEET NUMBER	TOTAL SHEETS
	KANSAS				

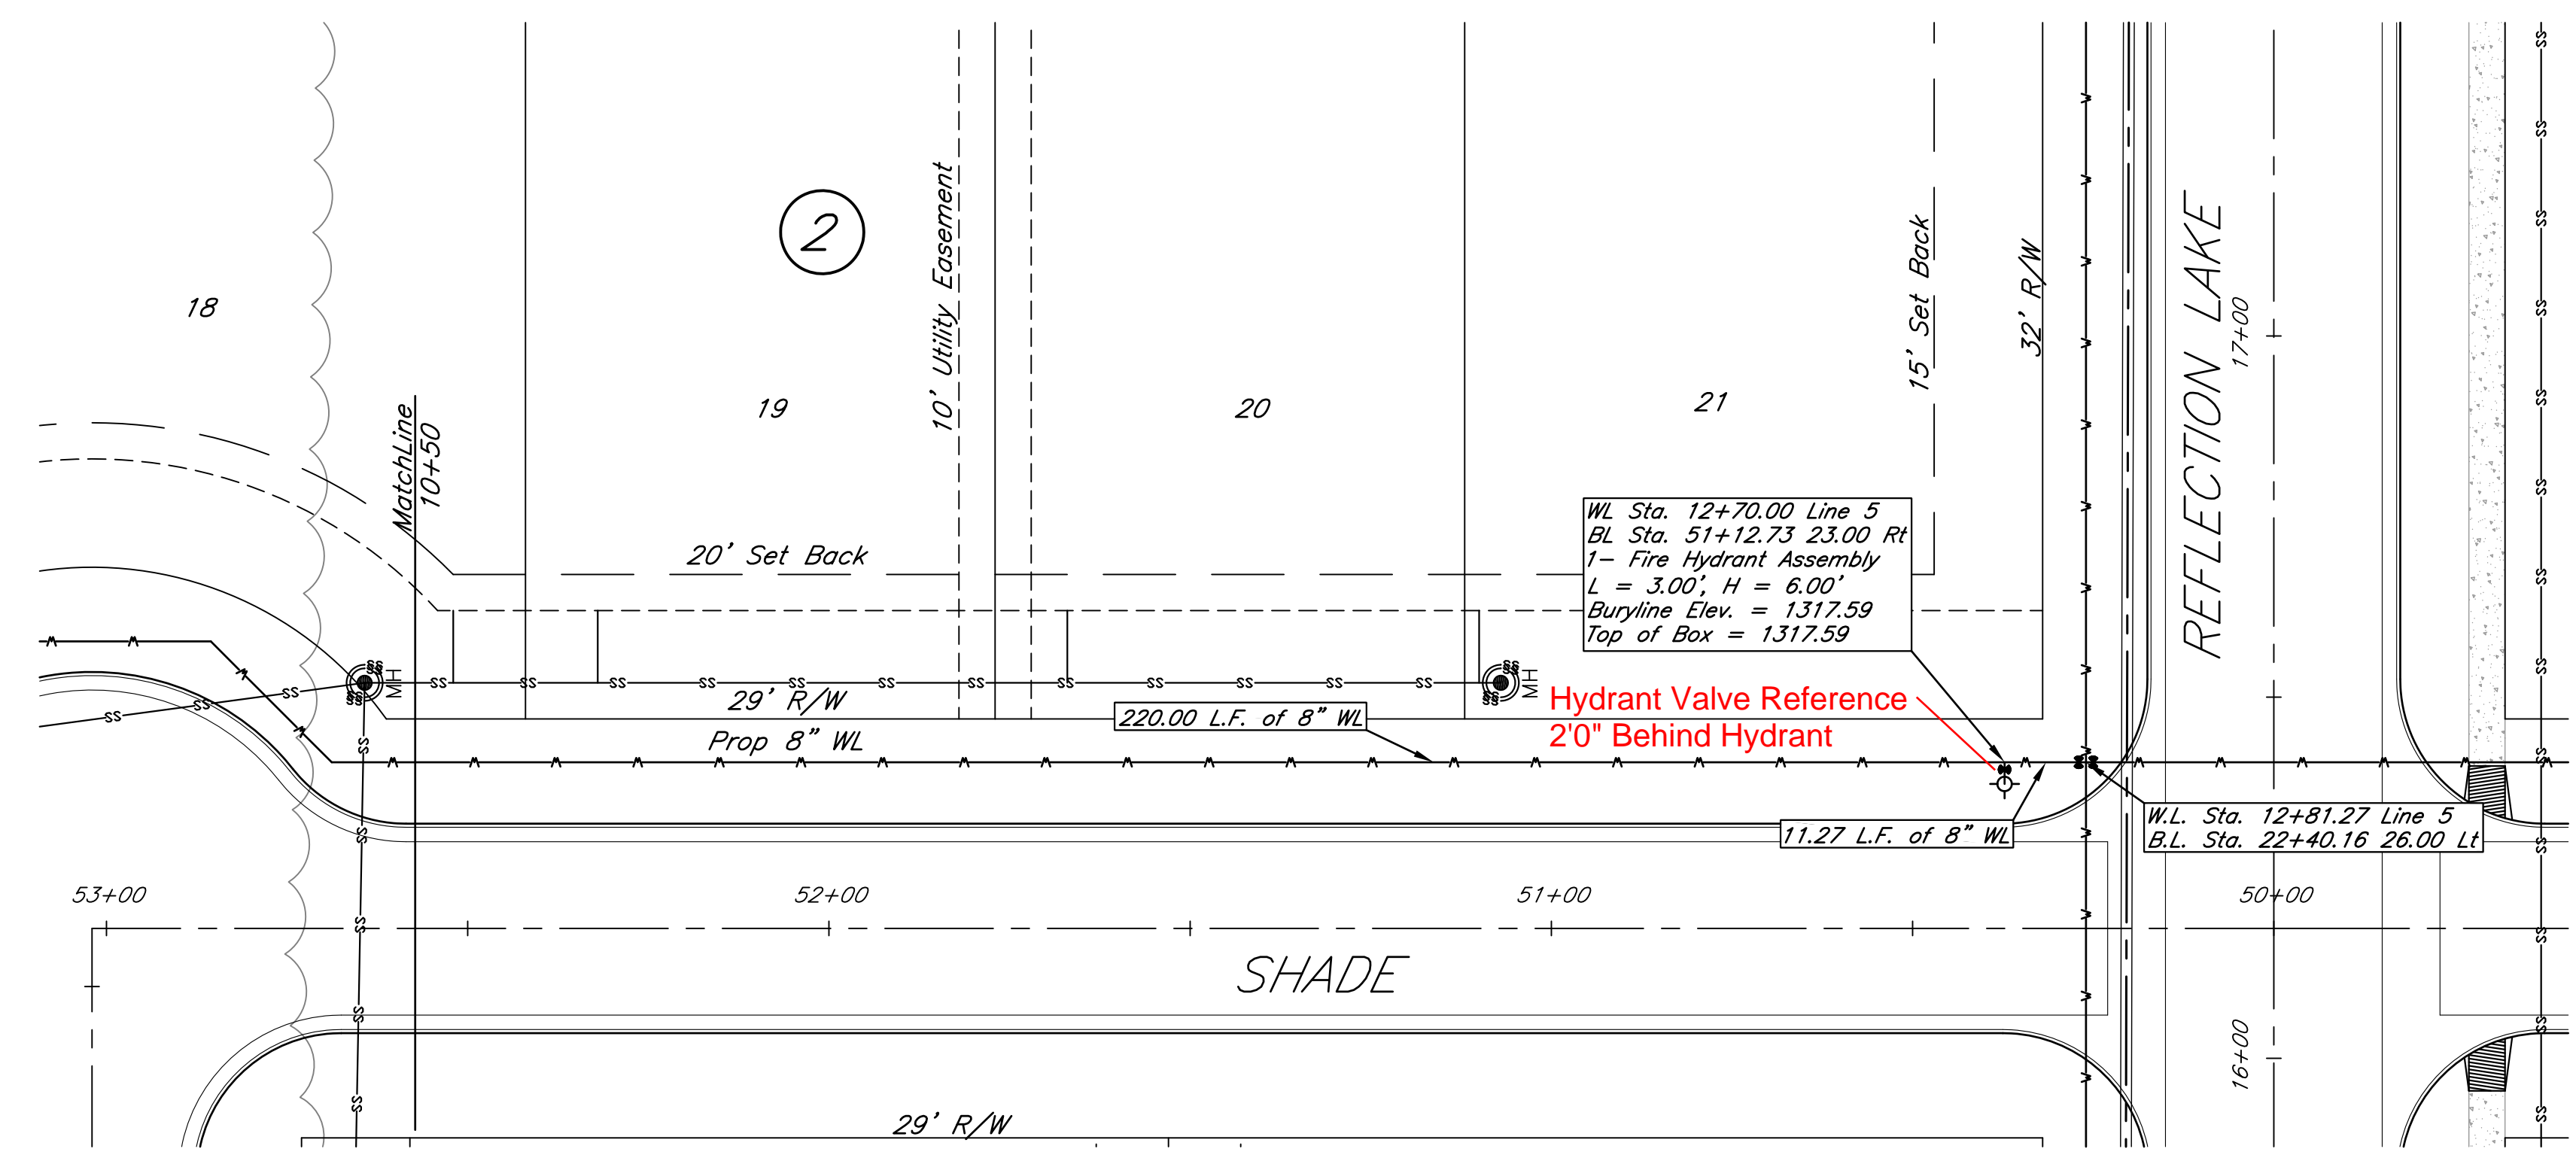

RECORD DRAWING
3-29-2010

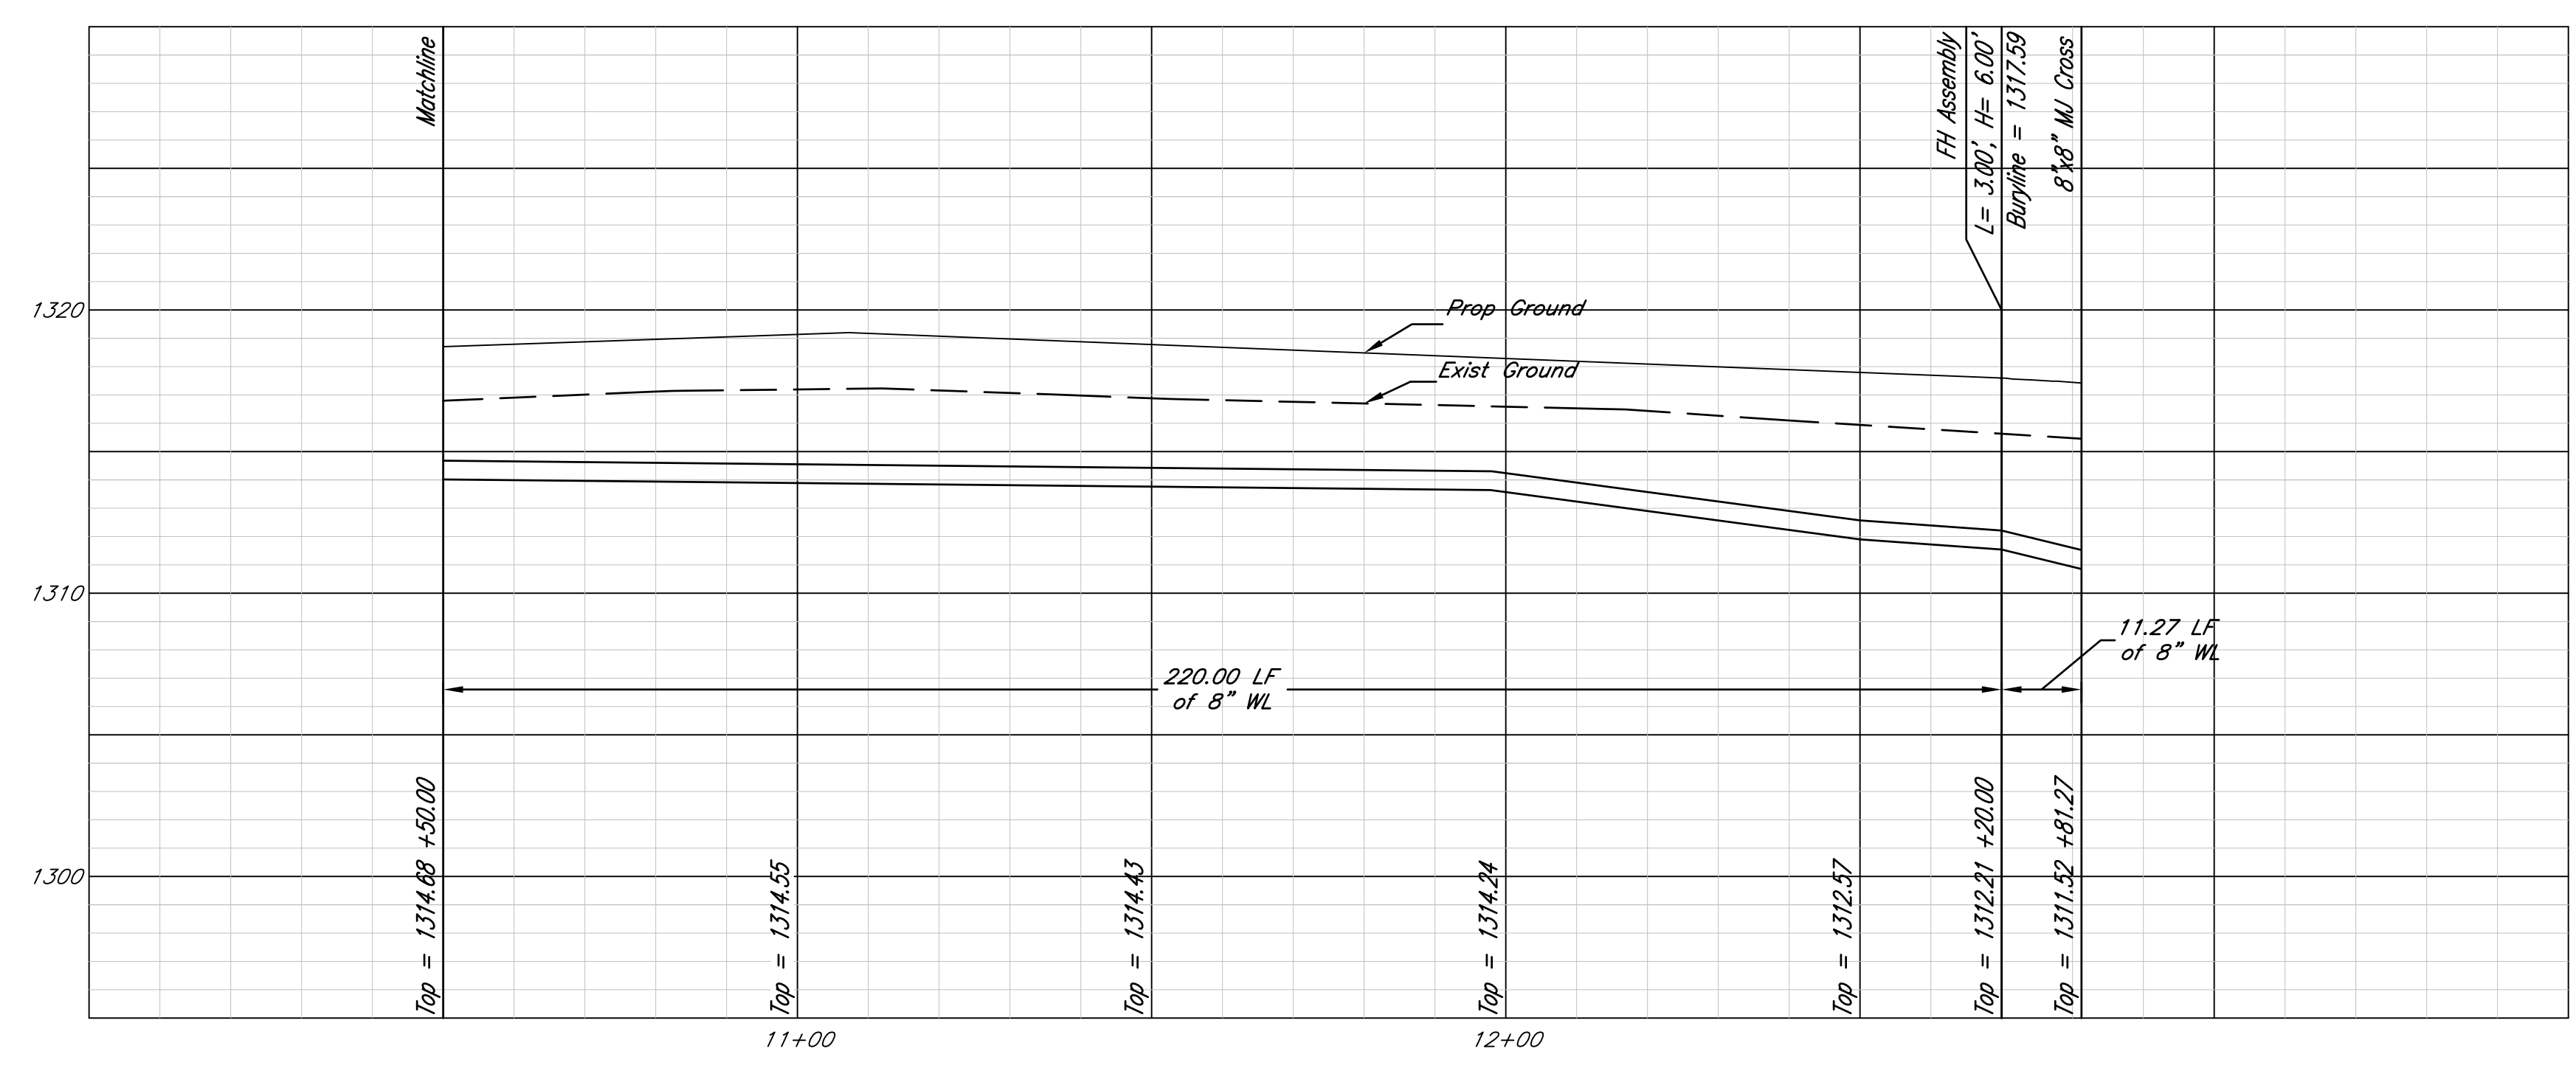

kemiller
engineering

516 S. Market,
Wichita, KS 67202

316/284-0242

Reflection Lake 3rd Addition
Line 5 10+50 - 12+84
Andover, Kansas

KEM NO. 06128	FILE water
DESIGN KM	DRAWN NS
DATE 5/2008	REVISED 03/05/09

PROJECT NUMBER: _____ PROJECT NUMBER: _____

SHEET
10
OF
11