

The Contractor shall field verify the existing manhole stub elevations prior to the start of construction.


The Contractor shall contact each property owner to verify the location of the riser with the property owner.

NUMBER	TYPE	LOCATION				DESIGN STATION \ DIRECTION	AS BUILT STATION \ DIRECTION	FOR INFORMATION ONLY	
		LOT NO.	BLOCK NO.	ADDITION NAME	LINE NO.			APPROXIMATE LENGTH OF PIPE	VERTICAL
1	Double Riser	6, 7	1	J. B. Muller	1	11+38/Rt.		9'	24'
2	Double Riser	25, 26	1	J. B. Muller	1	11+50/Lt.		9'	25'
3	Double Riser	8, 9	1	J. B. Muller	1	13+53/Rt.		9'	20'
4	Manhole	23, 24	1	J. B. Muller	1	13+90/Lt.		9'	26'
5	Double Riser	10, 11	1	J. B. Muller	1	15+82/Rt.		8'	20'
6	Single Riser	22	1	J. B. Muller	1	16+10/Lt.		8'	26'
7	Double Riser	11, 12	1	J. B. Muller	1	16+90/Rt.		8'	20'
8	Manhole	21	1	J. B. Muller	1	16+95/Lt.		8'	26'
9	Double Riser	13, 14	1	J. B. Muller	1	19+14/Rt.		8'	20'
10	Manhole	19, 20	1	J. B. Muller	1	19+22/Lt.		8'	26'

NOTE: Horizontal distances are from main to cleanout
 Vertical distances are from existing ground to wye
 Cleanout to wye - 4"
 All are single wyes unless specifically noted.

REVISED: 12/31/07
 REVISED: 12/20/07

Ruggles & Bohm, P.A.
 Engineering, Surveying, Land Planning
 9000 W. 43rd St., Suite 100
 Overland Park, Kansas 66204
 Phone: (913) 241-4400
 Fax: (913) 241-4401
 Email: info@ruggles.com

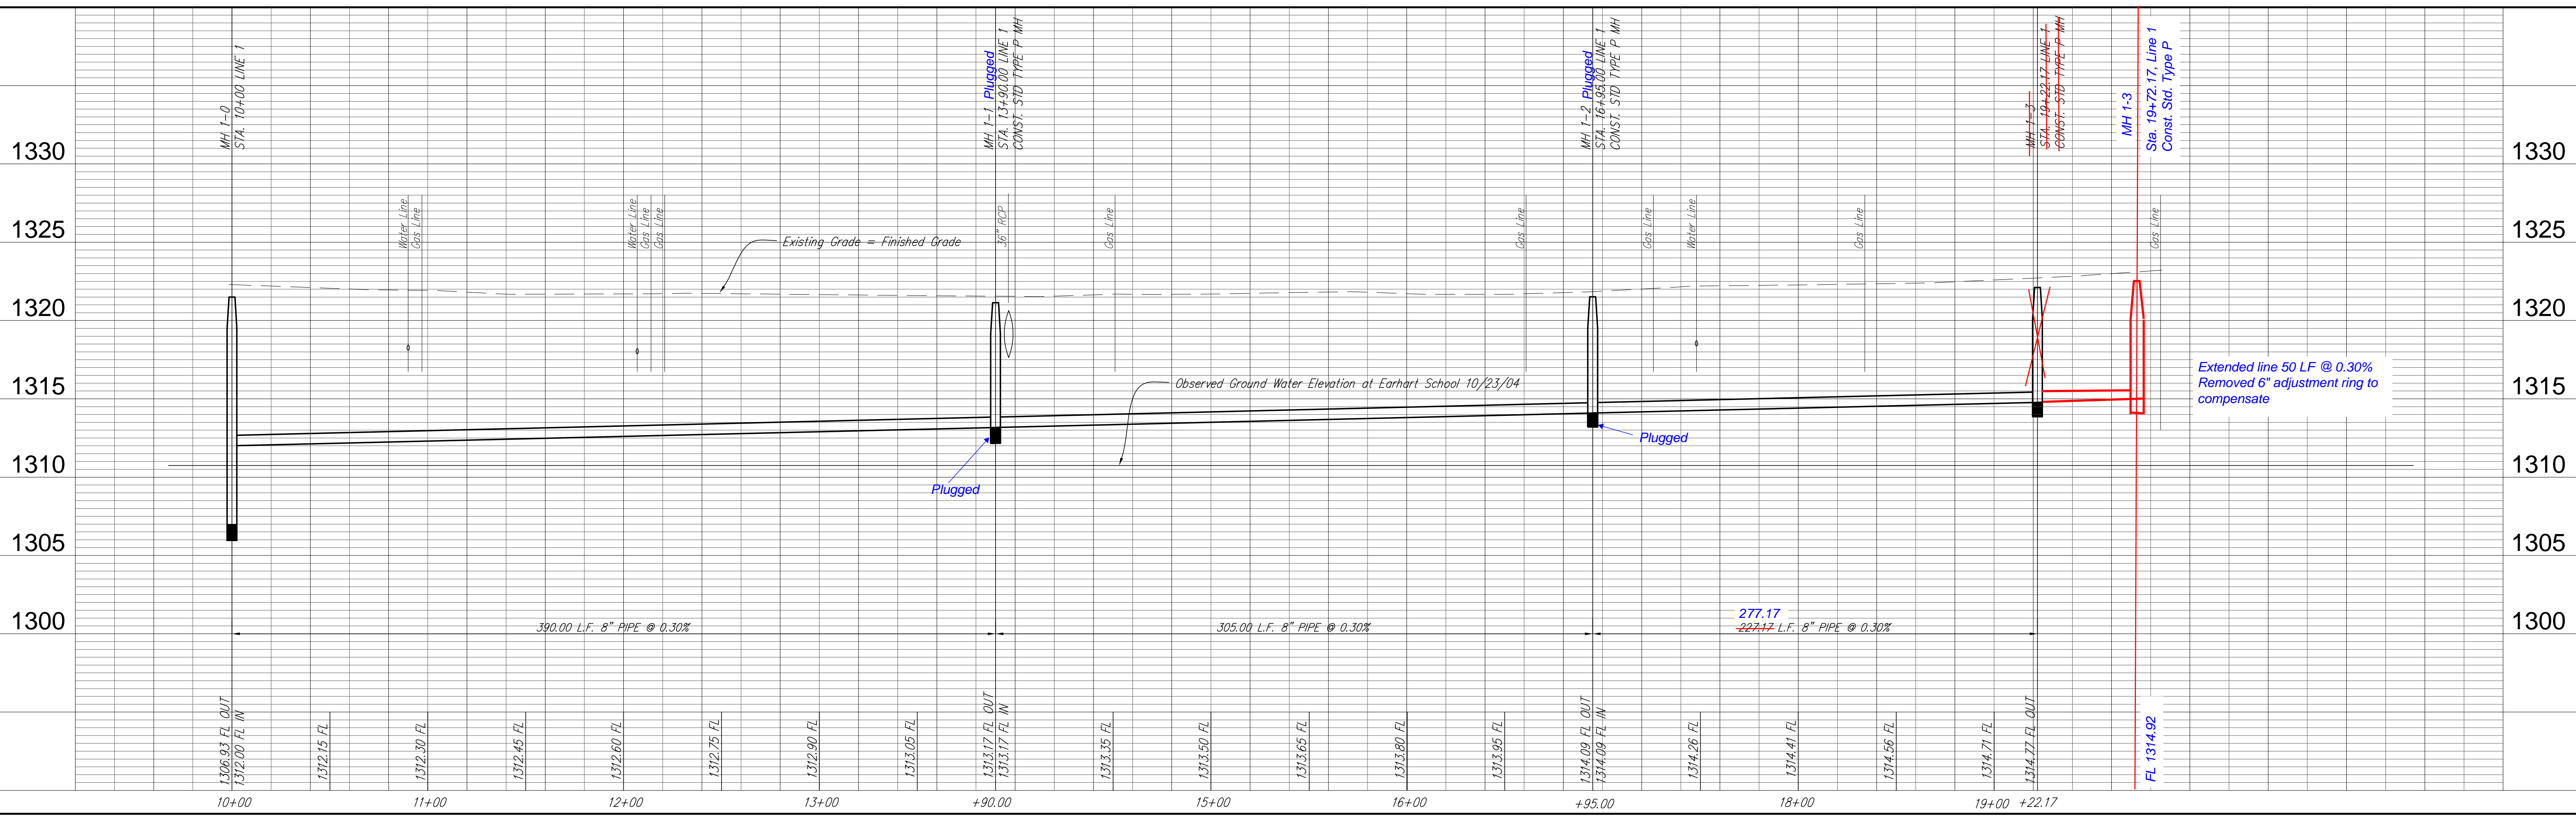

REVISION	6/9/06	REVIEW	
DRAWN	PDC	DATE	2/22/06
DESIGN	PDC	UTILITY	
PROJECT NUMBER	SANITARY SEWER LATERALS		
DRAWING FILE	LATERALS 1, 2 & 3, MAIN 16, SS # 23		
RB JOB	2827X		
SHEET	3		
OF	25		