
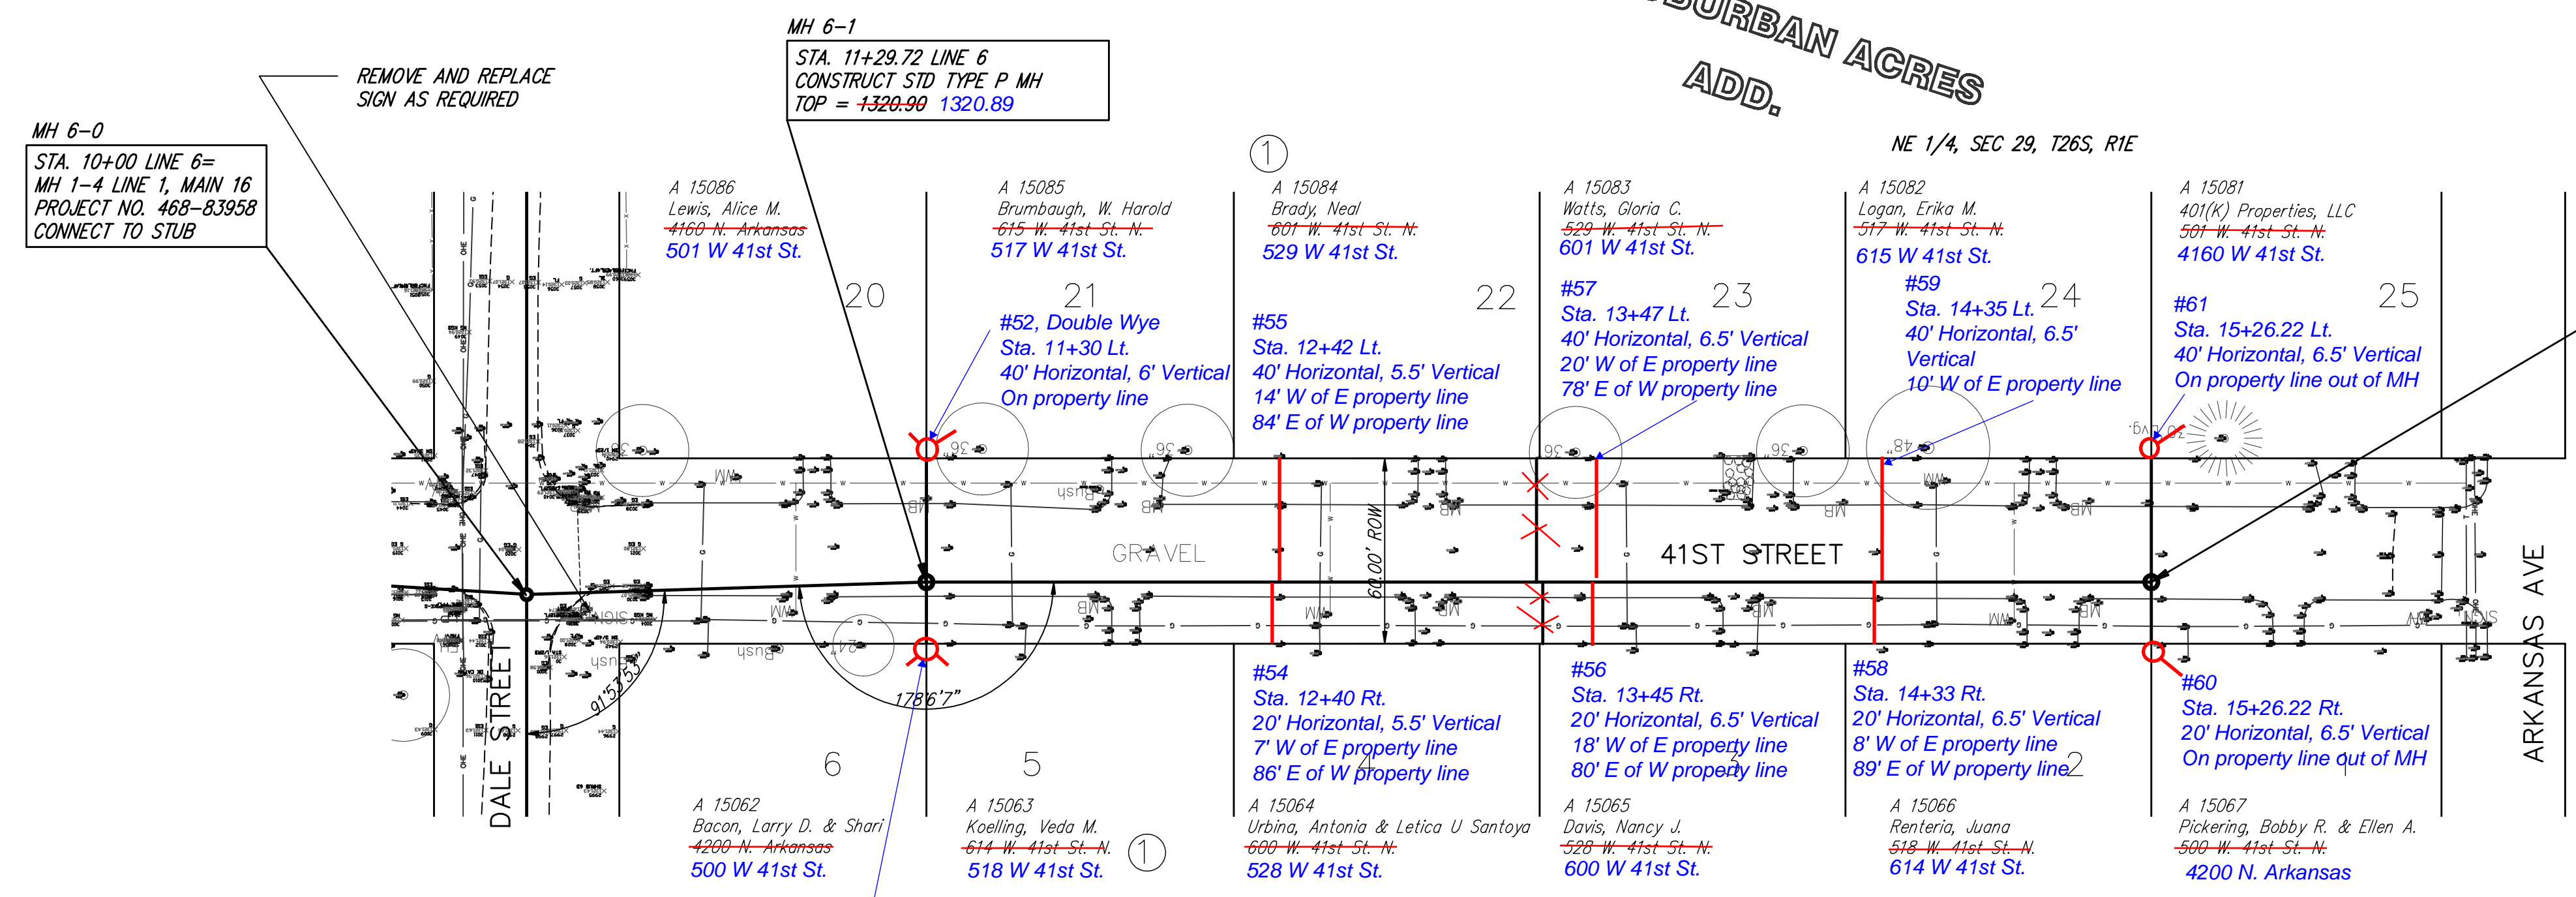


# SUBURBAN ACRES ADD.


NE 1/4, SEC 29, T26S, R1E

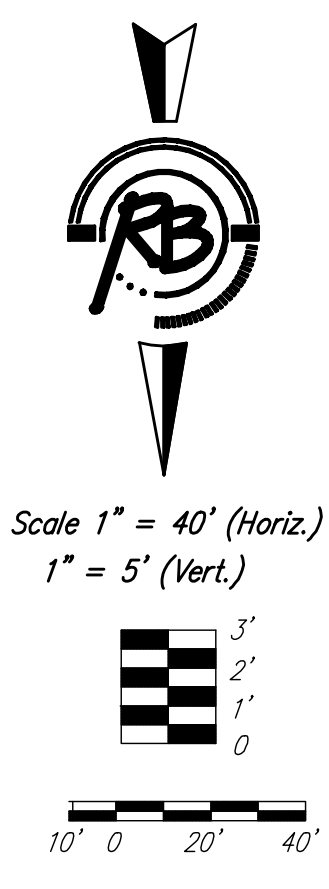


NOTE: Horizontal distances are from main to cleanout  
Vertical distances are from existing ground to wye  
Cleanout to wye - 4'  
All are single wyes unless specifically noted

The Contractor shall field verify the existing manhole stub elevations prior to the start of construction.  
The Contractor shall contact each property owner to verify the location of the riser with the property owner.

NUMBER	TYPE	LOCATION			DESIGN LINE NO.	DESIGN STATION DIRECTION	AS BUILT STATION DIRECTION	FOR INFORMATION ONLY	
		LOT NO.	BLOCK NO.	ADDITION NAME				APPROXIMATE LENGTH OF PIPE	VERTICAL
1	Double Riser	20, 21	1	Suburban Acres	6	11+30/Lt.		8'	30'
2	Double Riser	5, 6	1	Suburban Acres	6	11+30/Rt.		8'	15'
3	Double Riser	22, 23	1	Suburban Acres	6	12+27/Lt.		8'	30'
4	Double Riser	3, 4	1	Suburban Acres	6	12+29/Rt.		8'	15'
5	Double Riser	1, 2	1	Suburban Acres	6	15+26/Rt.		8'	30'
6	Double Riser	24, 25	1	Suburban Acres	6	15+26/Lt.		8'	15'

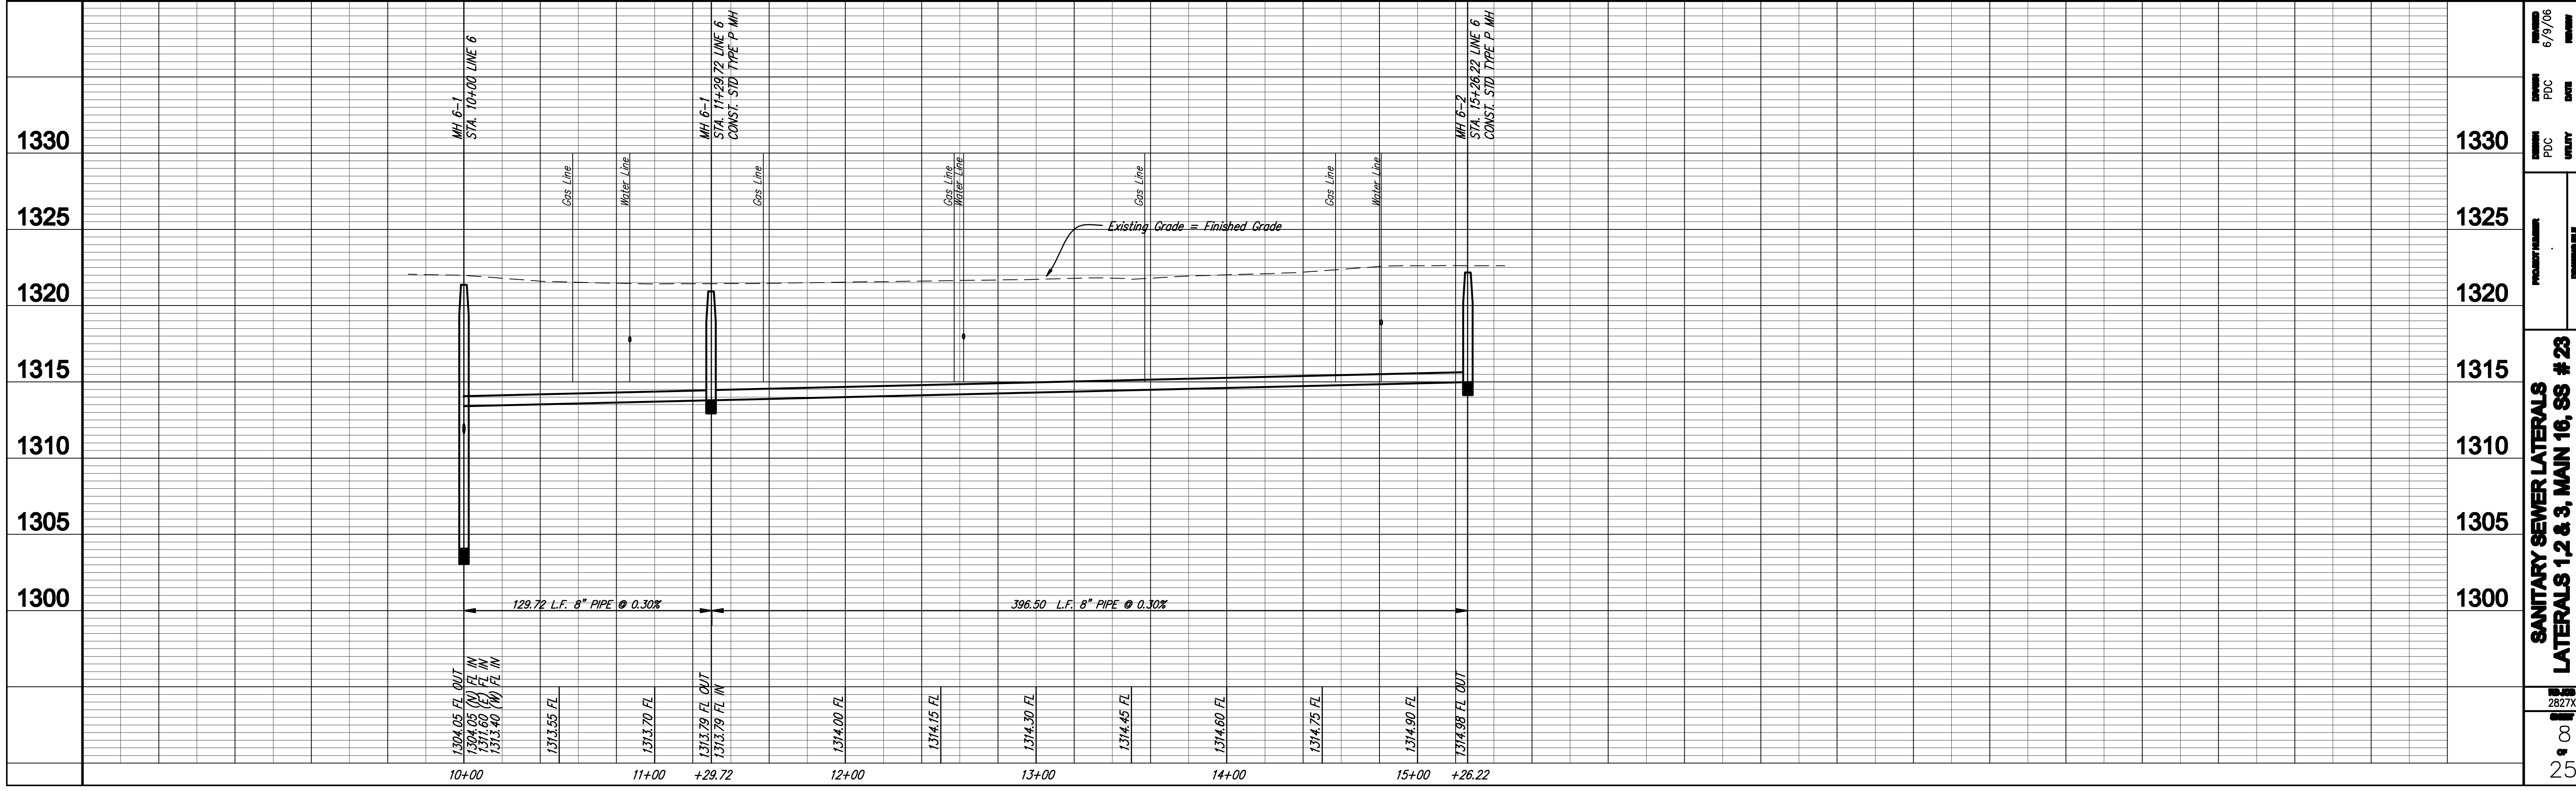

Rugles & Doherty, P.A.  
Engineering, Surveying, Land Management  
Professional Seal  
2/22/06

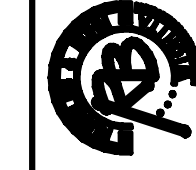

REVISED: 6/27/07

PROJECT NUMBER: 2827X  
DATE: 6/9/06  
PDC: PDC  
UTILITY: UTILITY  
Engr. Base  
SANITARY SEWER LATERALS  
LATERALS 1, 2 & 3, MAIN 16, SS # 23  
LINE 6  
25