


CONSTRUCTION PLANS
FOR
PUBLIC IMPROVEMENTS PHASE I




OCA NO. 792424 / 635664 / 622094

CITY OF WICHITA PROJECT NO. 472-84132 / 448-90050 / 468-83962

CITY OF WICHITA, KANSAS
JAMES L. ARMOUR, P.E. - ACTING CITY ENGINEER

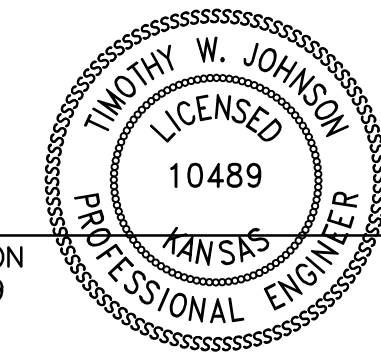

TIMOTHY W. JOHNSON
Reg. P.E. No. 10489 DATE

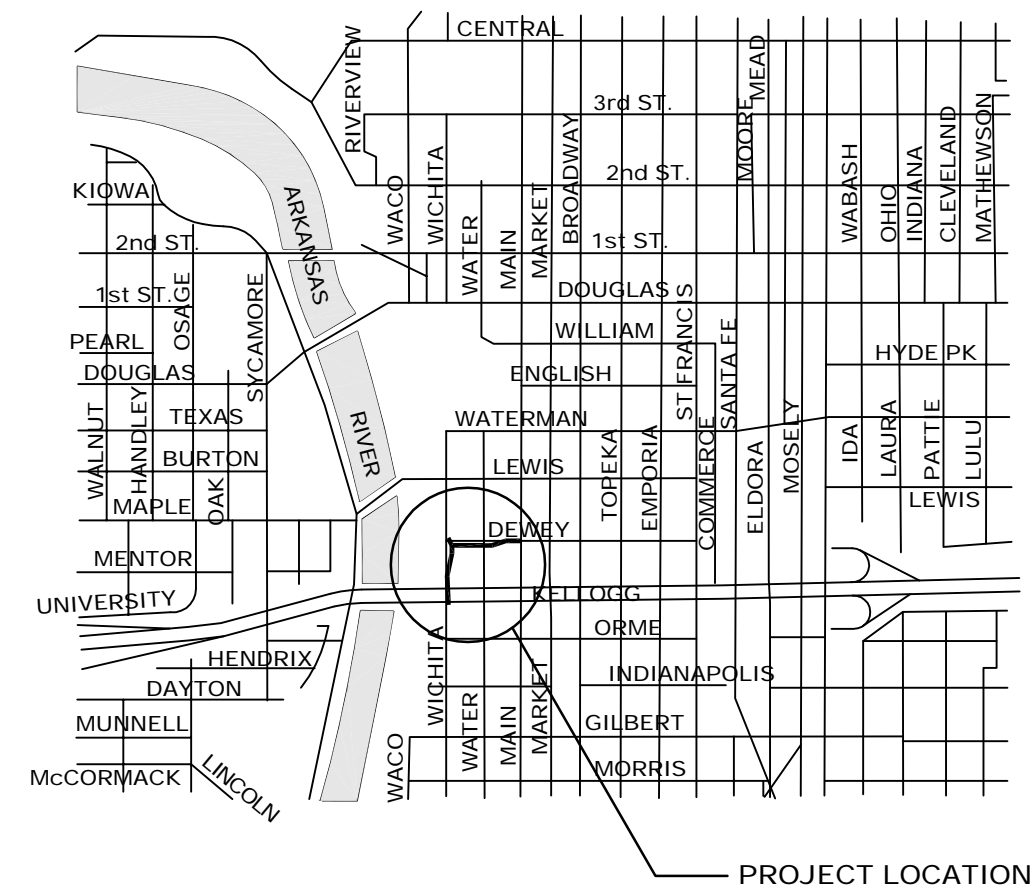

LOCATION MAP

INDEX OF SHEETS

1.0 Cover Sheet	X.1 Cross-Sections - Dewey St.
2.0 General Notes	X.2 Cross-Sections - Dewey St.
3.0 Project Control Plan	X.3 Cross-Sections - Dewey St.
	X.4 Cross-Sections - Wichita St.
	X.5 Cross-Sections - Wichita St.
	X.6 Cross-Sections - Wichita St.
	X.7 Cross-Sections - Water St.
	X.8 Cross-Sections - Water St.
Erosion Control Plans	
EC1.1 Plan	
EC2.1 Standard Details	
EC2.2 Standard Details	
EC2.3 Standard Details	
EC2.4 Standard Details	
EC2.5 Standard Details	
EC2.6 Standard Details	
EC2.7 Standard Details	
Water Plan	
W1.0 Water - Key Map	
W1.1 Water - Standard Assembly Details	
W1.1 Water - Standard Water Details	
W2.1 Water - Plan & Profile - Dewey St.	
W2.2 Water - Plan & Profile - Dewey St.	
W2.3 Water - Plan & Profile - Water St.	
W2.4 Water - Plan & Profile - Wichita St.	
W2.5 Water - Plan & Profile - Lines 2, 4	
W2.6 Water - Plan & Profile - Lines 6, 7, 8, 10	
W2.7 Water - Plan & Profile - Line 9	
Demolition Plans	
D1.0 Sheet Layout Plan	
D1.1 Demolition Plan - Dewey St.	
D1.2 Demolition Plan - Dewey St.	
D1.3 Demolition Plan - Wichita St.	
D1.4 Demolition Plan - Wichita St.	
D1.5 Demolition Plan - Water St.	
D1.6 Demolition Plan - Water St.	
Sanitary Sewer Plan	
SS1.0 Sanitary Sewer - General Layout	
SS1.1 Sanitary Sewer - Plan & Profile - Line 1	
SS1.2 Sanitary Sewer - Plan & Profile - Line 1	
SS1.3 Sanitary Sewer - Plan & Profile - Lines 3, 4, 5	
SS1.4 Sanitary Sewer - Plan & Profile - Line 10	
SS2.1 Standard Details - Type P Manholes	
SS2.2 Standard Details - Manhole Frame & Cover	
SS2.3 Standard Details - 8" Cleanout Riser	
Storm Sewer	
ST1.1 Storm Sewer - Plan & Profile - Wichita St.	
ST1.2 Storm Sewer - Plan & Profile - Dewey St.	
ST1.3 Storm Sewer - Plan & Profile	
ST2.1 Standard Details Manhole Adjustment	
ST2.2 Standard Details RC Manhole	
ST2.3 Standard Details Type 2 Curb	
ST2.4 Standard Details Drop Inlet	
ST2.5 Standard Details Type 1 Inlet	
Paving	
P1.0 General Layout	
P2.0 Typical Sections - 37 Street	
P2.1 Standard Details - Driveways	
P2.2 Standard Details - Wheelchair Ramps	
P2.3 Typical Sections - 29 Street	
P3.1 Plan & Profile - Dewey St.	
P3.2 Plan & Profile - Dewey St.	
P3.3 Plan & Profile - Wichita St.	
P3.4 Plan & Profile - Wichita St.	
P3.5 Plan & Profile - Water St.	
P3.6 Plan & Profile - Water St.	
P3.7 Dewey / Main Intersection	
P3.8 Dewey / Water Intersection	
P4.1 Striping Plan	
P4.2 Striping Plan - Details	


Cornejo & Sons - Contractor
Mike Foster - City of Wichita, Inspector
Date Released: 9/05/05
As-Built
pdf: APR 12/31/08

FEBRUARY 2005

PLANS PREPARED BY



Johnson & Associates, Inc.
100 E. California Ave. - Third Floor
Oklahoma City, OK 73104

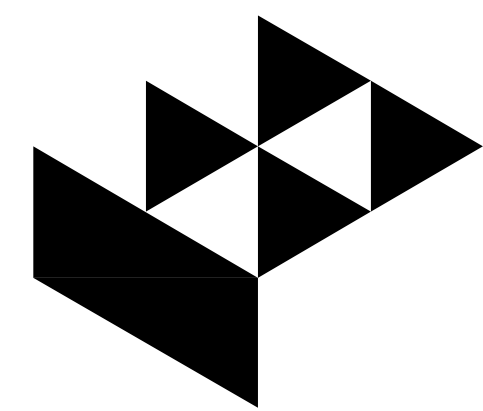

Gossen Livingston
 Architecture
 420 South Emporia
 Wichita, KS 67202
 Tel: (316) 265-9367
 Fax: (316) 265-5646
 Email: architecture@gl.com


© 2005 Gossen Livingston Associates, Inc.

The drawing and all information herein is the exclusive property of Gossen Livingston Associates, Inc. and is not to be copied or used in any way without the express written consent of Gossen Livingston Associates, Inc. All drawings, specifications, ideas, designs and arrangements appearing herein constitute the original and unpublished work of:

Gossen Livingston Associates, Inc.



Johnson & Associates, Inc.
 100 E. California Ave. - Third Floor
 Oklahoma City, OK 73104
 (405) 235-8075 FAX (405) 235-8078
 Certificate of Authorization #E-1128 EXP. DATE: 12-31-2006

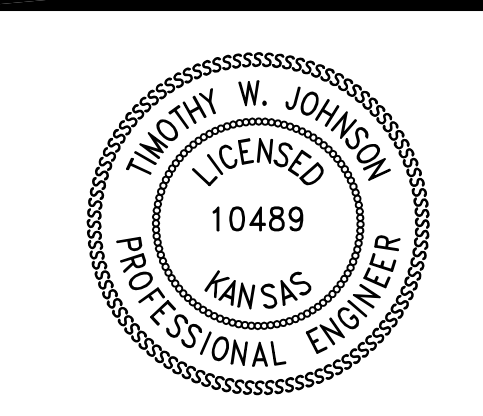


WICHITA WATERWALK
 PUBLIC IMPROVEMENTS
 PHASE I

Mark	Date	Description

SANITARY SEWER No. 1

Job No.	SS1.1
Date	02-15-05
Drawn	BC
Checked	PB
Drawn	54 of 68

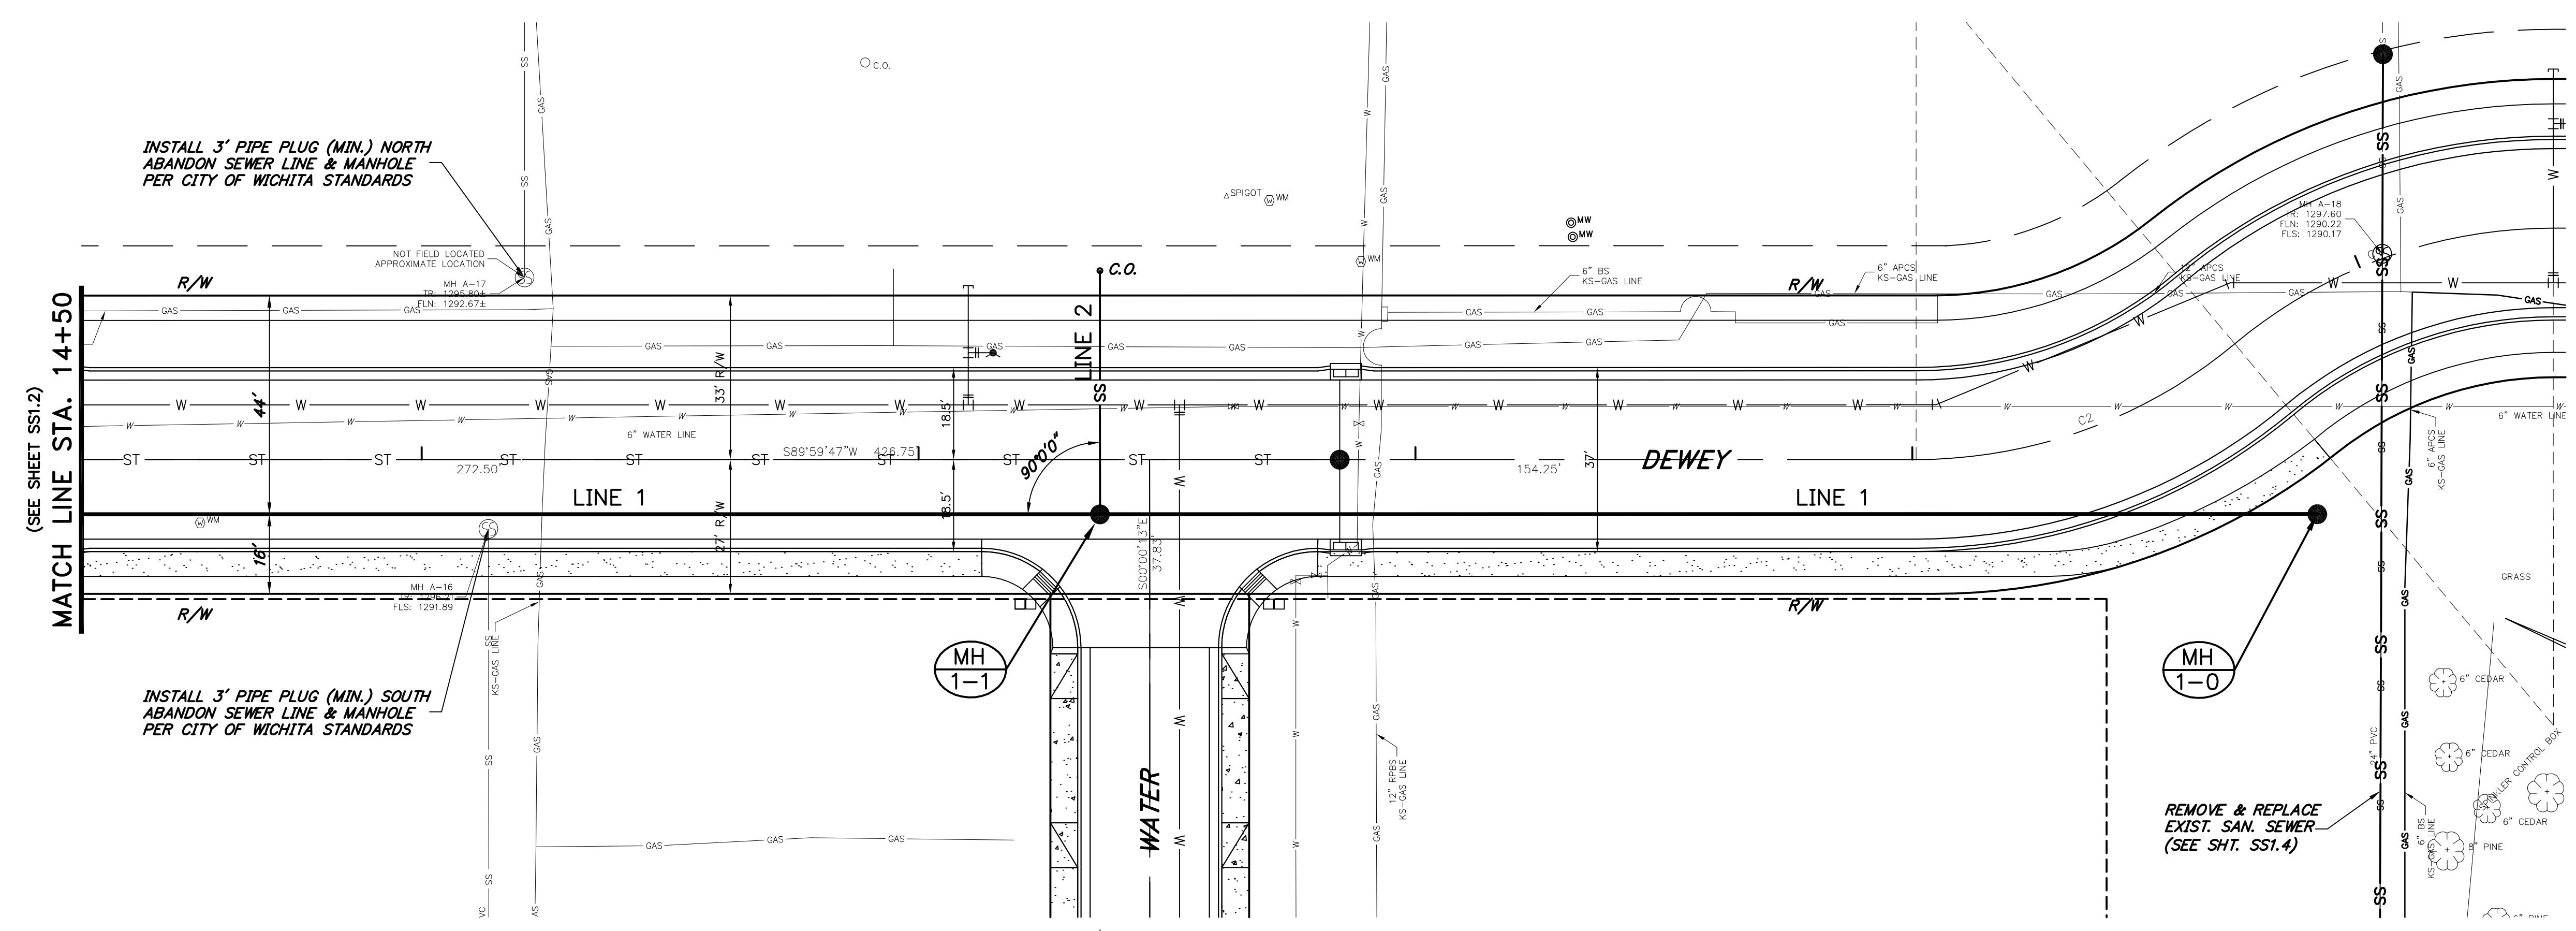


PLAN:
 SCALE: 1"=20'


PROFILE:
 SCALE: 1"=20' (HORIZ.)
 1"=4' (VERT.)

N-9078.65 E-10272.81
 STA. 12+45, SAN SEWER LINE No. 1 =
 STA. 10+00, SAN SEWER LINE No. 2
 CONST. STD. TYPE P LINED MANHOLE, 5' DIA.
 TOP RIM=1286.53

N-9078.66 E-10517.81
 STA. 10+00, SAN SEWER LINE No. 1
 CL FUTURE LIFT STATION
 BEING CONSTRUCTED
 CONST. STD. TYPE P LINED MANHOLE, 5' DIA.
 TOP RIM=1288.75

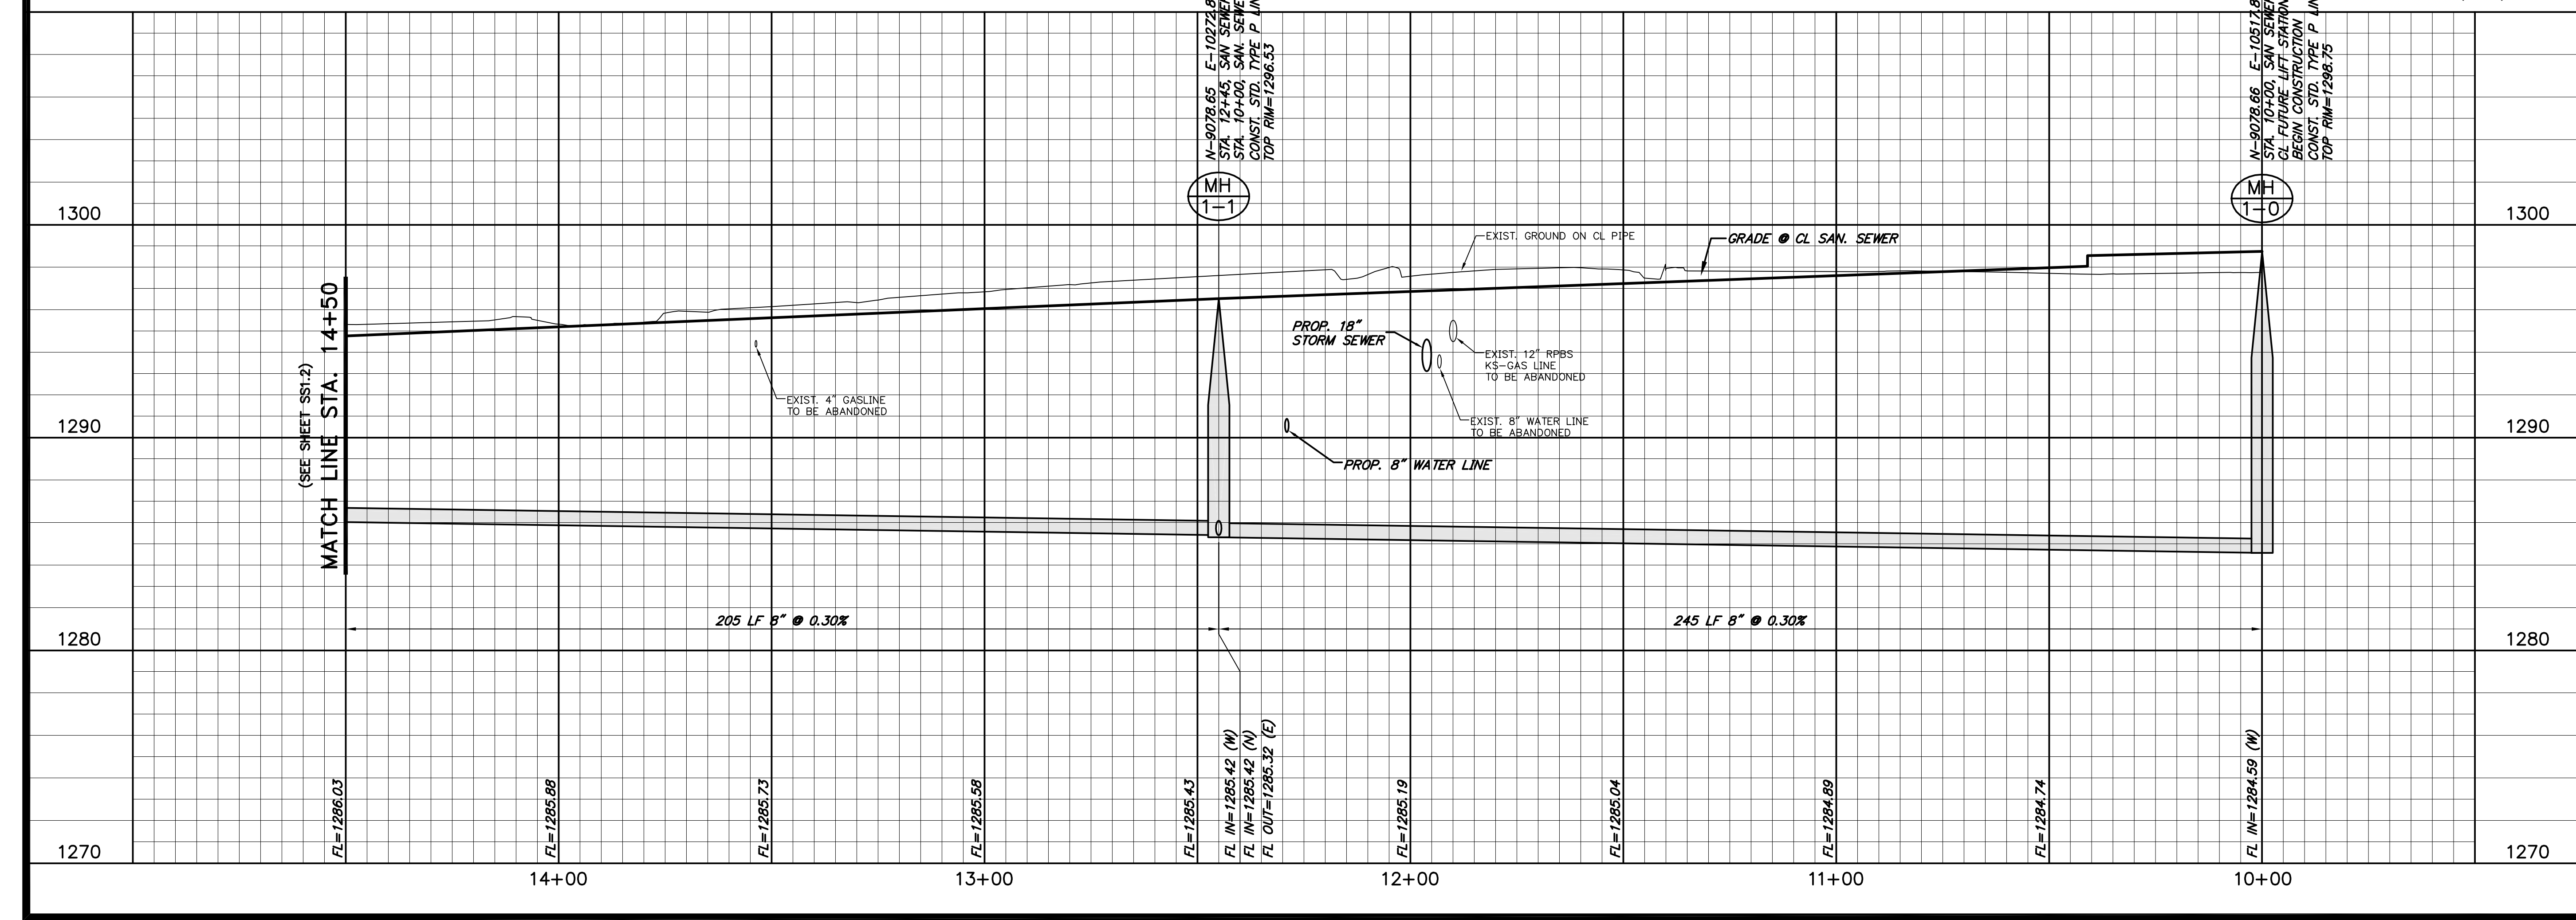

THE INFORMATION CONTAINED ON THIS DRAWING IS THE PROPERTY OF GOSSEN LIVINGSTON ASSOCIATES, INC. AND IS NOT TO BE REPRODUCED OR TRANSMITTED IN ANY FORM OR BY ANY MEANS, ELECTRONIC OR MECHANICAL, INCLUDING PHOTOCOPYING, RECORDING, OR BY ANY INFORMATION STORAGE AND RETRIEVAL SYSTEM. WITHOUT THE WRITTEN PERMISSION OF GOSSEN LIVINGSTON ASSOCIATES, INC.

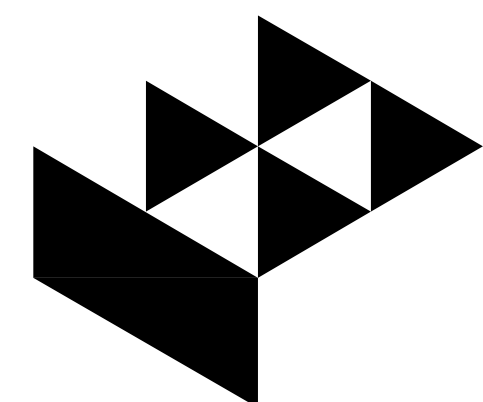

Gossin Livingston
 Architecture
 420 South Emporia
 Wichita, KS 67202
 Tel: (316) 265-9367
 Fax: (316) 265-5646
 Email: architecture@gl.com

© 2005 Gossin Livingston Associates, Inc.
 The drawing and all information herein is the exclusive property of Gossin Livingston Associates, Inc. and is not to be copied or used in any way without the express written consent of Gossin Livingston Associates, Inc. All drawings, specifications, ideas, designs and arrangements appearing herein constitute the original and unpublished work of:
 Gossin Livingston Associates, Inc.



Johnson & Associates, Inc.
 100 E. California Ave. - Third Floor
 Oklahoma City, OK 73104
 (405) 235-8075 FAX (405) 235-8078
 Certificate of Authorization #E-1128 EXP. DATE: 12-31-2006





WICHITA WATERWALK
 PUBLIC IMPROVEMENTS
 PHASE I


Mark	Date	Description

SANITARY SEWER No. 2, 3, & 4


Job No.	SS1.3
Date	02-15-05
Drawn	BC
Checked	PB
	56 of 68

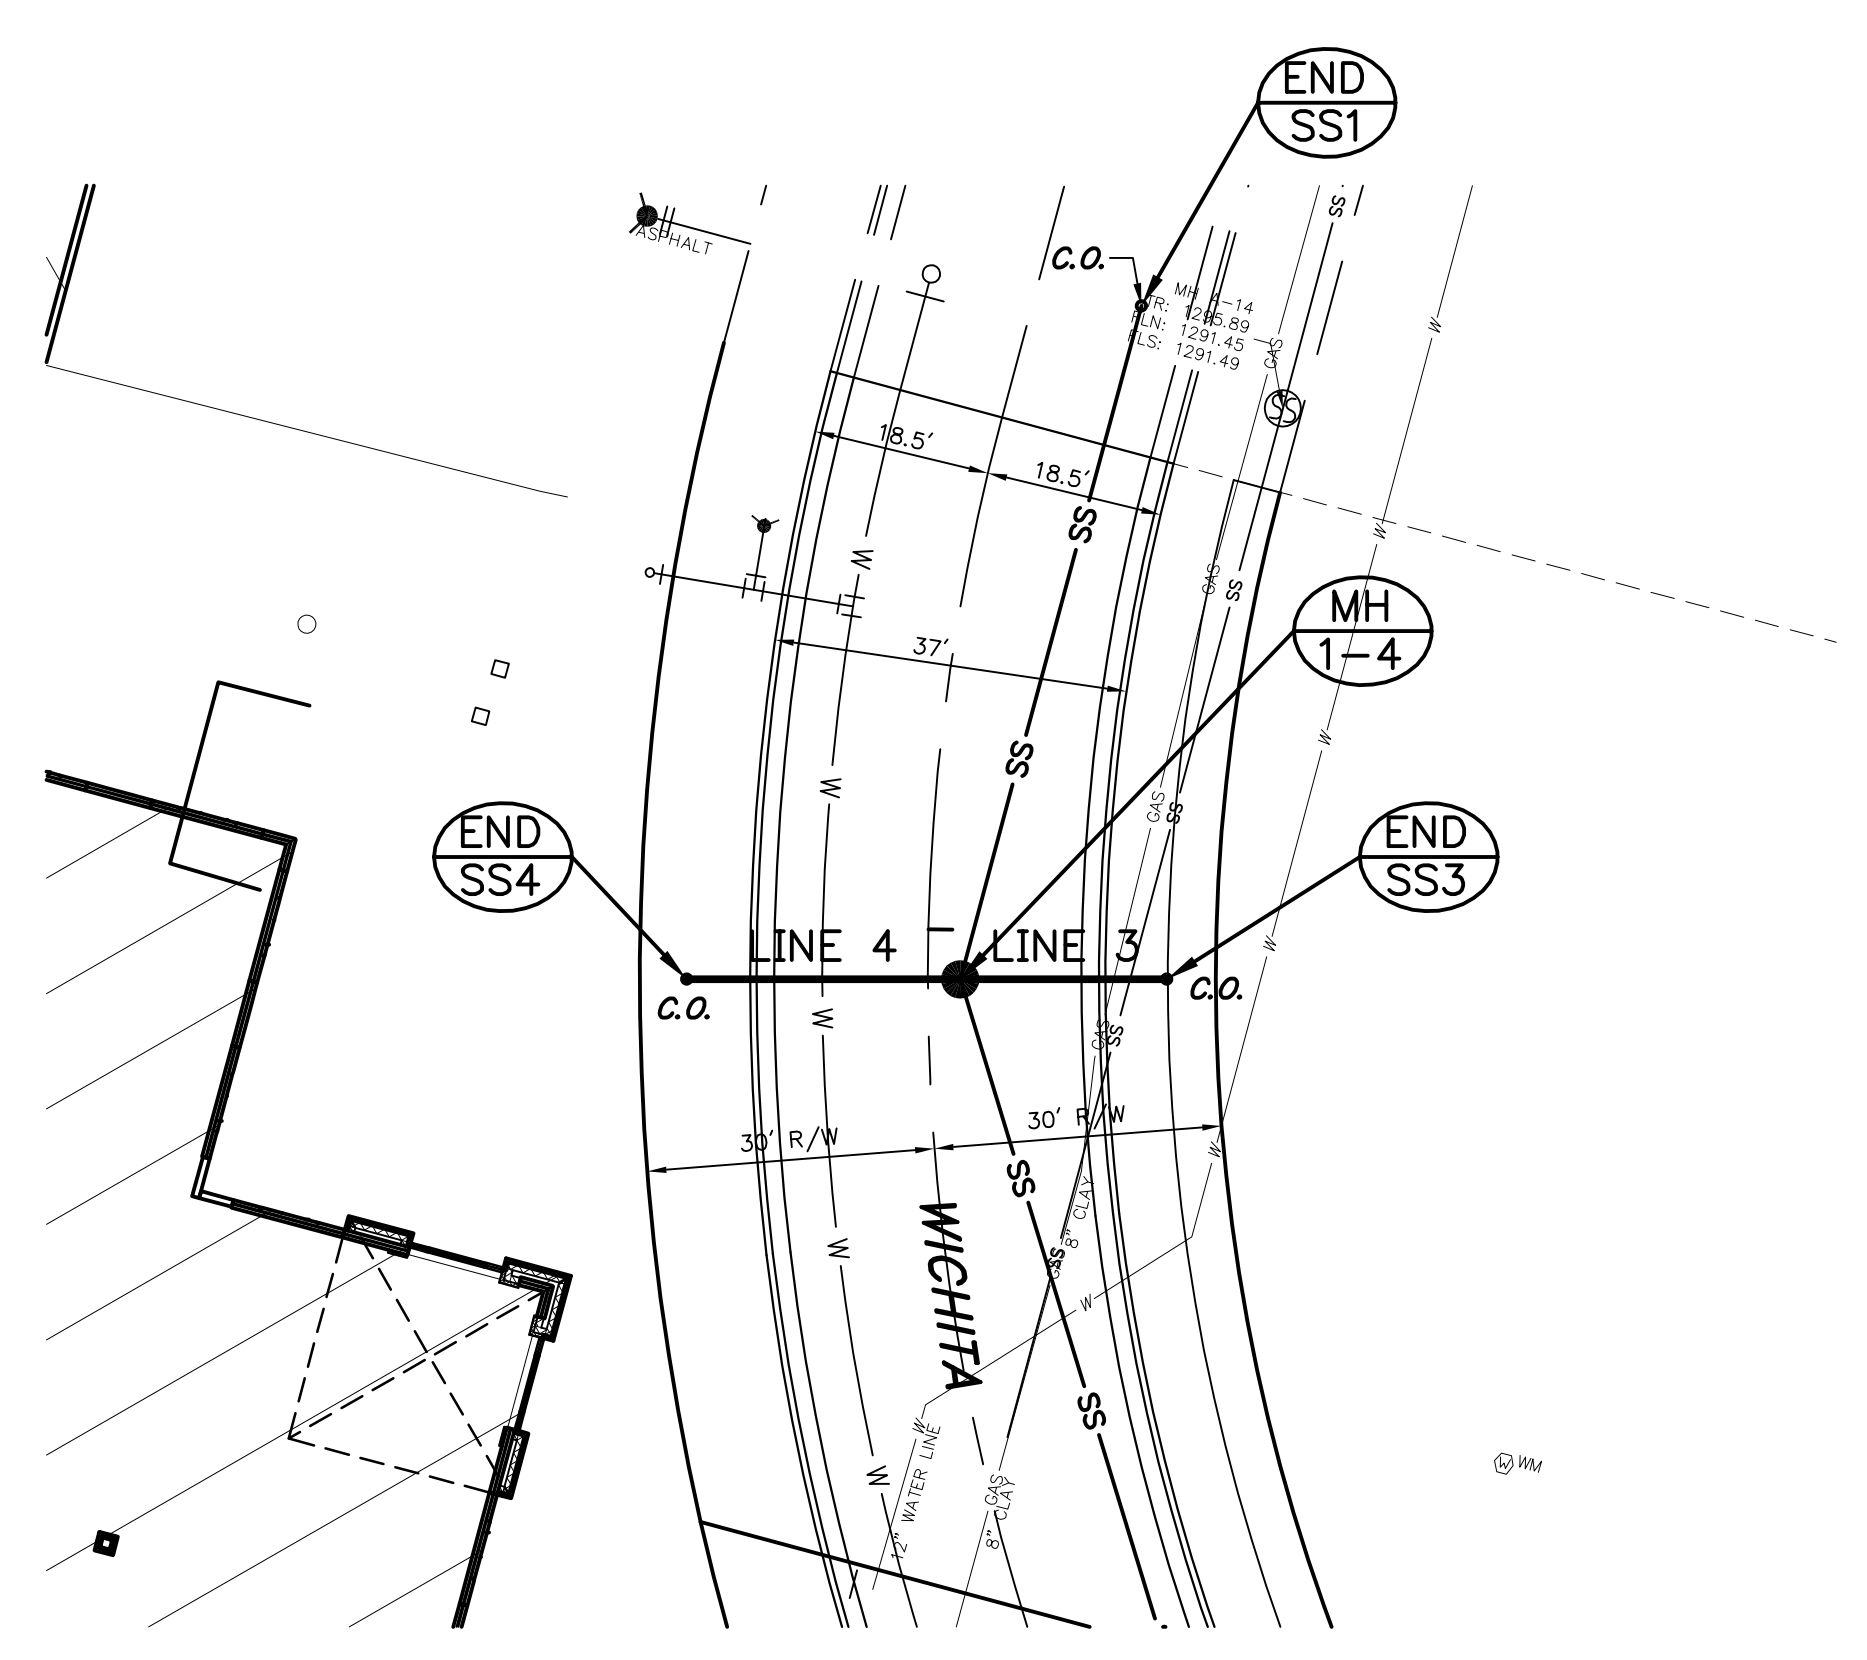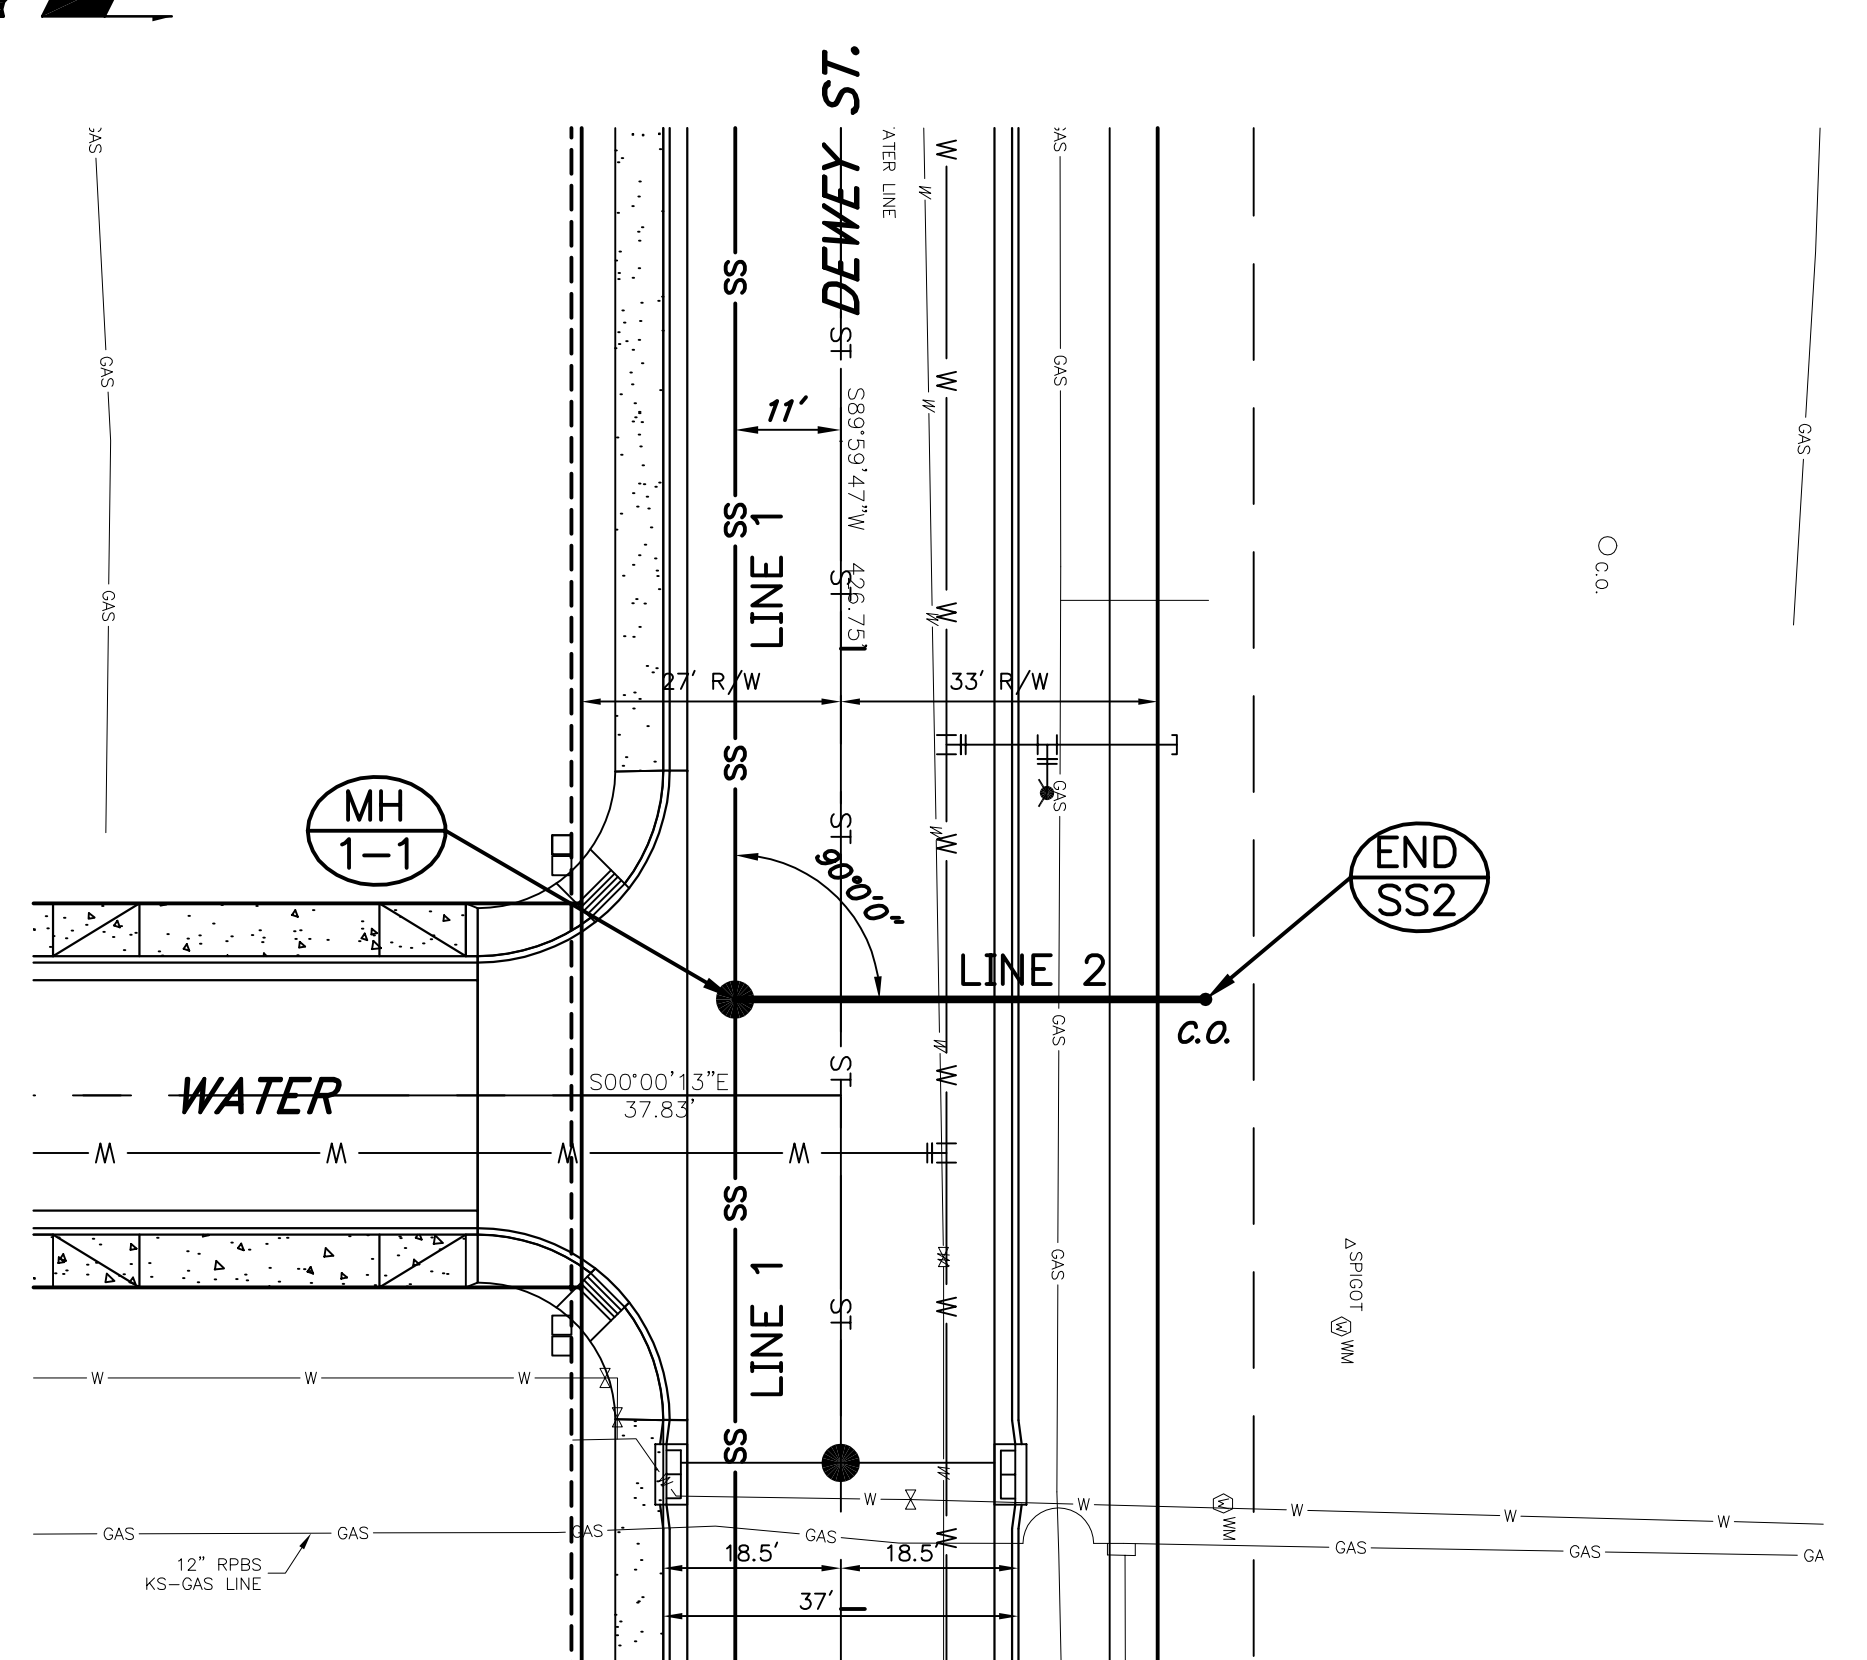

PLAN:
 SCALE: 1"=20'
 PROFILE:
 SCALE: 1"=20' (HORIZ.)
 1"= 4' (VERT.)

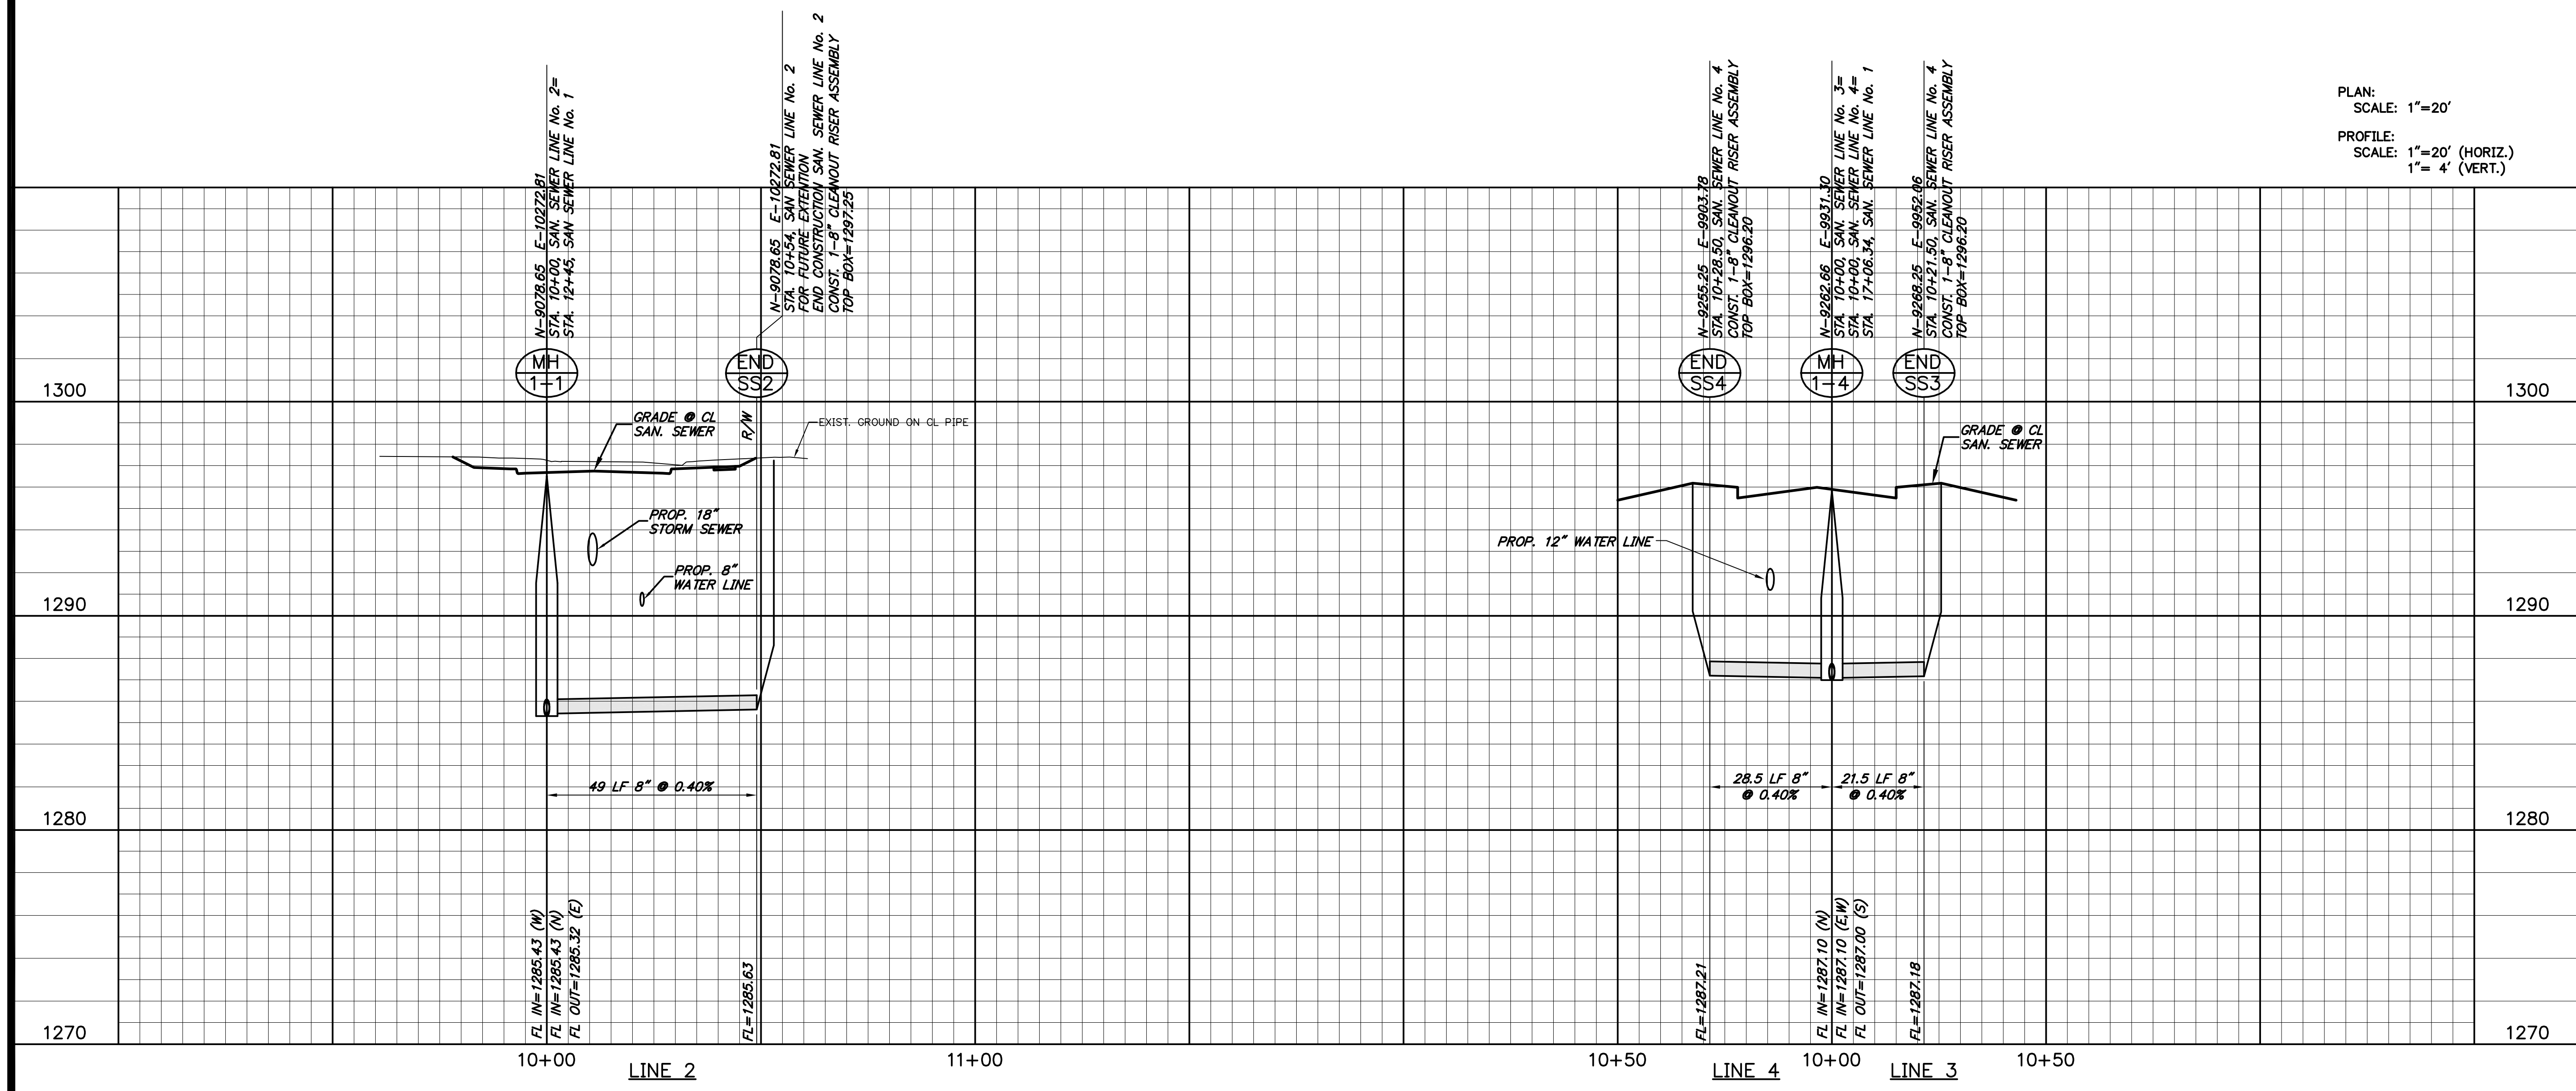

SEE SHEETS SS1.1 THROUGH SS1.5 FOR SANITARY SEWER LINES 1 THROUGH 5. SEE SHEETS SS1.6 THROUGH SS1.10 FOR WATER LINES 1 THROUGH 10. SEE SHEETS SS1.11 THROUGH SS1.15 FOR STORM SEWER LINES 1 THROUGH 15. SEE SHEETS SS1.16 THROUGH SS1.20 FOR GAS LINES 1 THROUGH 20. SEE SHEETS SS1.21 THROUGH SS1.25 FOR UTILITY LINES 1 THROUGH 25.

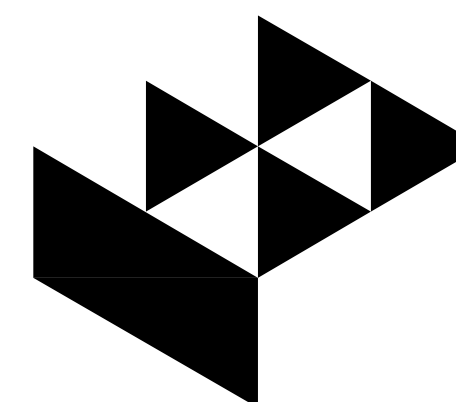

Gossen Livingston

Architecture
420 South Emporia
Wichita, KS 67202
Tel: (316) 265-9367
Fax: (316) 265-5646
Email: architecture@gl.com

© 2005 Gossen Livingston Associates, Inc.

The drawing and all information herein is the exclusive property of Gossen Livingston Associates, Inc. and is not to be copied or used in any way without the express written consent of Gossen Livingston Associates, Inc. All drawings, specifications, ideas, designs and arrangements appearing herein constitute the original and unpublished work of:

Gossen Livingston Associates, Inc.




Johnson & Associates, Inc.
100 E. California Ave. - Third Floor
Oklahoma City, OK 73104
(405) 235-8075 FAX (405) 235-8078

Certificate of Authorization #E-1128 EXP. DATE: 12-31-2006



PLAN:
SCALE: 1"=20'


PROFILE:
SCALE: 1"=20' (HORIZ.)
1"= 4' (VERT.)

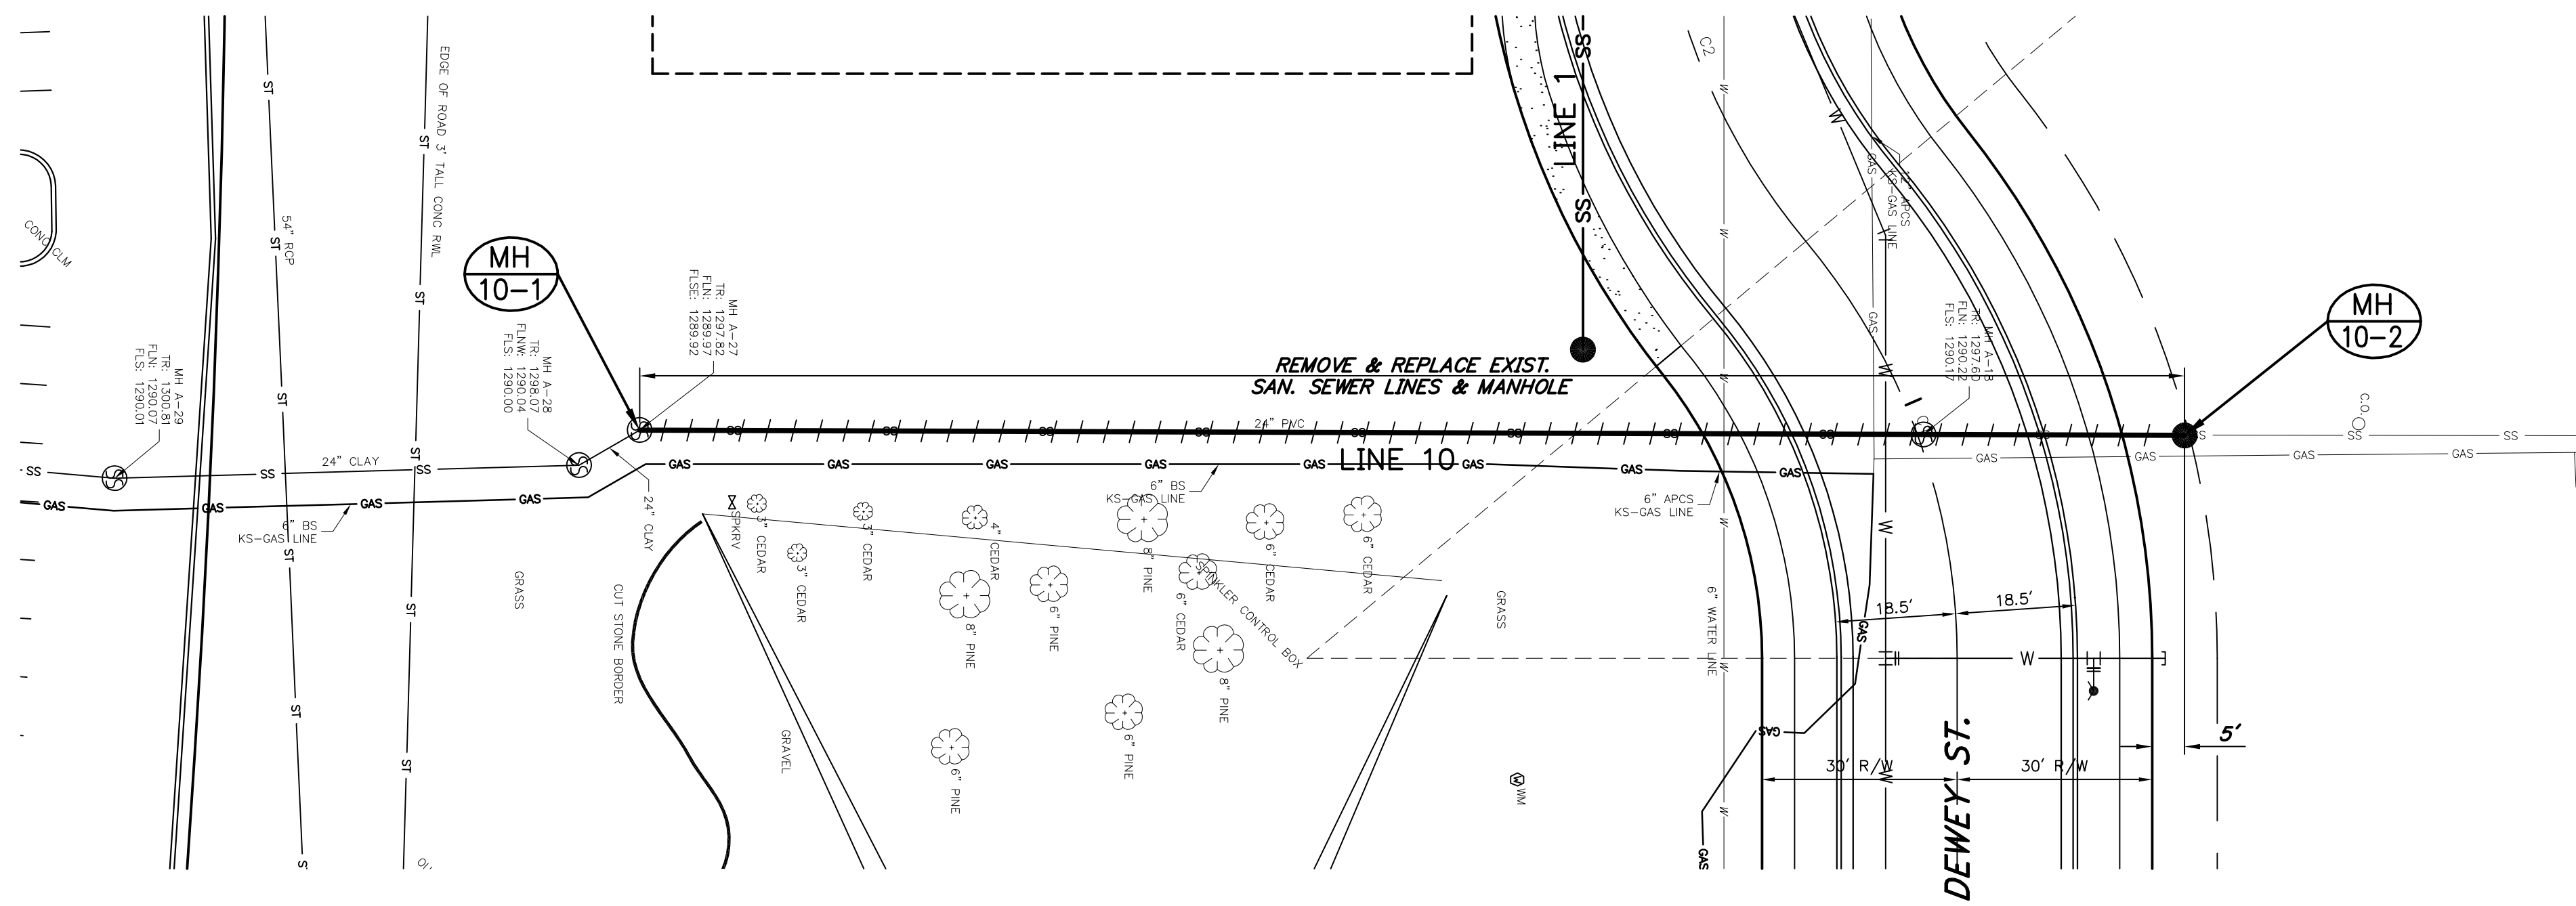

N-893361 E-1053010
STA 12+37.59 SAN SEWER LINE No. 10
EXIST. MANHOLE
TOP RIM=1297.82



N-917120 E-1053102
STA 12+37.59 SAN SEWER LINE No. 10
CONST. STD. TYPE P LINED MANHOLE, 5' DIA.
TOP RIM=1299.00

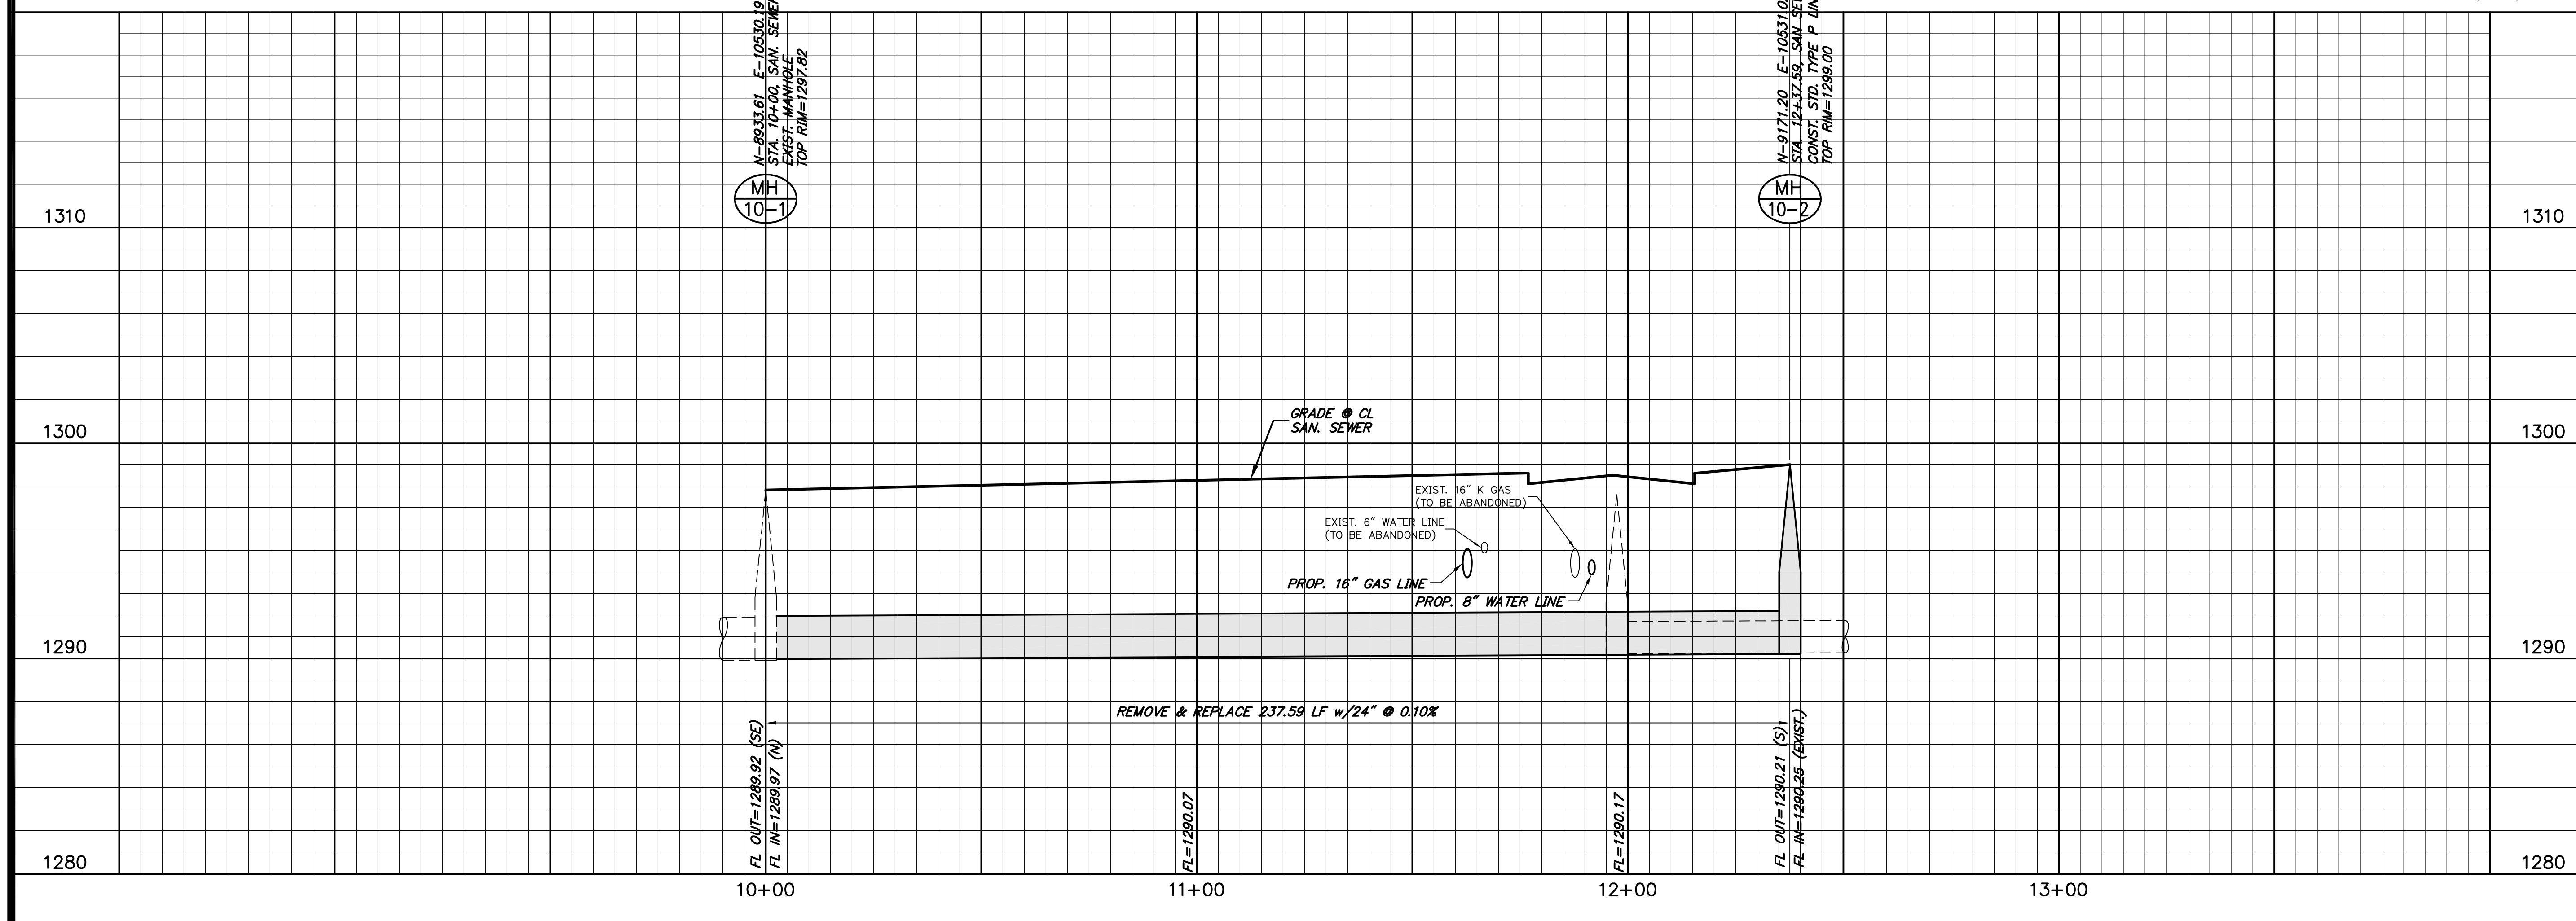

WICHITA WATERWALK

PUBLIC IMPROVEMENTS PHASE I

Mark	Date	Description

SANITARY SEWER No. 10

Job No.	SS1.4
Date	02-15-05
Drawn	BC
Checked	PB

57 of 68