

CITY OF WICHITA, KANSAS  
 MICHAEL E. LINDEBAK, P.E., CITY ENGINEER

ROAD CLOSURES


ASSOCIATED WITH

CENTRAL RAIL CORRIDOR

CITY OF WICHITA PROJECT NO. 468-83473 PHASE II  
 OCA NO. 715226

INDEX OF SHEETS

- 1 Title Sheet
- 2 Streets & SWS Key Map & General Notes
- 3 Typical Sections
- 4 9th St. Plan
- 5 10th St. Plan
- 6 10th St. & Santa Fe Plan
- 7 11th St. Plan
- 8 15th St. Plan
- ~~9-10~~ ~~18th St. Plan (Deleted)~~
- 11 Standard Drive
- 12 Concrete Pavement Details
- 13 Miscellaneous Details
- 14 Storm Sewer Line No. 100, 200 & 500
- 15-16 Storm Sewer Line No. 300
- ~~17~~ ~~Storm Sewer Line No. 400 (Deleted)~~
- 18-21A Storm Sewer Standards
- 22 Railroad Clearance Detail
- 23-24 Signing Plans
- 25 Signing Details
- 26 Sanitary Sewer Key Map & General Notes
- 27 Horizontal & Vertical Control for Water & Sewer
- 28 Sanitary Sewer Line No. 1
- 29-30 Sanitary Sewer Standards
- 31 Waterline Key Map & General Notes
- 32 Waterline Standard
- 33-41 Waterline Plans
- 42-43 City of Wichita Waterline Maps
- 44-47 BMP's
- 48-60 Cross-Sections

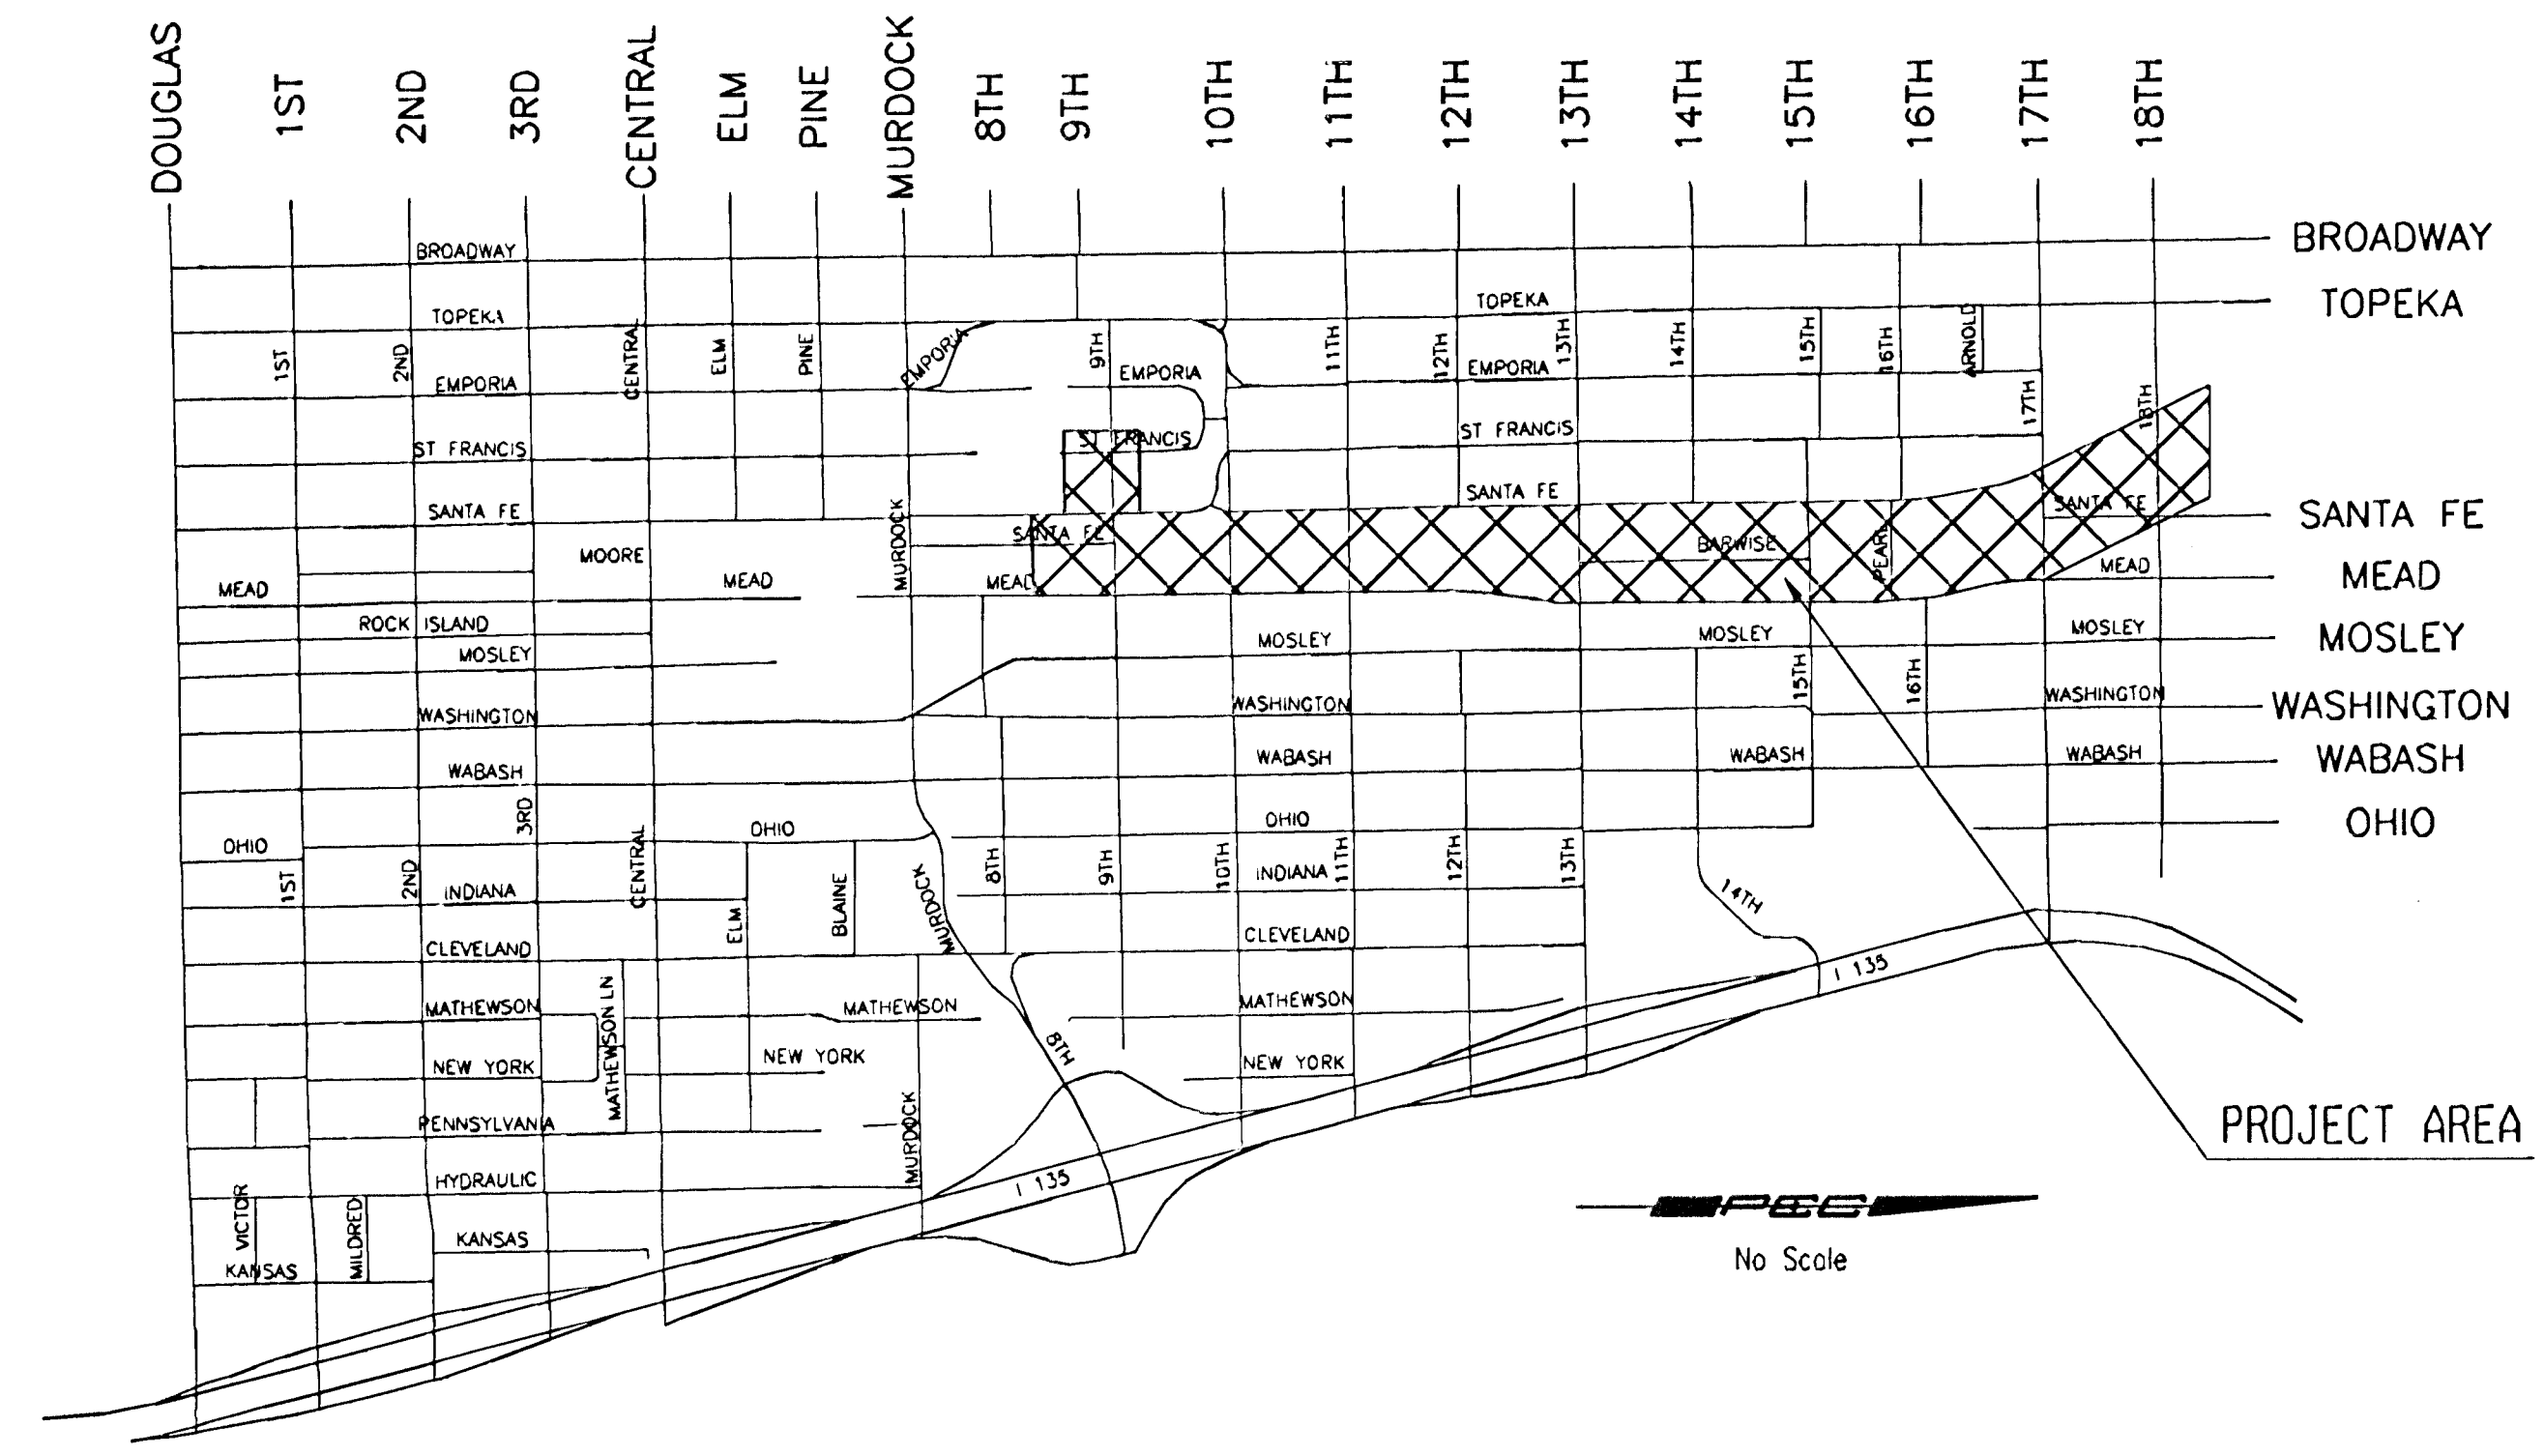

SS AS BUILT  
 6/29/04 ROL

MAY 2003

PLANS PREPARED BY  
 PROFESSIONAL ENGINEERING CONSULTANTS, P.A. ENGINEERS  
 & HNTB ARCHITECTS ENGINEERS PLANNERS  
 WICHITA, KANSAS

	Professional Engineering Consultants, P.A. Responsible for Street & SWS sheets No. 1-25 and 44-60
	Professional Engineering Consultants, P.A. Responsible for Sanitary Sewer and Waterline sheets No. 26-36, 42 and 43
	HNTB ARCHITECTS ENGINEERS PLANNERS Responsible for Waterline sheets No. 37-41

DSNR: RWM OPER: DRP SCALE: 1/1999/99189/Bld set 2/Title.dgn 6-14-2002 8:25:35 LAST REV: 9-26-2002 BY: DRP