


BENCHMARKS:
 BM #1: ARKANSAS RIVER BRIDGE &
 63RD ST. S. CITY OF WICHITA
 BENCHMARK DISC. SW COR. OF
 BRIDGE, TOP OF HUBGUARD. 500'±
 E. OF GROVE.
 ELEV. = 1269.95 MSL

BM #2: BRASS PLATE ON THE NE
 WINGWALL OF ARKANSAS RIVER
 BRIDGE & 63RD ST. S.
 ELEV. = 1267.48 MSL

Scale: 1" = 20'
 • = Iron

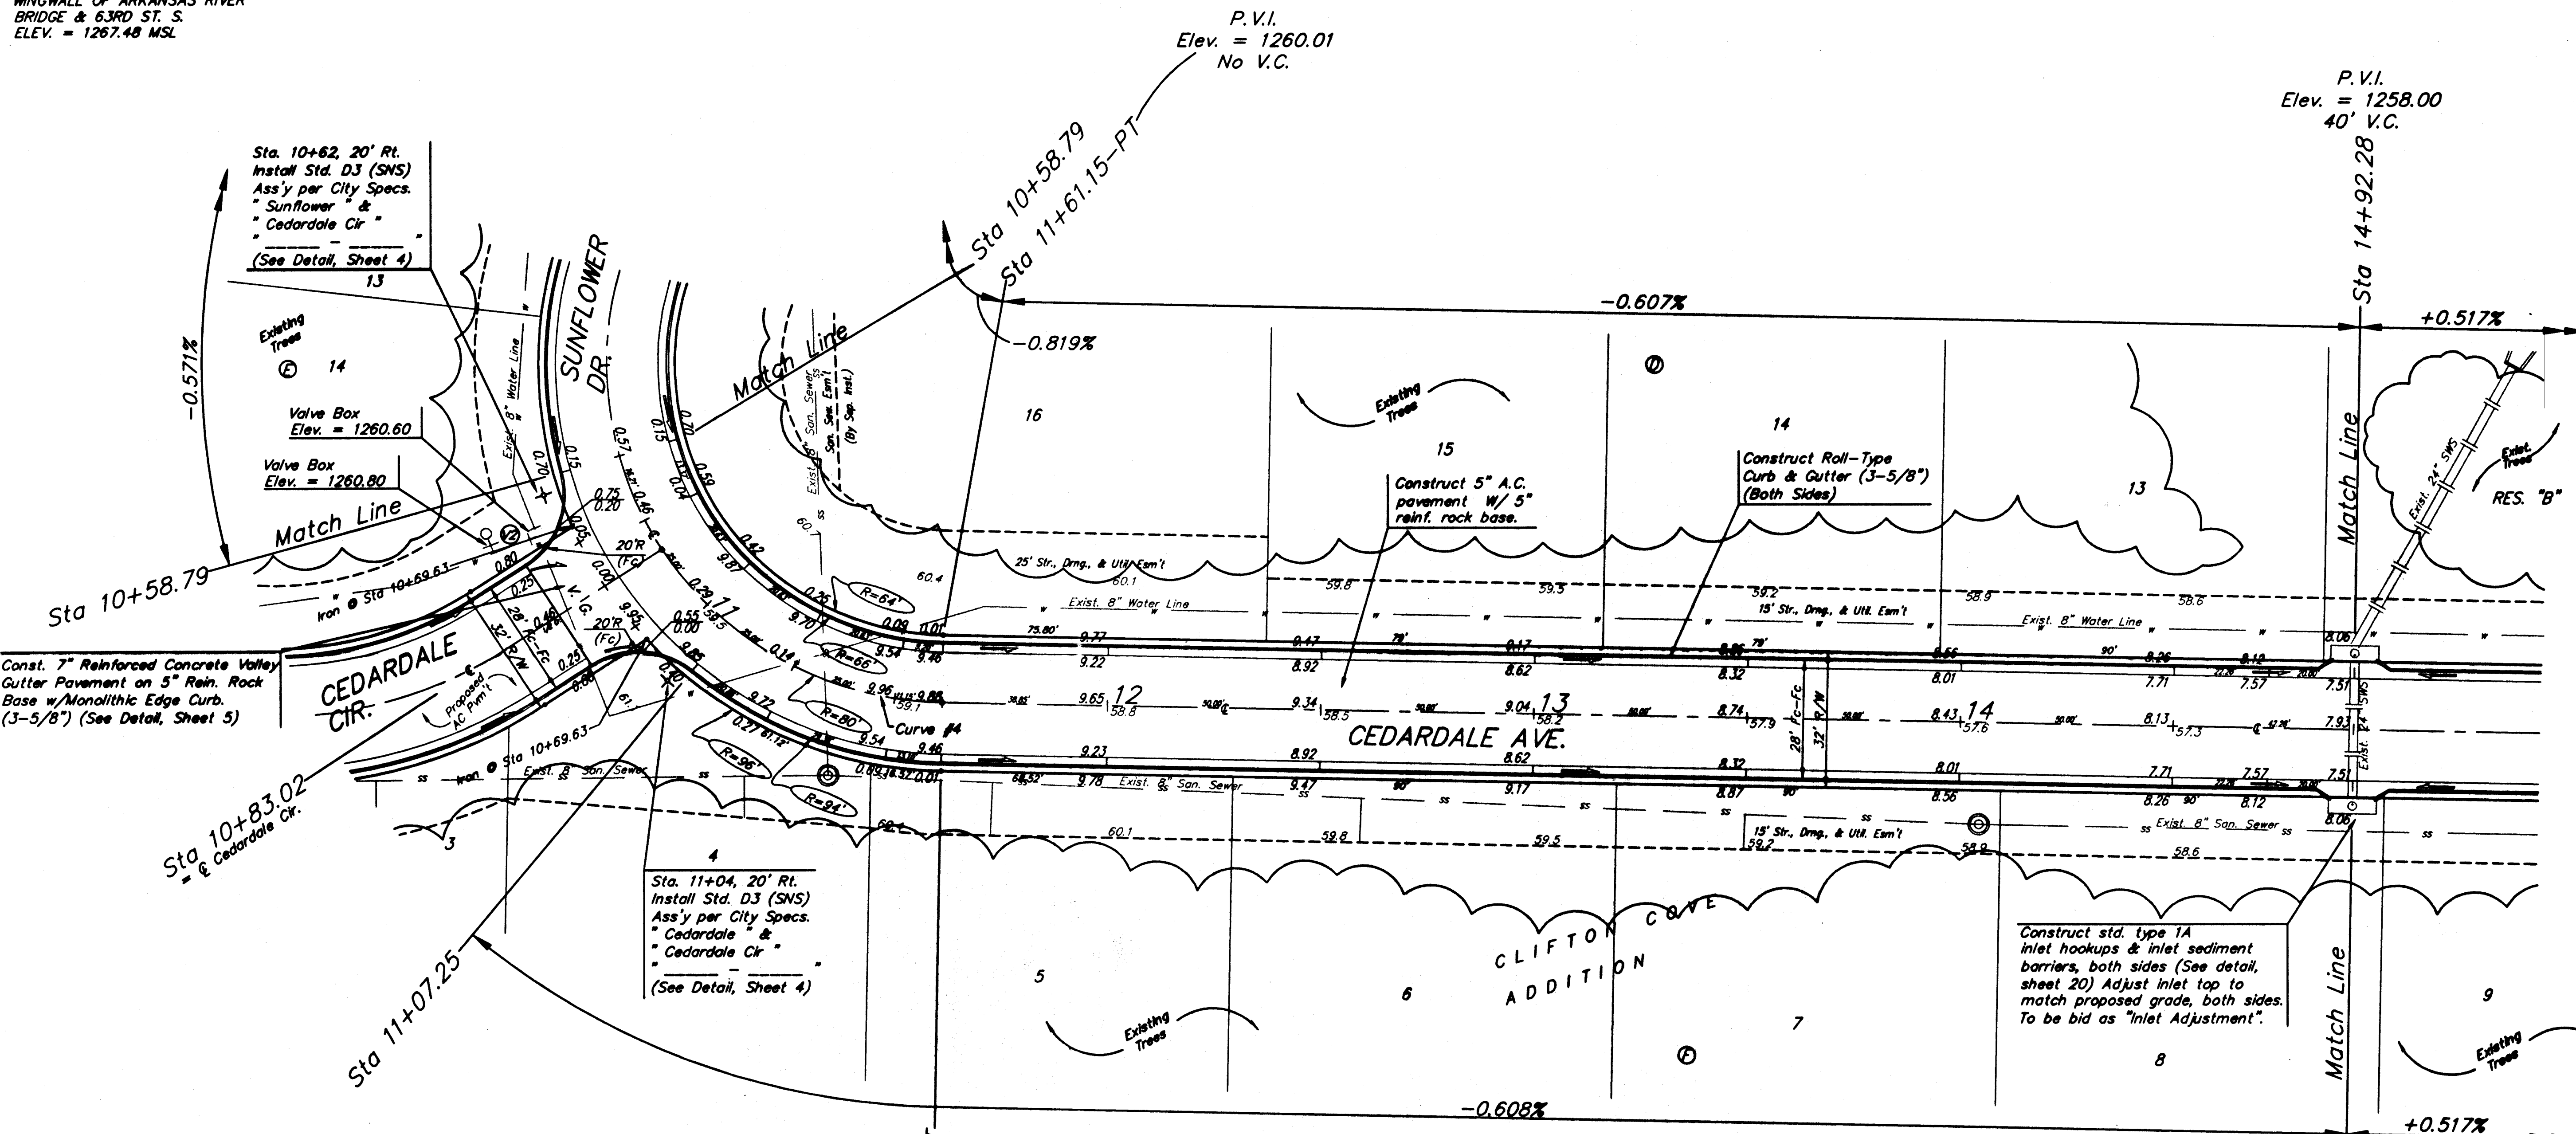

WATER VALVE LOCATION TABLE

VALVE NUMBER	BASELINE STATION	OFFSET DISTANCE	OFFSET DIRECTION
V2	10+68.69	24.36'	Rt.

Paving contractor will be responsible to operate all water valves on the project, in the presence of the inspector, to ensure accessibility to the valves, and that all valves are left in the "ON" position when the project is completed.

Curve #4
 Curve Data Based on Centerline
 Rad. = 80' Delta = 137° 50' 56" Tangent = 207.53'
 Arc = 192.47' L.C. = 149.30' Del/Ft. = 21.46630 Min.

Station	Arc	FACE CHORD LENGTHS				T. Del.
		8' Lt.	8' Rt.	Del.	T. Del.	
9+68.68	-	-	-	0.0000	0.0000	-
9+75.00	6.32'	4.58'	8.06'	2.7548	2.7548	-
10+00.00	25.00'	18.05'	31.75'	8.5708	11.1297	-
10+25.00	25.00'	18.05'	31.75'	8.5708	20.1005	-
10+50.00	25.00'	18.05'	31.75'	8.5710	28.6716	-
10+58.79	8.79'	6.37'	11.20'	3.0853	32.7568	-
10+75.00	16.21'	11.73'	20.63'	5.4817	38.0425	-
10+83.02	8.02'	5.81'	10.22'	2.9220	40.9645	-
11+00.00	16.98'	12.29'	21.61'	6.0450	47.0135	-
11+07.25	7.25'	5.25'	9.24'	2.3546	49.3721	-
11+25.00	17.75'	12.84'	22.59'	6.2123	55.5844	-
11+50.00	25.00'	18.05'	31.75'	8.5710	64.5554	-
11+61.15	11.15'	8.08'	14.21'	3.5934	68.5528	-

Existing Trees Shall be removed ONLY with approval of the Engineer. Trees Not In Direct Conflict With Proposed New Construction Shall Remain And Be Protected From Damage. Cost to be Included in Bid Item "Site Clearing & Restoration"

AS BUILT 4/2/17
 Roll type curb & gutter to be constructed on the pavement on this sheet. Top of curb elevation are given for full height curb.

Baughman

Clifton Cove Addition - Phase 1

CEDARDALE AVE.

STA 10+58.79 TO STA 14+92.28

Engineering | Surveying | Planning | Landscape Architecture

PROJECT NUMBER: 472-24237

REVISIONS:

DESIGN: MWS/JAK

DRAWN: TMS

DATE: 5/17/06

SCALE: Noted

SHEET: 9 OF 31

Clifton Cove Addition Phase 1 (V1) 05-08-E320