


PLAN VIEW
SCALE: 1" = 20'-0"

WICHITA DATUM USED -
10.00 ADDED TO ALL ELEVATIONS
SHOWN ON DWG L.1.2

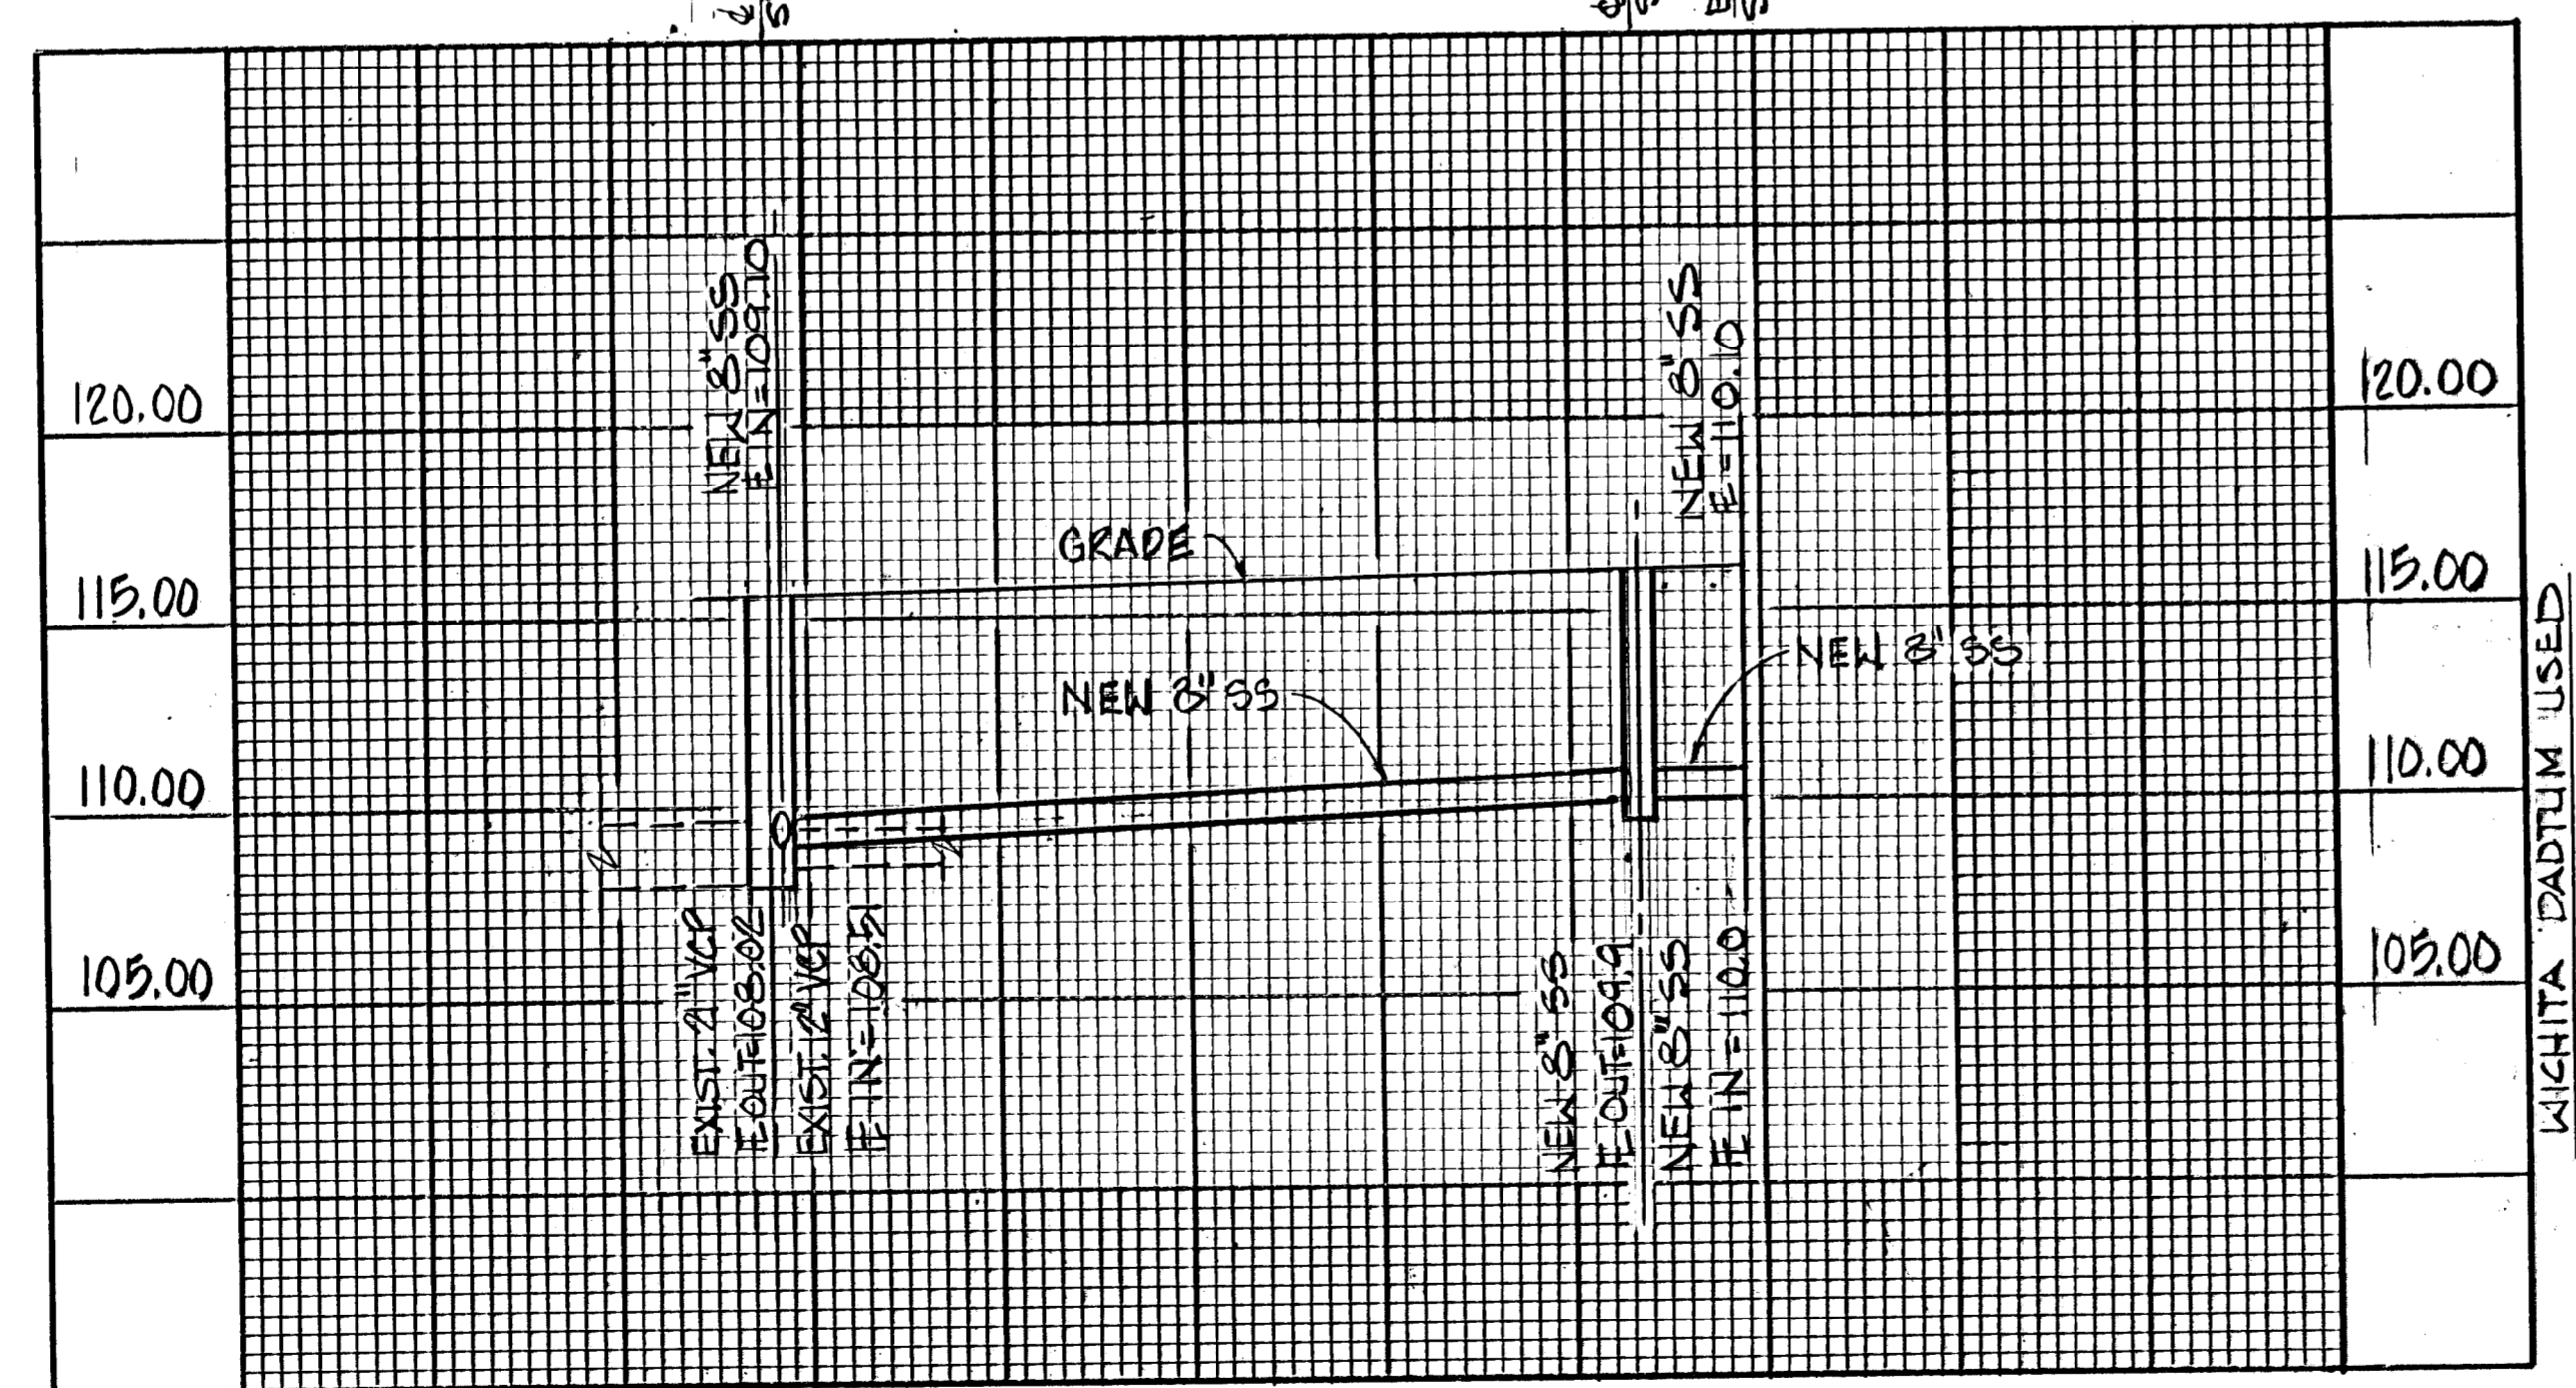

PROFILE VIEW
SCALE: 1" = 20'-0" HORIZONTAL
1" = 5'-0" VERTICAL

- LEGEND**
- T.C. - TOP OF CURB
 - B.C. - BOTTOM OF CURB
 - T.P. - TOP OF PAVEMENT
 - CL - CENTER LINE
 - - CULVERT (DRAINAGE)
 - - FLOW DIRECTION
 - S- SEWER LINE
 - W- WATER LINE
 - STA. STATION NUMBER
 - EL. ELEVATION (CITY DATUM)
 - - MANHOLE (DRAINAGE)
 - - DRAIN
 - CL - FLOW LINE
 - SS - SANITARY SEWER

APPROVED AS NOTED
By CITY ENGINEER OF WICHITA
Sanitary Sewers KRH 2/4/92
Storm Sewers _____
Highway Approaches _____
Water Mains _____

NOTE TO CONTRACTOR
INSPECTION AND TESTING FOR THIS PROJECT IS TO BE PERFORMED BY A LICENSED CONSULTING ENGINEERING FIRM UNDER CONTRACT WITH THE OWNER/DEVELOPER. SAID INSPECTION SHALL BE IN ACCORDANCE WITH THE CITY OF WICHITA STANDARDS AND PRACTICES AND CERTIFIED PROFESSIONAL ENGINEERS. NO WORK SHALL BE PERFORMED IN DEDICATED EASEMENTS OR THE PUBLIC RIGHT-OF-WAY BY THE CONTRACTOR WITHOUT SUCH INSPECTION AND TESTING. ALL WORK BE COMMENCED IN DEDICATED EASEMENTS OR PUBLIC RIGHT-OF-WAY WITHOUT WRITTEN AUTHORIZATION BY THE CITY ENGINEER.

PROJECT NO. 327PPS (607861)

3				
2				
1				
NO.	DATE	REVISIONS	BY	APP'D.

CITY OF WICHITA
SAINT FRANCIS HOSPITAL
"P" BUILDING SANITARY
SEWER PLAN & PROFILE

SHEET NO. 1 of 1	SCALE 1" = 20'-0"	APP'D.	QUANTITIES	TRACED
DESIGNED WAB	DETAILED BKT		QUAN. CK.	TRACE CK.
DESIGN CK. RWD	DETAL. CK. RWD			
JAN. 24, 1992				