


VICINITY MAP

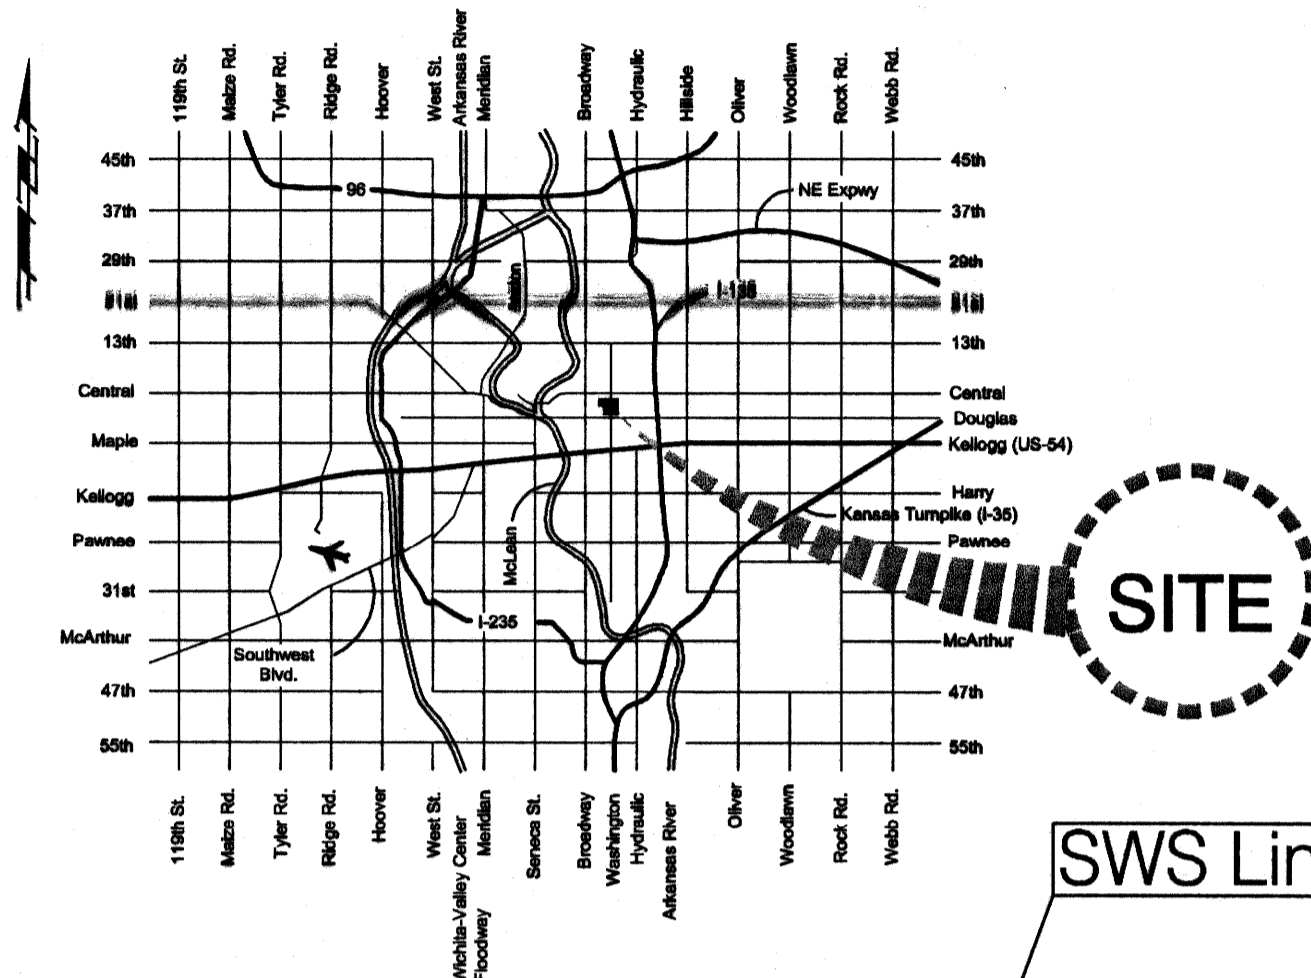

# CONSTRUCTION PLANS FOR PROPOSED STORM WATER SEWER COLLECTION SYSTEM IMPROVEMENTS DOUGLAS AVENUE DRAINAGE OUTFALL PROJECT

## ~ PHASE 2 ~

FOR  
THE CITY OF WICHITA, KANSAS  
James L. Armour, P.E., City Engineer

Project No. 468-84060  
O.C.A. No. 660798

3rd Street Sanitary Sewer  
Replacement Project

Project No. 468-84490  
O.C.A. No. 620475

Wabash Water Main  
Replacement Project

Project No. 448-90366  
O.C.A. No. 636198

3rd Street North  
Water Main  
Extension Project

Project No. 448-90217  
O.C.A. No. 636197

February 2008


WB Carter Construction - Contractor  
K. Graber - City of Wichita, Inspector  
As-built  
Release Date: 7/6/2009  
pdf: APRosas 10/28/2009

Index

- 1 Title Sheet
- 2 Key Sheet
- 3 Notepage
- 4-9 SWS Line 4 Plan/Profile
- 10-13 SWS Lines 4a-4j Plan/Profile
- 14 SWS Line 5 Plan/Profile
- 15 SWS Lines 5a-5b Plan/Profile
- 16 SWS Line 6 Plan/Profile
- 17-26 SWS Details
- 27 3rd St. N SS Replacement Plan/Profile
- 28-30 3rd St. N. Water Main Extension Plan/Profile
- 31-32 Wabash Water Main Replacement Plan/Profile
- 33 Water Meter Relocation Table
- 34 Standard Water Details
- 35-38 Pavement Typical Sections & Details
- 39-41 3rd Street North Paving Plan
- 42-44 Wabash Paving Plan
- 45 2nd Street Paving Plan
- 46 Reinf. Concrete Joint Plan
- 47 Quantity Recapitulation Sheet
- 48 Seeding /Sodding Restoration Plan
- 49 Erosion Control Plan
- 50-53 Erosion Control Details
- 54 Drainage Basin Map

SCALE: 1" = 175'

DOUGLAS AVENUE  
DRAINAGE OUTFALL PROJECT  
~ PHASE 1 ~

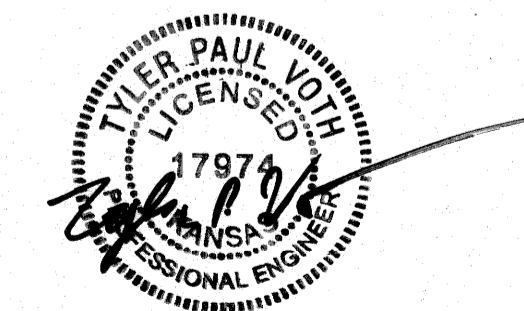

APPROVED - DATE 2-6-08  
*James L. Armour*  
JAMES L. ARMOUR, P.E., CITY ENGINEER  
CITY OF WICHITA, KANSAS