



**NOTE:** ALL LINES TO BE INSTALLED BY OTHERS ARE SUBJECT TO OCI REVIEW

**NOTE:** CONTRACTOR TO VERIFY DEPTH AND LOCATION OF EXISTING UTILITIES PRIOR TO CONSTRUCTION.

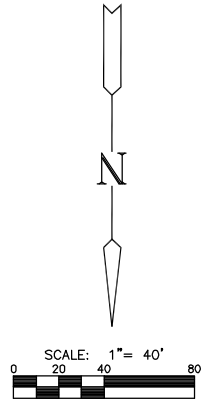

**PLAN LINE 1**

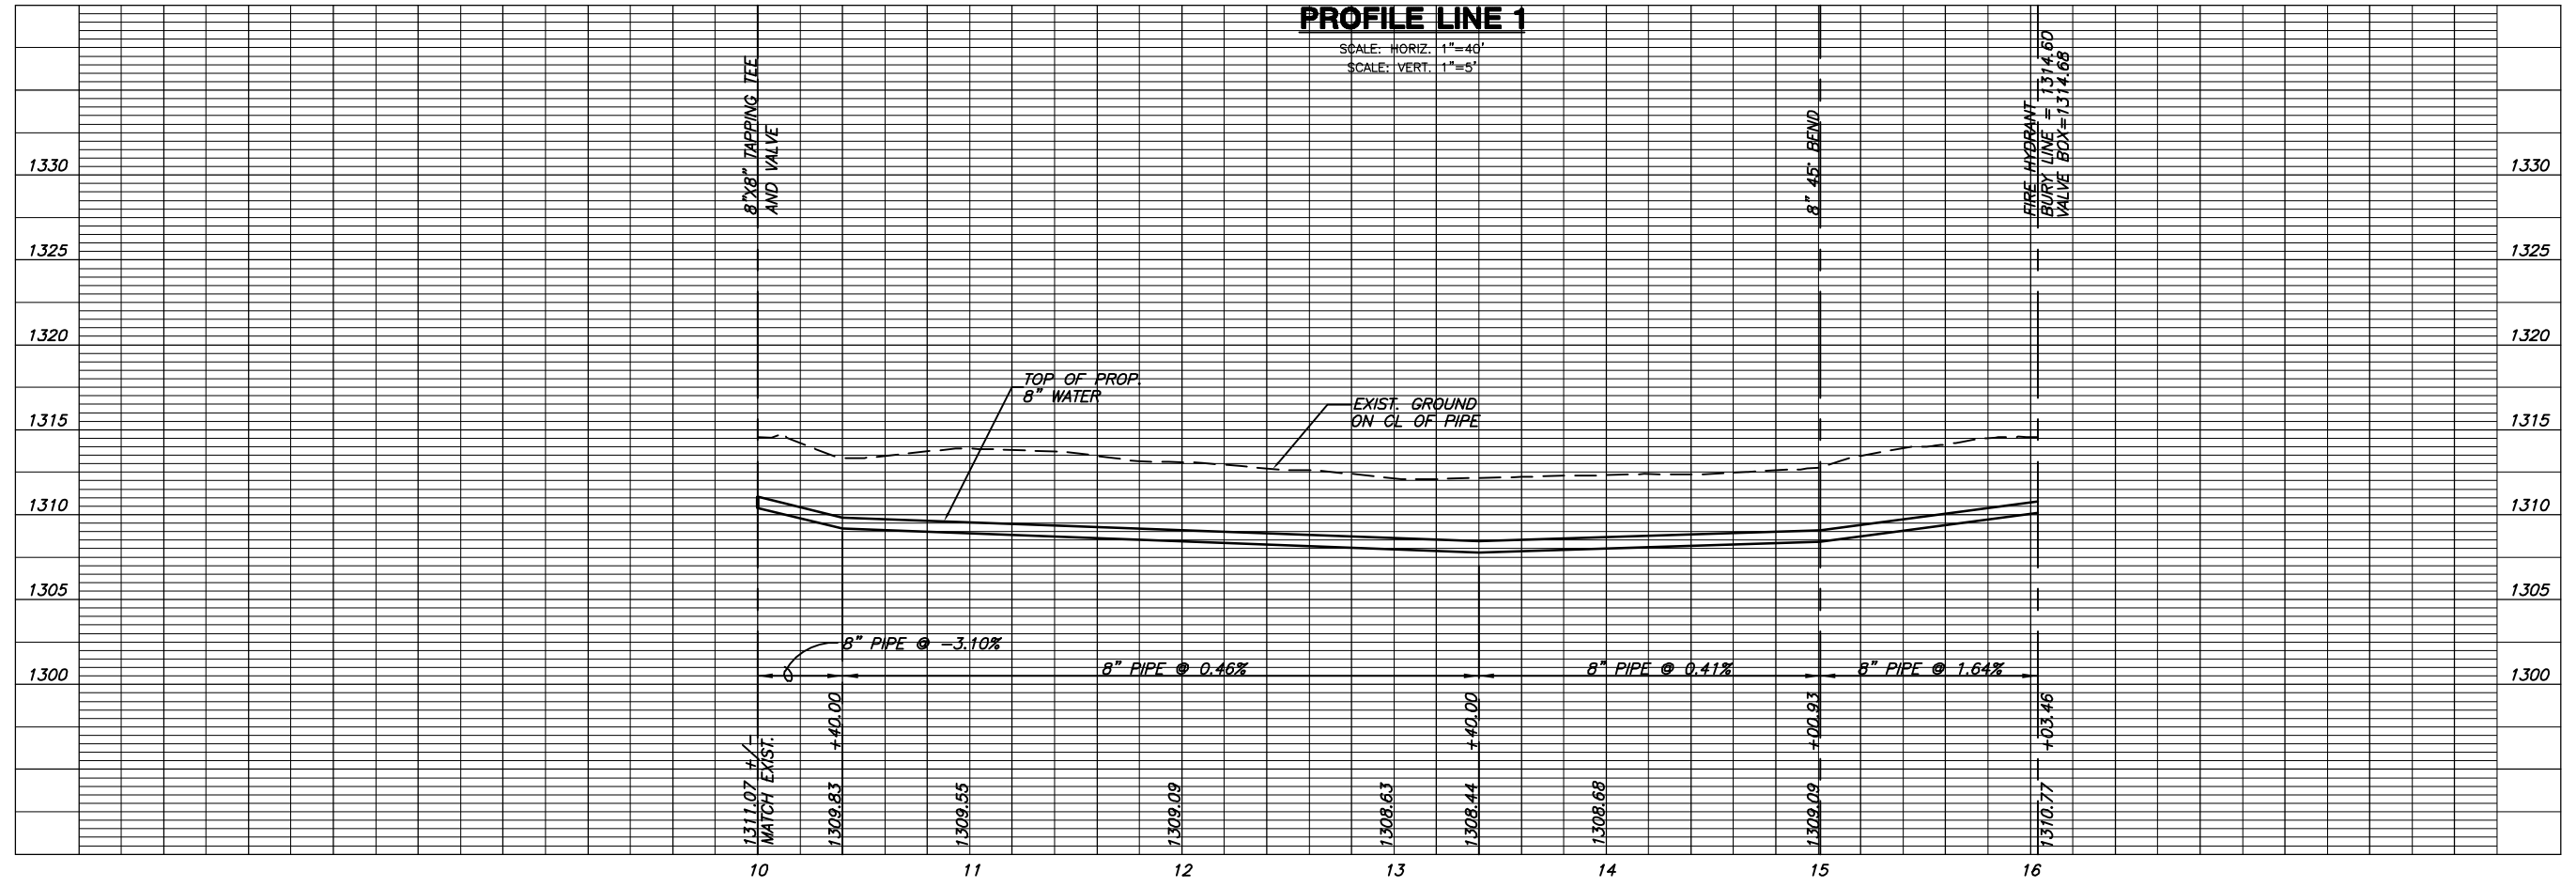

**NOTE:** WATER LINE VALVES TO BE OPERATED BY CONTRACTOR ONLY IF WATER INSPECTOR IS ON SITE.

**AS-BUILT PLANS**  
**CONTRACTOR:**  
**INSPECTOR: JEFF CARTWRIGHT, MKEC**  
**ENGINEERING**  
**PDF BY: DM, 1-26-10**

**MKEC**  
 ENGINEERING  
 CONSULTANTS  
 411 N. WEBB ROAD  
 WICHITA, KS. 67206  
 3 1 6 - 6 8 4 - 9 6 0 0



C:\GLICKMAN METALS\08273\_C1\_AS\_BUILT.DWG

GLICKMAN RECYCLING - SN3035  
 HS80115 SHREDDER

WATER LINE 1 PLAN & PROFILE

DATE	BY	CHKD	SCALE	DRAWING NUMBER	REV
OCT. 2008	TKL	SRS	1:40	C8	0