

WATER DISTRIBUTION SYSTEM IMPROVEMENTS

TO SERVE

GODDARD MAINTENANCE BUILDING UNIFIED SCHOOL DISTRICT 265 GODDARD, KANSAS


PRIVATE PROJECT NO. 1541 PPW (607853)

CITY OF WICHITA, KANSAS

JAMES L. ARMOUR, P.E. - CITY ENGINEER

INDEX OF SHEETS

SHEET C310	TITLE SHEET
SHEET C311	KEY MAP AND GENERAL NOTES
SHEET C312-C313	PLAT
SHEET C314	PLAN/PROFILE
SHEET C303	STANDARD WATER ASSEMBLY DETAILS
SHEET C400-C402	SOIL EROSION BMP DETAILS

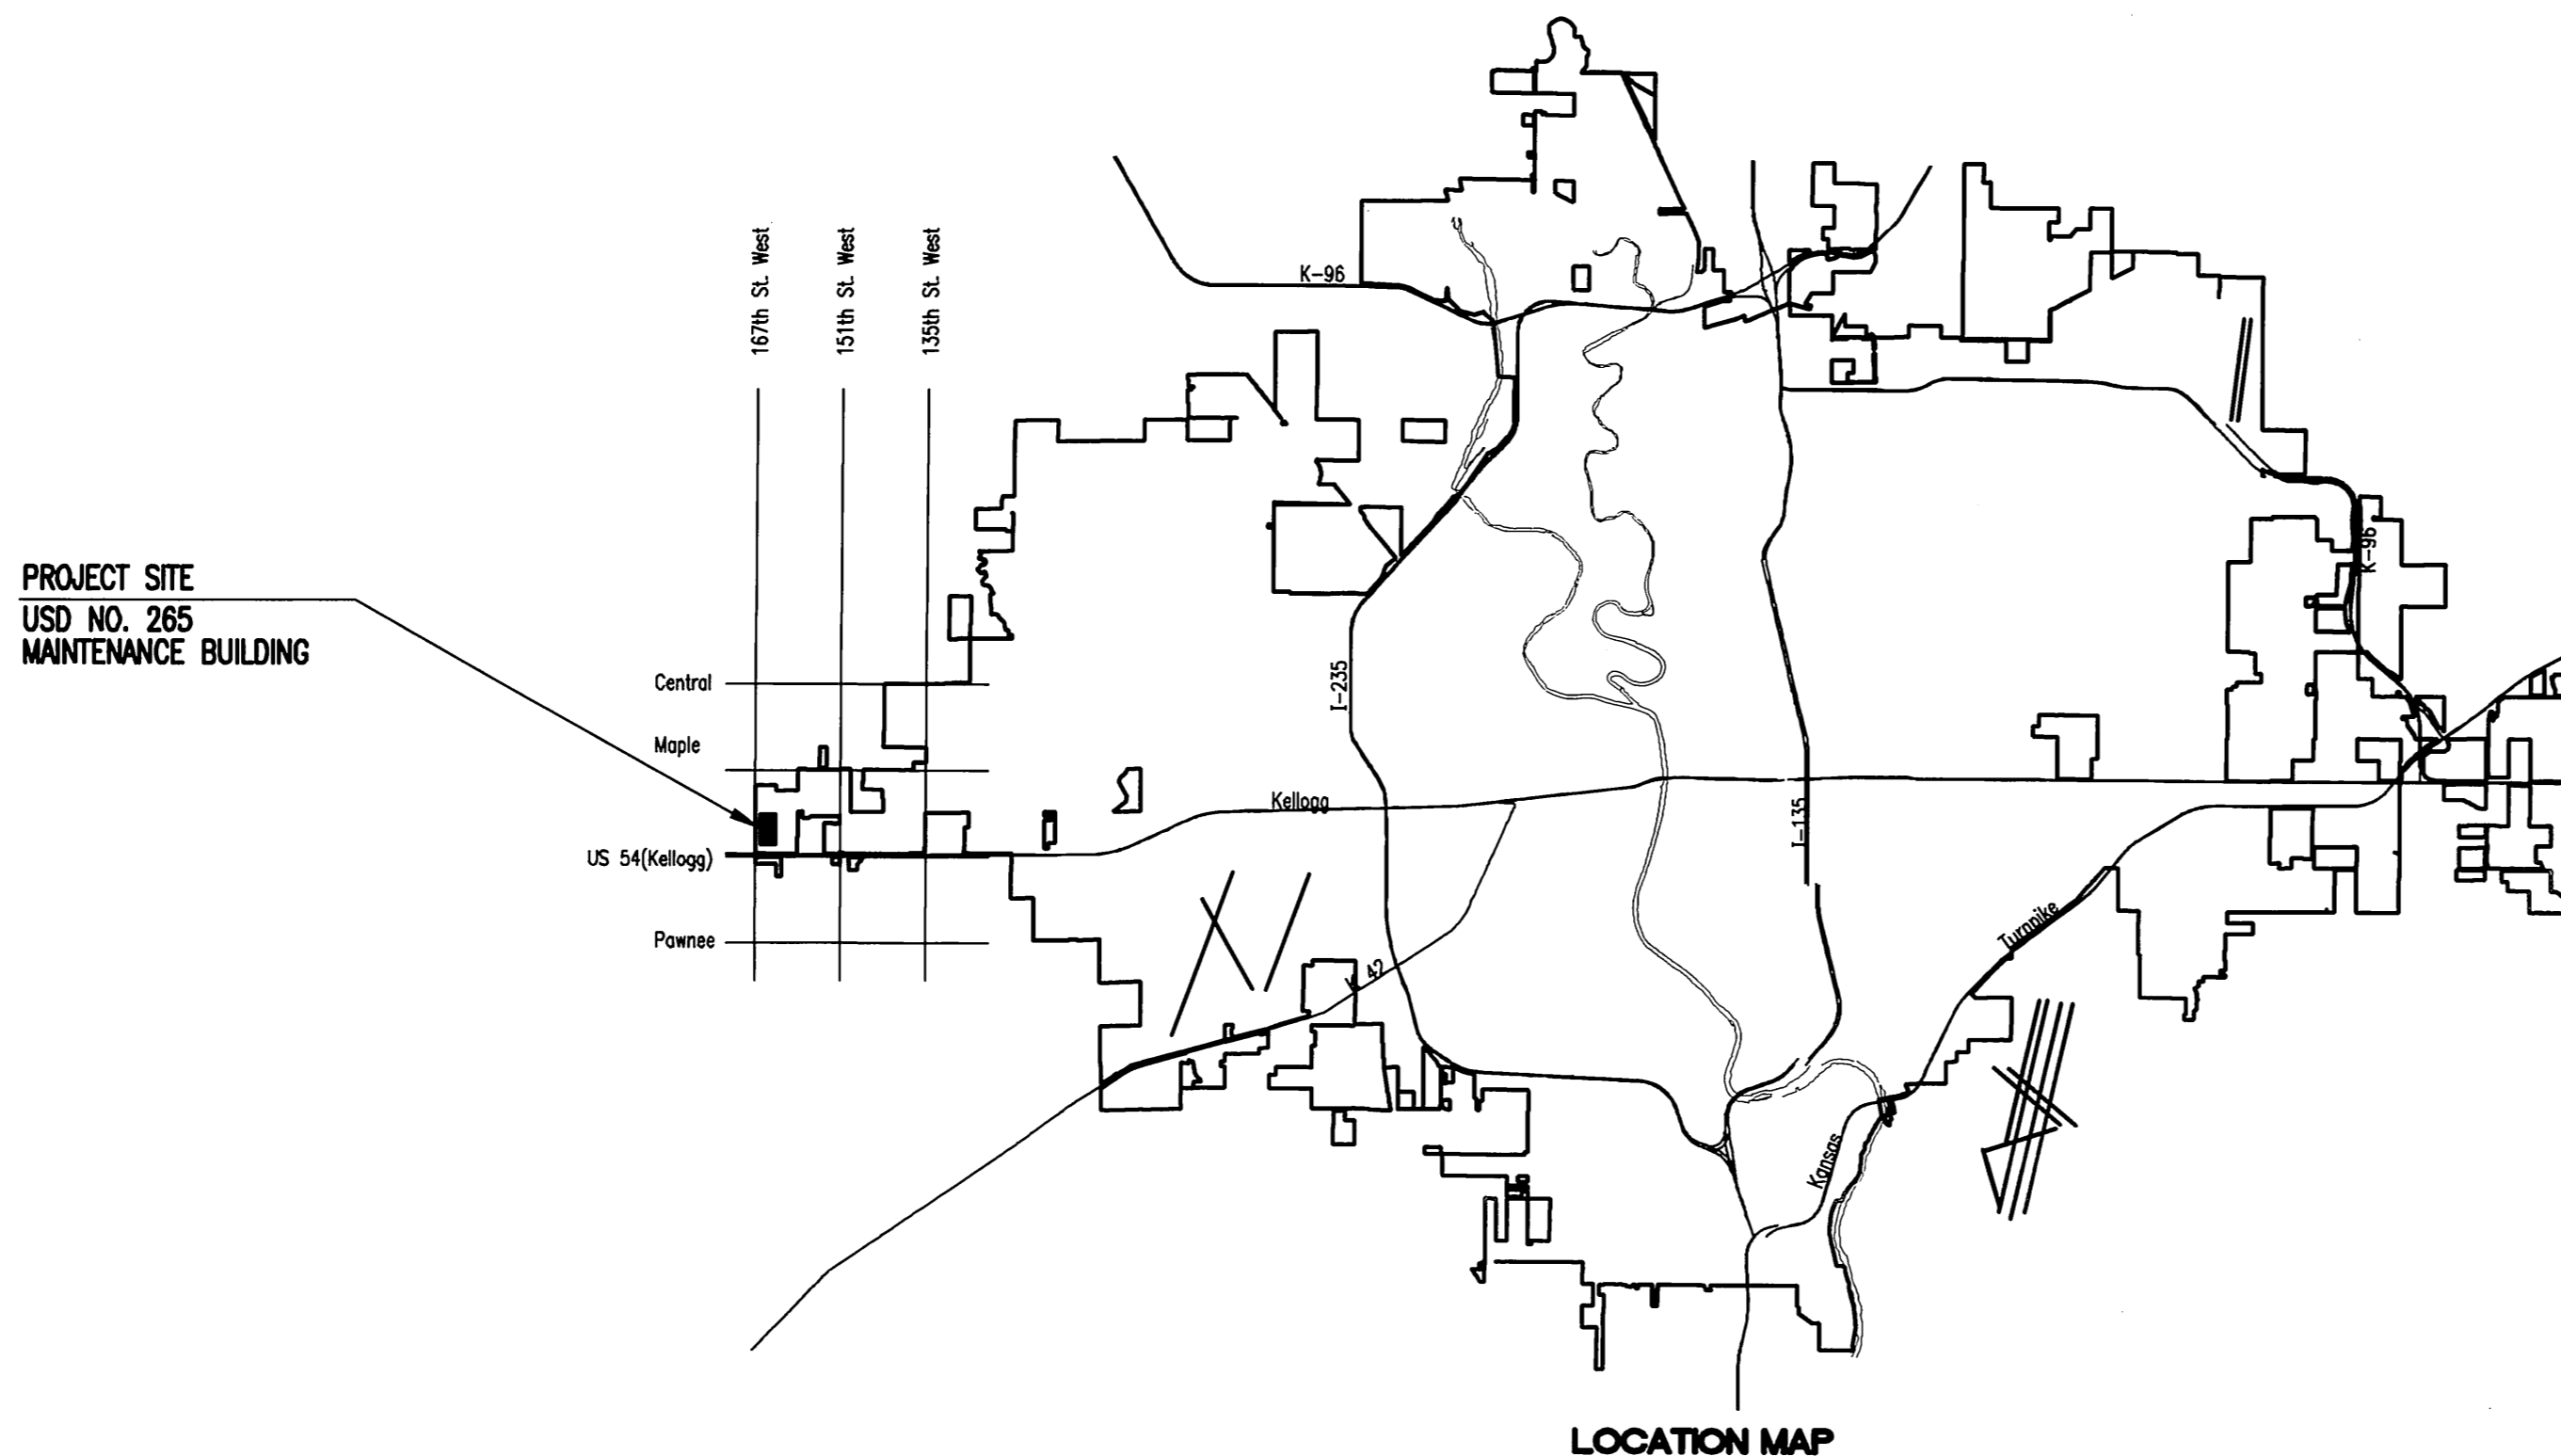

APPROVED AS NOTED
BY CITY ENGINEER OF WICHITA,
BY WICHITA WATER UTILITIES,
& BY WICHITA FIRE DEPARTMENT

Water Mains (Public Works) *[Signature]* 7/14/10
Water Mains (Water Utilities) *[Signature]* 7/14/10
Fire Prot. Line *[Signature]* 7/14/2010


NOTE TO CONTRACTORS

PUBLIC PROPERTY:
Inspection and testing for the waterline is to be provided by a Licensed Consulting Engineering Firm under contract with the Owner/Developer. Said inspection to be in accordance with the City of Wichita standard construction engineering practices and certified by a Licensed Professional Engineer licensed in the State of Kansas. No work shall be performed in dedicated easements or public right-of-way by the Contractor without such inspection nor shall any work be commenced without written authorization by the City Engineer. All Construction and Materials shall comply with the City of Wichita Specifications and Standards (on file and available in the City Engineer's Office).

PRIVATE PROPERTY:
Installation and testing for the fire protection line is to be performed by a City of Wichita licensed fire protection contractor in accordance with the fire codes as adopted by the City of Wichita. All materials and construction practices for the fire protection line shall comply with the fire codes as adopted by the City of Wichita (available from the City of Wichita Fire Department). The Contractor shall not commence work without notification and approval of the Wichita Fire Department.
Inspection of the fire protection line is to be provided by the City of Wichita Fire Department and by a licensed Consulting Engineering Firm under contract with the Owner/Developer.
The contractor shall not start work until the project inspector is assigned to the project and present on the site. Any work done without inspection will be required to be uncovered for inspection.

JULY 2010
PLANS PREPARED BY
PROFESSIONAL ENGINEERING CONSULTANTS, P.A.
ENGINEERS
WICHITA, KANSAS


As Built Plans:
CONTRACTOR: Ewertz Exc.
INSPECTOR: Tom Jones, K E Miller Engineering
.PDF by: LGG, 10-26-2010

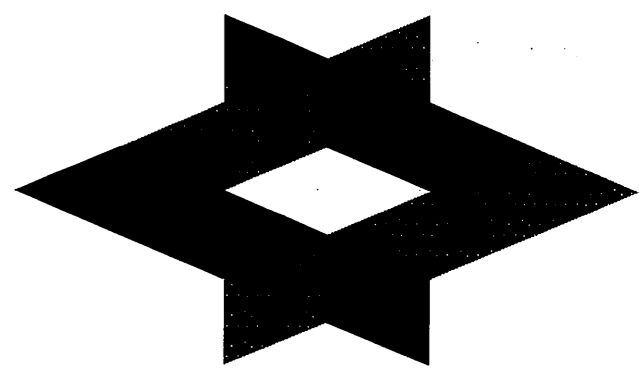

GLMV Architecture
420 S. Emporia, Wichita, KS 67202
Tel: (316) 265-9367

125 S. Washington, Wichita, KS 67202
Tel: (316) 262-0451

www.glmv.com

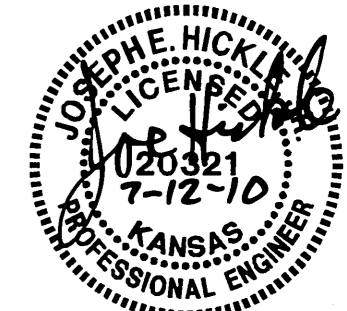

© 2010 GLMV Architecture, Inc.
All work herein is the exclusive property of GLMV Architecture, Inc. and is not to be copied or used in any way without the express written consent of GLMV Architecture, Inc. All drawings, specifications, ideas, designs and arrangements appearing herein constitute the original and unpublished work of GLMV Architecture, Inc.

**MAINTENANCE BUILDING
UNIFIED SCHOOL DISTRICT 265
GODDARD, KANSAS**

△1	5/10/10	ITEMS PER ADDENDUM 1
△2	5/17/10	ITEMS PER ADDENDUM 2
△3	6/18/10	OCI COMMENT REVISIONS
Mark	Date:	Description

PPW TITLE SHEET

Job No.	1185,090	C310
Date	07/07/10	
Drawn	RFT	
Checked	JEH	
Dwg.	of	

Save: 07-12-2010 11:05:10 AM by RFT
Plot: 07-12-2010 11:41:16 AM by RFT
C:\G:\UNIVERSITY\2010\1541-PPW\1541-PPW Title Sheet

Professional Engineering Consultants, P.A.
303 S. DOCKEA - WICHITA, KANSAS 67202 • 316-262-2601
www.pce.com • design@pce.com