

GENERAL NOTES:

1. Contractor will be required to provide notice to utility companies a minimum of twenty-four (24) hours prior to any excavation, as follows:

Kansas One-Call (316)687-2470

The Contractor must notify the following in case of an emergency:

Cox Communications (316)262-4270
or (316)263-2061

Westar Energy/ (800)482-4950
Kansas Gas & Electric Company 1-555-1212

AT&T (316)268-4908

City of Wichita Water Department (316)268-4071

City of Wichita Sewer Department (316)941-1608
Blackhills Natural Gas (800)303-0357

2. Exist. utilities and their locations, as shown on the plans, represent the best information attainable for design. Location information has been obtained from the various utility companies and is either from company record drawings or company-provided field locations. The Contractor will be required to work around existing utilities which do not conflict with proposed constructions.

3. The Contractor to verify utility locations prior to construction of this project.

4. Utility service and installation shall be coordinated with the respective utility owner. Contacts are:

Kansas Gas Service	Jim Coe	(316)832-3126
Westar Energy	Miles Capps	(316)261-6251
Blackhills Natural Gas	Calvin Briggs	(316)942-8811
Wichita Water & Sewer	Kerry Gibson	(316)268-4555
AT&T	Jim Toben	(316)268-2759
Cox Communications	Mark Anaya	(316)262-4270

5. All lawn/turf areas disturbed by construction of proposed improvements shall be restored with the same grass as existing. Restoration of disturbed areas shall include, but not limited to, to soil preparation, fertilizing, sodding. All work shall be in accordance with the City of Wichita Standard Specifications and the City of Wichita Administrative Regulations No. AR 6.5 which governs cleanup and repair or replacement following construction. All cost for the soil preparation, sodding shall be paid for through the lump sum bid item for "Sodding."

6. Traffic affected by the construction of this project shall be handled in accordance with the latest edition of the Manual on Uniform Traffic Control Devices.

7. It is the contractor's responsibility to visit this site to better understand the extent of site clearing and restoration to be performed. Site Clearing and Restoration shall include all costs for removal of items which a pay item is not provided.

8. The contractor shall be responsible for preserving property irons. The contractor will be required to re-establish any property irons which are damaged or destroyed by the construction operations. Such irons shall be re-established by a licensed land surveyor in accordance with state laws.

9. Properties within the project limits may have underground sprinkler systems in public right-of-way which conflict with new construction. Contractor will be required to remove such improvements should they not be removed by their owner at the time of construction of the project. The contractor will be required to salvage all sprinkler heads and/or valves and give such material to owner. Portions of underground sprinkler systems not in conflict with new construction shall be protected from damage and shall remain in place. All work in connection with underground sprinkler systems shall be considered as subsidiary to the contract pay items for work.

10. Cuts made in paved surfaces on public property will be repaired by the City's Contractor and charged against the contractor. Unit Repair prices are available from the city at 268-4418. A surcharge may be applicable. Call 268-4418 for details. Repair costs to be paid prior to release of utility service if utilities are effected.

SANITARY SEWER LINES TO SERVE LATERAL 153, MAIN 4, SANITARY SEWER No. 23 (North of 33rd Street North, West of Jeanette)

Project No. 468-84598

OCA: 744305


&

LATERAL 154, MAIN 4, SANITARY SEWER No. 23 (South of 35th Street North, East of Seneca)

Project No. 468-84613

OCA: 744307

CITY OF WICHITA, KANSAS
Jim Armour, P.E., City Engineer

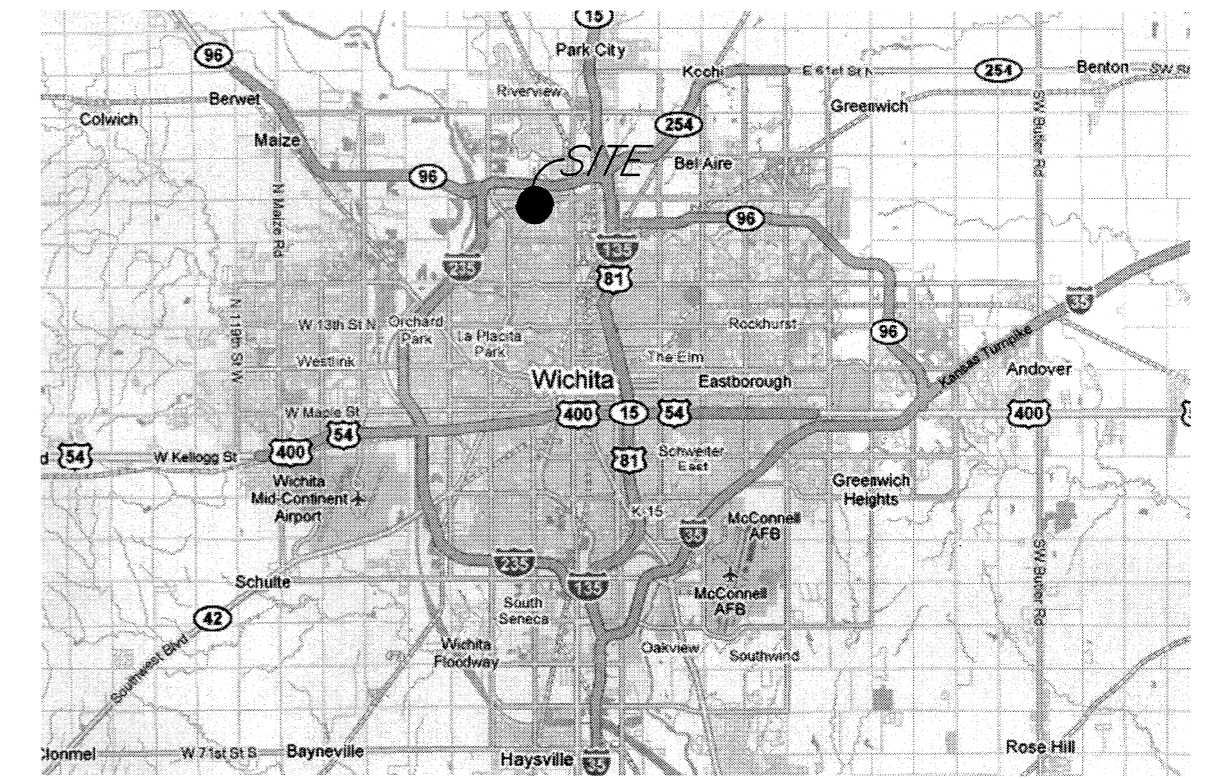

LOCATION MAP
(For Visual Use Only)



INDEX OF SHEETS:

- Cover Sheet
- Control Map
- Plan and Profile (468-84598)
- Plan and Profile (468-84613)
- Various Details
- 9. Erosion Control Details

BENEFIT DISTRICTS:

- Project No. 468-84598
- Project No. 468-84613

WB Carter - Contractor
J. Terhune - City of Wichita, Field Project Engineer
S. Cody - City of Wichita, Inspector
As-built
Release Date: (12/23/2010)
pdf: APRosas 12/27/2010

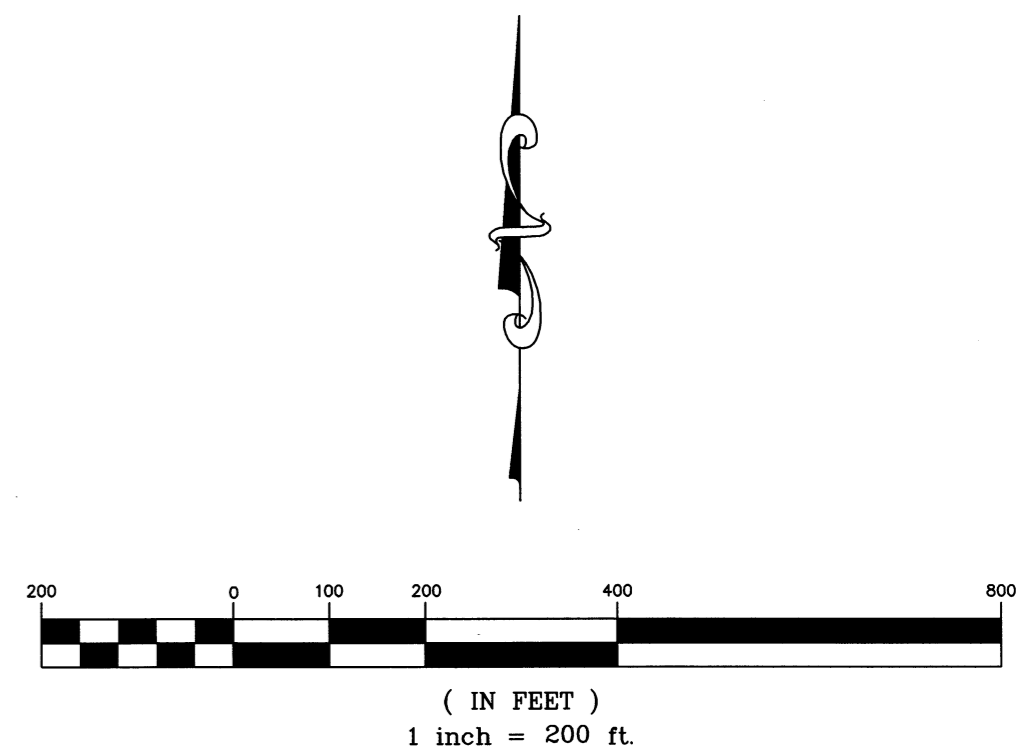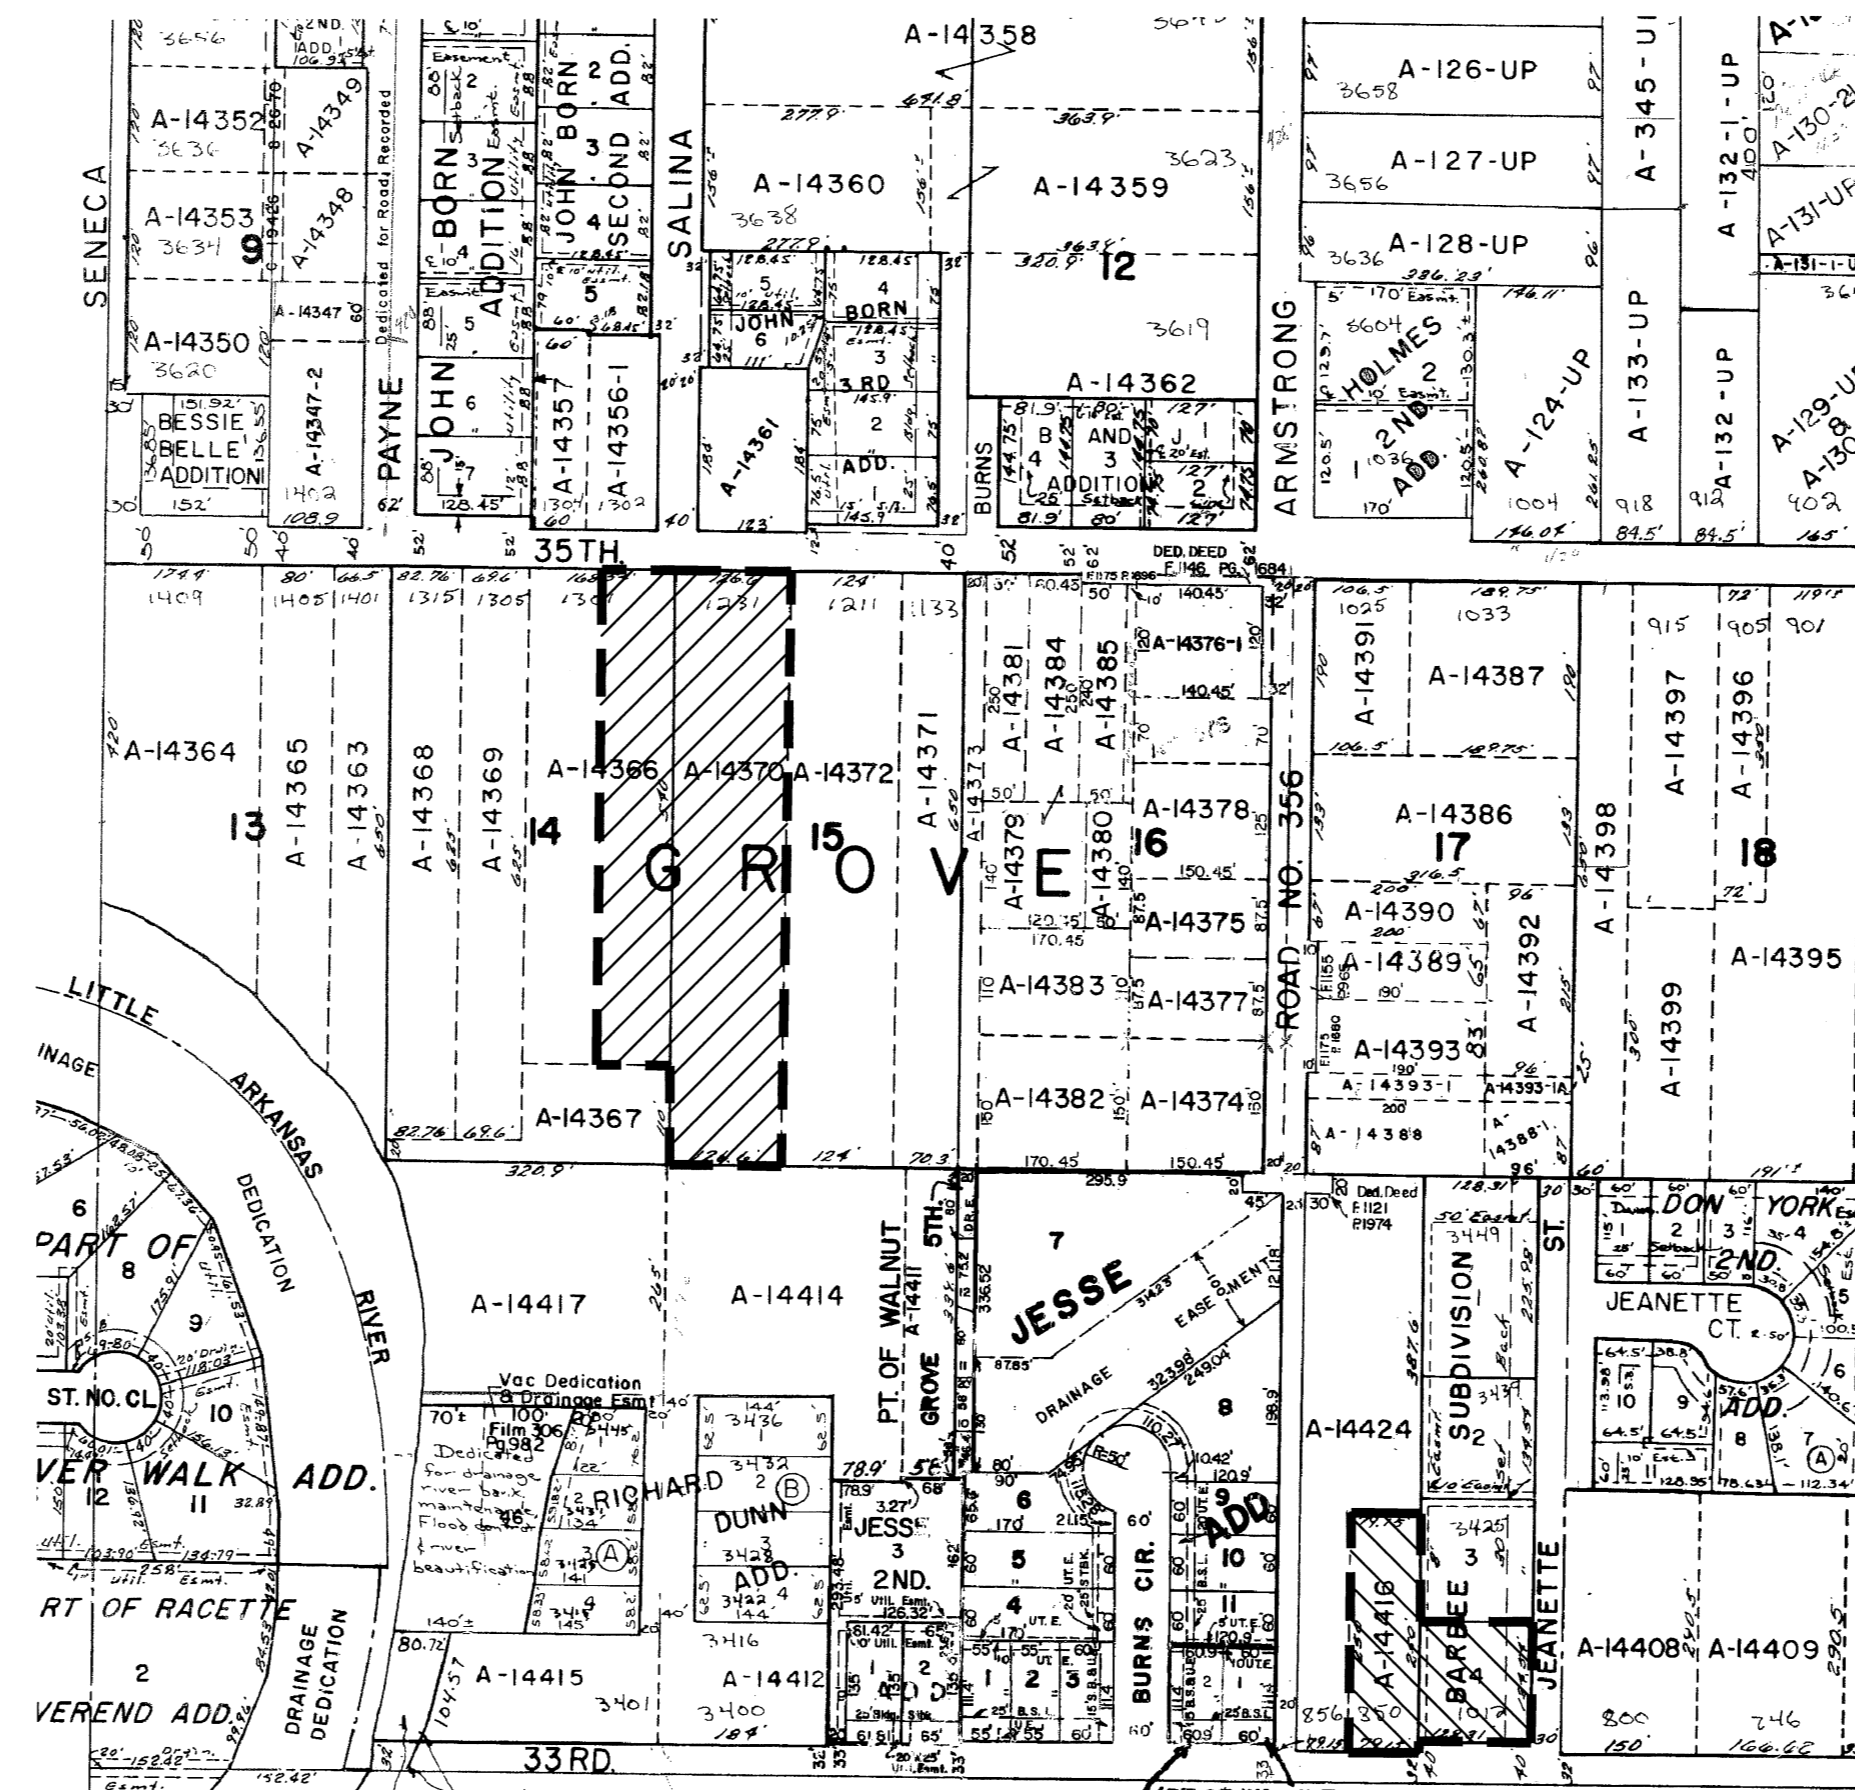

September 2009



516 S. Market,
Wichita, KS 67202

316/264-0242