

PRIVATE STORM WATER SEWER EXTENSION


TO SERVE HAWKER BEECHCRAFT CORPORATION WAREHOUSE B89

PRIVATE PROJECT NO. 1909 PPS (607861)
CITY OF WICHITA, KANSAS
JAMES L. ARMOUR, P.E. - CITY ENGINEER

PROJECT NOT INSPECTED BY A CONSULTANT FIRM NO AS BUILTS
TURNED IN.
APPEARS TO HAVE BEEN INSTALLED AS PLANNED,

INDEX OF SHEETS

SHEET NO. C4.1	TITLE SHEET
SHEET NO. C4.2	KEY MAP AND GENERAL NOTES
SHEET NO. C4.3	SWS LINE NO. 1 PLAN/PROFILE
SHEET NO. C4.4	SWS LINE NO. 1A PLAN/PROFILE
SHEET NO. C4.5	SWS LINE NO. 1A PLAN/PROFILE
SHEET NO. C4.6	AREA INLET AND TRENCH DRAIN DETAILS
SHEET NO. C4.7	TYPE "P" MANHOLE DETAILS
SHEET NO. C4.8	FRAME & COVER DETAILS
SHEET NO. C3.1	SWPPP
SHEET NO. C3.2-C3.4	SOIL EROSION BMP DETAILS

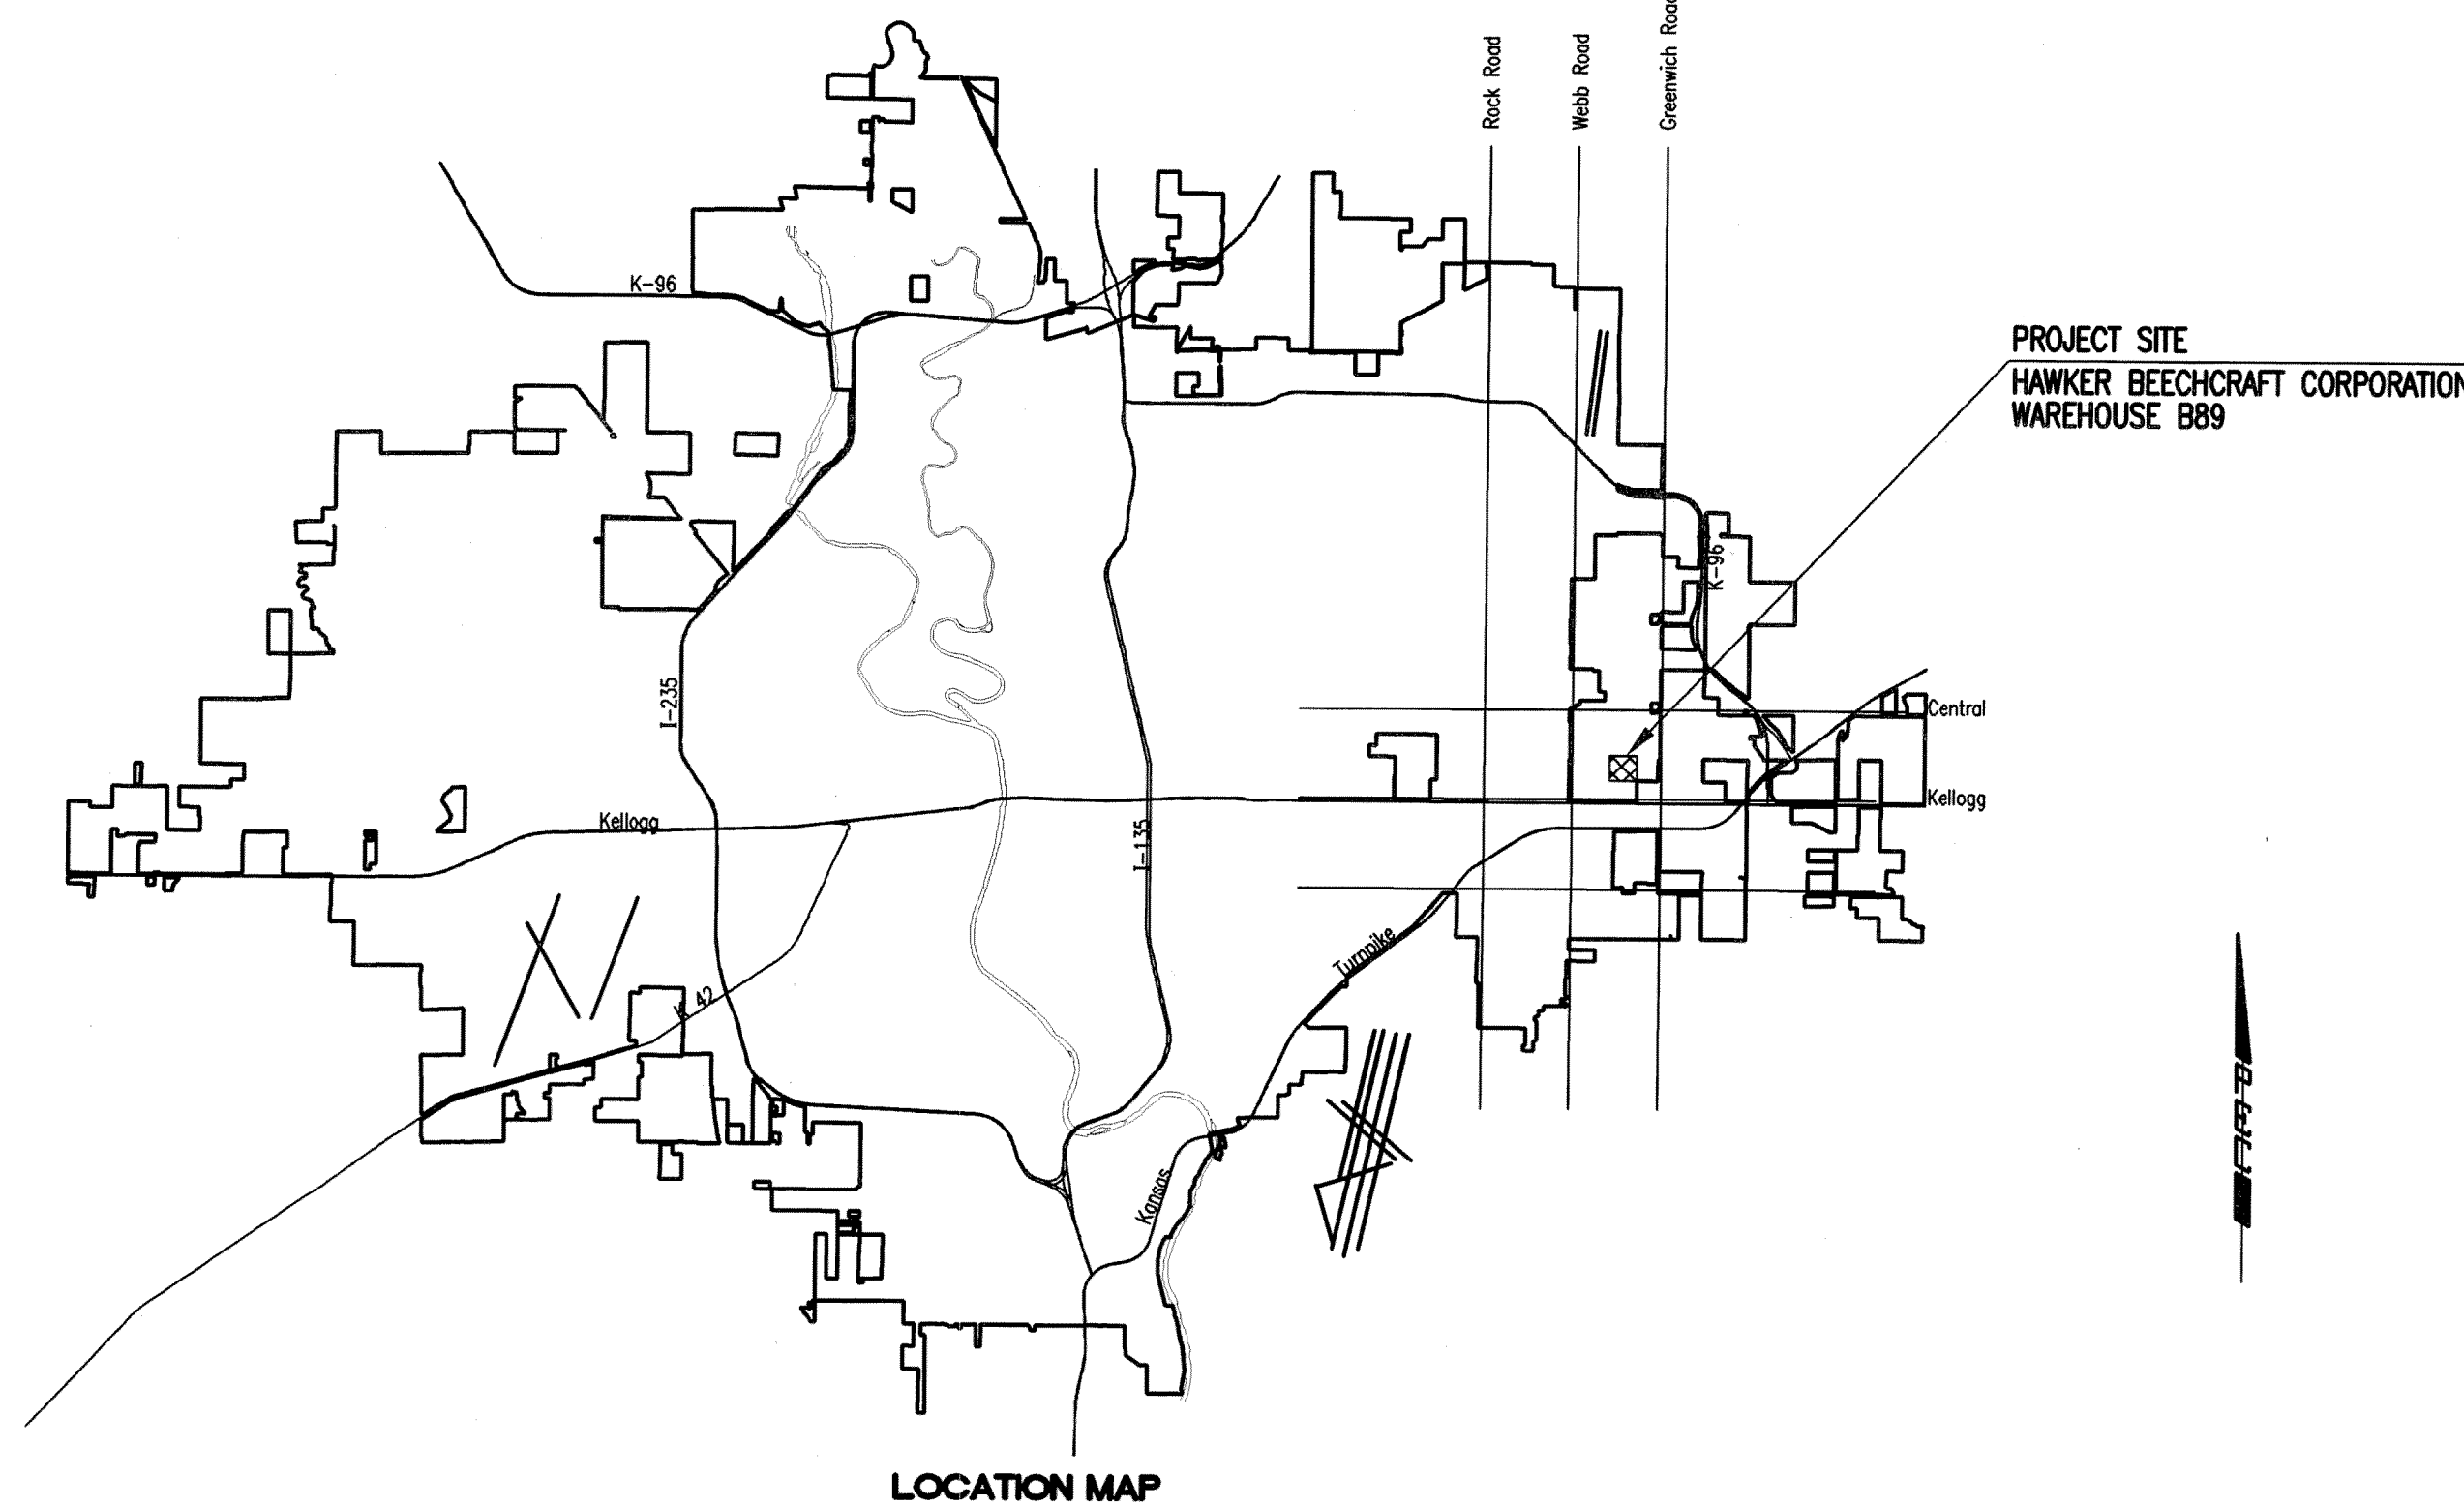

APPROVED AS NOTED
By CITY ENGINEER OF WICHITA

Sanitary Sewers _____

Storm Sewers Julianne Krollman 8-15-08

Driveway Approaches _____

Paving _____

NOTE TO CONTRACTOR

INSPECTION AND TESTING FOR THIS PROJECT IS TO BE PROVIDED BY A LICENSED CONSULTING ENGINEERING FIRM CONTRACTED BY THE OWNER/DEVELOPER. SAID INSPECTION TO BE IN ACCORDANCE WITH THE CITY OF WICHITA STANDARD CONSTRUCTION ENGINEERING PRACTICES AND CERTIFIED BY A LICENSED PROFESSIONAL ENGINEER. NO WORK SHALL BE PERFORMED IN DEDICATED EASEMENTS OR PUBLIC RIGHT-OF-WAY BY THE CONTRACTOR UNTIL SUCH INSPECTION IS ARRANGED FOR AND REQUIRED BONDS HAVE BEEN SUBMITTED TO AND APPROVED BY THE CITY. NOR SHALL ANY WORK BE COMMENCED IN DEDICATED EASEMENTS OR PUBLIC RIGHT-OF-WAY WITHOUT WRITTEN AUTHORIZATION BY THE CITY ENGINEER. IMPROVEMENTS PERFORMED UNDER THIS PROJECT SHALL NOT BE ACCEPTED BY THE CITY UNTIL ALL APPLICABLE DOCUMENTATION HAS BEEN SUBMITTED TO THE CITY ENGINEER. THIS MAY INCLUDE: RECORD DRAWINGS, INSPECTION LOGS, TEST DOCUMENTATION, TV TAPES, AND A CERTIFICATE OF COMPLETION. THE ABOVE SHALL BE PERFORMED BY THE CONSULTING FIRM CONTRACTED TO INSPECT THIS PROJECT.

AUGUST 2008

PLANS PREPARED BY
PROFESSIONAL ENGINEERING CONSULTANTS, P.A.
ENGINEERS
WICHITA, KANSAS

