


**PRIVATE WATER PLANS  
MENARDS - WEST WICHITA, KS  
STONEBRIDGE COMMERCIAL ADDITION**

**WATER LINE  
1, 2 & 4  
PLAN & PROFILE**  
SHEET TITLE  
08626  
PROJECT NUMBER


DESIGN BY: DACR  
DRAWN BY: DACR  
CHECKED BY: MAB

ISSUED: AS BUILT  
12-06-10  
REVISED:


SHEET NO.  
13 of 45

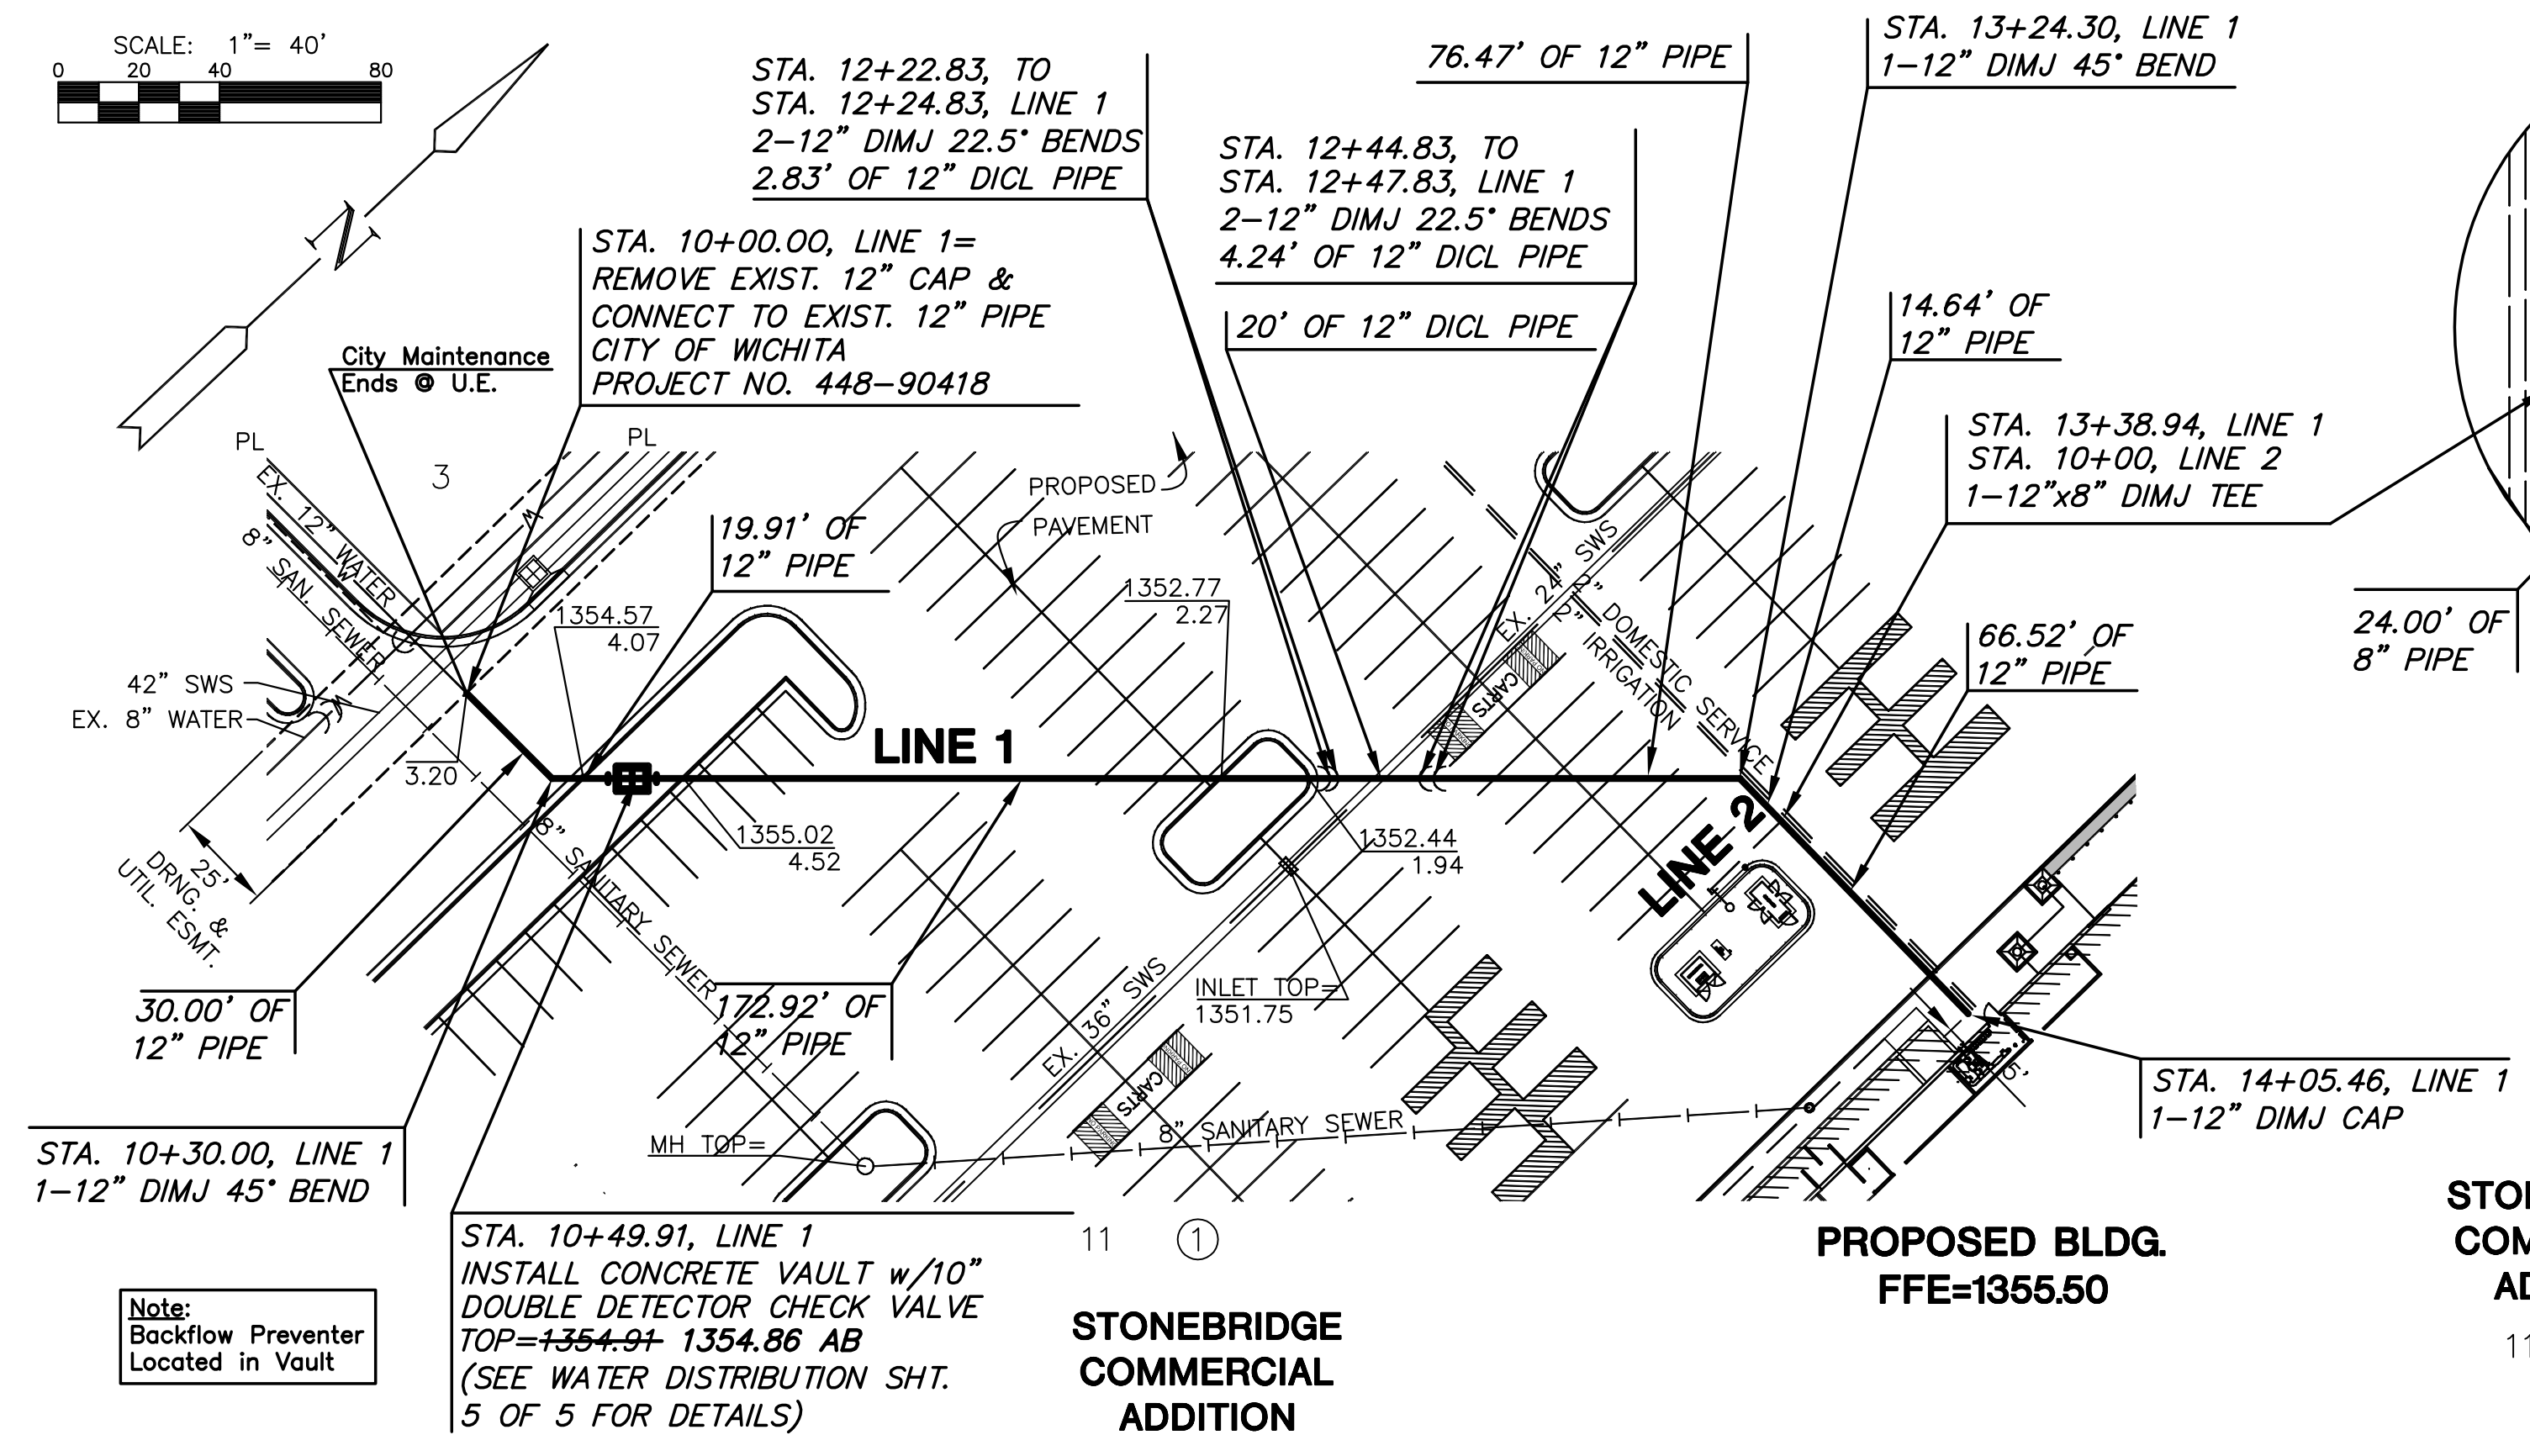


**PLAN LINE 1**

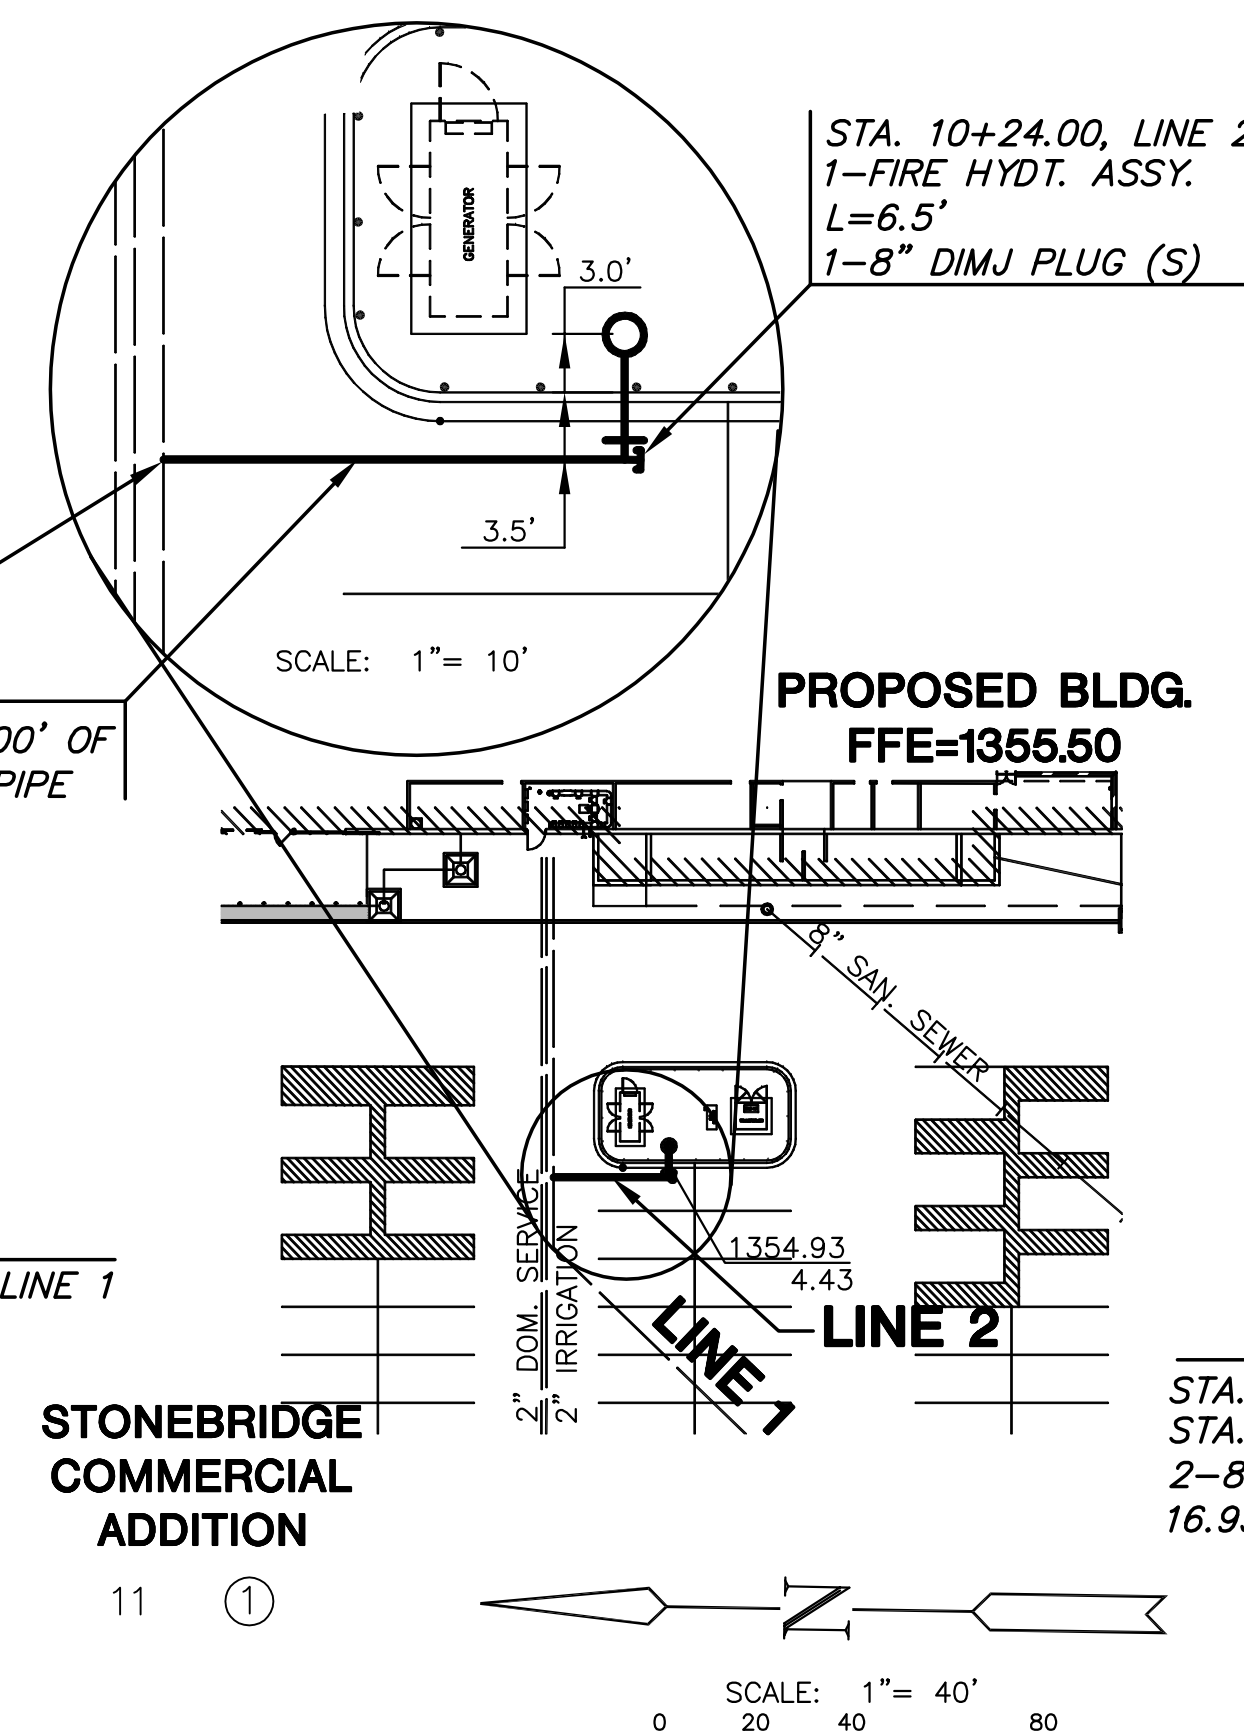


**PLAN LINE 2**

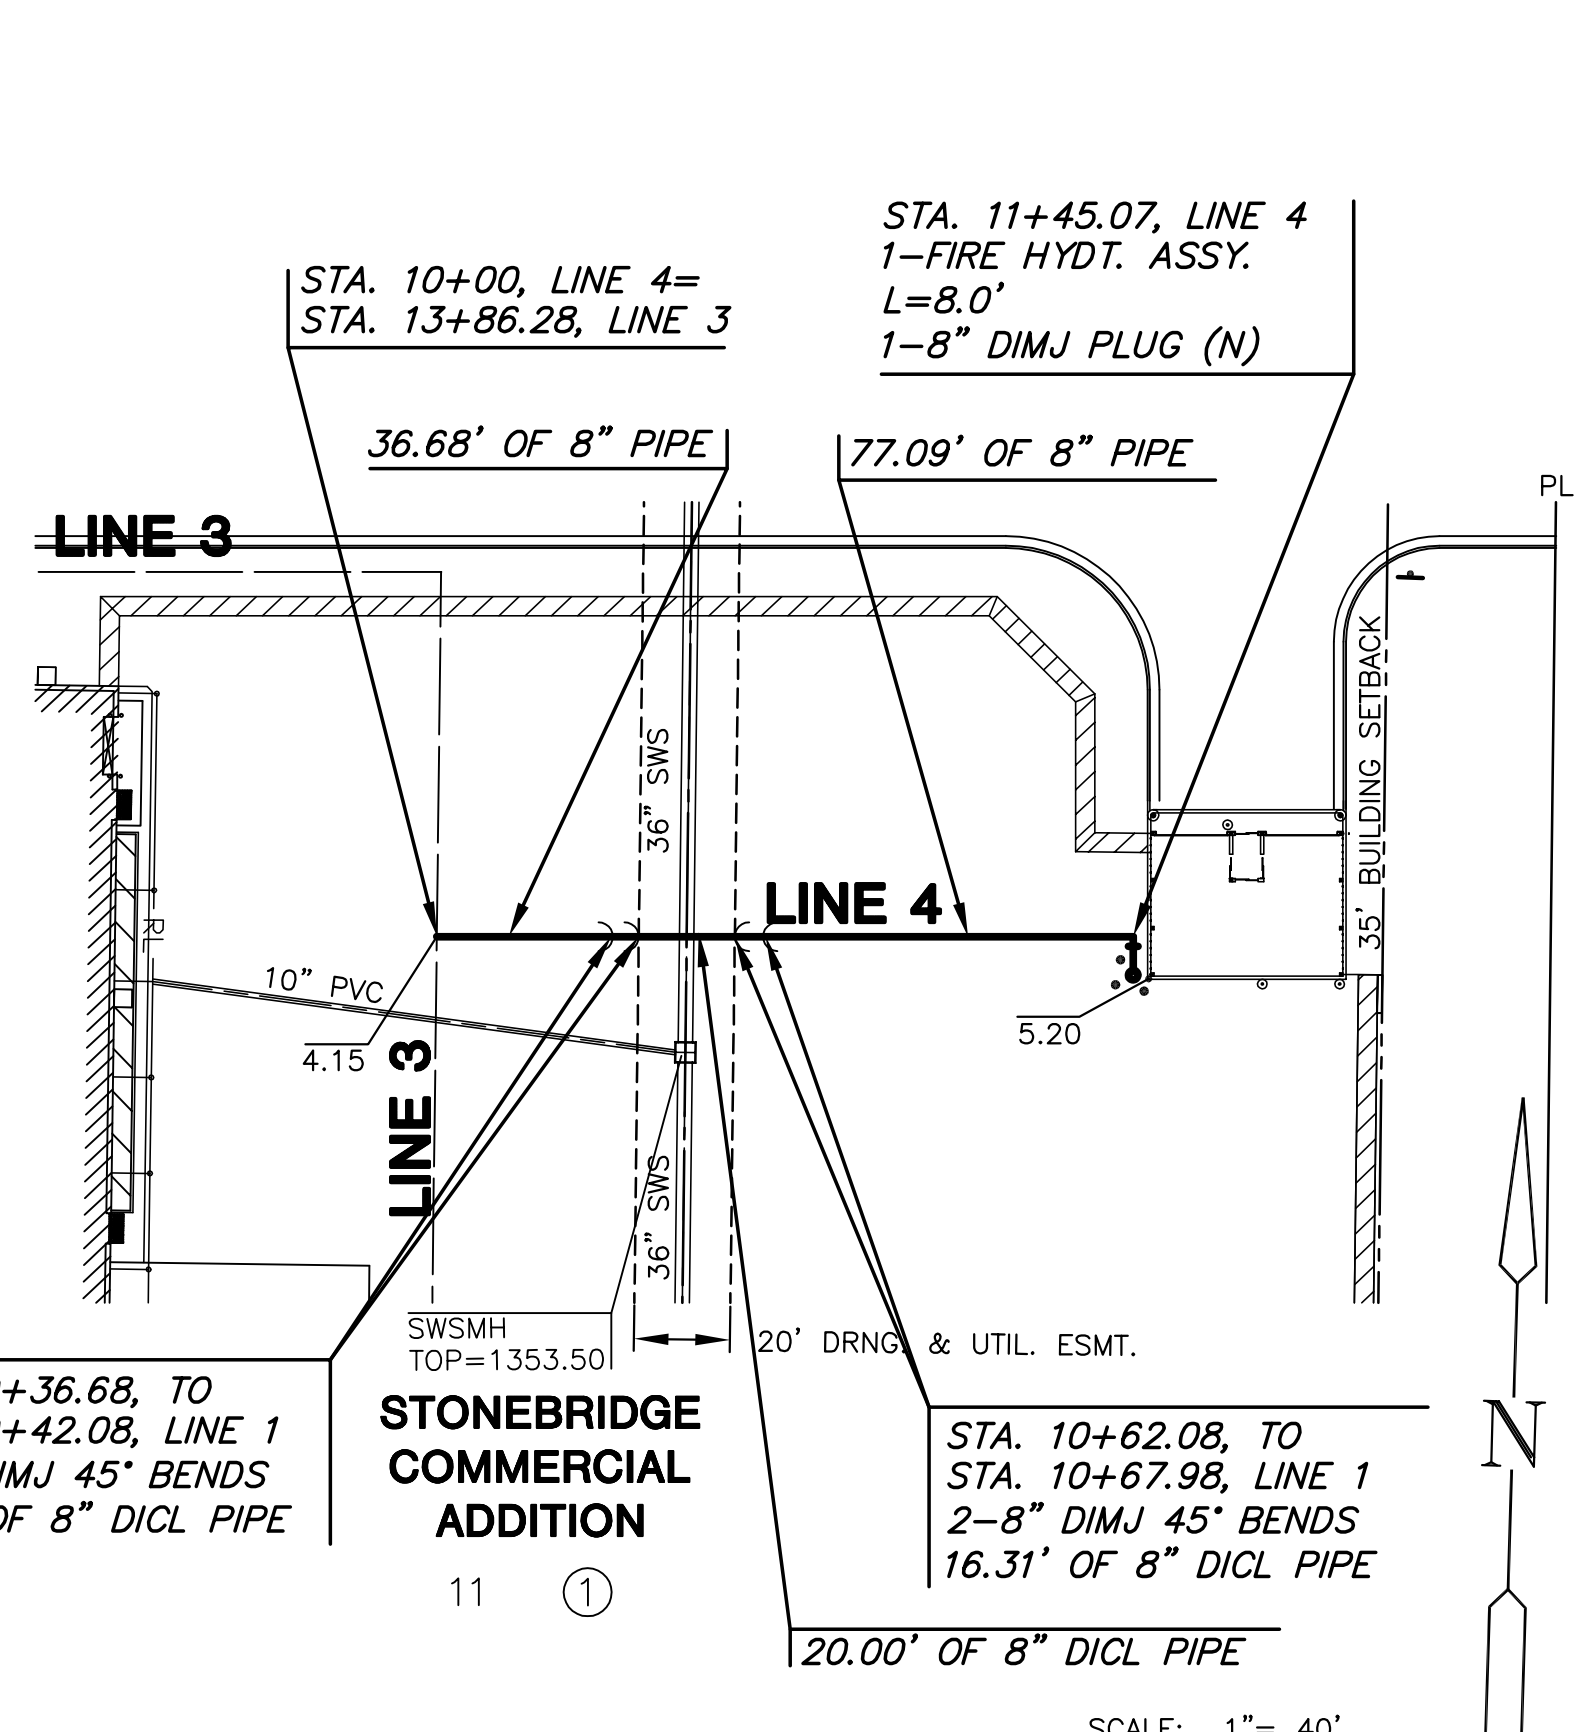


**PLAN LINE 4**

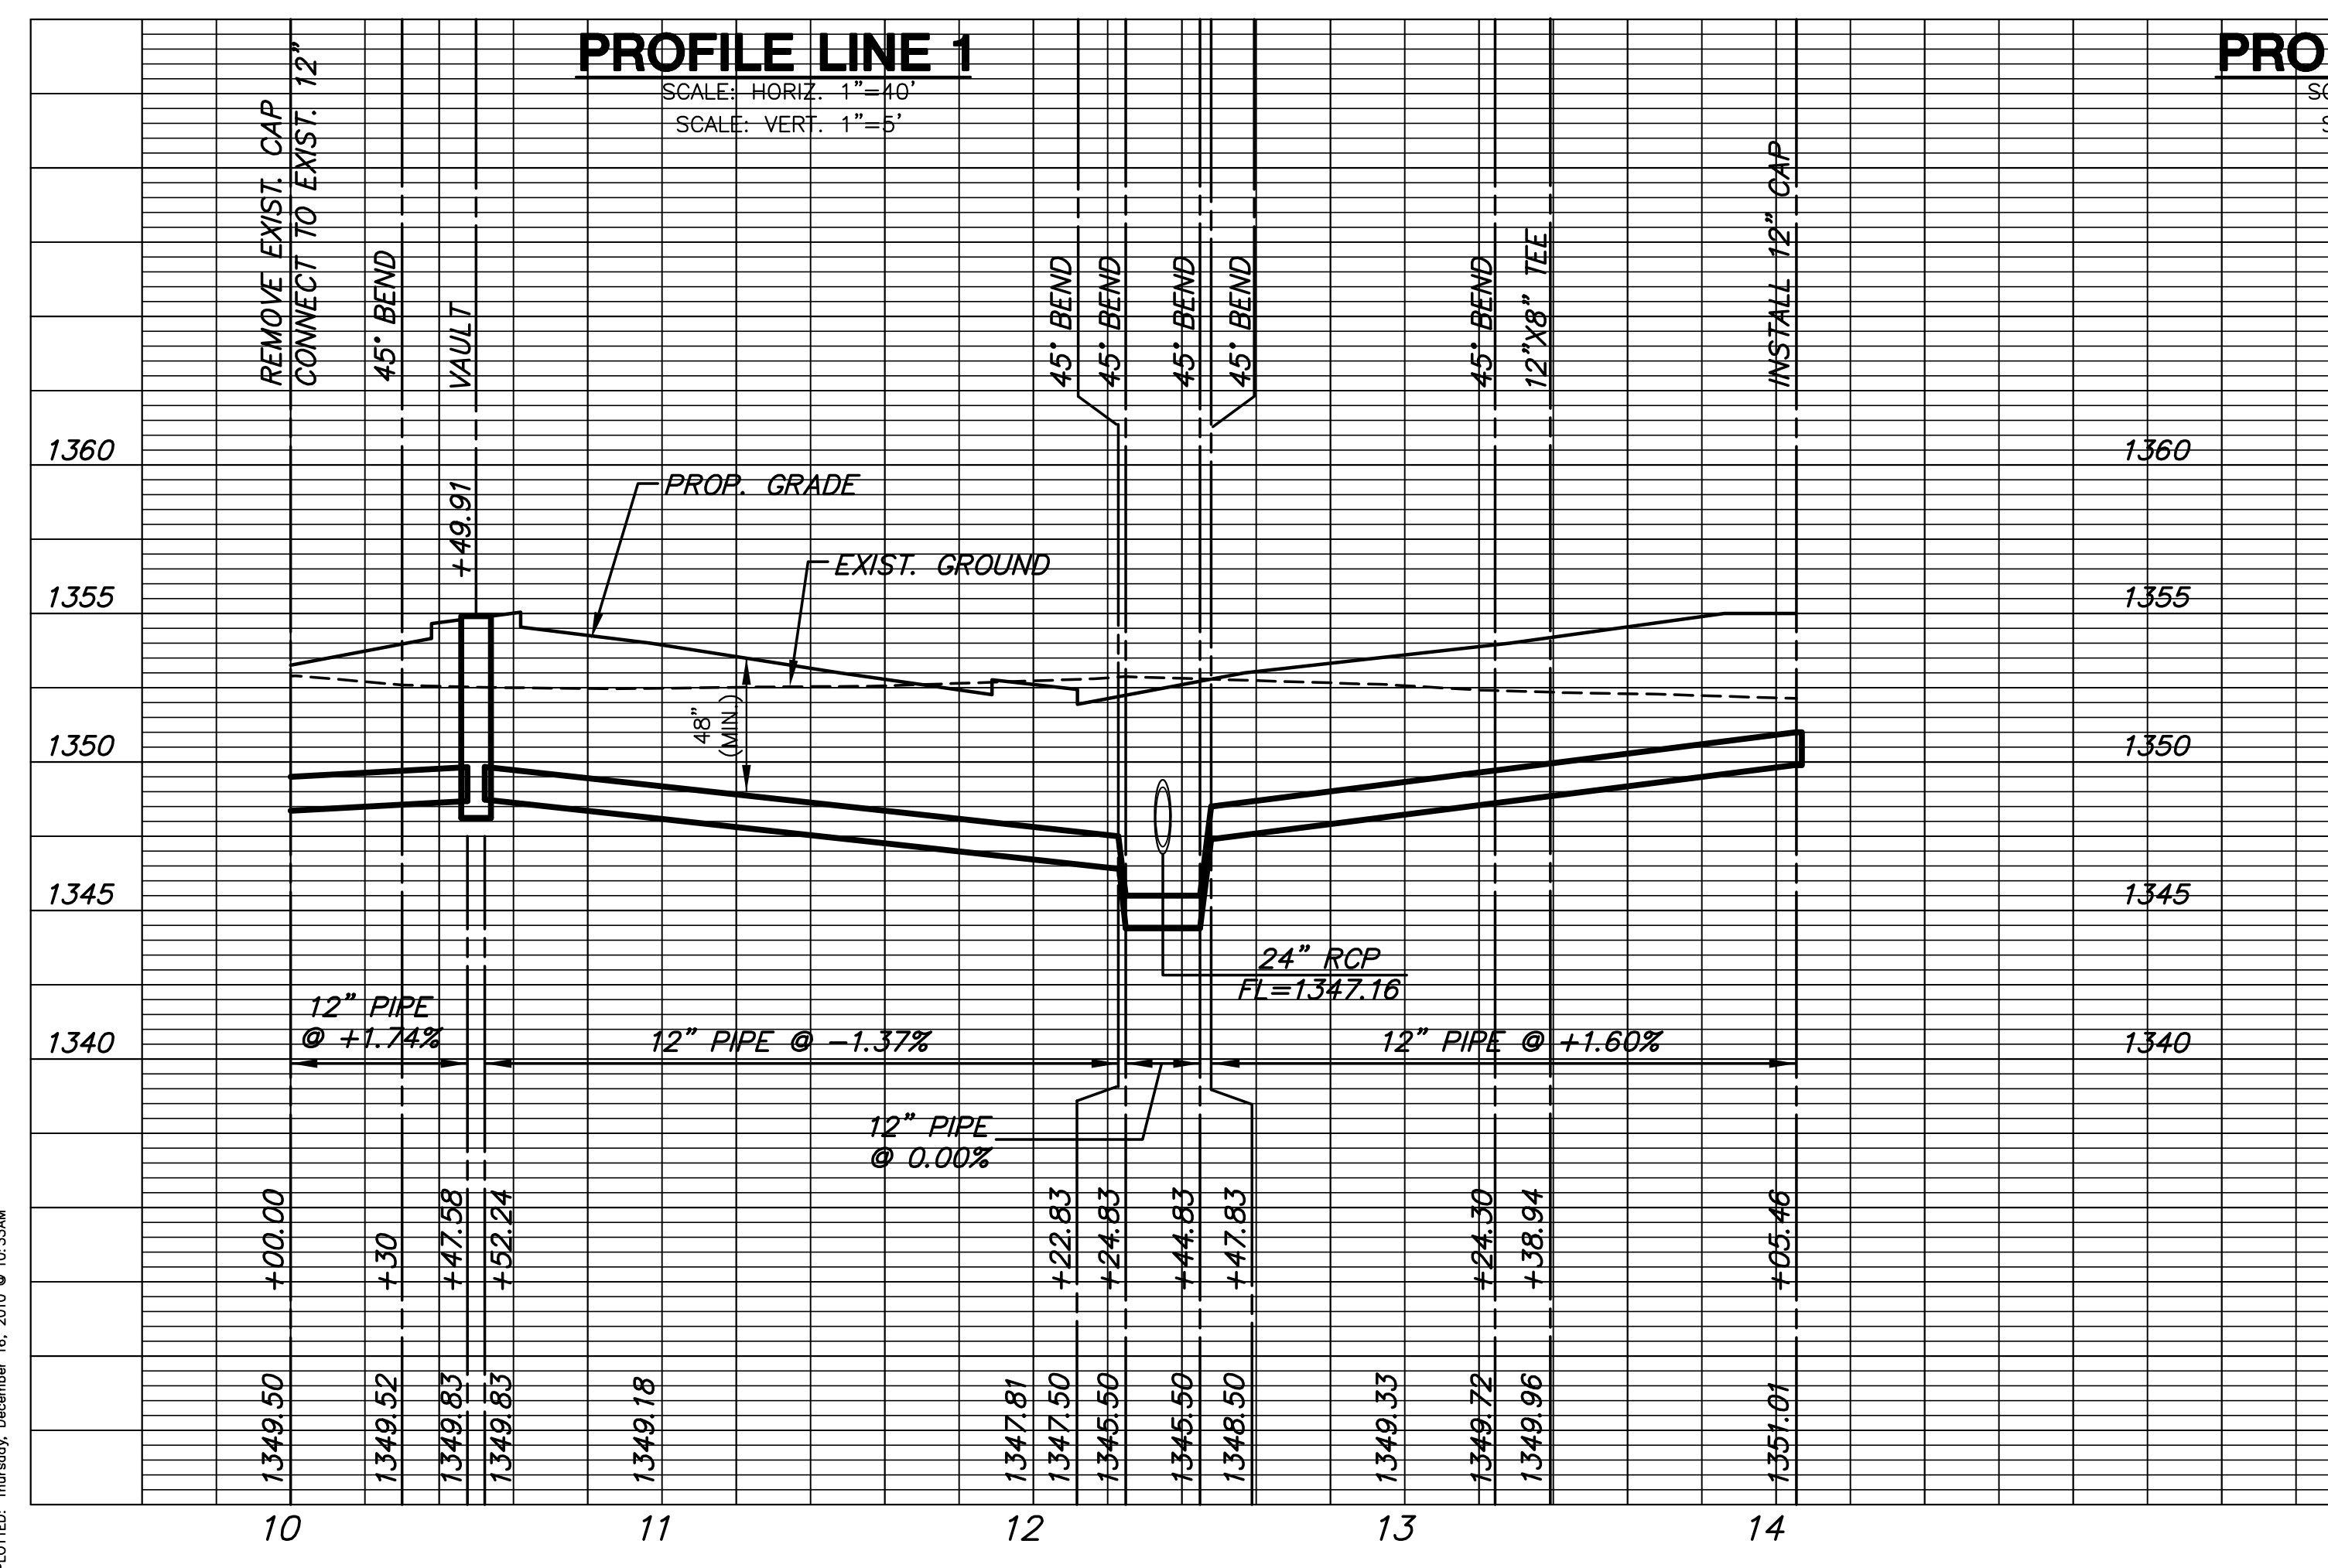

**PROFILE LINE 1**

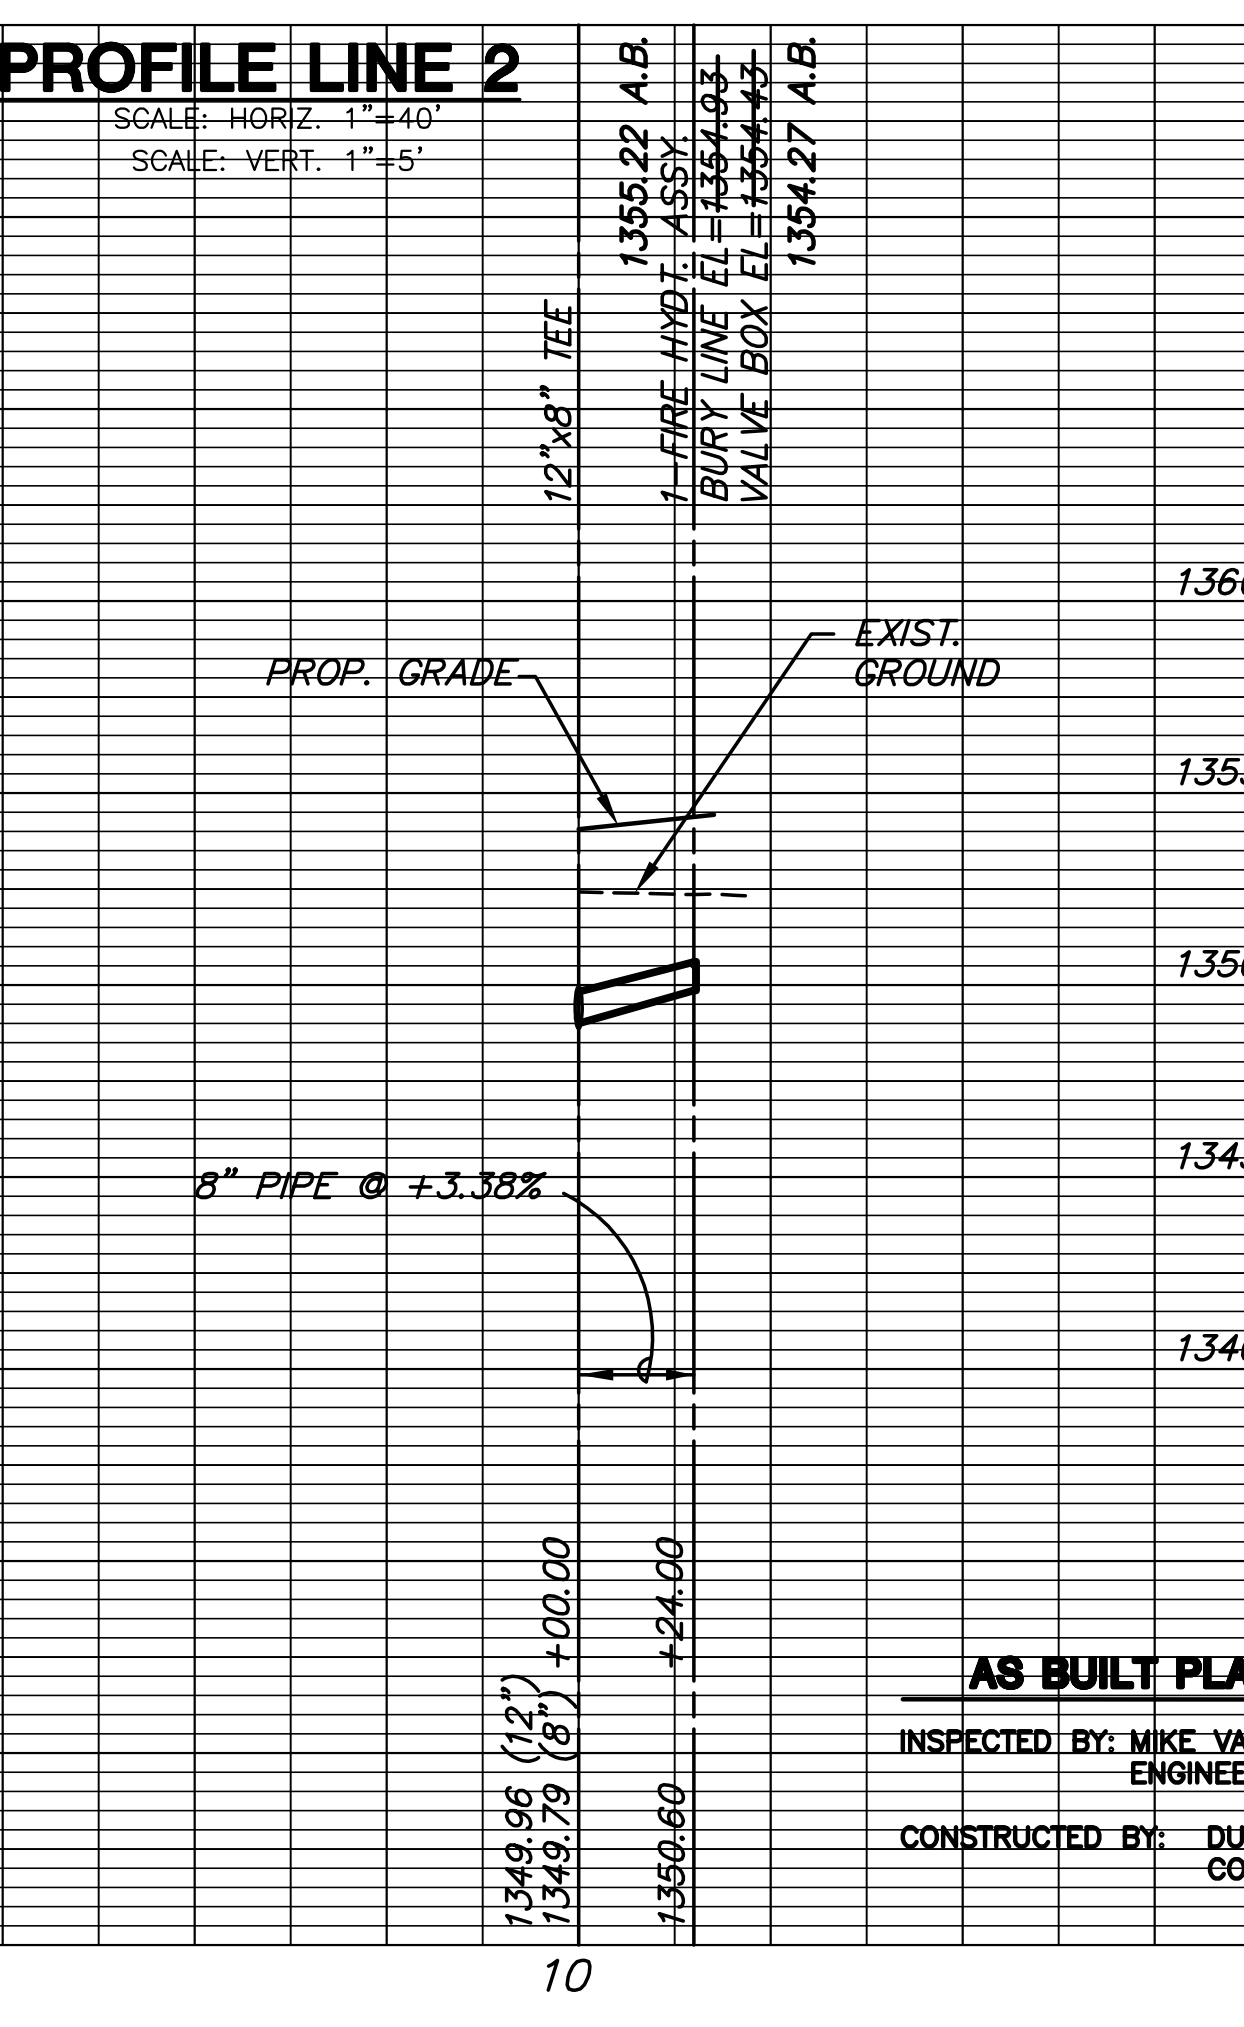

**PROFILE LINE 2**

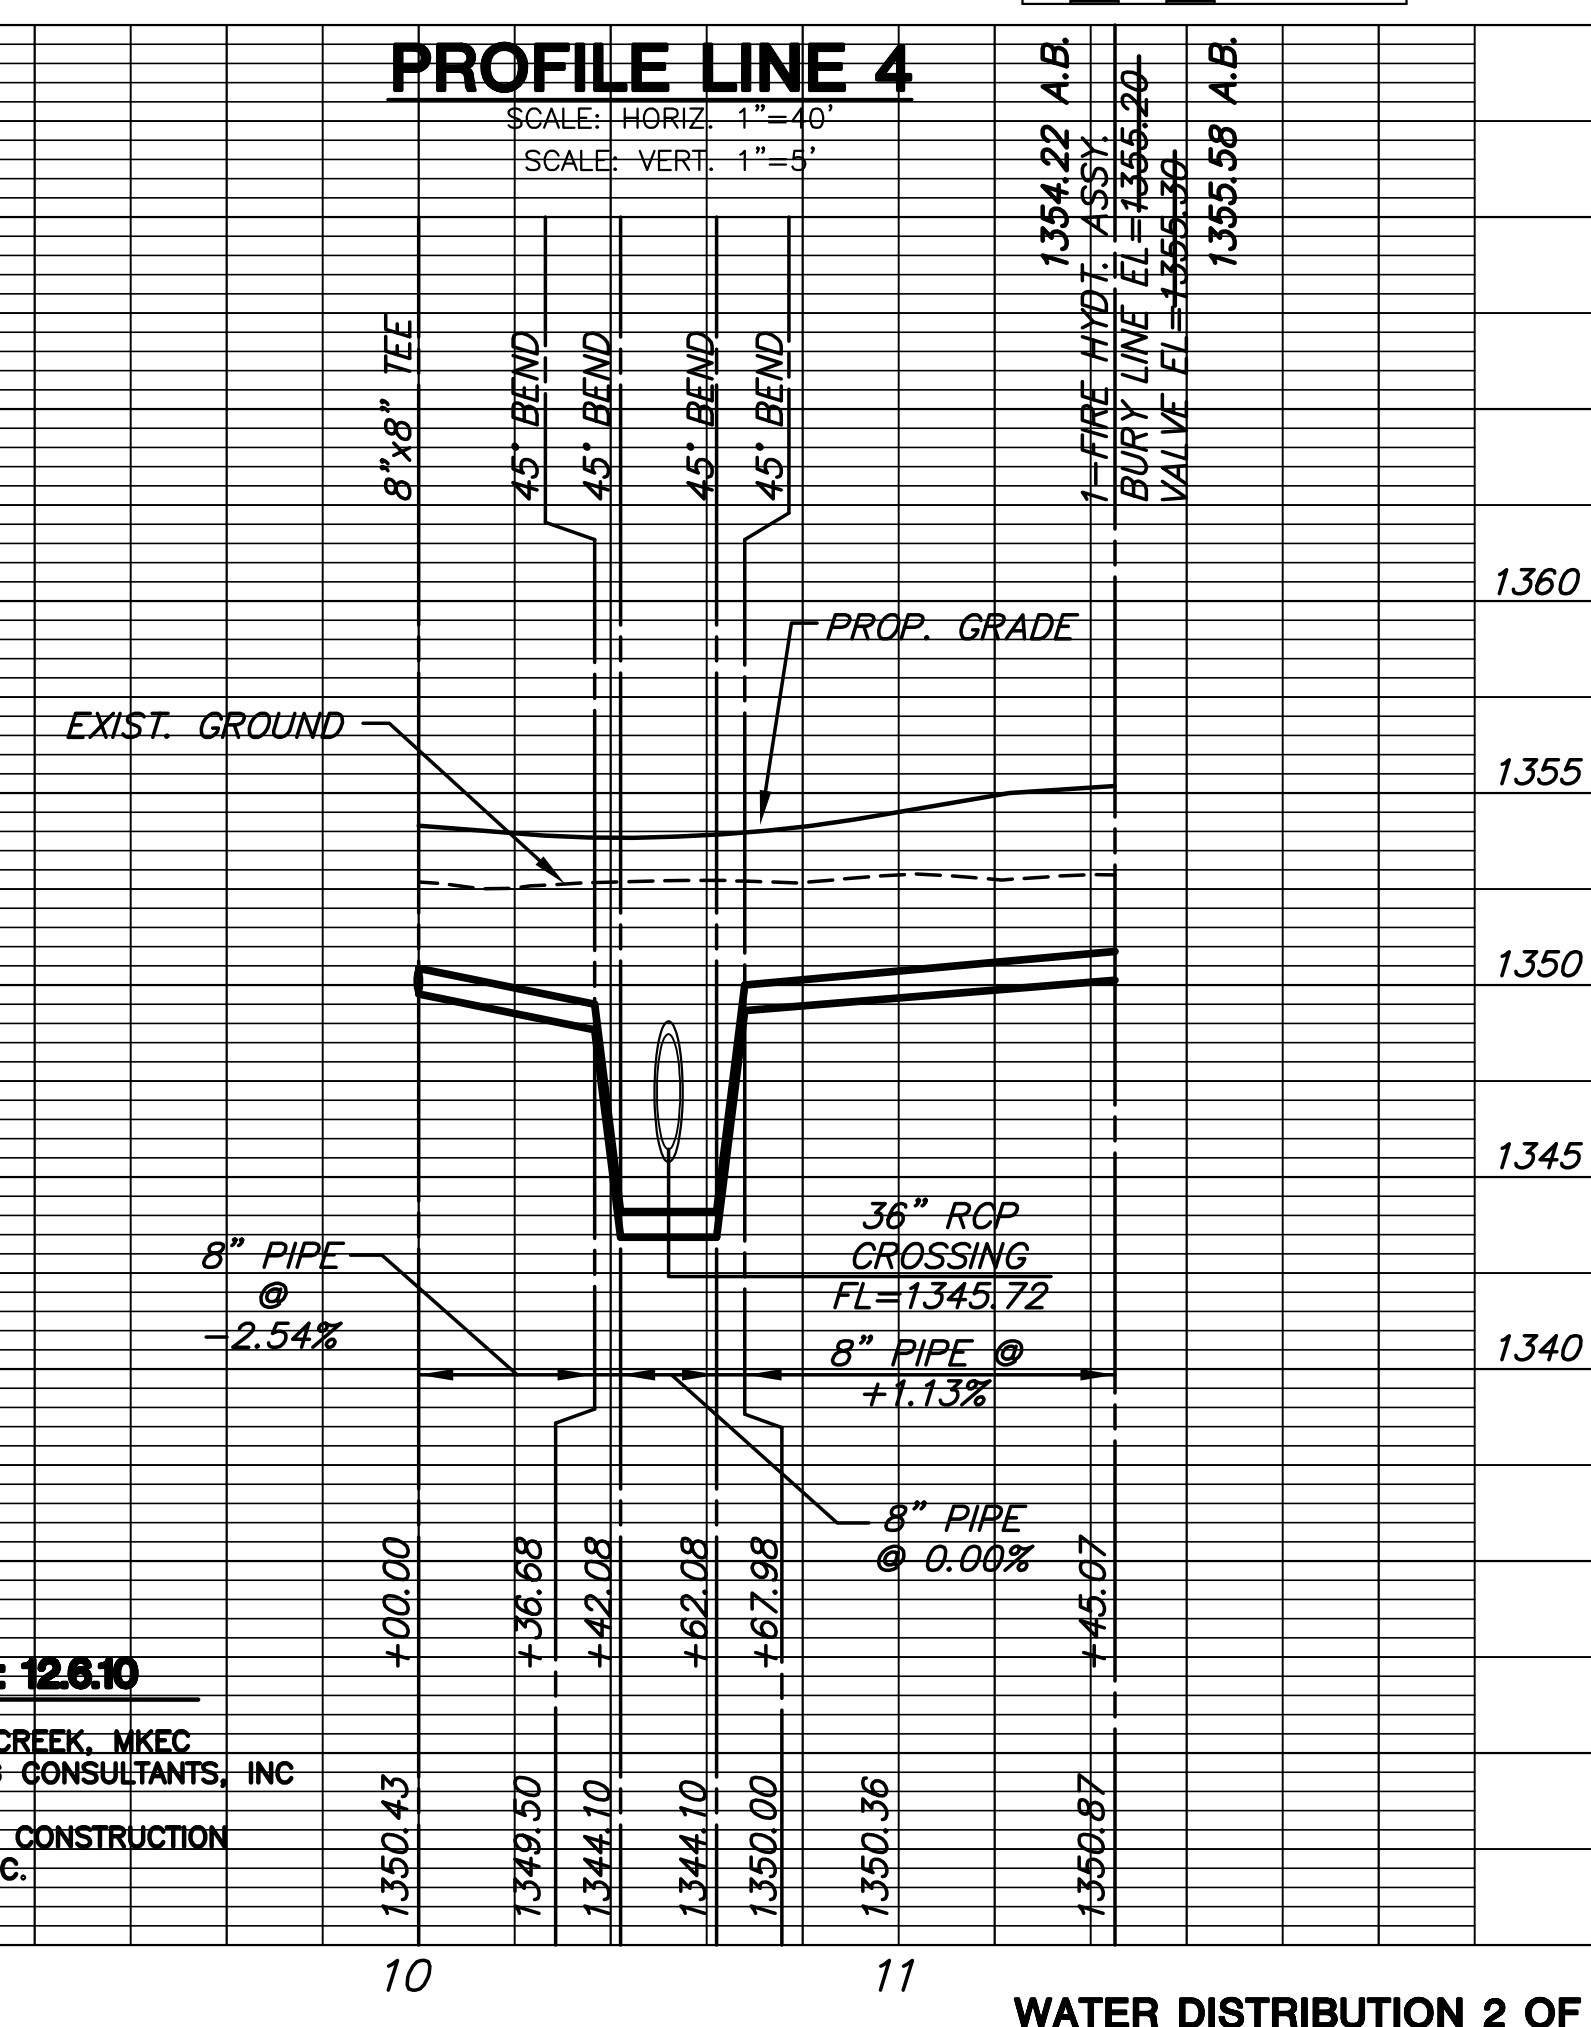

**PROFILE LINE 4**

**AS BUILT PLANS: 12.10**  
INSPECTED BY: MIKE VANDECREEK, MKEC  
ENGINEERING CONSULTANTS, INC.  
CONSTRUCTED BY: DULING CONSTRUCTION  
CO., INC.