

**CIVIL SITE PLANS**  
**MENARDS - WEST WICHITA, KS**  
**STONEBRIDGE COMMERCIAL ADDITION**


**SWS PLAN & PROFILE**

SHEET TITLE  
**08626**  
PROJECT NUMBER


DESIGN BY: **MKEC**  
DRAWN BY: **MKEC**  
CHECKED BY: **MAB**

ISSUED: **AS BUILT**  
**12-06-10**

SHEET NO.  
**19 of 45**

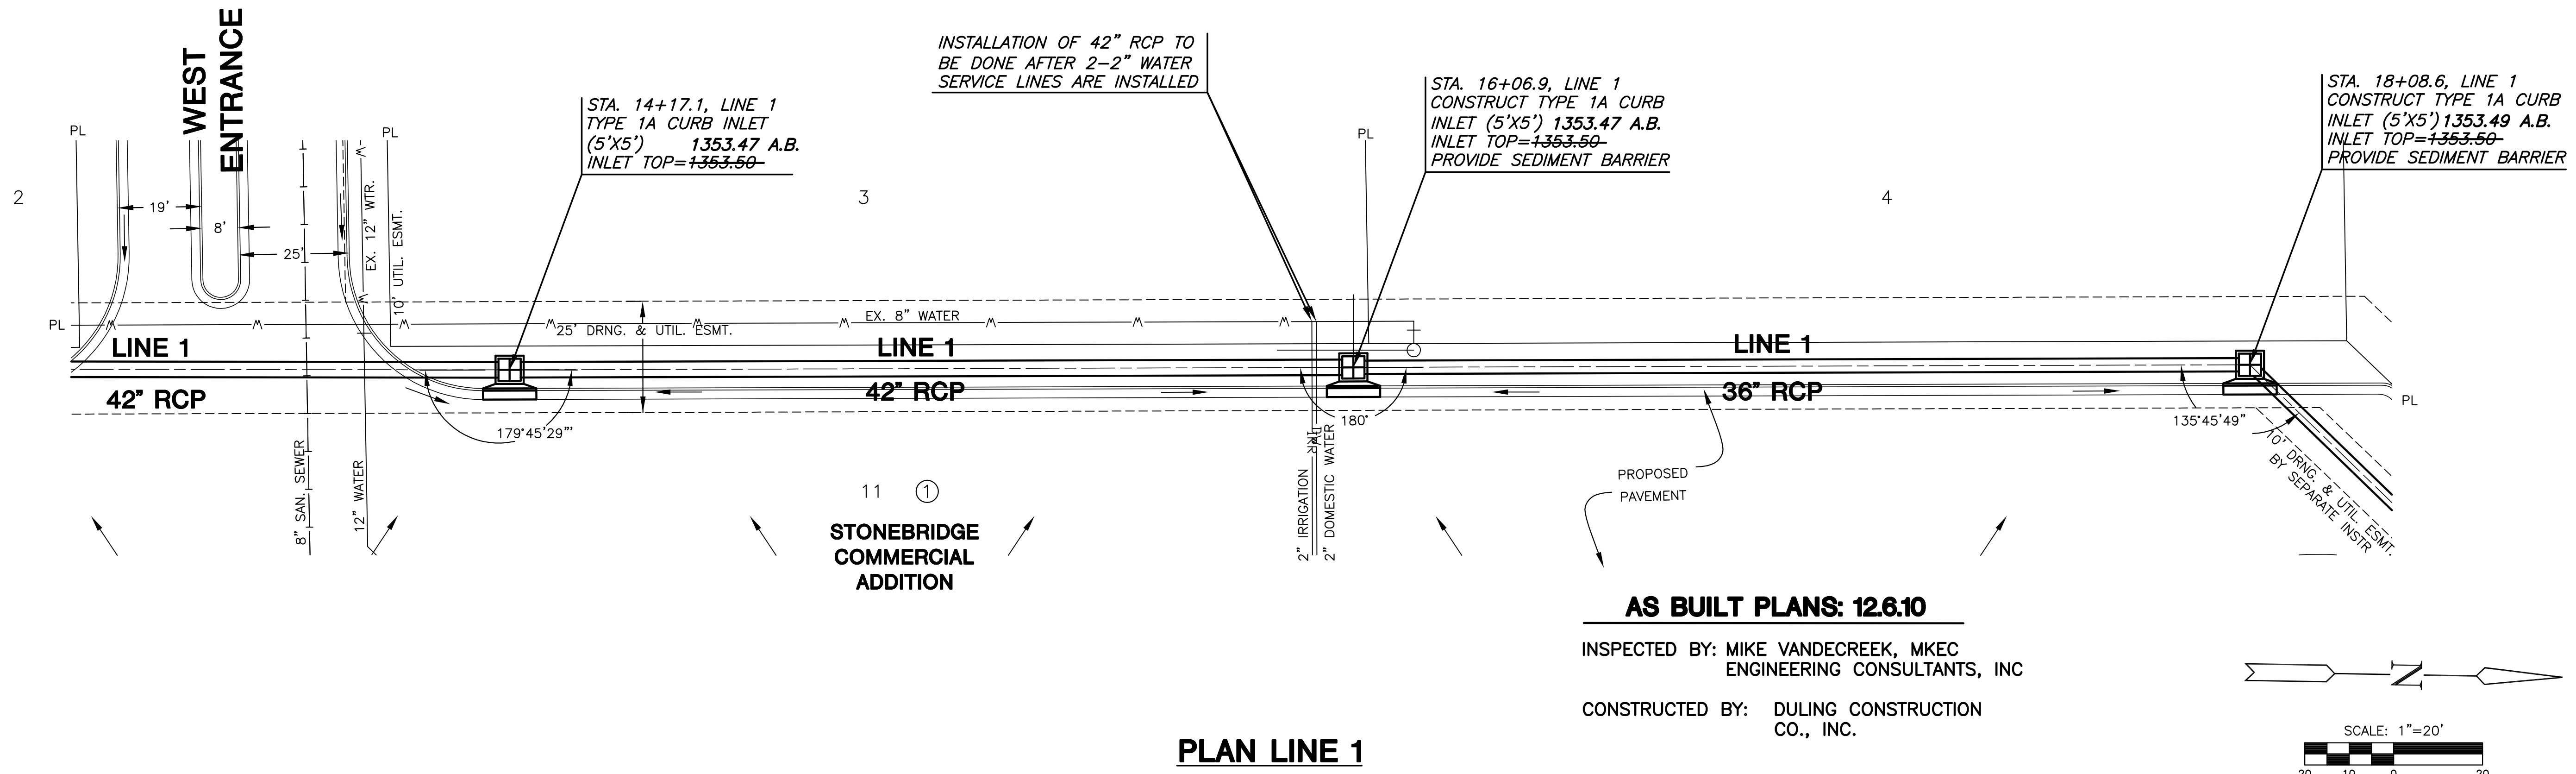

**PLAN LINE 1**

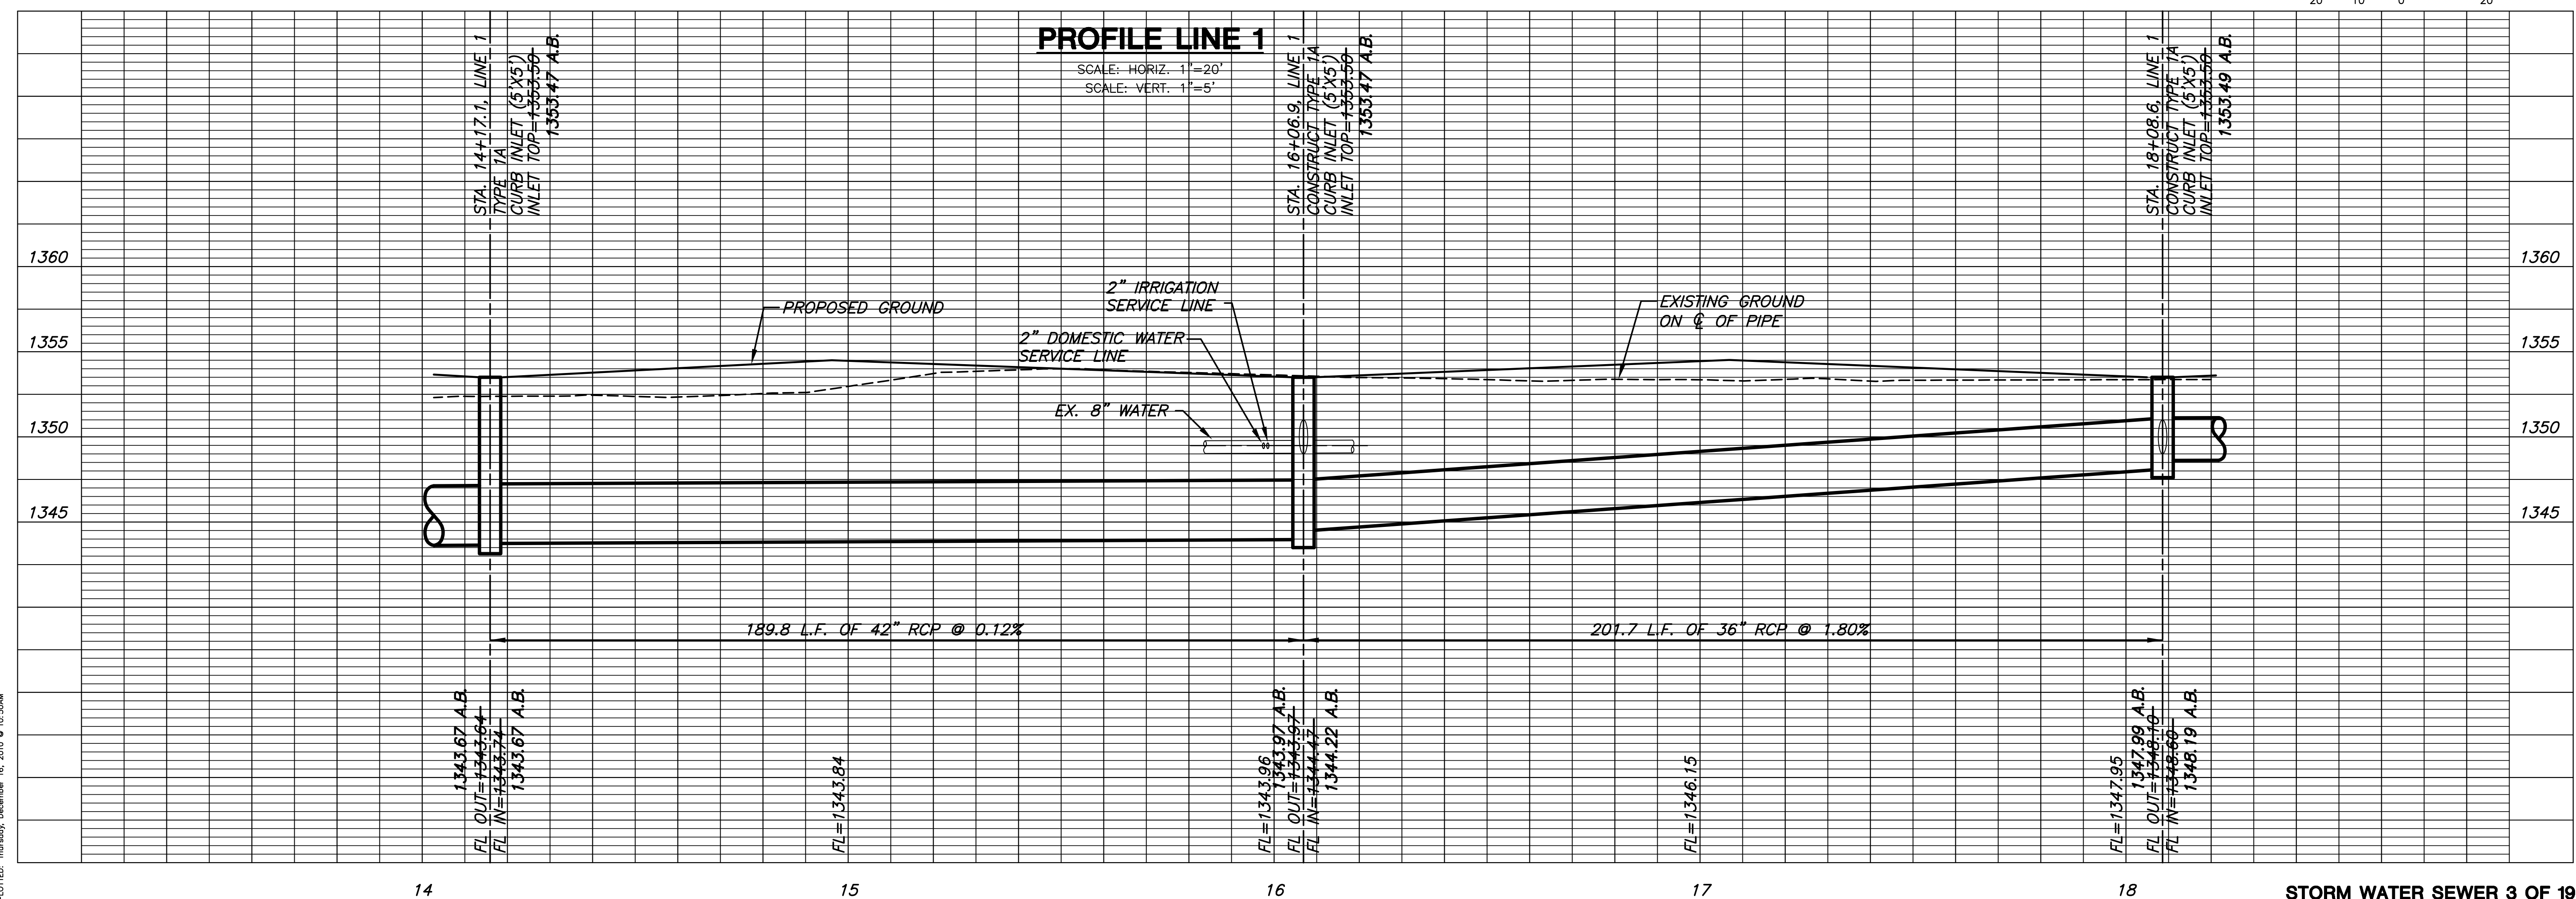

PLOTTED: Thursday, December 16, 2010 @ 10:59AM

U:\CIVIL\05440\08626-MENARDS-WEST WICHITA\AS BUILT\08626.D2.DWG