



**STORM WATER SEWER PLANS TO SERVE
MENARDS - WEST WICHITA, KS
STONEBRIDGE COMMERCIAL ADDITION**

SWS PLAN & PROFILE
SHEET TITLE
PROJECT NUMBER
08626

DESIGN BY: **MB**
DRAWN BY: **JWC**
CHECKED BY: **GJA**

ISSUED: **CONSTRUCTION**
5-04-10
REVISED: **AS BUILT**
12-06-10

SHEET NO.
24 of 45

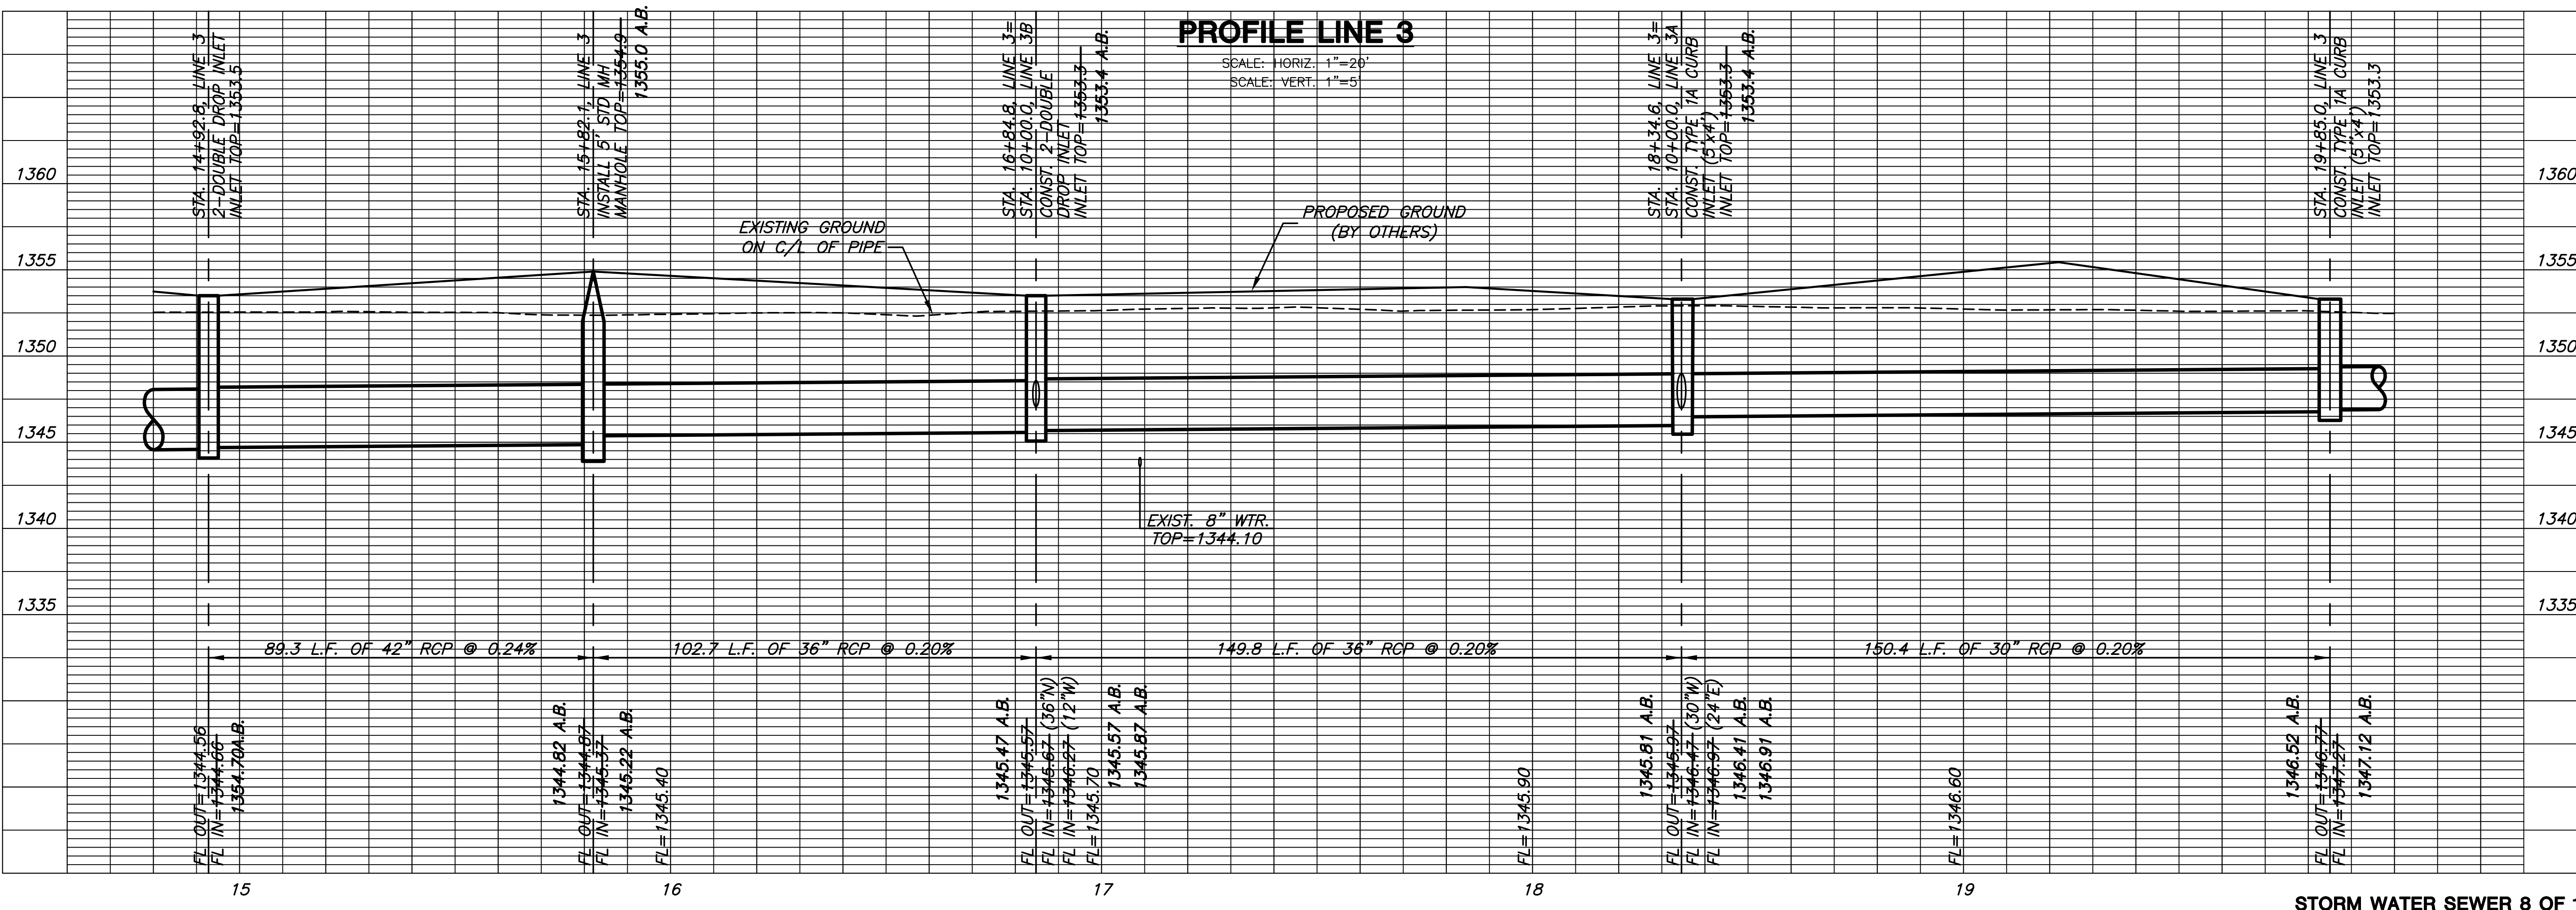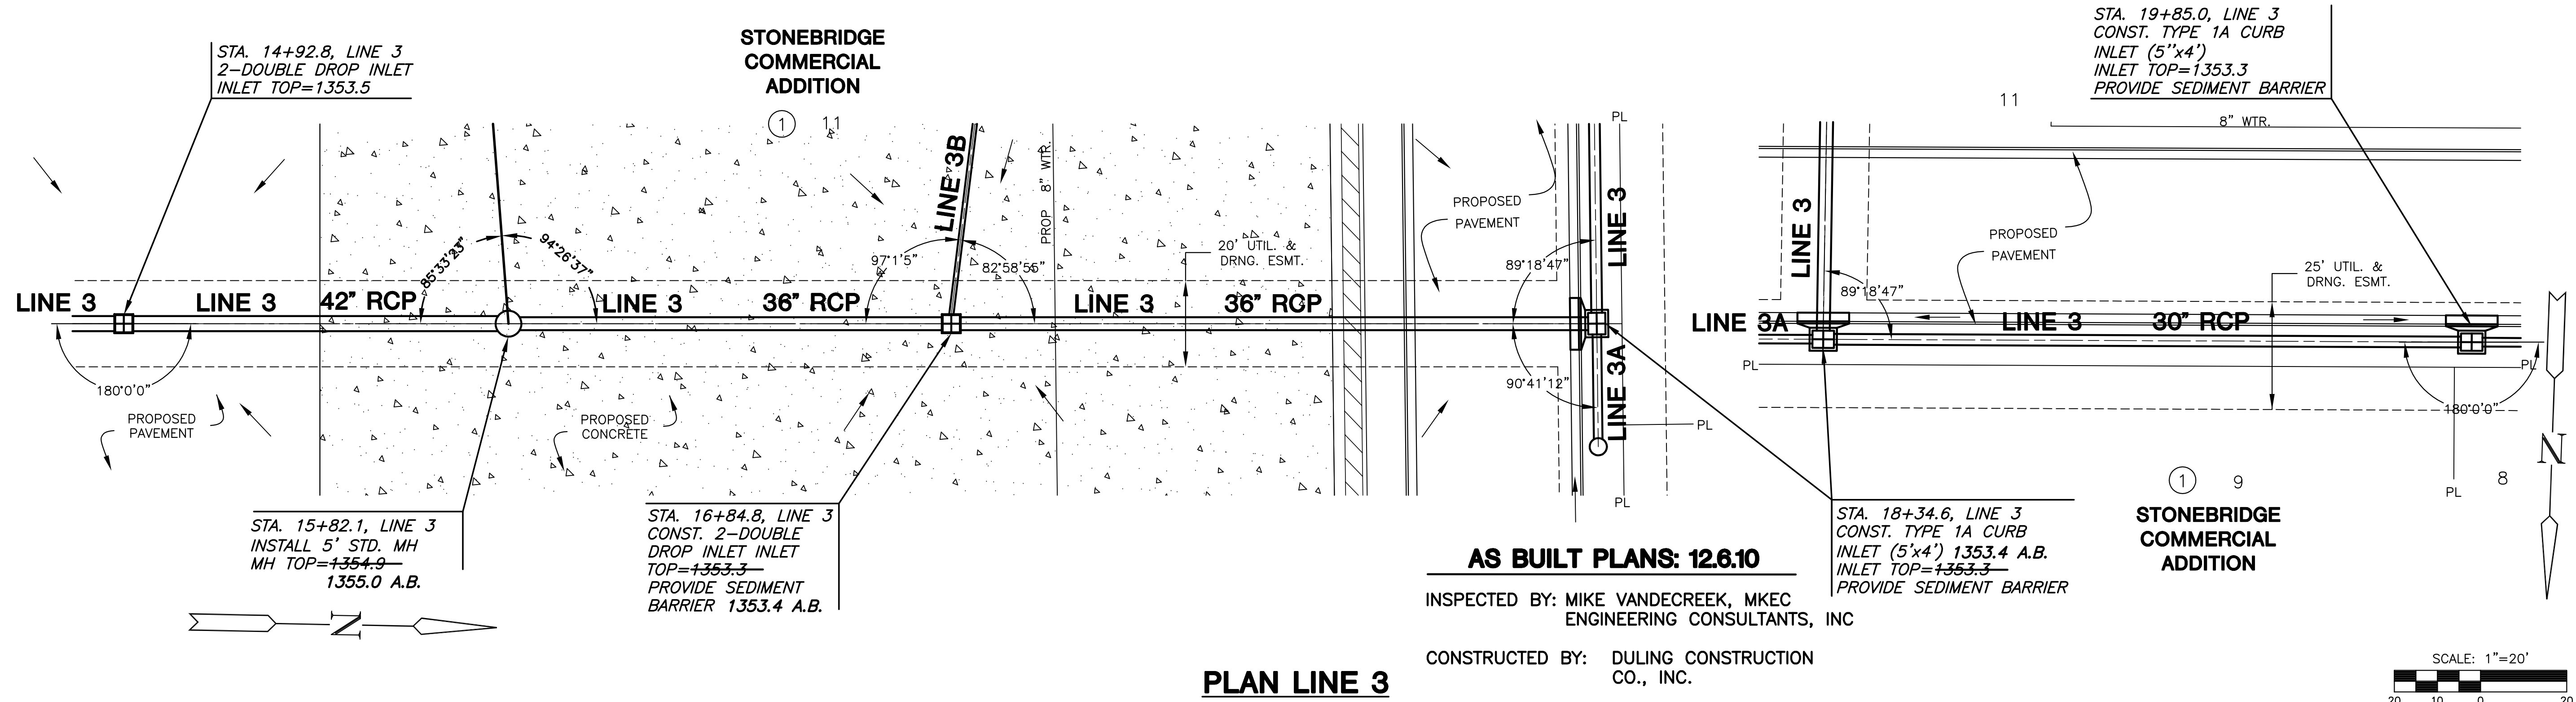

PLOTTED: Thursday, December 16, 2010 @ 11:03AM

J:\CIVIL\05440\08626-MENARDS-WEST WICHITA\AS BUILT\08626.D7.DWG