



SANITARY SEWER LATERAL
SUMMIT CROSSING ADDITION

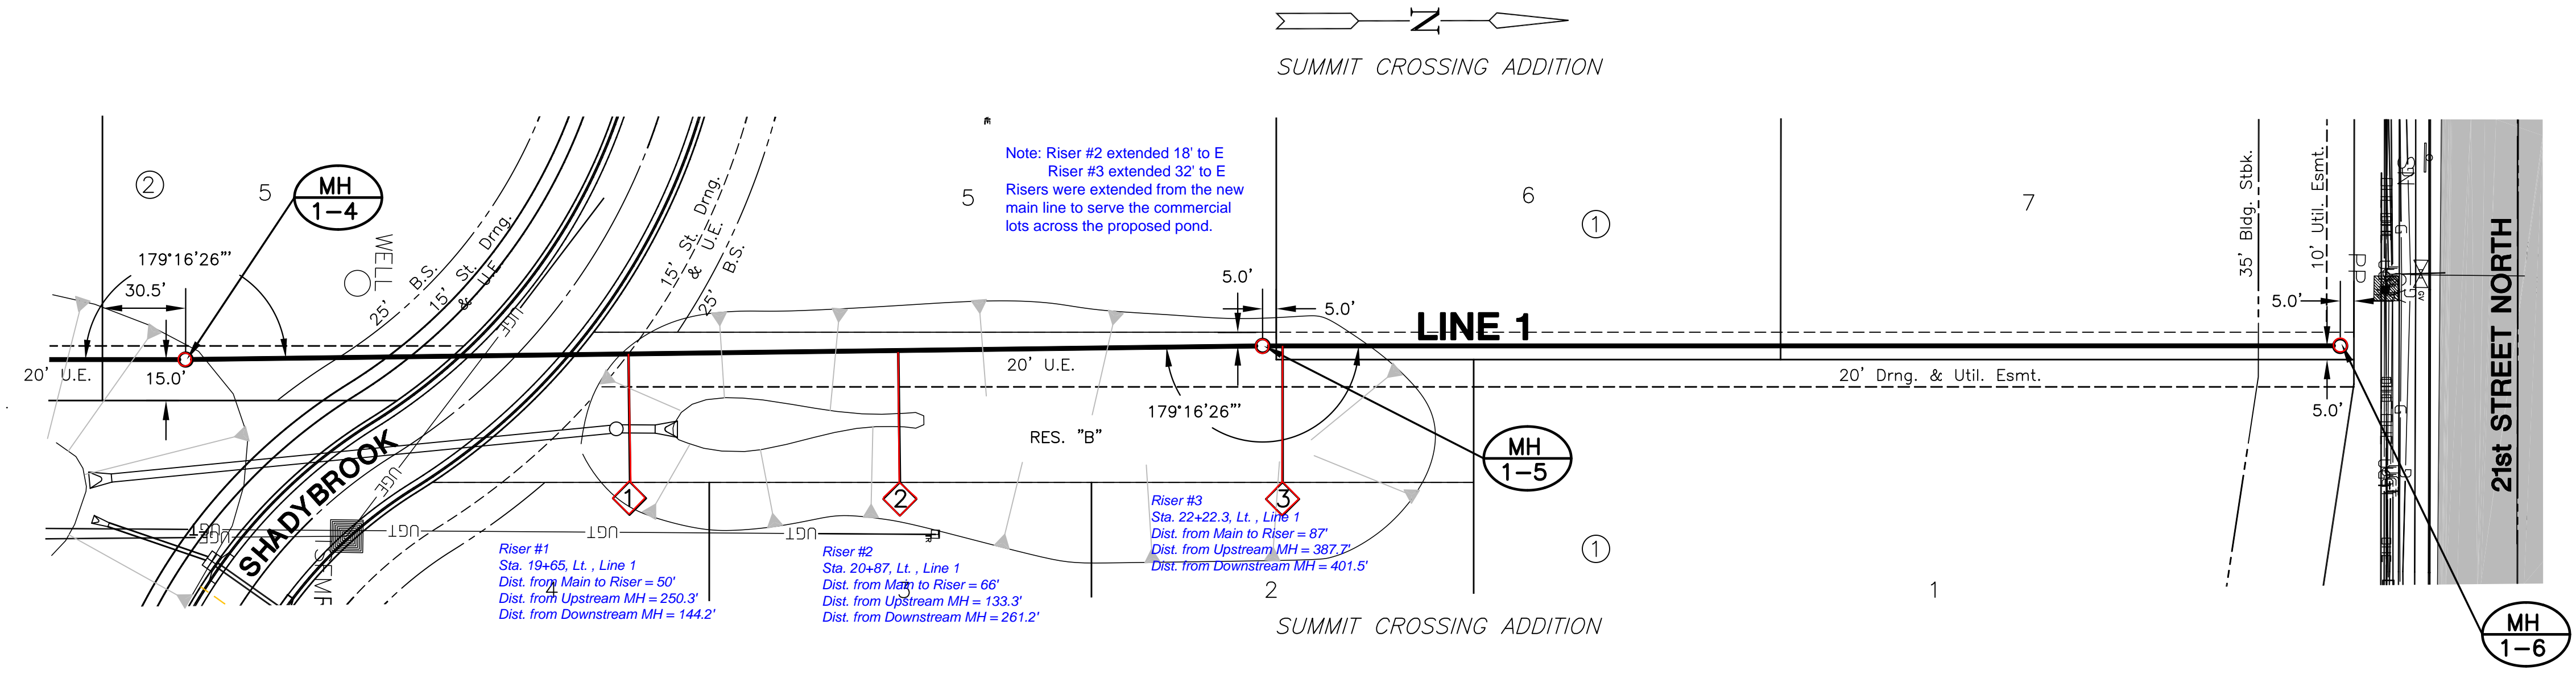

PLAN LINE 1

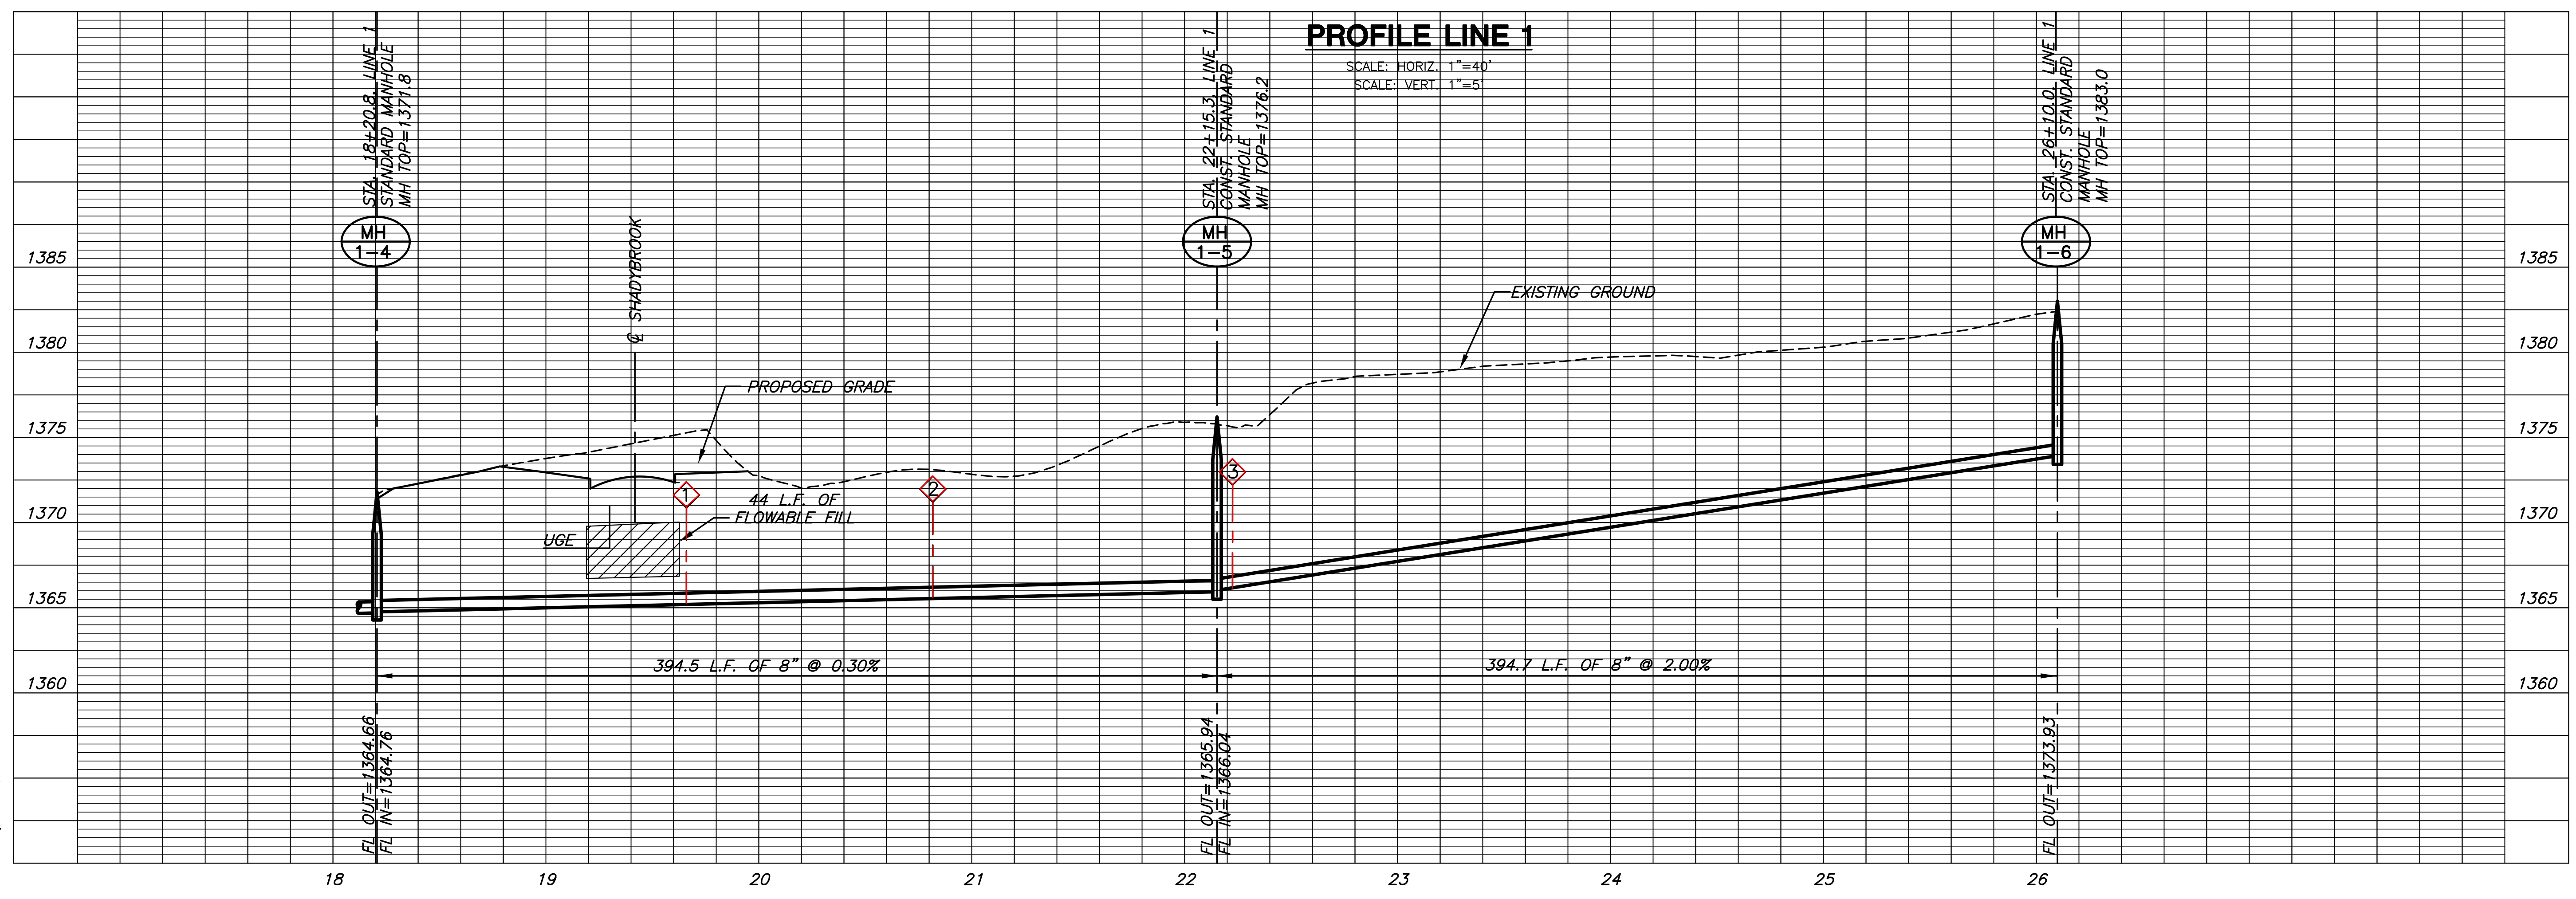

PROFILE LINE 1

LINE 1
SHEET TITLE
468-84579
PROJECT NUMBER

DFL
DESIGN BY
KKL
DRAWN BY
GJA
CHECKED BY

ISSUED
March 2010
REVISED

SHEET NO.
5 of 13