

Index

Title Sheet	1
Key Sheet	2
General Notes	3
Typical Pavement Sections	4-7
Paving Plans	8-22
Valley Gutter Details	23
Paving Details	24-27
Intersection Joint/Grading Plans	28-33
Pavement Joint Plan	34-36
Storm Water Plan/Profile	37-50
Sanitary Sewer Plan/Profile	51
Sewer Details	52-57
Summary of Quantities	58-59
Recapitulation of Quantities	60
Pavement Marking & Signing Plan	61-64
Signing Details	65
Traffic Signal/Wiring Details	66-73
Const. Traffic Control	74-91
<b>Traffic Control Details</b>	<b>92-95</b>
Traffic Detour Details	96
Erosion Control Details	97-100
Earthwork Cross Sections	101-131
<b>KDOT Project:</b>	
Title Sheet	1
Key Sheet	2
General Notes	3
Typical Pavement Sections	4
Standard Drive Details	5
Paving Plans	6-7
Paving Details	8
Wheelchair Ramp Detail	9
Intersection Joint/Grading Plans	10
Pavement Joint Plan	11
Storm Water Plan/Profile	12-13
Storm Sewer Details	14-17
Pavement Marking & Signing Plan	18-19
2nd & West Signalization Plans	20-21
Traffic Signal/Wiring Details	22-23
Summary & Recapitulation of Quantities	24
Erosion Control Details	25-28
Earthwork Cross Sections	29-32
<b>Waterline Project:</b>	
Title Sheet	1
Water Detail Sheet	2
Water Main Plans	3-17
Meter Tables, Service Details & Summary of Quantities	18


STREET AND STORM WATER SEWER IMPROVEMENTS

# WEST STREET

## From Maple to Central

FOR  
**THE CITY OF WICHITA,  
 SEDGWICK COUNTY, KANSAS**  
 James L. Armour, P.E., City Engineer


November 2008

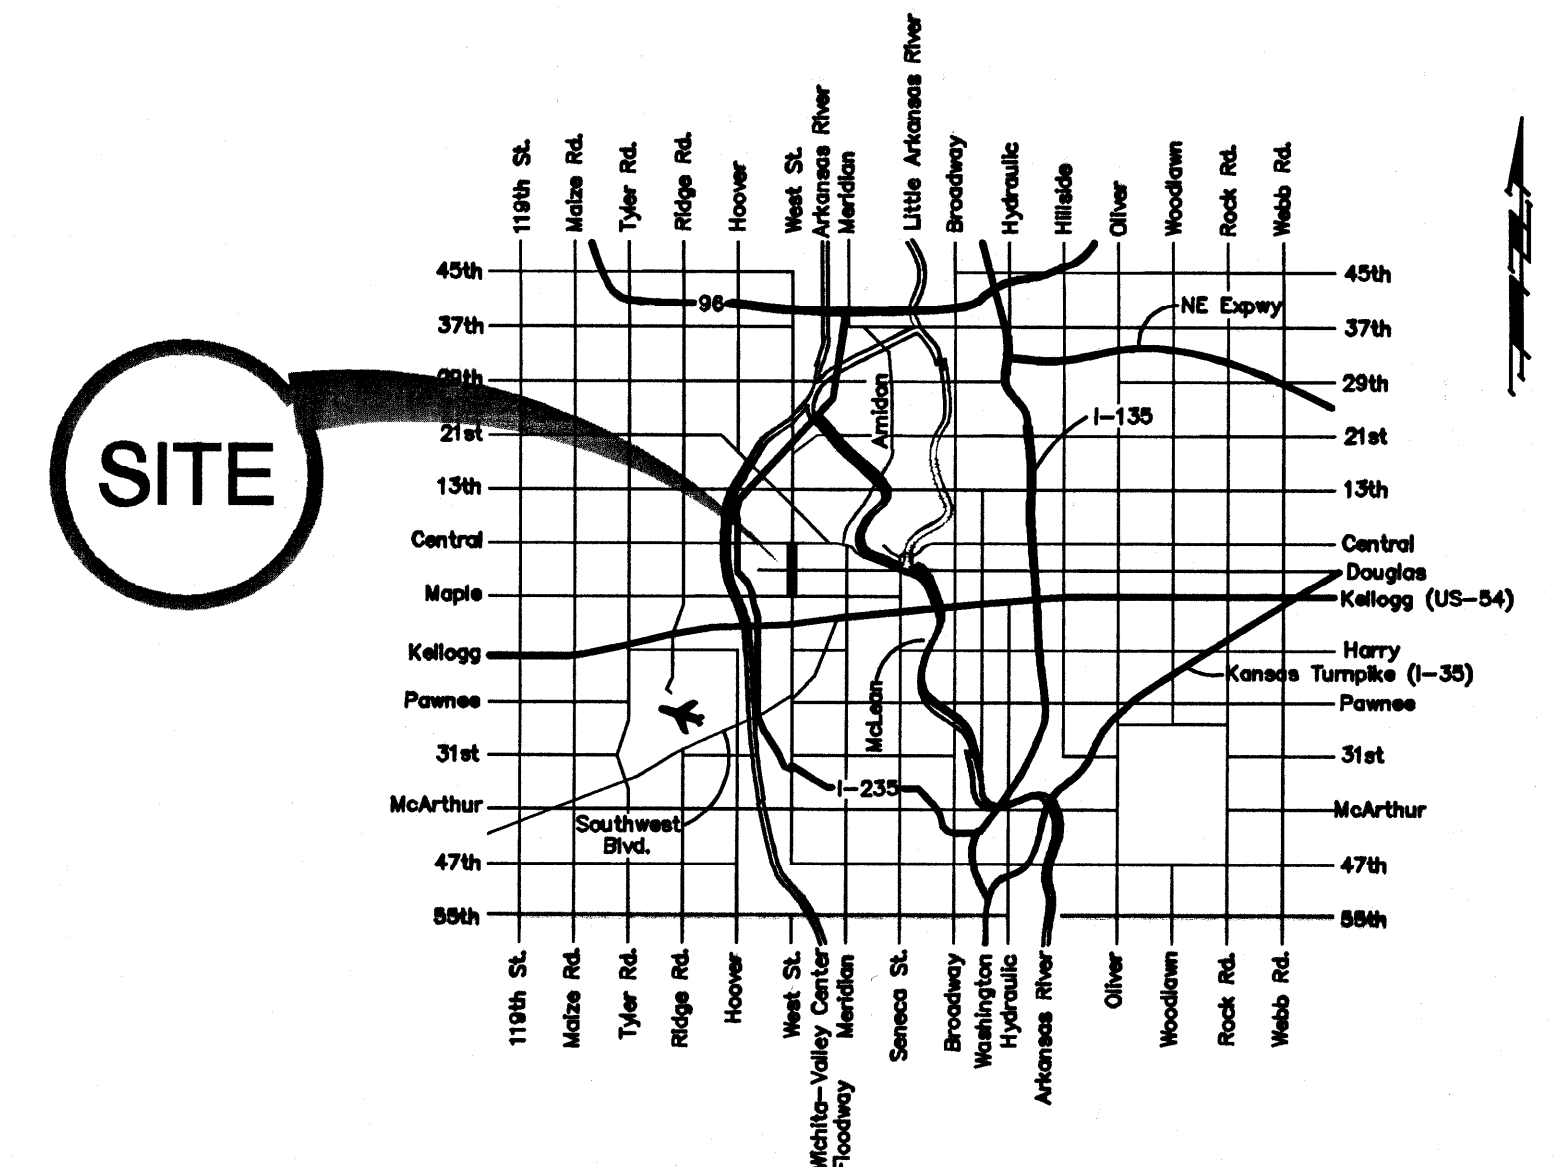

Vicinity Map

Cornejo & Sons/WB Carter - Contractor/Sub  
 S. Degenhardt - Field Project Engineer, City of Wichita  
 M. Coykendall - Inspector, City of Wichita  
 As-built  
 Stub  
 Release Date: 9/10/2010  
 pdf: APRosas 3/22/2011

Station 8+75.71  
 Begin Project No.  
 472-84761

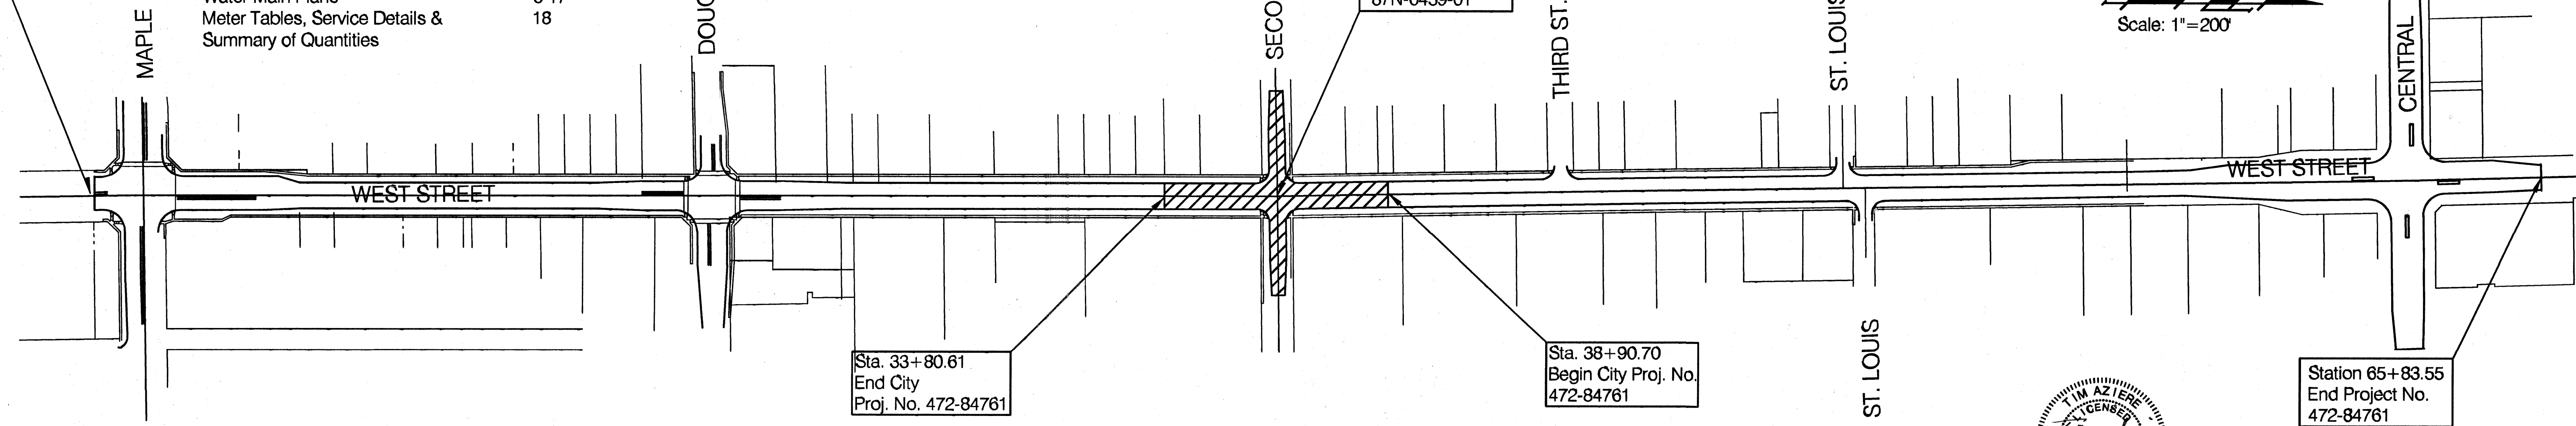

Sta. 33+80.61  
 End City  
 Proj. No. 472-84761

KDOT Project No.  
 87N-0459-01


Sta. 38+90.70  
 Begin City Proj. No.  
 472-84761

Station 65+83.55  
 End Project No.  
 472-84761

Scale: 1"=200'

### FINAL PLANS

City Project No. 472-84761  
 O.C.A. No. 706995

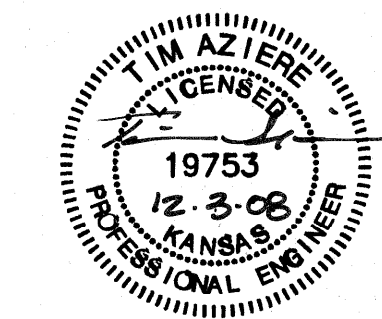

APPROVED - DATE 12-03-08  
  
 JIM ARMOUR, P.E., CITY ENGINEER  
 CITY OF WICHITA, KANSAS