

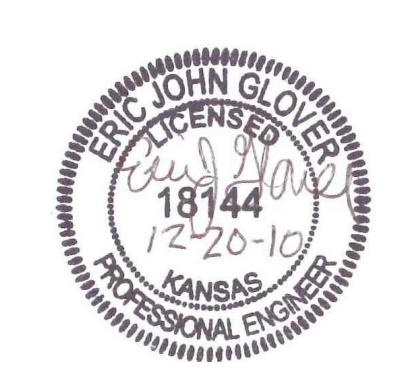
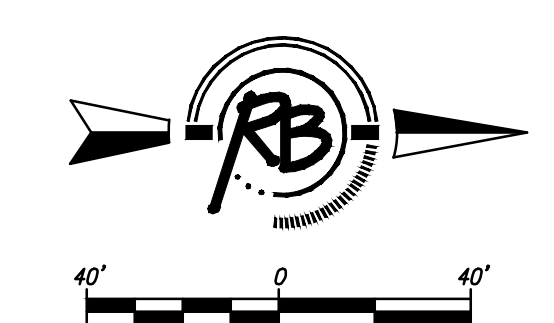


Carol Jean 2nd Addition

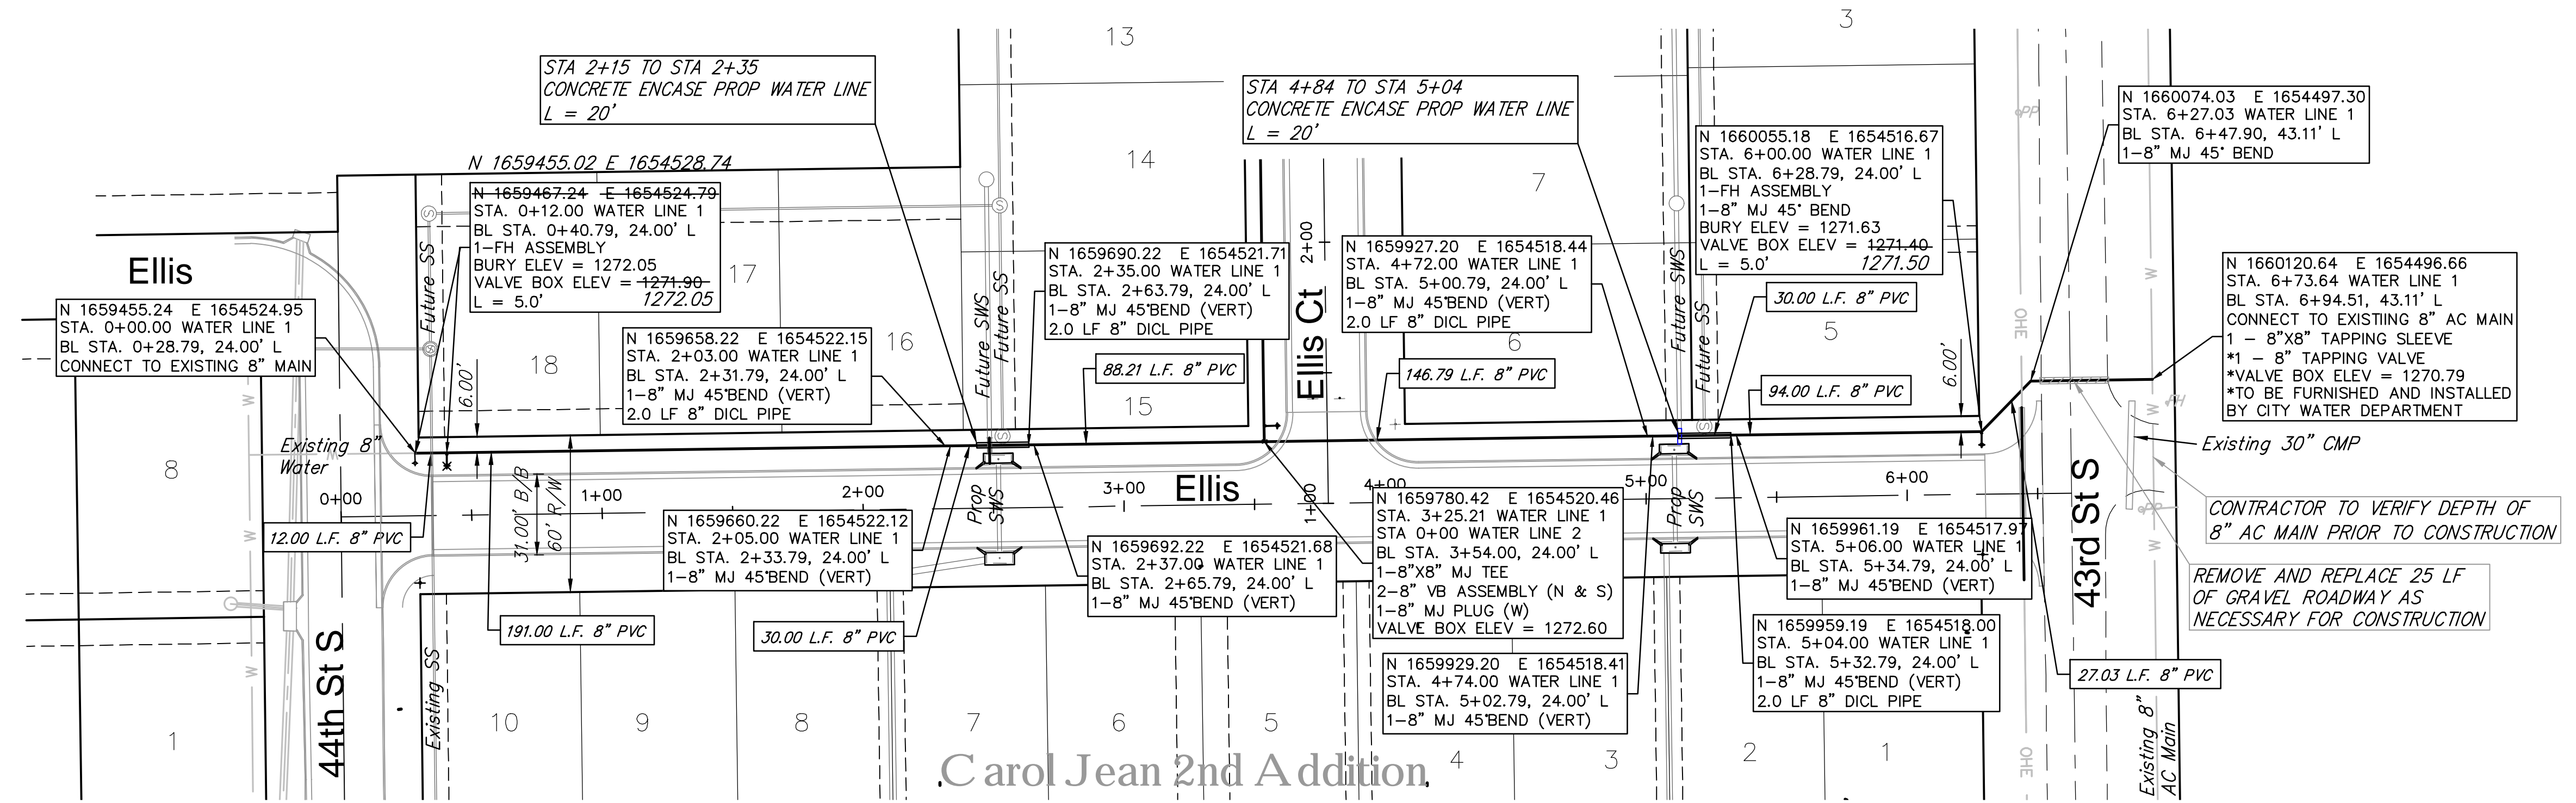

Ruggles & Bohm, P.A.
 Engineering, Surveying, Land Planning
 501 North Main Street, Suite 200
 Wichita, Kansas 67202
 Phone: 316-261-0000
 Fax: 316-261-0001
 www.rugglesandbohm.com

AS-BUILT 4/25/11

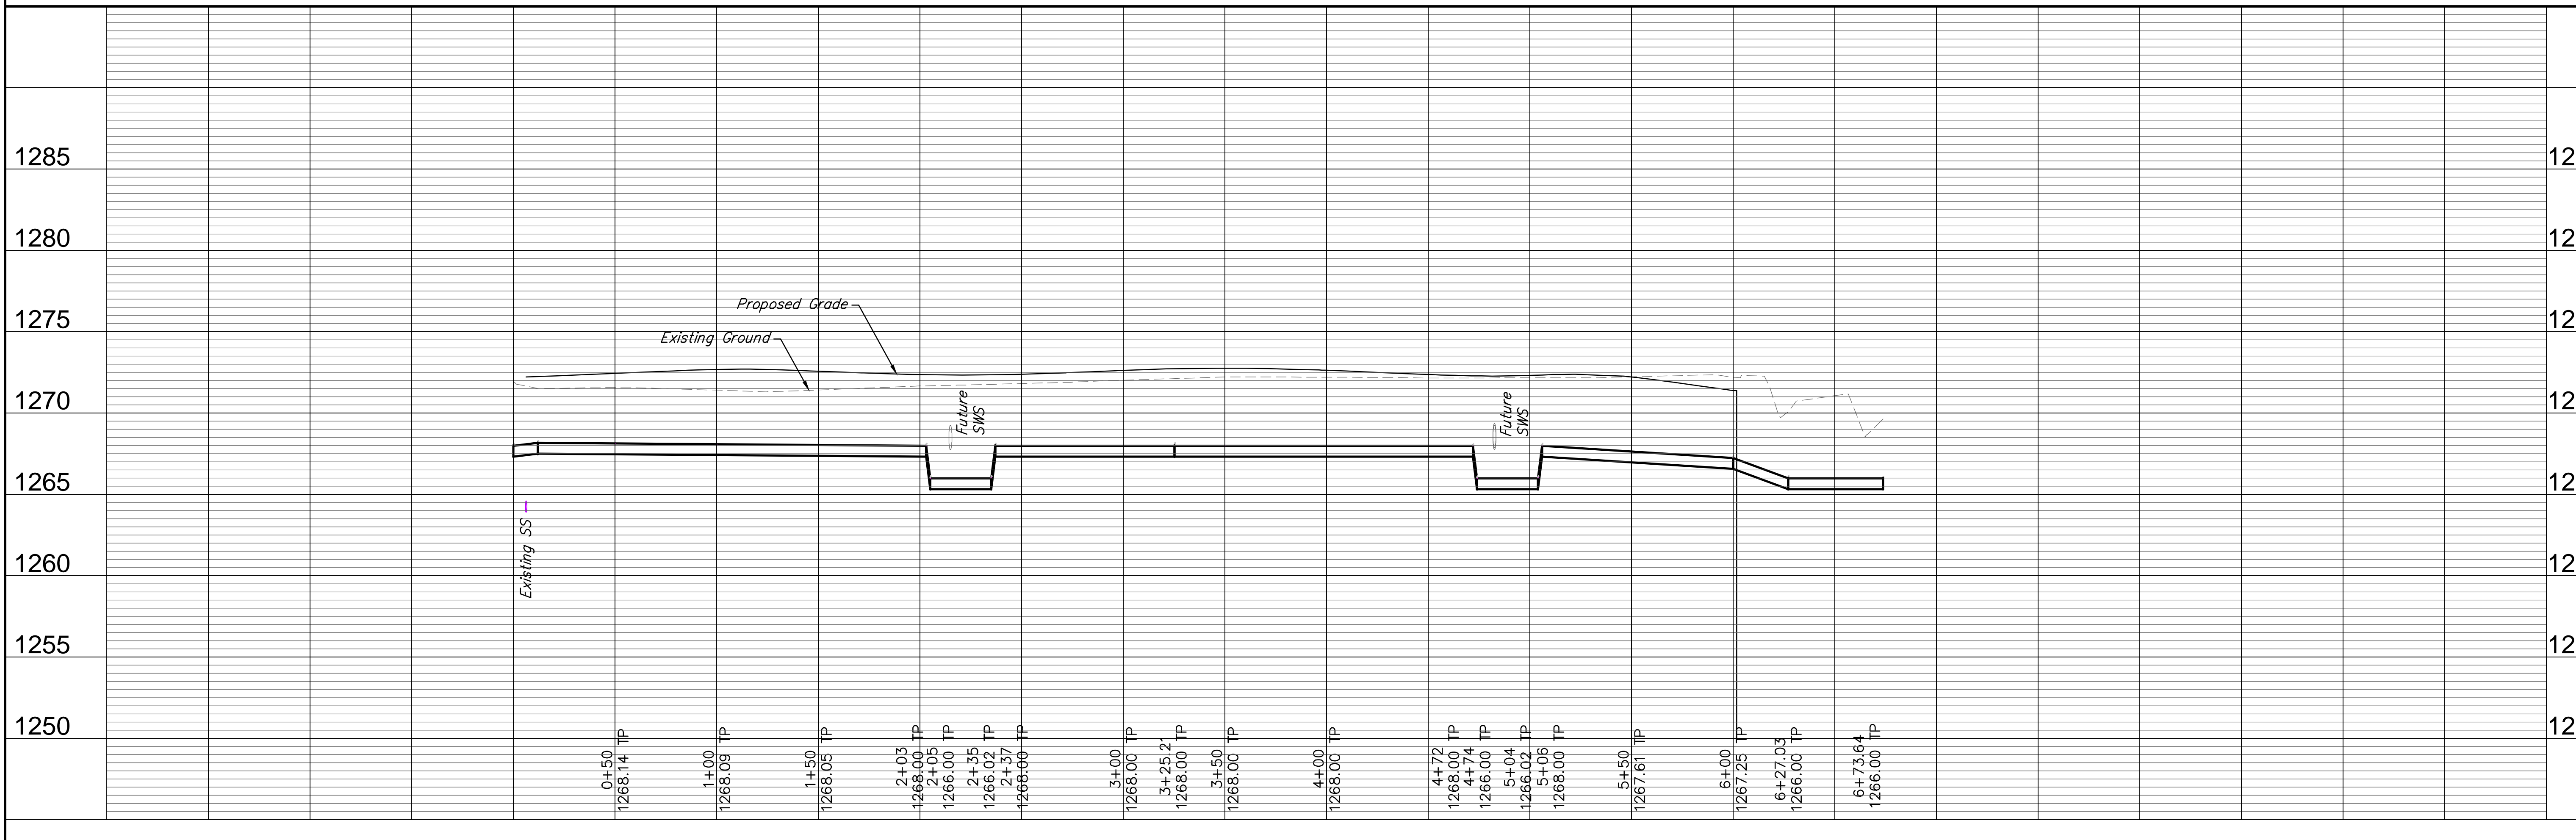

1285		1285
1280		1280
1275		1275
1270		1270
1265		1265
1260		1260
1255		1255
1250		1250

Water Distribution System
Water Line 01
WICHITA, KANSAS

PROJECT NUMBER: 1567PPP
 DRAWING FILE: 1567PPP.dwg
 Project: South Village Pkg. Eng. Set 2 (Water)

DESIGN: EIC
 DRAWN: EIC
 CHECKED: EIC
 UTILITY: UTILITY
 DATE: Dec. 20, 2010

REVISION: REVIEW
 DATE: REVIEW

RB JOB: 3714E
 SHEET: 3 OF 11