


AS BUILT PLANS  
 CONTRACTOR: UTILITIES PLUS  
 INSPECTOR: J. HAYES, C.E.D.  
 PDF BY: CC, 5-23-2011

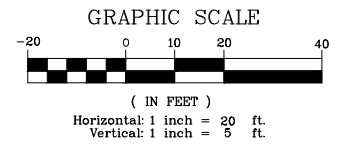


UTILITY LEGEND

- = Fire Hydrant
- = Water Meter
- = Water Valve
- = Gas Meter
- = Gas Valve
- = Telephone Riser
- = Mailbox
- = Flag Pole
- = SS Manhole
- = SWS Manhole
- = Sign
- = Misc. Post
- = Guy Anchor
- = Power Pole
- = Light Pole
- = Deciduous Tree or Shrub
- = Existing Fence
- = Right of Way Line
- = Underground Telephone
- = Underground Electric
- = Overhead Electric
- = Water Line
- = Sanitary Sewer
- = Gas Line
- = Cable TV or Fiber Optic

UTILITIES SHOWN REPRESENT THE BEST INFORMATION AVAILABLE FOR DESIGN. ADDITIONAL UTILITIES MAY BE PRESENT ON THIS PROJECT. THE CONTRACTOR SHALL BE RESPONSIBLE FOR DETERMINING THE EXACT LOCATION, DEPTH AND SIZE OF ALL UNDERGROUND UTILITIES PRIOR TO CONSTRUCTION. THE CONTRACTOR SHALL BE LIABLE FOR ANY DAMAGE CAUSED BY THE FAILURE TO DO SO.

ON SITE B.M.: R.R. Spike in Power Pole  
 41.1' W. of S.E. Cor. of Subject Property.  
 Elev.=93.20 (City Datum)

STORM WATER SEWER LINE No. 2

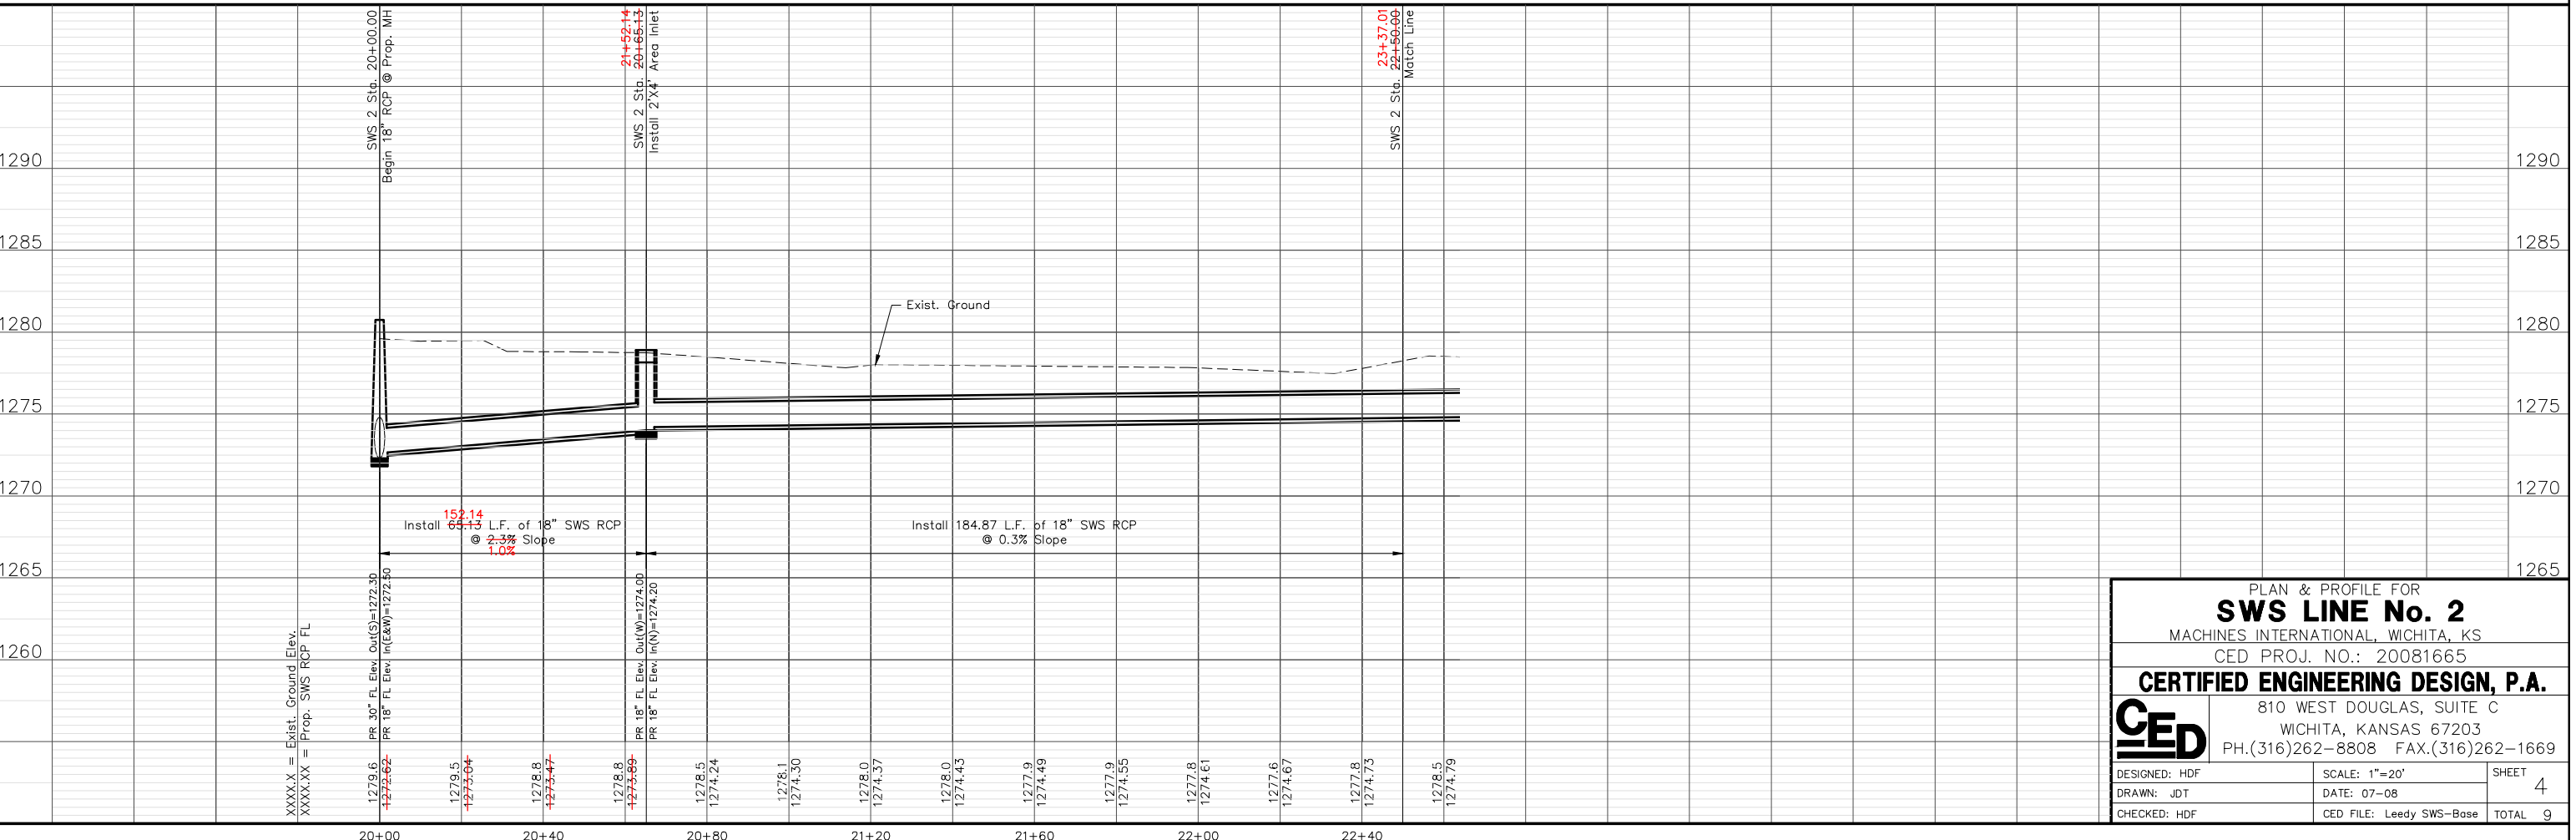

PLAN & PROFILE FOR  
**SWS LINE No. 2**  
 MACHINES INTERNATIONAL, WICHITA, KS  
 CED PROJ. NO.: 20081665  
**CERTIFIED ENGINEERING DESIGN, P.A.**  
 810 WEST DOUGLAS, SUITE C  
 WICHITA, KANSAS 67203  
 PH.(316)262-8808 FAX.(316)262-1669

DESIGNED: HDF	SCALE: 1"=20'	SHEET
DRAWN: JDT	DATE: 07-08	4
CHECKED: HDF	CED FILE: Leedy SWS-Base	TOTAL 9