

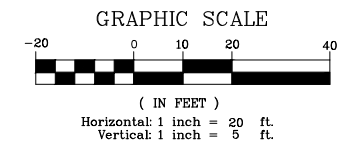


AS BUILT PLANS
 CONTRACTOR: UTILITIES PLUS
 INSPECTOR: J. HAYES, C.E.D.
 PDF BY: CC, 5-23-2011

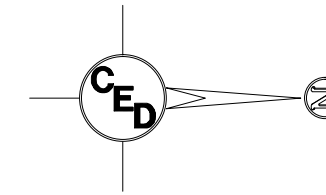

UTILITY LEGEND


= Fire Hydrant	= Flag Pole
= Water Meter	= SS Manhole
= Water Valve	= SWS Manhole
= Gas Meter	= Sign
= Gas Valve	= Misc. Post
= Telephone Riser	= Guy Anchor
= Mailbox	= Power Pole
= Light Pole	
= Deciduous Tree or Shrub	
= Existing Fence	
= Right of Way Line	
= Underground Telephone	
= Underground Electric	
= Overhead Electric	
= Water Line	
= Sanitary Sewer	
= Gas Line	
= Cable TV or Fiber Optic	

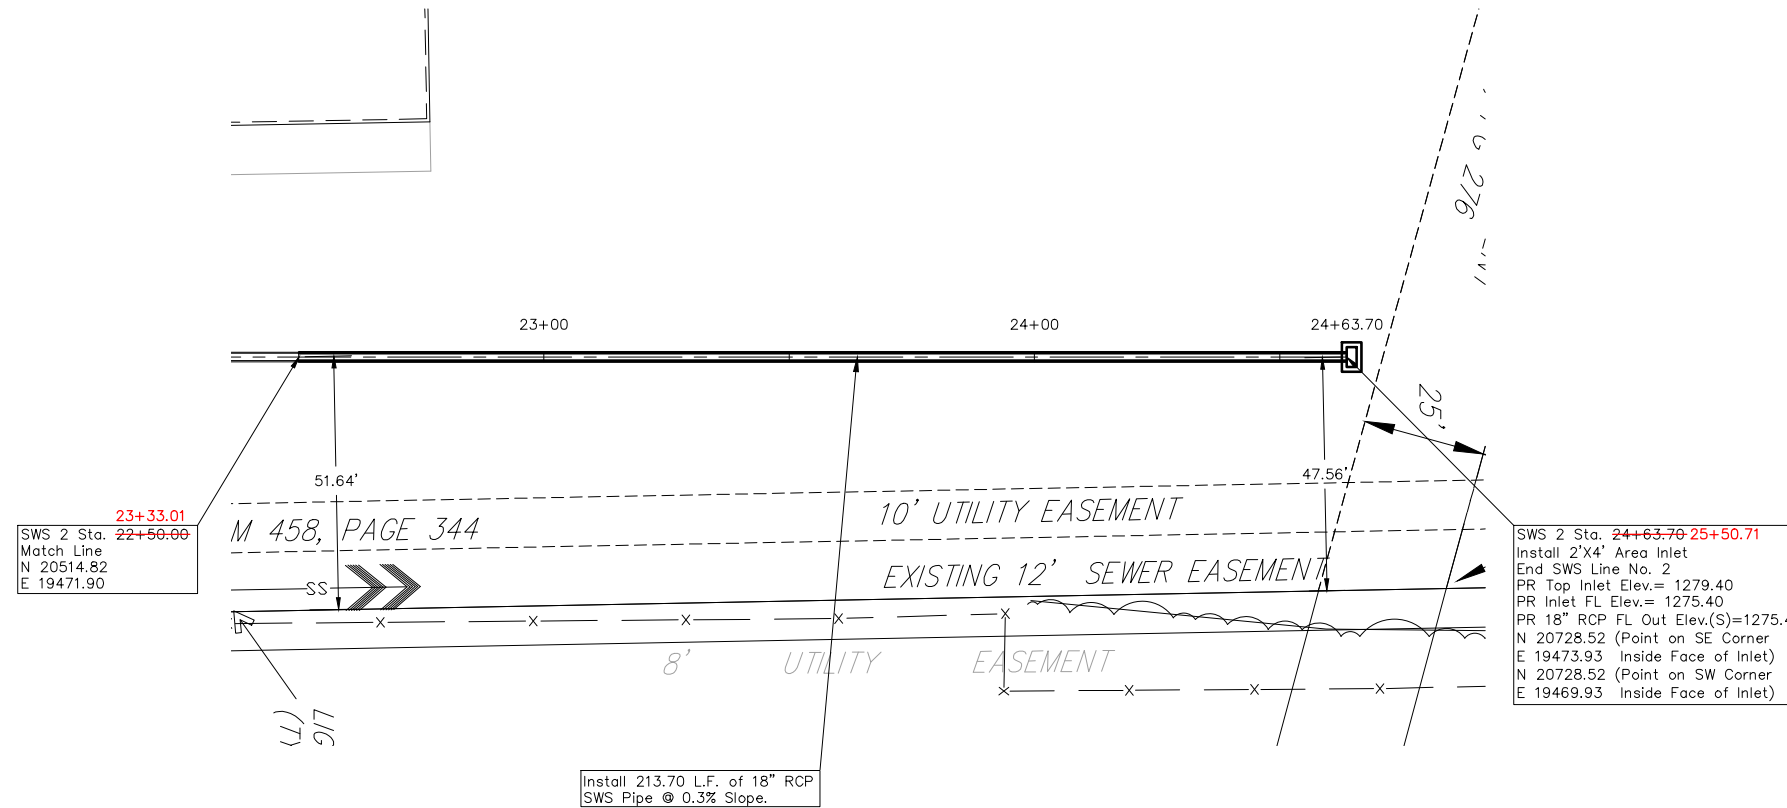

ON SITE B.M.: R.R. Spike in Power Pole
 41.1' W. of S.E. Cor. of Subject Property.
 Elev.=93.20 (City Datum)

UTILITIES SHOWN REPRESENT THE BEST INFORMATION AVAILABLE FOR DESIGN. ADDITIONAL UTILITIES MAY BE PRESENT ON THIS PROJECT. THE CONTRACTOR SHALL BE RESPONSIBLE FOR DETERMINING THE EXACT LOCATION, DEPTH AND SIZE OF ALL UNDERGROUND UTILITIES PRIOR TO CONSTRUCTION. THE CONTRACTOR SHALL BE LIABLE FOR ANY DAMAGE CAUSED BY THE FAILURE TO DO SO.

STORM WATER SEWER LINE No. 2

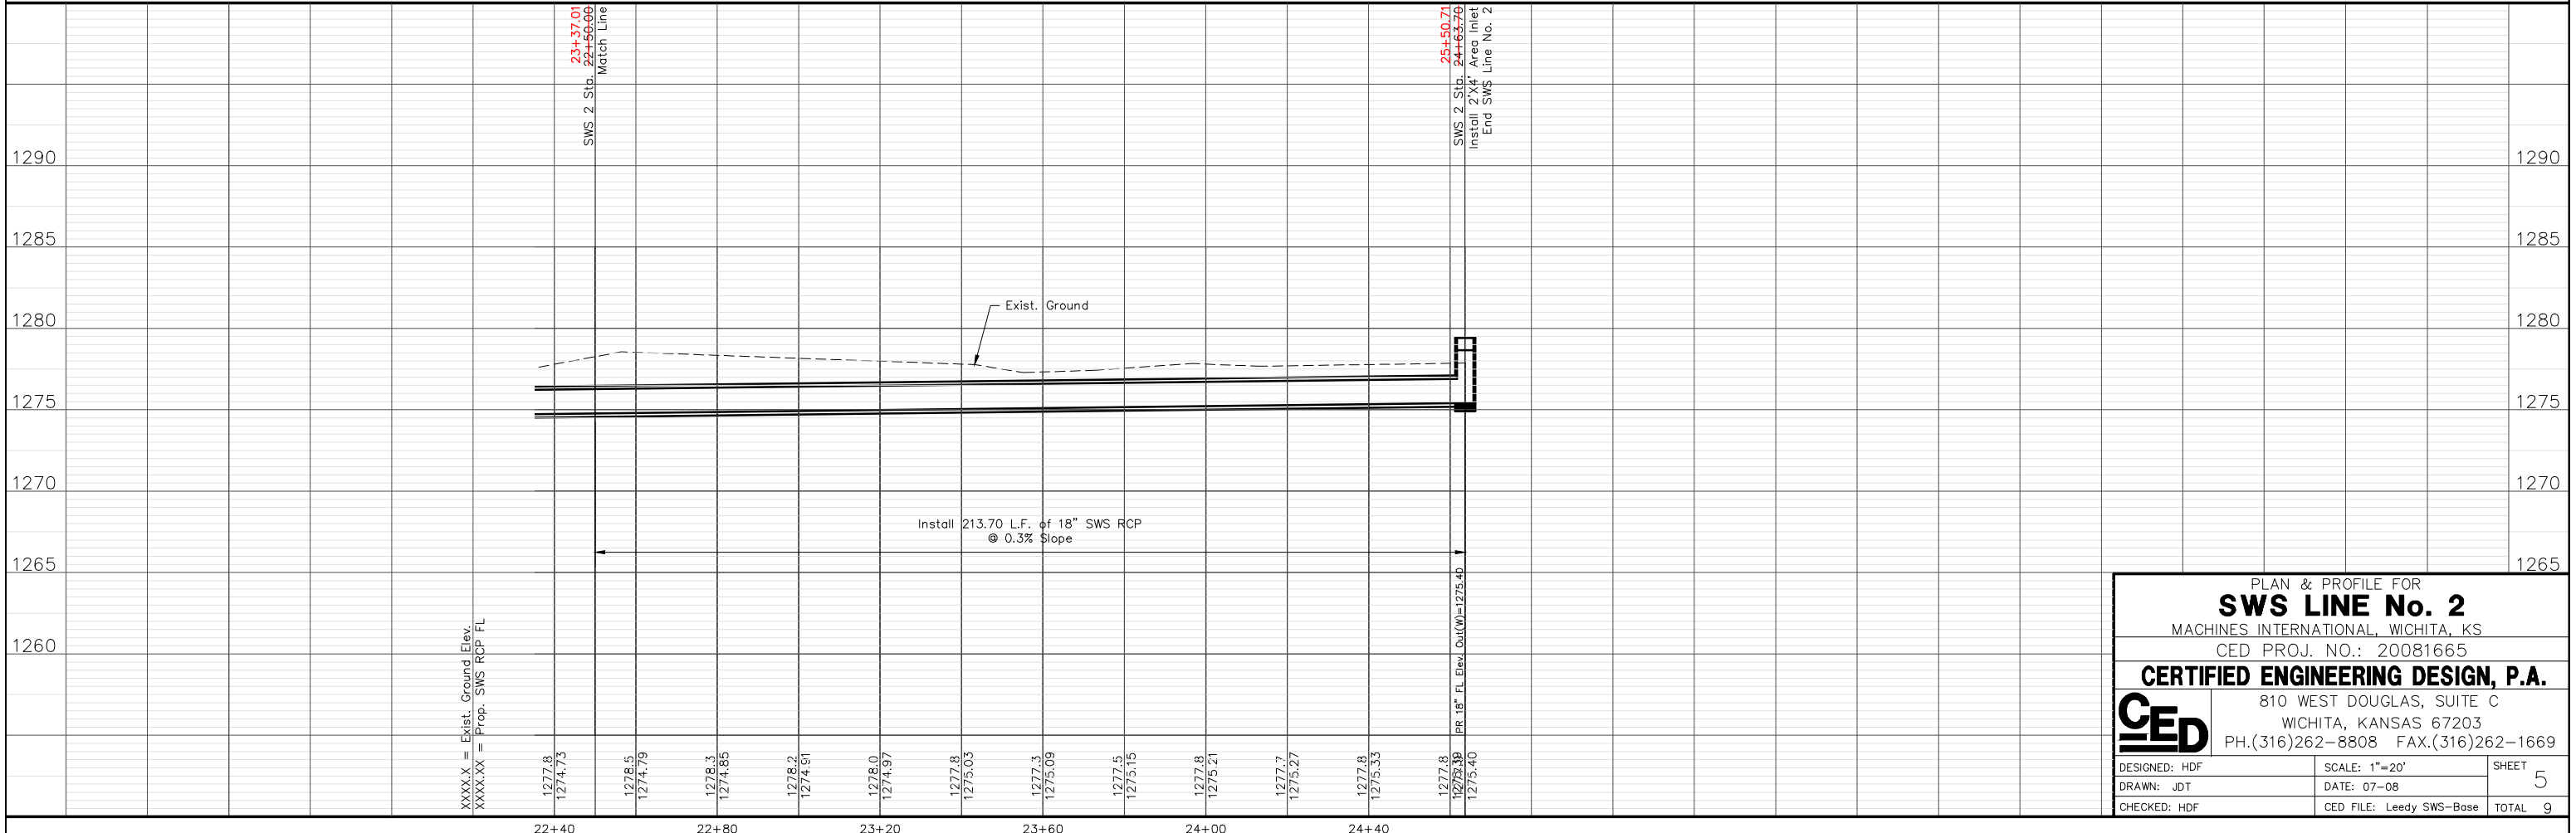

PLAN & PROFILE FOR
SWS LINE No. 2
 MACHINES INTERNATIONAL, WICHITA, KS
 CED PROJ. NO.: 20081665

CERTIFIED ENGINEERING DESIGN, P.A.
 810 WEST DOUGLAS, SUITE C
 WICHITA, KANSAS 67203
 PH.(316)262-8808 FAX.(316)262-1669

DESIGNED: HDF SCALE: 1"=20' SHEET 5
 DRAWN: JDT DATE: 07-08
 CHECKED: HDF CED FILE: Leedy SWS-Base TOTAL 9