
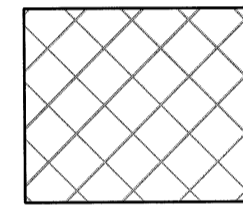
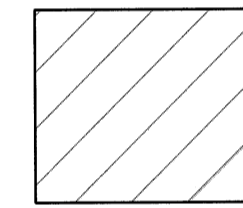


Equivalent Residential Unit (ERU) Calculation:

Proposed building area = 31508.0 sq. ft.
 Proposed parking, sidewalk
 and other pavement area = 68016.0 sq. ft.
 Total Impervious Area= 99524.0 sq ft.

$ERU = 99524 / 20139 = 4.94$

-  Building Area
-  Drive, Parking, Sidewalk and other impervious area

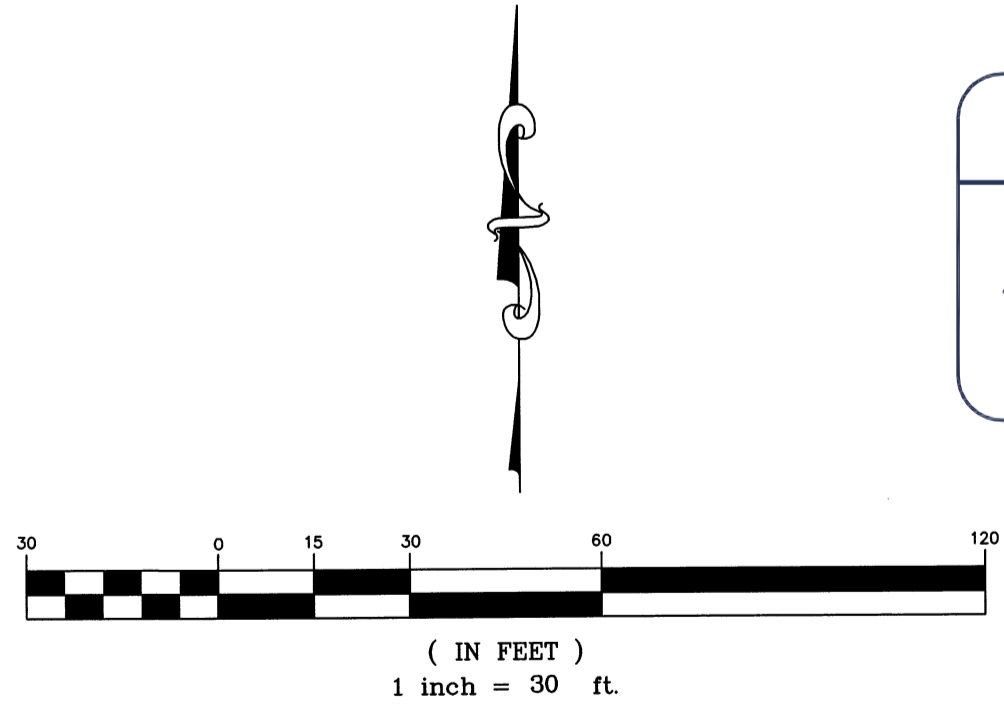

AS BUILTS
kemiller
 engineering
 516 S. Market,
 Wichita, KS 67202 (316)264-0242



TOP - North Central ERU Plan Sheet Wichita, Kansas			
PROJECT NUMBER			
kemiller engineering 516 S. Market, Wichita, KS 67202 (316)264-0242	KEM NO. 10147	FILE	DATE 12/2010
	DESIGN KM	DRAWN GP	REVISED 01/04/2011
			6.3