
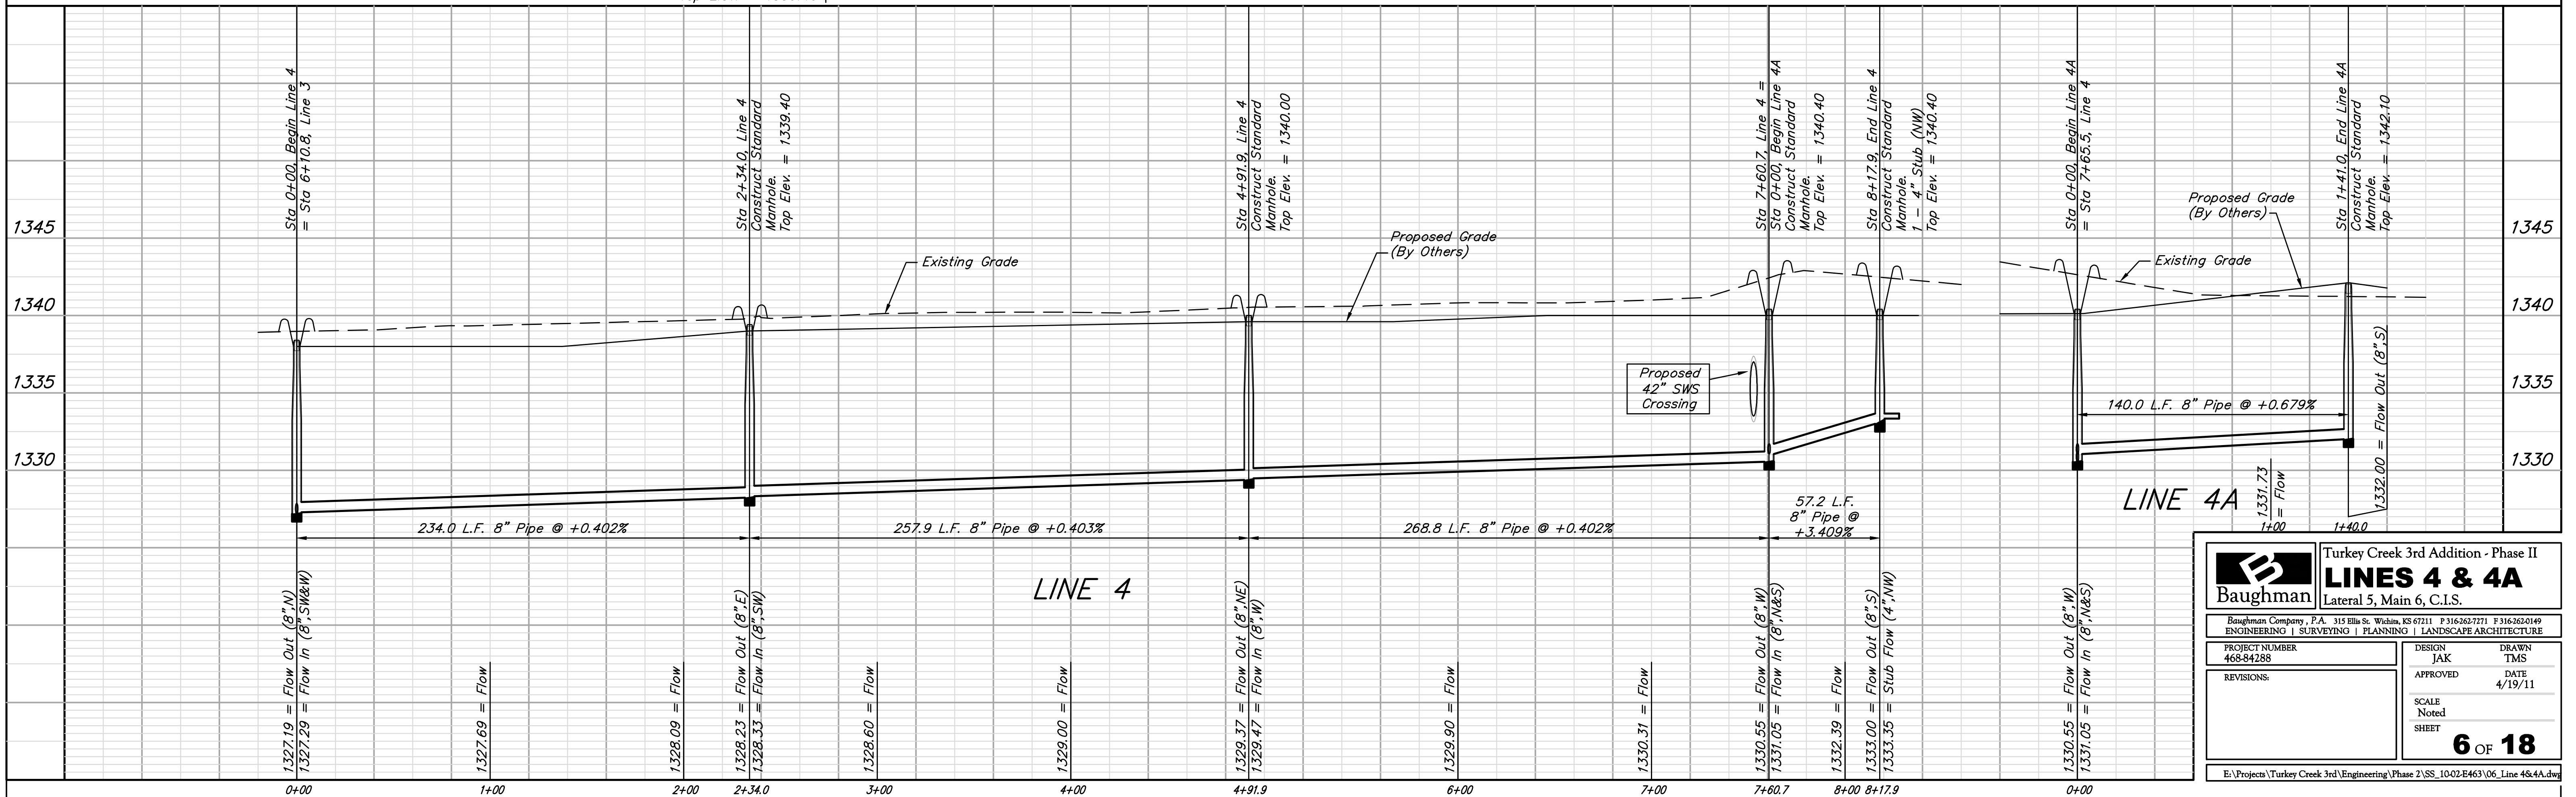
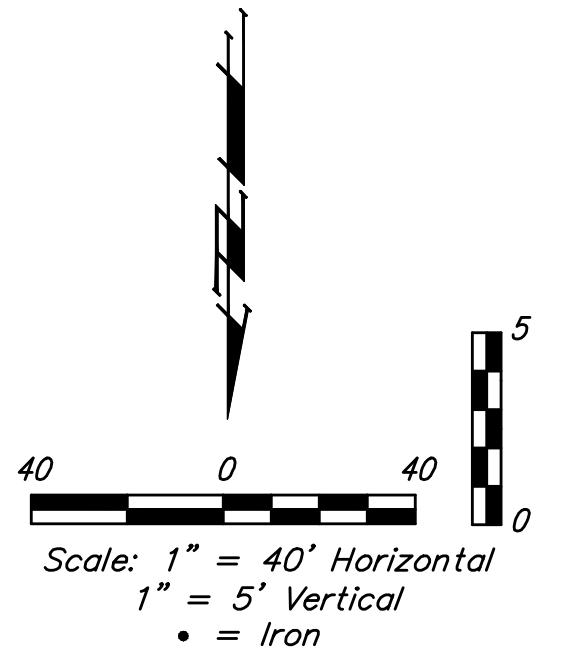


BENCHMARKS:
 BM #1: 135TH ST. W. & PAWNEE- CITY OF WICHITA BENCHMARK DISC, NORTHEAST CORNER OF INTERSECTION ON SW CORNER OF CONCRETE BASE OF HIGH LINE POLE. ELEV. = 1359.65 NGVD29

BM #2: CITY OF WICHITA BENCHMARK DISC, 0.4 MI. SOUTH OF KELLOGG ON 135TH ST. W., WEST SIDE OF CONCRETE BASE FOR HIGH LINE POLE, WEST OF K.G.&E. SUBSTATION, 135± SOUTH OF RAILROAD TRACKS ON EAST SIDE OF 135TH ST. W. ELEV. = 1367.77 NGVD29

AS-BUILT

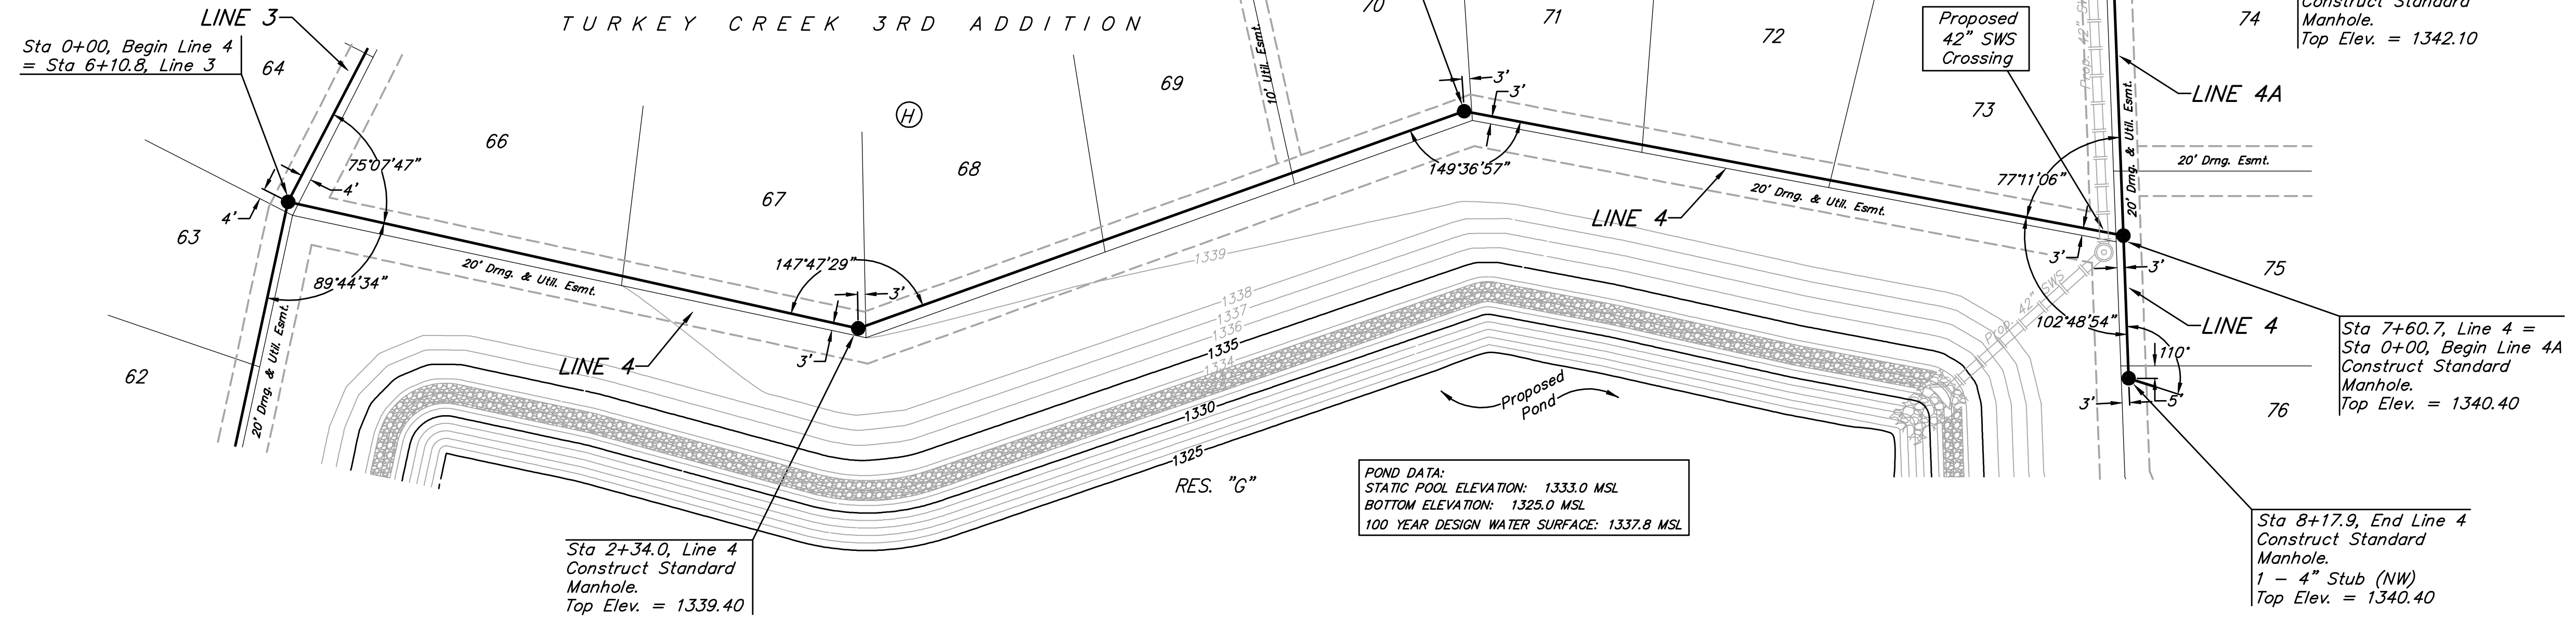

Baughman Turkey Creek 3rd Addition - Phase II
Lines 4 & 4A
 Lateral 5, Main 6, C.I.S.

Baughman Company, P.A. 315 Ellis St. Wichita, KS 67211 P 316-262-7271 F 316-262-0149
 ENGINEERING | SURVEYING | PLANNING | LANDSCAPE ARCHITECTURE

PROJECT NUMBER: 468-84288
 DESIGN: JAK
 DRAWN: TMS
 APPROVED: [Signature]
 DATE: 4/19/11

REVISIONS:
 SCALE: Noted
 SHEET: **6 OF 18**

E:\Projects\Turkey Creek 3rd\Engineering\Phase 2\SS_1002-E463\06_Line 4&4A.dwg